[redacted]

ARAPAHOE COUNTY JUSTICE CENTER
7375 S. POTOMAC STREET
CENTENNIAL, CO 80112

REVISION	DATE	DESCRIPTION
0	11/05/2018	SUBMITTAL
0.1	12/05/2018	JAIL SHEETS FOR D.O.T. REVIEW
1	08/01/2019	AS-BUILT SET
2	09/13/2019	ADDED CAMERAS FOR BOOKING, MEDICAL, AND OUTPATIENT
3	10/03/2019	ADDED CAMERAS IN PODS 1-6
4	12/26/2019	PEDESTAL INTERCOM "IC-G5" ADDED
5	01/23/2020	ACTALL ADDITIONS
6	04/02/2020	ADDED COURT CAMERAS
7	09/09/2020	ADDED POD-1 DURESS BUTTON
8	11/30/2020	2021 CCTV CAMERA REPLACEMENTS
9	07/22/2022	CH2 3RD FLOOR REMODEL (5) PANIC BUTTON RELOCATIONS, (2) DSI ALARMS
10	10/26/2022	CH2 3RD FLOOR REMODEL - ADDED DOOR F388X DSI ALARM (PER ASI NO. 4A)
11	11/08/2022	CH2 3RD FLOOR REMODEL - ADDED A 6TH PANIC ALARM FOR THE MEETING ROOM
12	07/19/2023	CH1 3RD FLOOR - RELOCATED "INTERPRETER" PANIC TO 307 COURTROOM.
13	10/05/2023	ADDITION OF SE GATE - CONTROL, INTERCOM, CAMERA
14	07/09/2024	REMOVAL OF GATE G4 - AS PART OF 2024 ADDITION/REMODEL CONSTRUCTION
15	09/05/2024	CH2 3RD FLOOR REMODEL (PHASE 2) (5) PANIC BUTTON RELOCATIONS, (4) DSI ALARMS
16	10/10/2024	(6) ADDED CAMERAS IN CH1 / CH2
17	04/28/2025	PHASE 2 REMODEL
18	06/15/2025	ADDED JAIL CAMERAS
19	07/24/2025	CH2 3RD FLOOR REMODEL / ADDITIONAL ALARMS (3) PANIC BUTTONS, (2) DSI ALARMS

[redacted]

PROJECT

ARAPAHOE COUNTY JUSTICE CENTER
7375 S. POTOMAC STREET
CENTENNIAL, CO 80112

SHEET NAME

COVER SHEET

SHEET NUMBER

SE000

REVISION

19

GENERAL SHEET SYMBOLS LEGEND

SYMBOL	
A	KEYNOTE BUBBLE - SEE KEYNOTES OF SHEET/DETAIL FOR MORE INFORMATION.
3 / -	DETAIL CALL-OUT - TOP INDICATES DETAIL NUMBER BOTTOM INDICATES SHEET DETAIL IS ON. ("-" INDICATES DETAIL ON SAME SHEET)

SECURITY ELECTRONICS SYSTEM - SYMBOLS LEGEND

SYMBOL	TAG PREFIX	DESCRIPTION	BACK BOX	MOUNTING HEIGHT	CABLE TYPE	NOTES
	---	ELECTRICALLY CONTROLLED AND MONITORED DOOR	N/A	AS REQUIRED	SEC-4	N/A
GD	---	ELECTRICALLY CONTROLLED AND MONITORED DOOR - GARAGE DOOR (OPEN, STOP, CLOSE)	N/A	AS REQUIRED	SEC-6	
GA	---	ELECTRICALLY CONTROLLED AND MONITORED DOOR - VEHICLE GATE (OPEN, STOP, CLOSE)	N/A	AS REQUIRED	SEC-6	
	---	MONITORED ONLY DOOR	N/A	AS REQUIRED	SEC-3	N/A
	---	ELECTRICALLY CONTROLLED DOOR (ELECTRIC LOCK ONLY - NO DPS)	N/A	AS REQUIRED	SEC-4	N/A
S	---	PAGING SPEAKER ZONE	N/A	N/A	SEC-10	N/A
IC	---	INTERCOM STATION - WALL MOUNTED	DOUBLE GANG	48" TO CENTER	SEC-5	N/A
	---	FIXED CAMERA	4-SQUARE	CEILING, U.N.O.	SEC-2	N/A
CPU	---	COMPUTER	N/A	N/A	N/A	N/A
MON	---	MONITOR	N/A	N/A	N/A	N/A
IL	---	DOOR INTERLOCK GROUP	N/A	N/A	N/A	N/A
ICM	---	INTERCOM MASTER STATION	N/A	N/A	N/A	N/A
TS	---	TOUCHSCREEN	N/A	N/A	N/A	N/A
LT	---	LIGHTING CONTROL ZONE	N/A	N/A	N/A	N/A
P PAN	---	PANIC BUTTON	N/A	N/A	N/A	N/A
UPS	---	UNINTERRUPTIBLE POWER SOURCE	N/A	N/A	N/A	N/A
MGE	---	ACTALL ETHERNET GATEWAY	N/A	AS REQUIRED	TBD	N/A
LDN C	---	ACTALL ZONE RECEIVER - CEILING MOUNT	N/A	AS REQUIRED	SEC-3	ARROW INDICATES ANTENNA DIRECTION.
LDN W	---	ACTALL ZONE RECEIVER - WALL MOUNT	N/A	AS REQUIRED	SEC-3	(OM) INDICATES OMNIDIRECTIONAL ANTENNA.
LDN LPC	---	ACTALL ZONE RECEIVER - LOW PROFILE CEILING MOUNT	N/A	AS REQUIRED	SEC-3	
PLC	---	PROGRAMMABLE LOGIC CONTROLLER	N/A	N/A	N/A	N/A
BCS	---	ACTALL BADGE CHECK STATION	N/A	FLOOR	SEC-2	N/A

SECURITY ELECTRONICS SYSTEM - GENERAL NOTES

1. INSTALL ALL SYSTEMS IN ACCORDANCE WITH THE DESIGN DRAWINGS, SPECIFICATIONS, OR OTHER CONTRACT DOCUMENTS.
2. COORDINATE THE INSTALLATION OF SECURITY SYSTEMS WITH ALL OTHER BUILDING SYSTEMS AND TRADES, IF NEEDED.
3. DEVICE AND CONDUIT LAYOUT IS DIAGRAMMATIC. REFER TO ARCHITECTURAL PLANS FOR EXACT BUILDING DIMENSIONS AND CONFIGURATION.
4. SEPARATE CONDUITS SHALL BE PROVIDED FOR EACH SYSTEM TYPE. REFER TO CONDUIT DRAWINGS FOR REQUIRED SYSTEM TYPE SEPARATION.
5. CLASS 1 AND 2 WIRING CIRCUITS SHALL BE KEPT SEPARATE.

SECURITY ELECTRONICS SYSTEM - ABREVIATIONS

(E)	EXISTING TO REMAIN
(ER)	EXISTING TO BE REPLACED
(D)	DEMO (REMOVE AND SALVAGE OR DISPOSE OF)
(TYP)	TYPICAL

SECURITY ELECTRONICS CABLE AND CONDUIT FILL SCHEDULE

REVISION	DATE	DESCRIPTION	REVISION	DATE	DESCRIPTION	REVISION	DATE	DESCRIPTION
0	11/05/2018	SUBMITTAL	6	04/02/2020	ADDED COURT CAMERAS	13	10/05/2023	ADDITION OF SE GATE - CONTROL, INTERCOM, CAMERA
0.1	12/05/2018	JAIL SHEETS FOR D.O.T. REVIEW	7	09/09/2020	ADDED POD-1 DURESS BUTTON	14	07/09/2024	REMOVAL OF GATE G4 - AS PART OF 2024 ADDITION/REMODEL CONSTRUCTION
1	08/01/2019	AS-BUILT SET	8	11/30/2020	2021 CCTV CAMERA REPLACEMENTS	15	09/05/2024	CH2 3RD FLOOR REMODEL (PHASE 2) (5) PANIC BUTTON RELOCATIONS, (4) DSI ALARMS
2	09/13/2019	ADDED CAMERAS FOR BOOKING, MEDICAL, AND OUTPATIENT	9	07/22/2022	CH2 3RD FLOOR REMODEL (5) PANIC BUTTON RELOCATIONS, (2) DSI ALARMS	16	10/10/2024	(6) ADDED CAMERAS IN CH1 / CH2
3	10/03/2019	ADDED CAMERAS IN PODS 1-6	10	10/26/2022	CH2 3RD FLOOR REMODEL - ADDED DOOR F388X DSI ALARM (PER ASI NO. 4A)	17	04/28/2025	PHASE 2 REMODEL
4	12/26/2019	PEDESTAL INTERCOM "IC-GS" ADDED	11	11/08/2022	CH2 3RD FLOOR REMODEL - ADDED A 6TH PANIC ALARM FOR THE MEETING ROOM	18	06/15/2025	ADDED JAIL CAMERAS
5	01/23/2020	ACTALL ADDITIONS	12	07/19/2023	CH1 3RD FLOOR - RELOCATED "INTERPRETER" PANIC TO 307 COURTROOM.	19	07/24/2025	CH2 3RD FLOOR REMODEL / ADDITIONAL ALARMS (3) PANIC BUTTONS, (2) DSI ALARMS

[redacted]

PROJECT

ARAPAHOE COUNTY JUSTICE CENTER
7375 S. POTOMAC STREET
CENTENNIAL, CO 80112

SHEET NAME


SYMBOLS LEGEND

SHEET NUMBER

SE001

REVISION

19

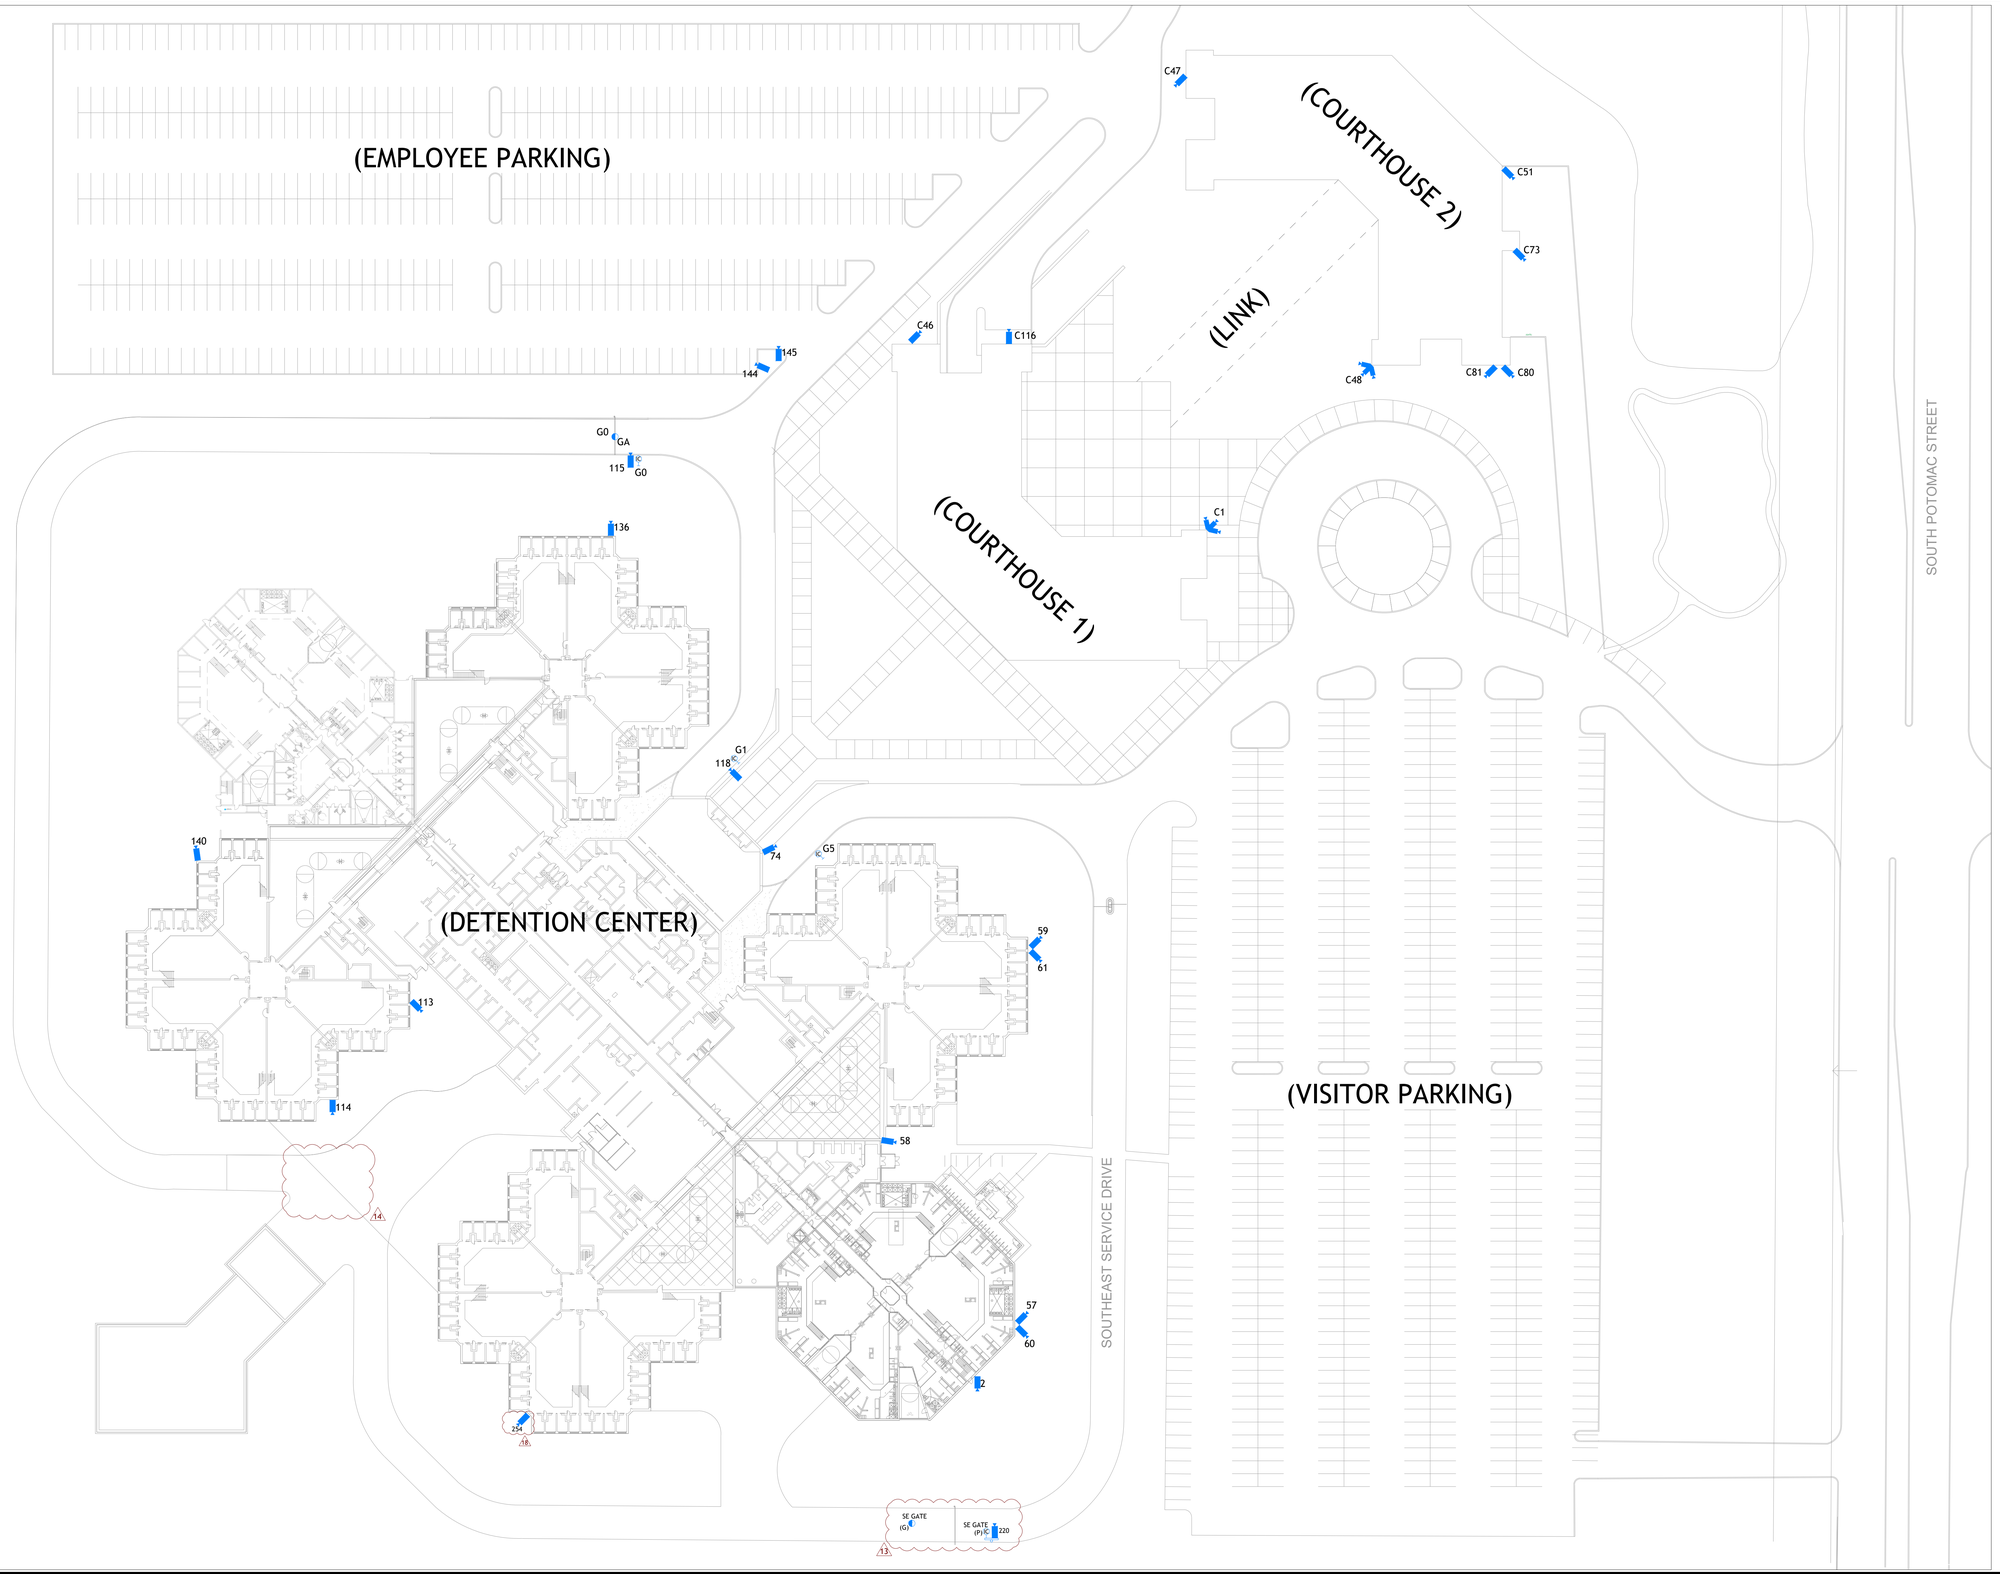

1 SECURITY SITE PLAN
SCALE: ABOUT 1" = 40'

REVISION	DATE	DESCRIPTION	REVISION	DATE	DESCRIPTION	REVISION	DATE	DESCRIPTION
0	11/05/2018	SUBMITTAL	6	04/02/2020	ADDED COURT CAMERAS	13	10/05/2023	ADDITION OF SE GATE - CONTROL, INTERCOM, CAMERA
0.1	12/05/2018	JAIL SHEETS FOR D.O.T. REVIEW	7	09/09/2020	ADDED POD-1 DURESS BUTTON	14	07/09/2024	REMOVAL OF GATE G4 - AS PART OF 2024 ADDITION/REMODEL CONSTRUCTION
1	08/01/2019	AS-BUILT SET	8	11/30/2020	2021 CCTV CAMERA REPLACEMENTS	15	09/05/2024	CH2 3RD FLOOR REMODEL (PHASE 2) (5) PANIC BUTTON RELOCATIONS, (4) DSI ALARMS
2	09/13/2019	ADDED CAMERAS FOR BOOKING, MEDICAL, AND OUTPATIENT	9	07/22/2022	CH2 3RD FLOOR REMODEL (5) PANIC BUTTON RELOCATIONS, (2) DSI ALARMS	16	10/10/2024	(6) ADDED CAMERAS IN CH1 / CH2
3	10/03/2019	ADDED CAMERAS IN PODS 1-6	10	10/26/2022	CH2 3RD FLOOR REMODEL - ADDED DOOR F388X DSI ALARM (PER ASI NO. 4A)	17	04/28/2025	PHASE 2 REMODEL
4	12/26/2019	PEDESTAL INTERCOM "IC-G5" ADDED	11	11/08/2022	CH2 3RD FLOOR REMODEL - ADDED A 6TH PANIC ALARM FOR THE MEETING ROOM	18	06/15/2025	ADDED JAIL CAMERAS
5	01/23/2020	ACTALL ADDITIONS	12	07/19/2023	CH1 3RD FLOOR - RELOCATED "INTERPRETER" PANIC TO 307 COURTROOM.	19	07/24/2025	CH2 3RD FLOOR REMODEL / ADDITIONAL ALARMS (3) PANIC BUTTONS, (2) DSI ALARMS


[redacted]

PROJECT
ARAPAHOE COUNTY JUSTICE CENTER
7375 S. POTOMAC STREET
CENTENNIAL, CO 80112

SHEET NAME
SECURITY SITE PLAN

SHEET NUMBER
SE100

REVISION
19

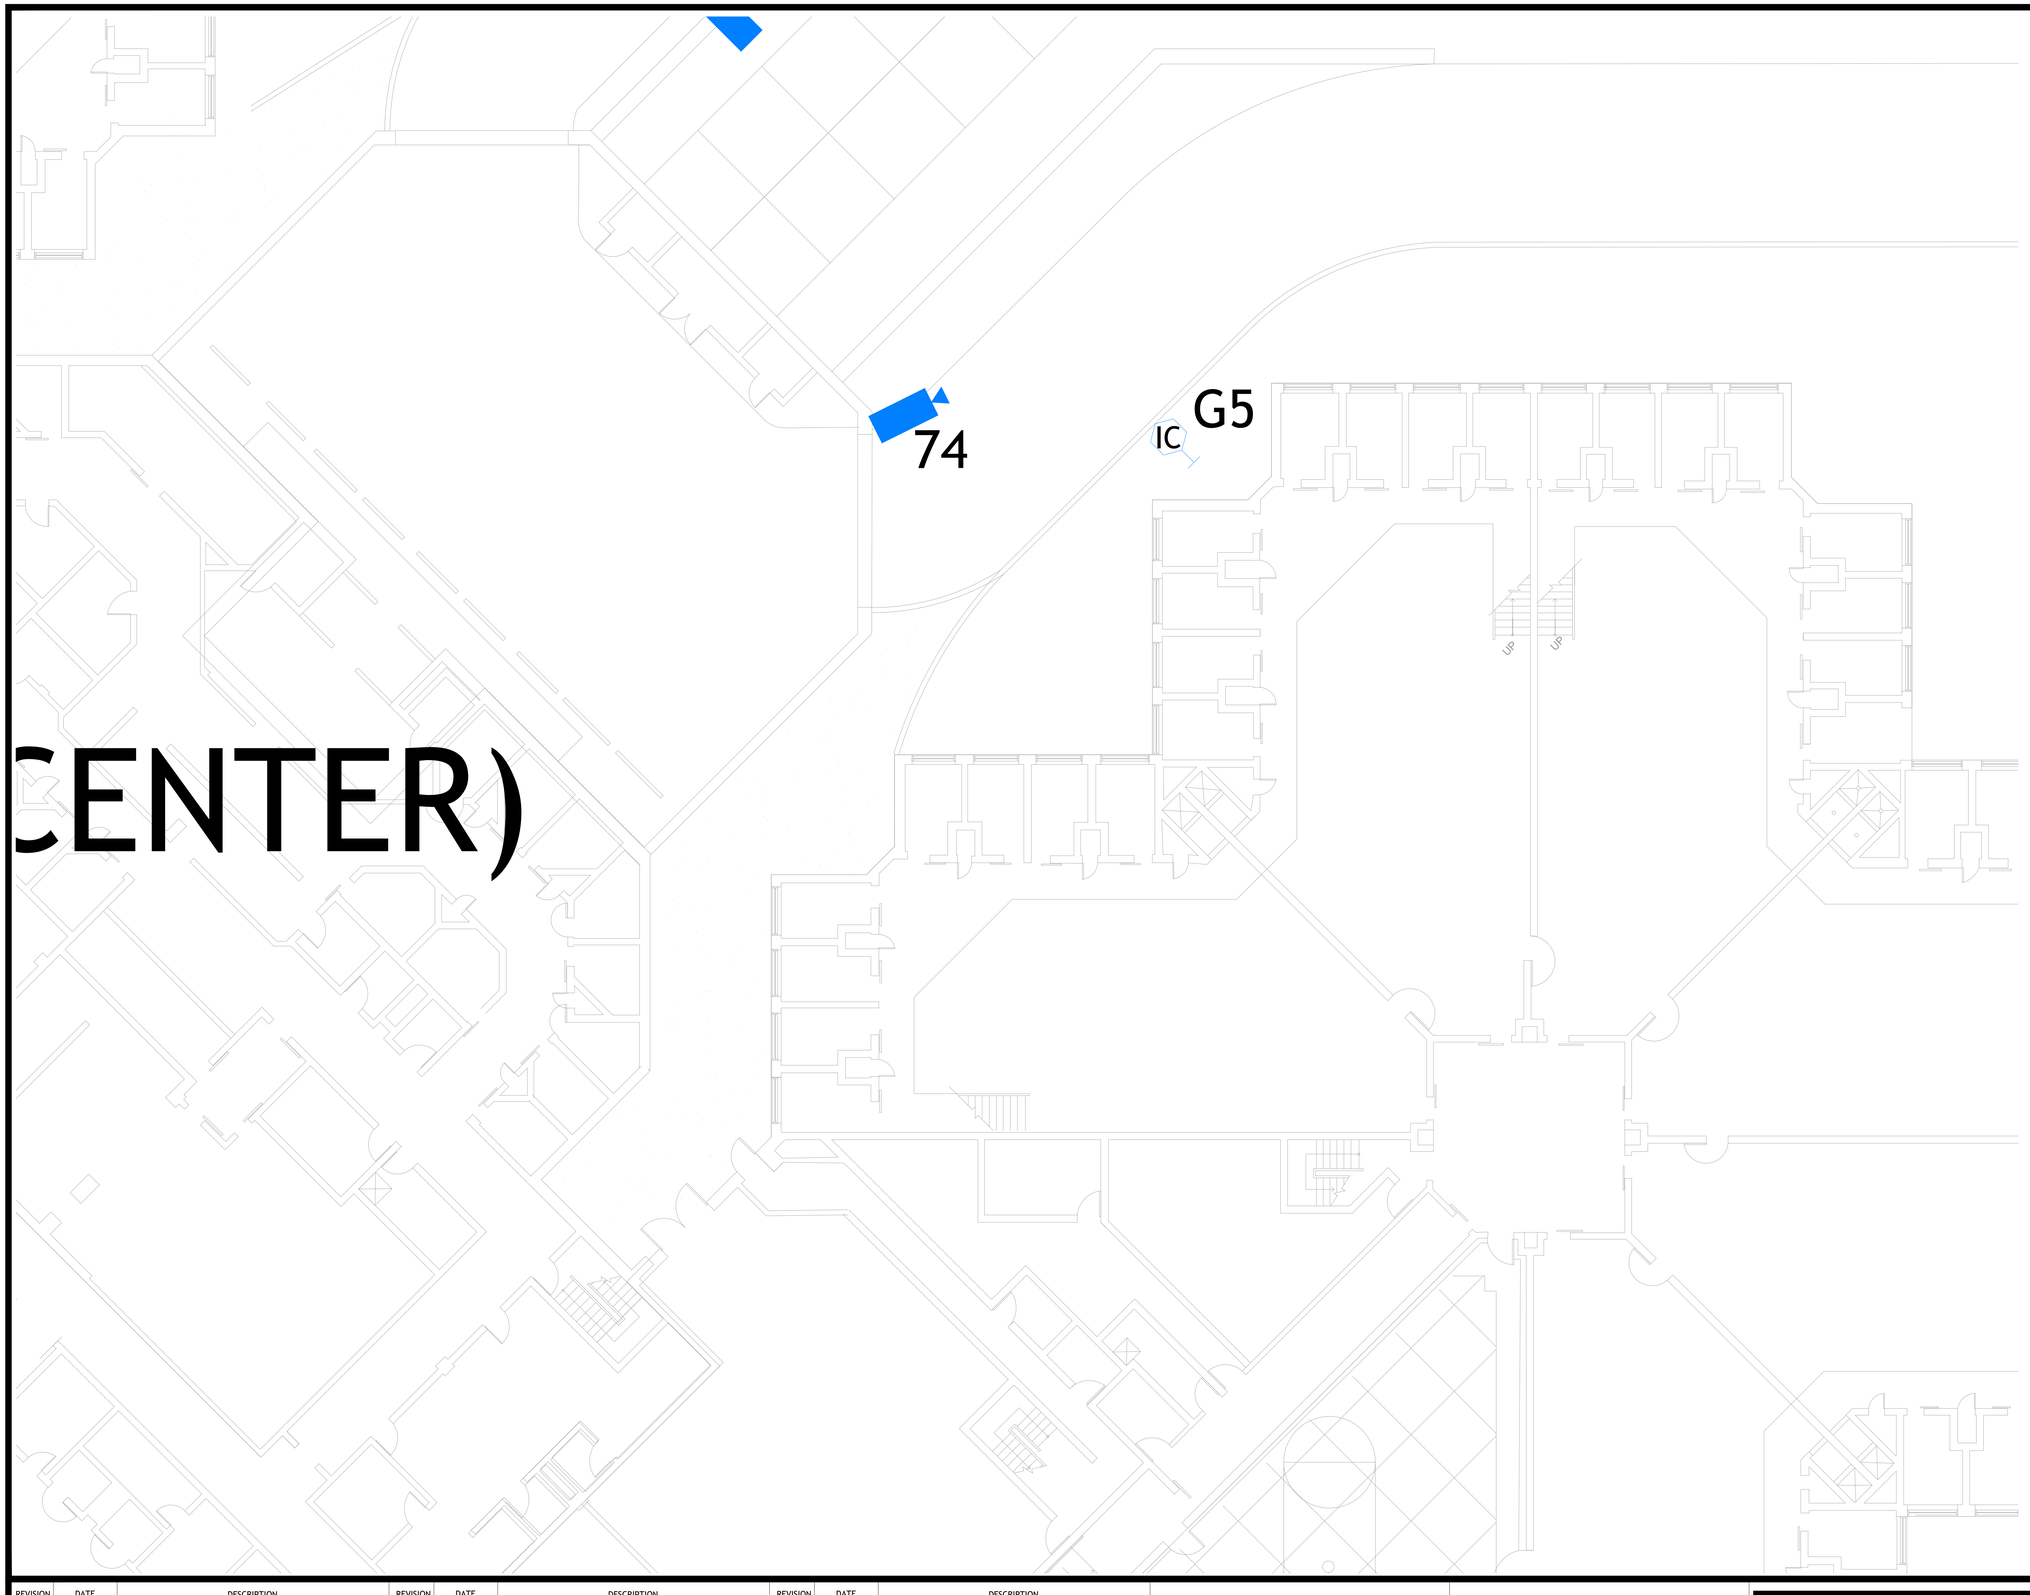

CENTER)

SHEET SE100R4 NOTES:
1.) RUN SURFACE MOUNT CONDUIT FROM NEW IC-G5 TO POD 1 PHONE/EQUIPMENT ROOM 158A.

1 REV 4 DETAIL SHEET
SCALE: NTS

REVISION	DATE	DESCRIPTION	REVISION	DATE	DESCRIPTION	REVISION	DATE	DESCRIPTION
0	11/05/2018	SUBMITTAL	6	04/02/2020	ADDED COURT CAMERAS	13	10/05/2023	ADDITION OF SE GATE - CONTROL, INTERCOM, CAMERA
0.1	12/05/2018	JAIL SHEETS FOR D.O.T. REVIEW	7	09/09/2020	ADDED POD-1 DURESS BUTTON	14	07/09/2024	REMOVAL OF GATE G4 - AS PART OF 2024 ADDITION/REMODEL CONSTRUCTION
1	08/01/2019	AS-BUILT SET	8	11/30/2020	2021 CCTV CAMERA REPLACEMENTS	15	09/05/2024	CH2 3RD FLOOR REMODEL (PHASE 2) (5) PANIC BUTTON RELOCATIONS, (4) DSI ALARMS
2	09/13/2019	ADDED CAMERAS FOR BOOKING, MEDICAL, AND OUTPATIENT	9	07/22/2022	CH2 3RD FLOOR REMODEL (5) PANIC BUTTON RELOCATIONS, (2) DSI ALARMS	16	10/10/2024	(6) ADDED CAMERAS IN CH1 / CH2
3	10/03/2019	ADDED CAMERAS IN PODS 1-6	10	10/26/2022	CH2 3RD FLOOR REMODEL - ADDED DOOR F388X DSI ALARM (PER ASI NO. 4A)	17	04/28/2025	PHASE 2 REMODEL
4	12/26/2019	PEDESTAL INTERCOM "IC-G5" ADDED	11	11/08/2022	CH2 3RD FLOOR REMODEL - ADDED A 6TH PANIC ALARM FOR THE MEETING ROOM	18	06/15/2025	ADDED JAIL CAMERAS
5	01/23/2020	ACTALL ADDITIONS	12	07/19/2023	CH1 3RD FLOOR - RELOCATED "INTERPRETER" PANIC TO 307 COURTROOM.	19	07/24/2025	CH2 3RD FLOOR REMODEL / ADDITIONAL ALARMS (3) PANIC BUTTONS, (2) DSI ALARMS


[redacted]

PROJECT
ARAPAHOE COUNTY JUSTICE CENTER
7375 S. POTOMAC STREET
CENTENNIAL, CO 80112


SHEET NAME
REV 4 DETAIL SHEET

SHEET NUMBER
SE100R4


REVISION
19

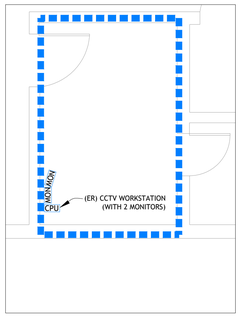

4 RM. 1315 DETAIL
SCALE: 1/4" = 1'-0"

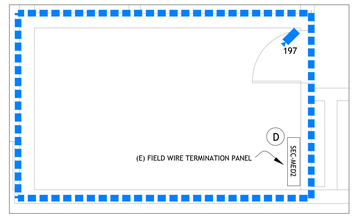

3 RM. 1231 DETAIL
SCALE: 1/4" = 1'-0"

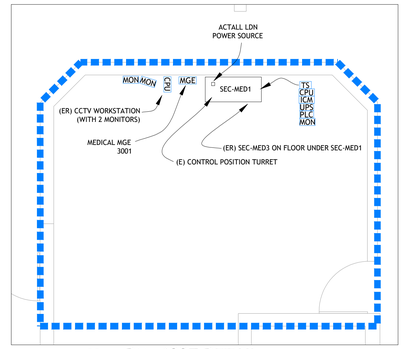


2 RM. 1227 DETAIL
SCALE: 1/4" = 1'-0"



1 SECURITY FLOOR PLAN - JAIL 1ST FLOOR - CORE 1
SCALE: 1/8" = 1'-0"

SHEET SE101 KEYNOTES:
A.) INTERCOM IS A LOCAL AIRPHONE INTERCOM BETWEEN THE NURSE STATION AND THE LIGHT COURT (EXISTING TO REMAIN).
B.) DURESS BUTTON "BC3" REMOVED.
C.) RUBBER ROOM. NO CALL BUTTON OR NURSE CALL INDICATION.
D.) EXISTING NURSE CALL LIGHT POWER SOURCE REMAINS IN THIS CABINET. TRANSFORMERS FOR CELL INTERCOMS LOCATED IN THIS CABINET. MEDICAL AREA INTERCOM, DURESS, AND NURSE CALL LIGHTING WIRE ALL PATCH THROUGH THIS CABINET.

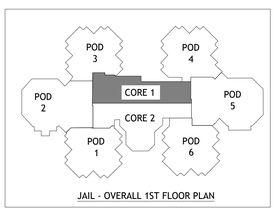

JAIL - OVERALL 1ST FLOOR PLAN

REVISION	DATE	DESCRIPTION
0	11/05/2018	SUBMITTAL
0.1	12/05/2018	JAIL SHEETS FOR D.O.T. REVIEW
1	08/01/2019	AS-BUILT SET
2	09/13/2019	ADDED CAMERAS FOR BOOKING, MEDICAL, AND OUTPATIENT
3	10/03/2019	ADDED CAMERAS IN PODS 1-6
4	12/26/2019	PEDESTAL INTERCOM "IC-G5" ADDED
5	01/23/2020	ACTALL ADDITIONS
6	04/02/2020	ADDED COURT CAMERAS
7	09/09/2020	ADDED POD-1 DURESS BUTTON
8	11/30/2020	2021 CCTV CAMERA REPLACEMENTS
9	07/22/2022	CH2 3RD FLOOR REMODEL (5) PANIC BUTTON RELOCATIONS, (2) DSI ALARMS
10	10/26/2022	CH2 3RD FLOOR REMODEL - ADDED DOOR F388X DSI ALARM (PER ASI NO. 4A)
11	11/08/2022	CH2 3RD FLOOR REMODEL - ADDED A 6TH PANIC ALARM FOR THE MEETING ROOM
12	07/19/2023	CH1 3RD FLOOR - RELOCATED "INTERPRETER" PANIC TO 307 COURTROOM.
13	10/05/2023	ADDITION OF SE GATE - CONTROL, INTERCOM, CAMERA
14	07/09/2024	REMOVAL OF GATE G4 - AS PART OF 2024 ADDITION/REMODEL CONSTRUCTION
15	09/05/2024	CH2 3RD FLOOR REMODEL (PHASE 2) (5) PANIC BUTTON RELOCATIONS, (4) DSI ALARMS
16	10/10/2024	(6) ADDED CAMERAS IN CH1 / CH2
17	04/28/2025	PHASE 2 REMODEL
18	06/15/2025	ADDED JAIL CAMERAS
19	07/24/2025	CH2 3RD FLOOR REMODEL / ADDITIONAL ALARMS (3) PANIC BUTTONS, (2) DSI ALARMS


[redacted]

PROJECT
ARAPAHOE COUNTY JUSTICE CENTER
7375 S. POTOMAC STREET
CENTENNIAL, CO 80112

SHEET NAME
SECURITY FLOOR PLAN -
JAIL 1ST FLOOR - CORE 1

SHEET NUMBER
SE101

REVISION
19

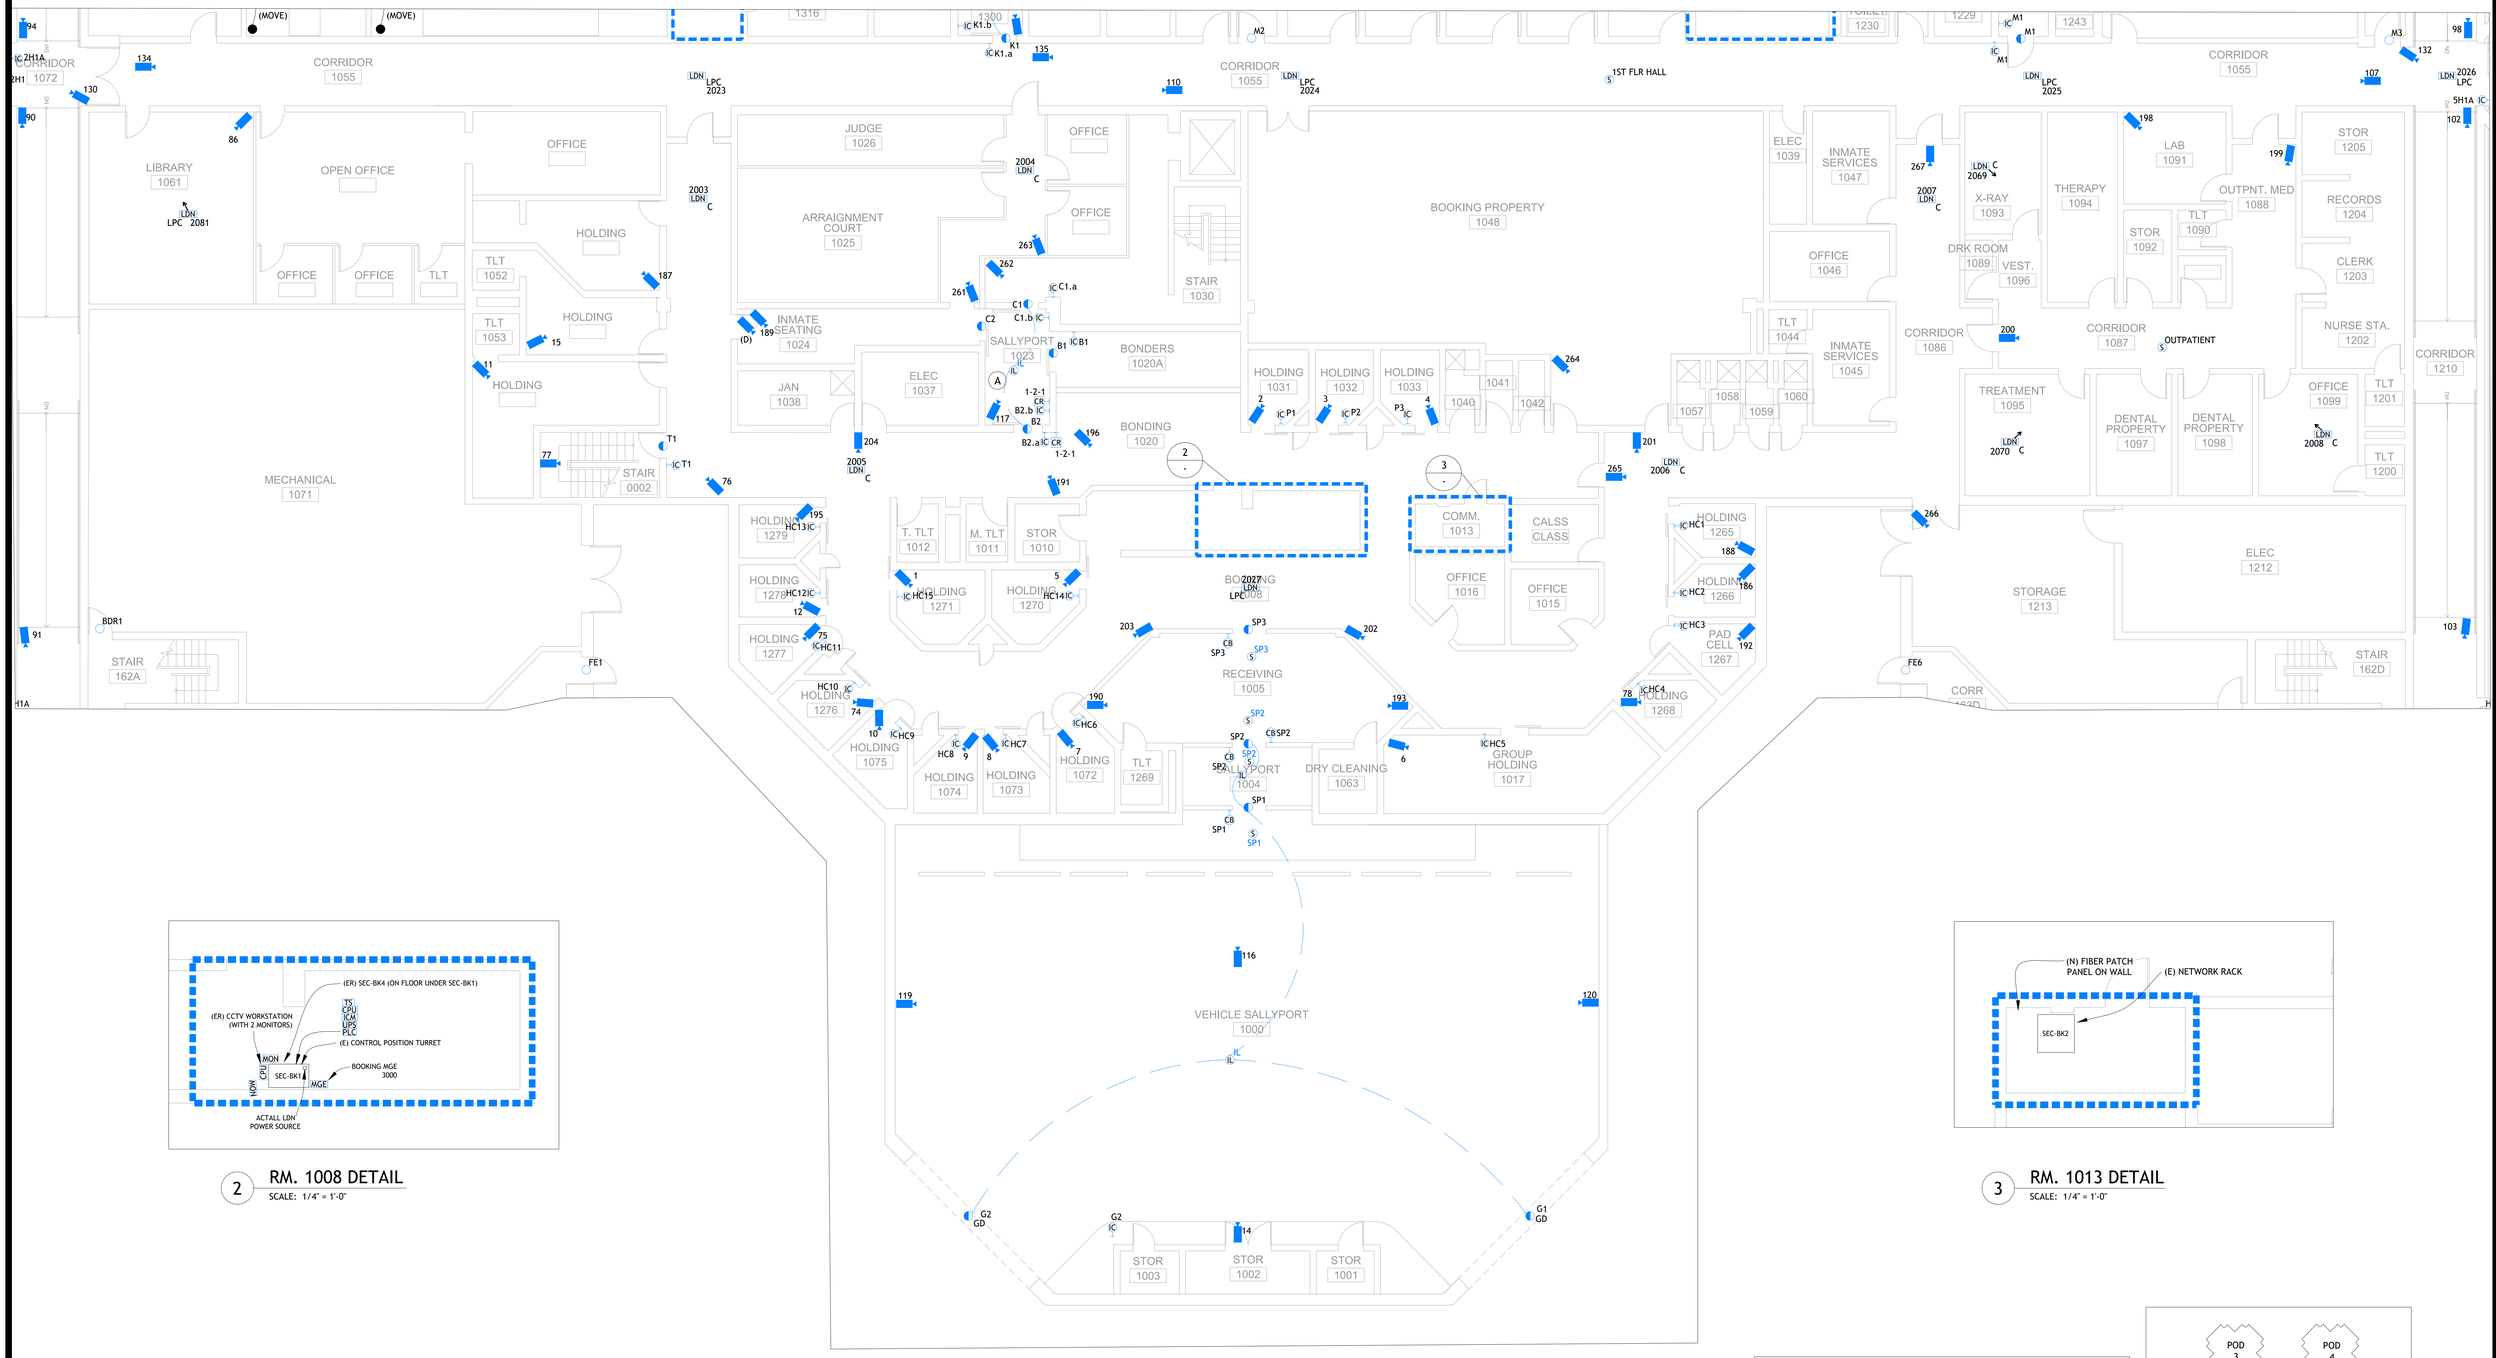


2 RM. 1008 DETAIL
SCALE: 1/4" = 1'-0"

3 RM. 1013 DETAIL
SCALE: 1/4" = 1'-0"

1 SECURITY FLOOR PLAN - JAIL 1ST FLOOR - CORE 2
SCALE: 1/8" = 1'-0"

SHEET SE102 KEYNOTES:
A.) DOOR "B2" IS EQUIPPED WITH AN AUTOMATIC DOOR CLOSING MESSAGE. THIS IS CONTROLLED THROUGH THE CARD ACCESS SYSTEM. THE AMP AND CONTROL HARDWARE FOR THIS MESSAGE ARE IN ROOM 2049.

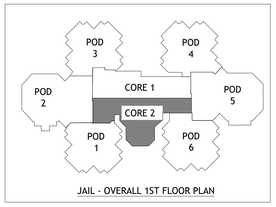

JAIL - OVERALL 1ST FLOOR PLAN

REVISION	DATE	DESCRIPTION
0	11/05/2018	SUBMITTAL
0.1	12/05/2018	JAIL SHEETS FOR D.O.T. REVIEW
1	08/01/2019	AS-BUILT SET
2	09/13/2019	ADDED CAMERAS FOR BOOKING, MEDICAL, AND OUTPATIENT
3	10/03/2019	ADDED CAMERAS IN PODS 1-6
4	12/26/2019	PEDESTAL INTERCOM "IC-G5" ADDED
5	01/23/2020	ACTALL ADDITIONS
6	04/02/2020	ADDED COURT CAMERAS
7	09/09/2020	ADDED POD-1 DURESS BUTTON
8	11/30/2020	2021 CCTV CAMERA REPLACEMENTS
9	07/22/2022	CH2 3RD FLOOR REMODEL (5) PANIC BUTTON RELOCATIONS, (2) DSI ALARMS
10	10/26/2022	CH2 3RD FLOOR REMODEL - ADDED DOOR F388X DSI ALARM (PER ASI NO. 4A)
11	11/08/2022	CH2 3RD FLOOR REMODEL - ADDED A 6TH PANIC ALARM FOR THE MEETING ROOM
12	07/19/2023	CH1 3RD FLOOR - RELOCATED "INTERPRETER" PANIC TO 307 COURTROOM.
13	10/05/2023	ADDITION OF SE GATE - CONTROL, INTERCOM, CAMERA
14	07/09/2024	REMOVAL OF GATE G4 - AS PART OF 2024 ADDITION/REMODEL CONSTRUCTION
15	09/05/2024	CH2 3RD FLOOR REMODEL (PHASE 2) (5) PANIC BUTTON RELOCATIONS, (4) DSI ALARMS
16	10/10/2024	(6) ADDED CAMERAS IN CH1 / CH2
17	04/28/2025	PHASE 2 REMODEL
18	06/15/2025	ADDED JAIL CAMERAS
19	07/24/2025	CH2 3RD FLOOR REMODEL / ADDITIONAL ALARMS (3) PANIC BUTTONS, (2) DSI ALARMS


[redacted]

PROJECT
ARAPAHOE COUNTY JUSTICE CENTER
7375 S. POTOMAC STREET
CENTENNIAL, CO 80112


SHEET NAME
SECURITY FLOOR PLAN -
JAIL 1ST FLOOR - CORE 2

SHEET NUMBER
SE102


REVISION
19

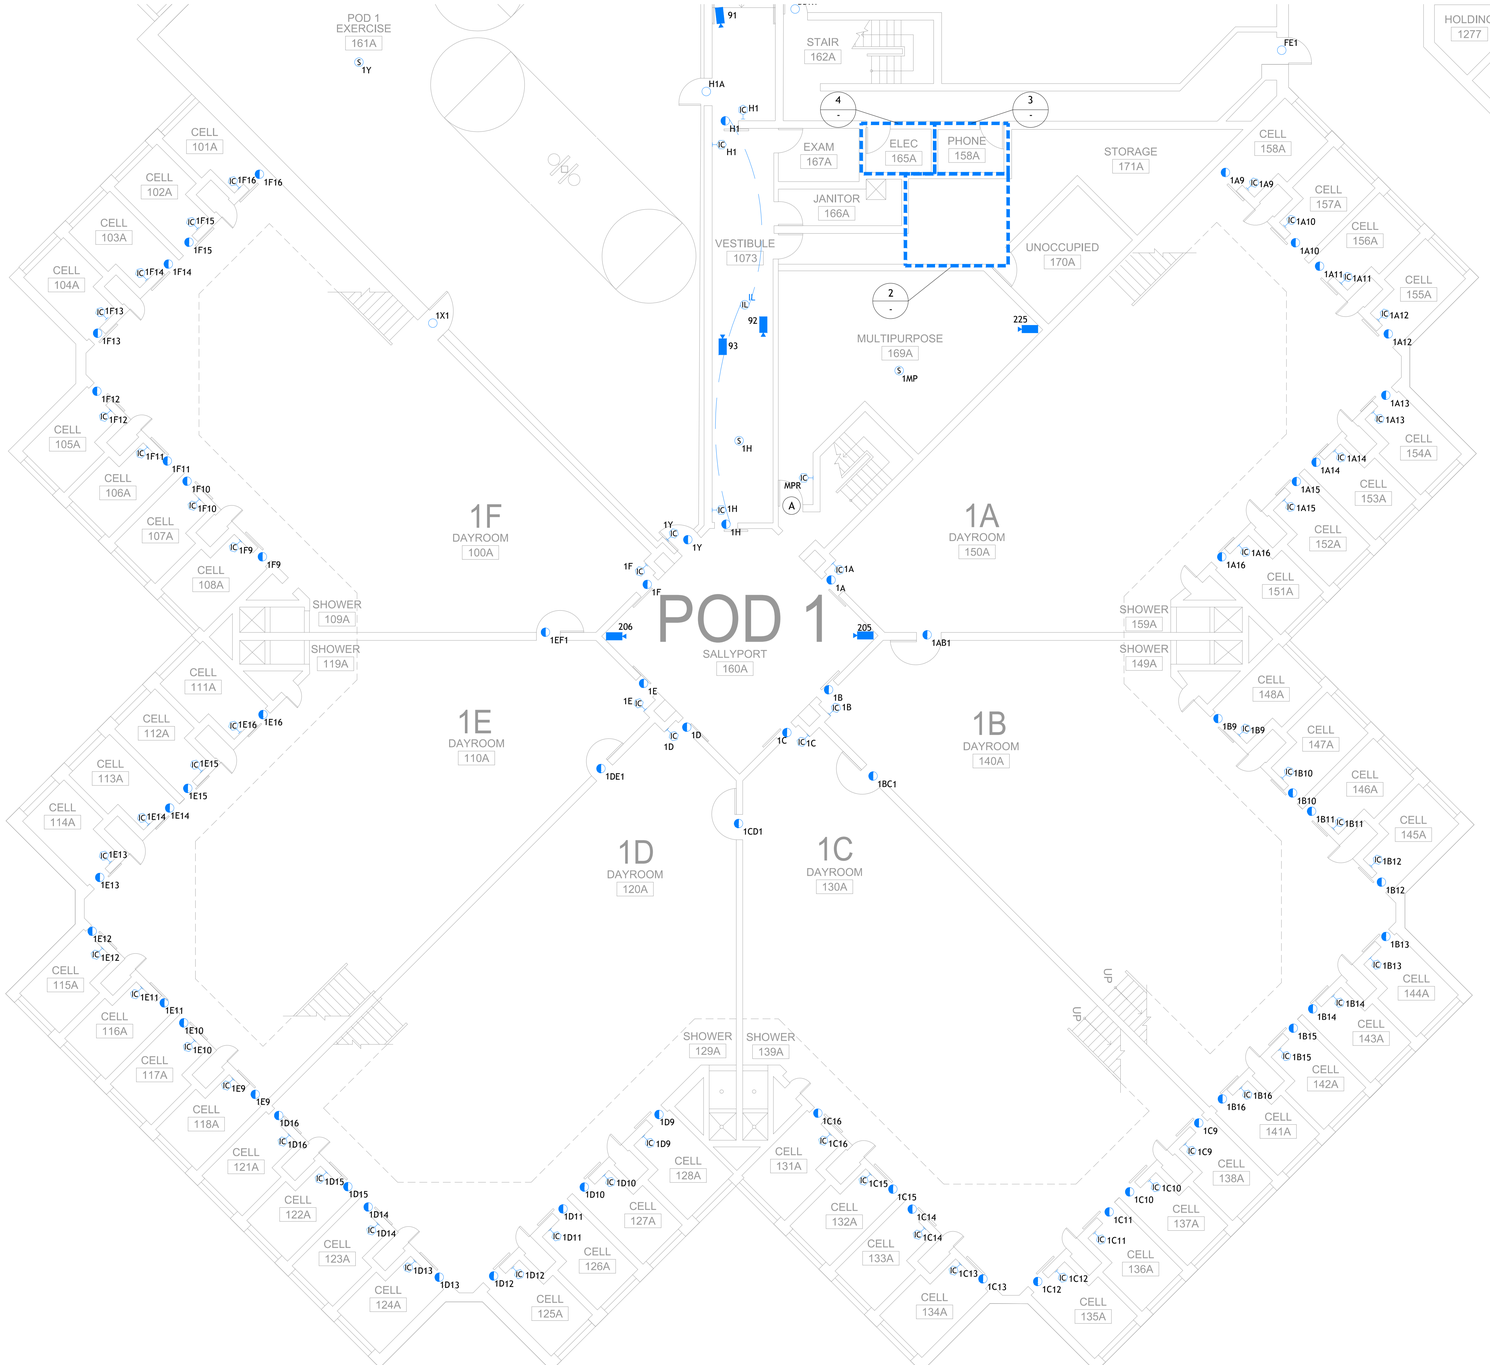


1 SECURITY FLOOR PLAN - JAIL 1ST FLOOR - POD 1
SCALE: 1/8" = 1'-0"

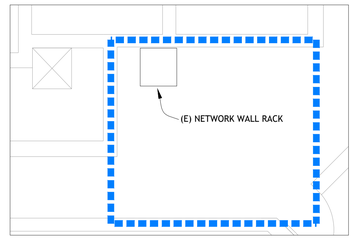

2 RM. 171A DETAIL
SCALE: 1/4" = 1'-0"

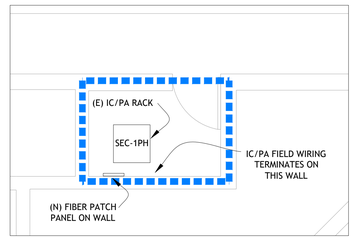


3 RM. 158A DETAIL
SCALE: 1/4" = 1'-0"

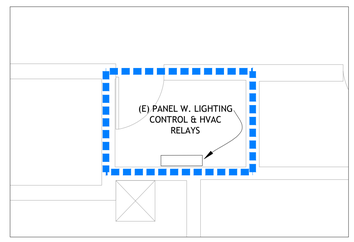

4 RM. 165A DETAIL
SCALE: 1/4" = 1'-0"

SHEET SE103 KEYNOTES:
A.) ELECTRIC LOCK ON THIS DOOR MECHANICALLY DISABLED AND NO LONGER USED.

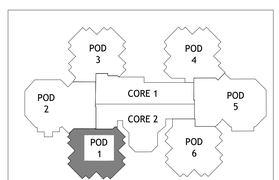

JAIL - OVERALL 1ST FLOOR PLAN

REVISION	DATE	DESCRIPTION
0	11/05/2018	SUBMITTAL
0.1	12/05/2018	JAIL SHEETS FOR D.O.T. REVIEW
1	08/01/2019	AS-BUILT SET
2	09/13/2019	ADDED CAMERAS FOR BOOKING, MEDICAL, AND OUTPATIENT
3	10/03/2019	ADDED CAMERAS IN PODS 1-6
4	12/26/2019	PEDESTAL INTERCOM "IC-G5" ADDED
5	01/23/2020	ACTALL ADDITIONS
6	04/02/2020	ADDED COURT CAMERAS
7	09/09/2020	ADDED POD-1 DURESS BUTTON
8	11/30/2020	2021 CCTV CAMERA REPLACEMENTS
9	07/22/2022	CH2 3RD FLOOR REMODEL (5) PANIC BUTTON RELOCATIONS, (2) DSI ALARMS
10	10/26/2022	CH2 3RD FLOOR REMODEL - ADDED DOOR F388X DSI ALARM (PER ASI NO. 4A)
11	11/08/2022	CH2 3RD FLOOR REMODEL - ADDED A 6TH PANIC ALARM FOR THE MEETING ROOM
12	07/19/2023	CH1 3RD FLOOR - RELOCATED "INTERPRETER" PANIC TO 307 COURTROOM.
13	10/05/2023	ADDITION OF SE GATE - CONTROL, INTERCOM, CAMERA
14	07/09/2024	REMOVAL OF GATE G4 - AS PART OF 2024 ADDITION/REMODEL CONSTRUCTION
15	09/05/2024	CH2 3RD FLOOR REMODEL (PHASE 2) (5) PANIC BUTTON RELOCATIONS, (4) DSI ALARMS
16	10/10/2024	(6) ADDED CAMERAS IN CH1 / CH2
17	04/28/2025	PHASE 2 REMODEL
18	06/15/2025	ADDED JAIL CAMERAS
19	07/24/2025	CH2 3RD FLOOR REMODEL / ADDITIONAL ALARMS (3) PANIC BUTTONS, (2) DSI ALARMS


[redacted]

PROJECT
ARAPAHOE COUNTY JUSTICE CENTER
7375 S. POTOMAC STREET
CENTENNIAL, CO 80112

SHEET NAME
SECURITY FLOOR PLAN -
JAIL 1ST FLOOR - POD 1


SHEET NUMBER
SE103

REVISION
19

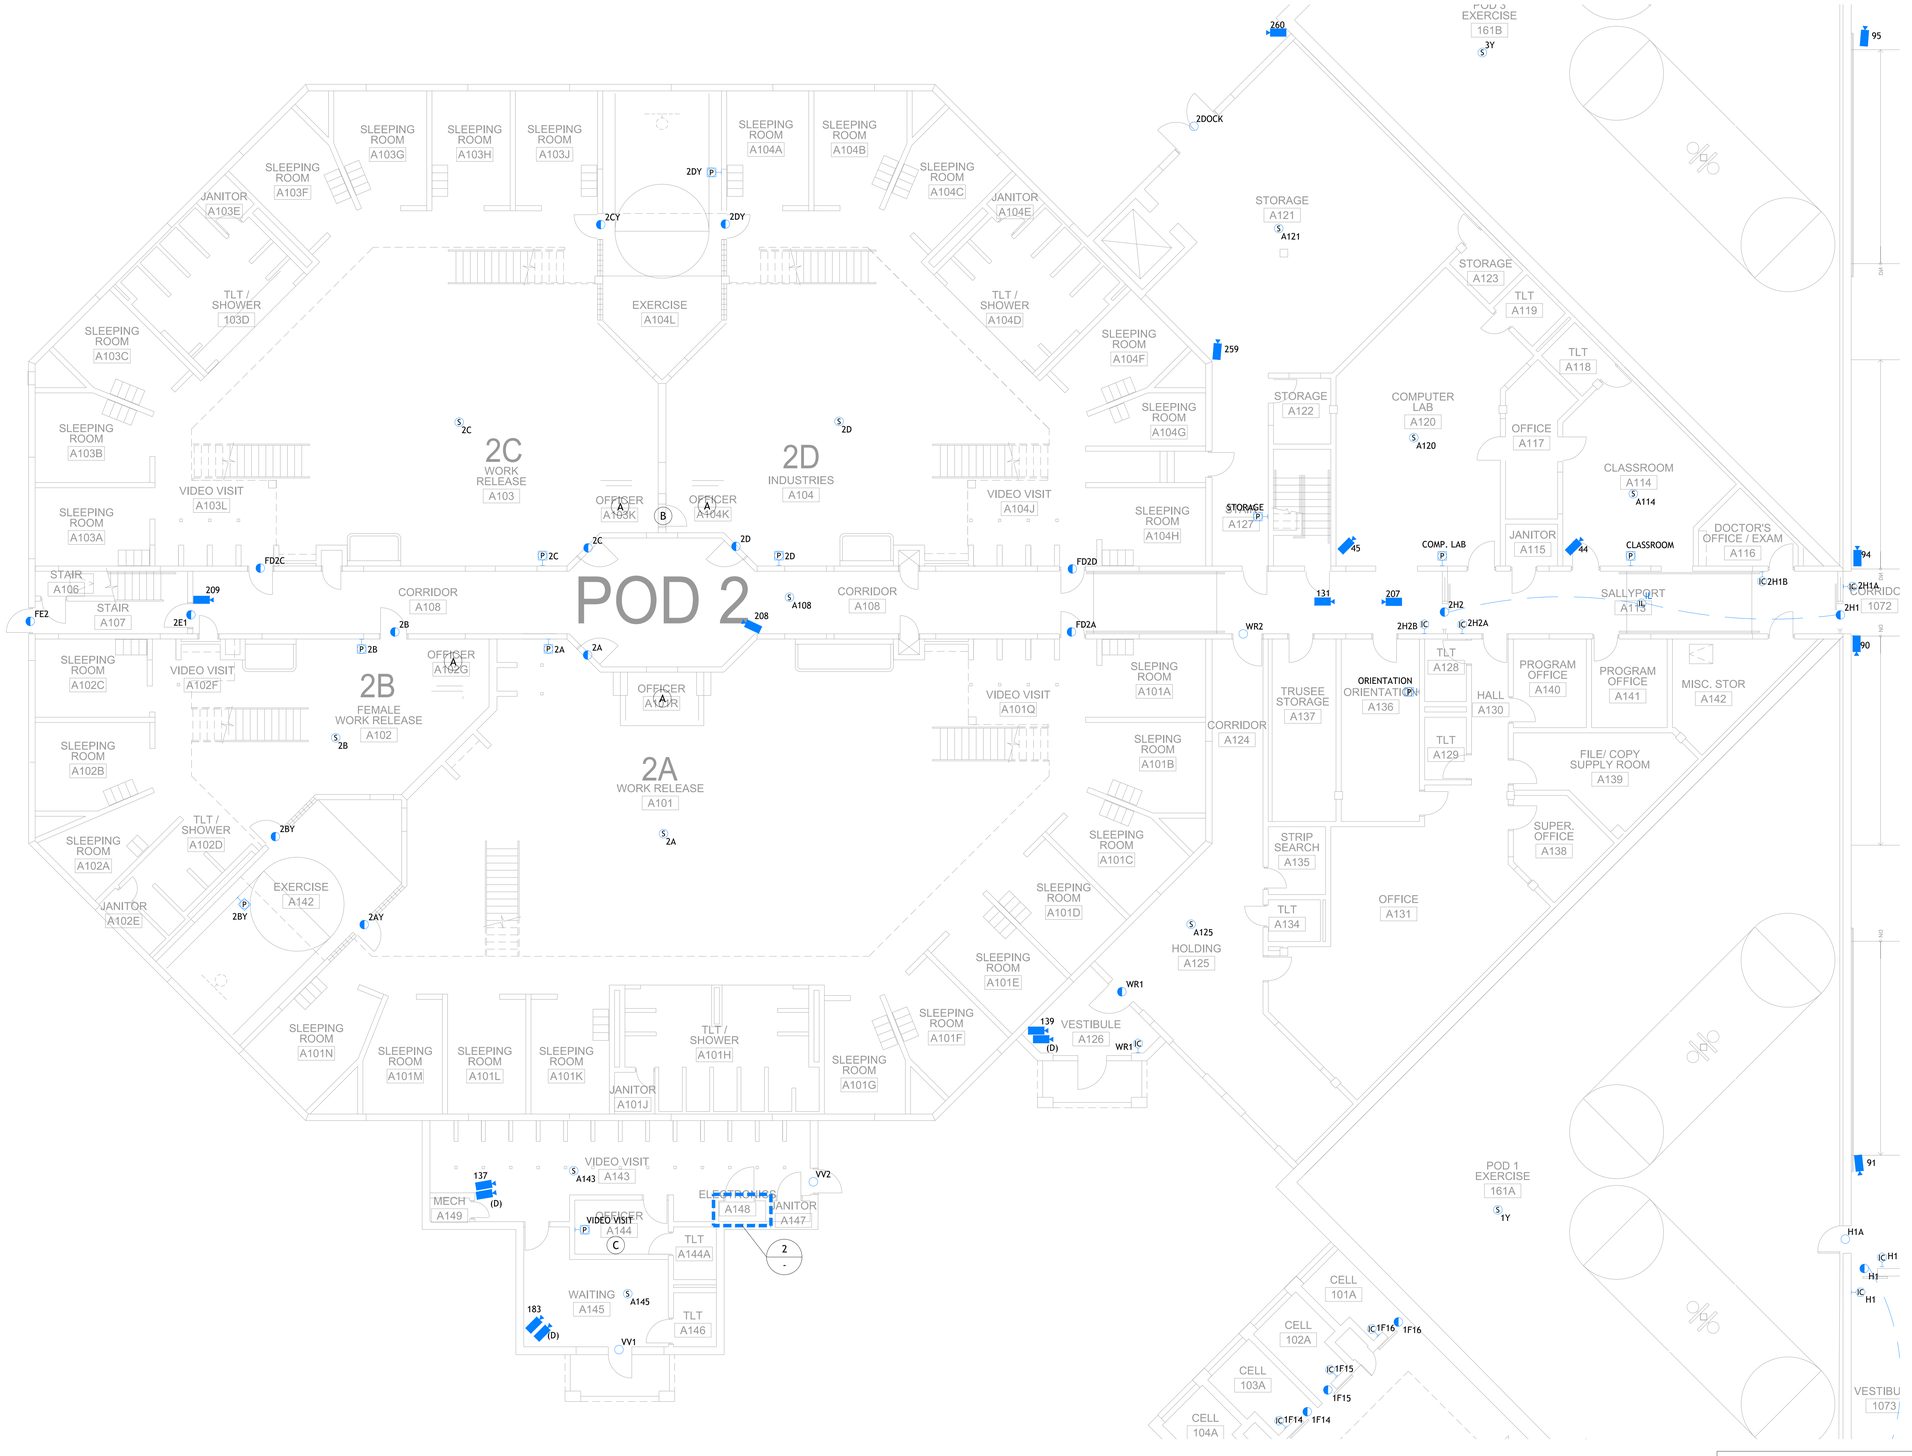

1 SECURITY FLOOR PLAN - JAIL 1ST FLOOR - POD 2


SCALE: 1/8" = 1'-0"

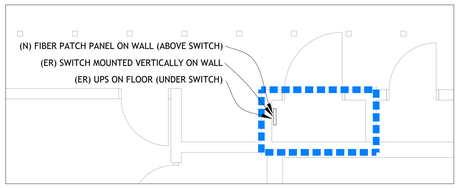

2 RM. A148 DETAIL

SCALE: 1/4" = 1'-0"

SHEET SE104 KEYNOTES:
A.) OFFICER STATION HAS AN ABANDONED KEY SWITCH.
B.) DOOR EQUIPPED WITH AN ELECTRIC LOCK THAT IS NO LONGER USED.
C.) LOCAL REX BUTTON OPENS VV1.

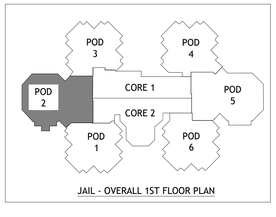

JAIL - OVERALL 1ST FLOOR PLAN

REVISION	DATE	DESCRIPTION
0	11/05/2018	SUBMITTAL
0.1	12/05/2018	JAIL SHEETS FOR D.O.T. REVIEW
1	08/01/2019	AS-BUILT SET
2	09/13/2019	ADDED CAMERAS FOR BOOKING, MEDICAL, AND OUTPATIENT
3	10/03/2019	ADDED CAMERAS IN PODS 1-6
4	12/26/2019	PEDESTAL INTERCOM "IC-G5" ADDED
5	01/23/2020	ACTALL ADDITIONS
6	04/02/2020	ADDED COURT CAMERAS
7	09/09/2020	ADDED POD-1 DURESS BUTTON
8	11/30/2020	2021 CCTV CAMERA REPLACEMENTS
9	07/22/2022	CH2 3RD FLOOR REMODEL (5) PANIC BUTTON RELOCATIONS, (2) DSI ALARMS
10	10/26/2022	CH2 3RD FLOOR REMODEL - ADDED DOOR F388X DSI ALARM (PER ASI NO. 4A)
11	11/08/2022	CH2 3RD FLOOR REMODEL - ADDED A 6TH PANIC ALARM FOR THE MEETING ROOM
12	07/19/2023	CH1 3RD FLOOR - RELOCATED "INTERPRETER" PANIC TO 307 COURTROOM.
13	10/05/2023	ADDITION OF SE GATE - CONTROL, INTERCOM, CAMERA
14	07/09/2024	REMOVAL OF GATE G4 - AS PART OF 2024 ADDITION/REMODEL CONSTRUCTION
15	09/05/2024	CH2 3RD FLOOR REMODEL (PHASE 2) (5) PANIC BUTTON RELOCATIONS, (4) DSI ALARMS
16	10/10/2024	(6) ADDED CAMERAS IN CH1 / CH2
17	04/28/2025	PHASE 2 REMODEL
18	06/15/2025	ADDED JAIL CAMERAS
19	07/24/2025	CH2 3RD FLOOR REMODEL / ADDITIONAL ALARMS (3) PANIC BUTTONS, (2) DSI ALARMS

[redacted]

PROJECT

ARAPAHOE COUNTY JUSTICE CENTER
7375 S. POTOMAC STREET
CENTENNIAL, CO 80112

SHEET NAME


SECURITY FLOOR PLAN -
JAIL 1ST FLOOR - POD 2

SHEET NUMBER

SE104


REVISION

19

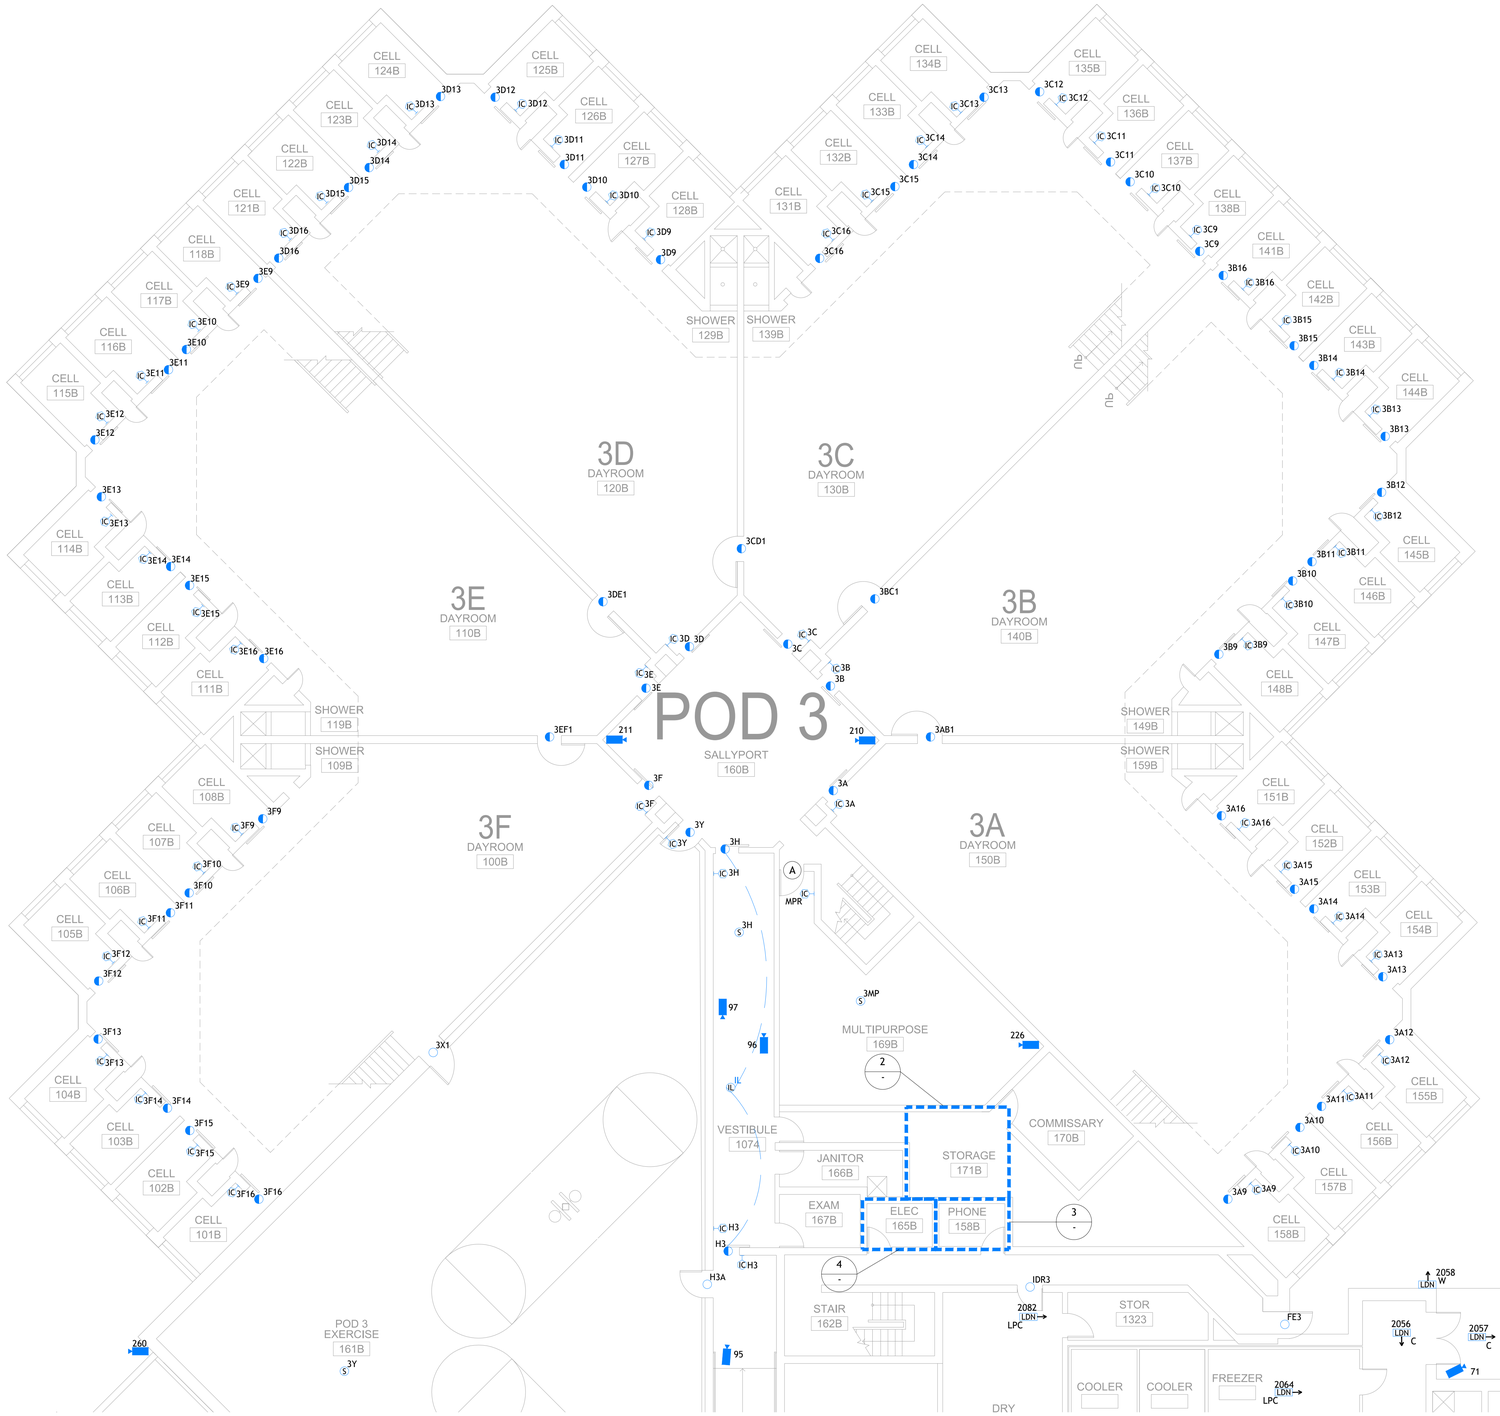


1 SECURITY FLOOR PLAN - JAIL 1ST FLOOR - POD 3

SCALE: 1/8" = 1'-0"

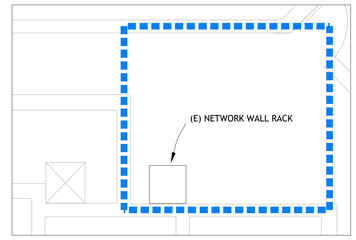


2 RM. 171B DETAIL

SCALE: 1/4" = 1'-0"

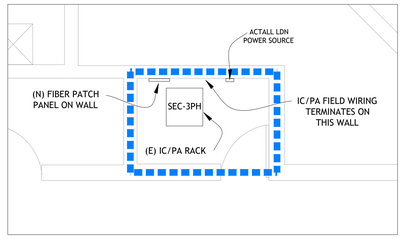

3 RM. 158B DETAIL


SCALE: 1/4" = 1'-0"

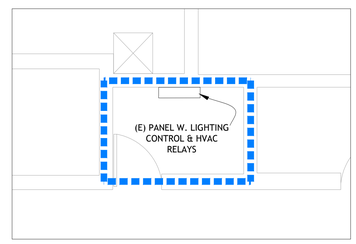

4 RM. 165B DETAIL

SCALE: 1/4" = 1'-0"

SHEET SE105 KEYNOTES:
A.) ELECTRIC LOCK ON THIS DOOR MECHANICALLY DISABLED AND NO LONGER USED.

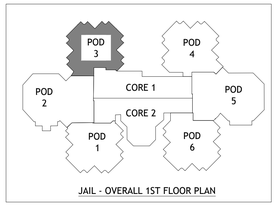

JAIL - OVERALL 1ST FLOOR PLAN

REVISION	DATE	DESCRIPTION
0	11/05/2018	SUBMITTAL
0.1	12/05/2018	JAIL SHEETS FOR D.O.T. REVIEW
1	08/01/2019	AS-BUILT SET
2	09/13/2019	ADDED CAMERAS FOR BOOKING, MEDICAL, AND OUTPATIENT
3	10/03/2019	ADDED CAMERAS IN PODS 1-6
4	12/26/2019	PEDESTAL INTERCOM "IC-G5" ADDED
5	01/23/2020	ACTALL ADDITIONS
6	04/02/2020	ADDED COURT CAMERAS
7	09/09/2020	ADDED POD-1 DURESS BUTTON
8	11/30/2020	2021 CCTV CAMERA REPLACEMENTS
9	07/22/2022	CH2 3RD FLOOR REMODEL (5) PANIC BUTTON RELOCATIONS, (2) DSI ALARMS
10	10/26/2022	CH2 3RD FLOOR REMODEL - ADDED DOOR F388X DSI ALARM (PER ASI NO. 4A)
11	11/08/2022	CH2 3RD FLOOR REMODEL - ADDED A 6TH PANIC ALARM FOR THE MEETING ROOM
12	07/19/2023	CH1 3RD FLOOR - RELOCATED "INTERPRETER" PANIC TO 307 COURTROOM.
13	10/05/2023	ADDITION OF SE GATE - CONTROL, INTERCOM, CAMERA
14	07/09/2024	REMOVAL OF GATE G4 - AS PART OF 2024 ADDITION/REMODEL CONSTRUCTION
15	09/05/2024	CH2 3RD FLOOR REMODEL (PHASE 2) (5) PANIC BUTTON RELOCATIONS, (4) DSI ALARMS
16	10/10/2024	(6) ADDED CAMERAS IN CH1 / CH2
17	04/28/2025	PHASE 2 REMODEL
18	06/15/2025	ADDED JAIL CAMERAS
19	07/24/2025	CH2 3RD FLOOR REMODEL / ADDITIONAL ALARMS (3) PANIC BUTTONS, (2) DSI ALARMS

[redacted]

PROJECT

ARAPAHOE COUNTY JUSTICE CENTER
7375 S. POTOMAC STREET
CENTENNIAL, CO 80112

SHEET NAME


SECURITY FLOOR PLAN -
JAIL 1ST FLOOR - POD 3

SHEET NUMBER


SE105

REVISION


19

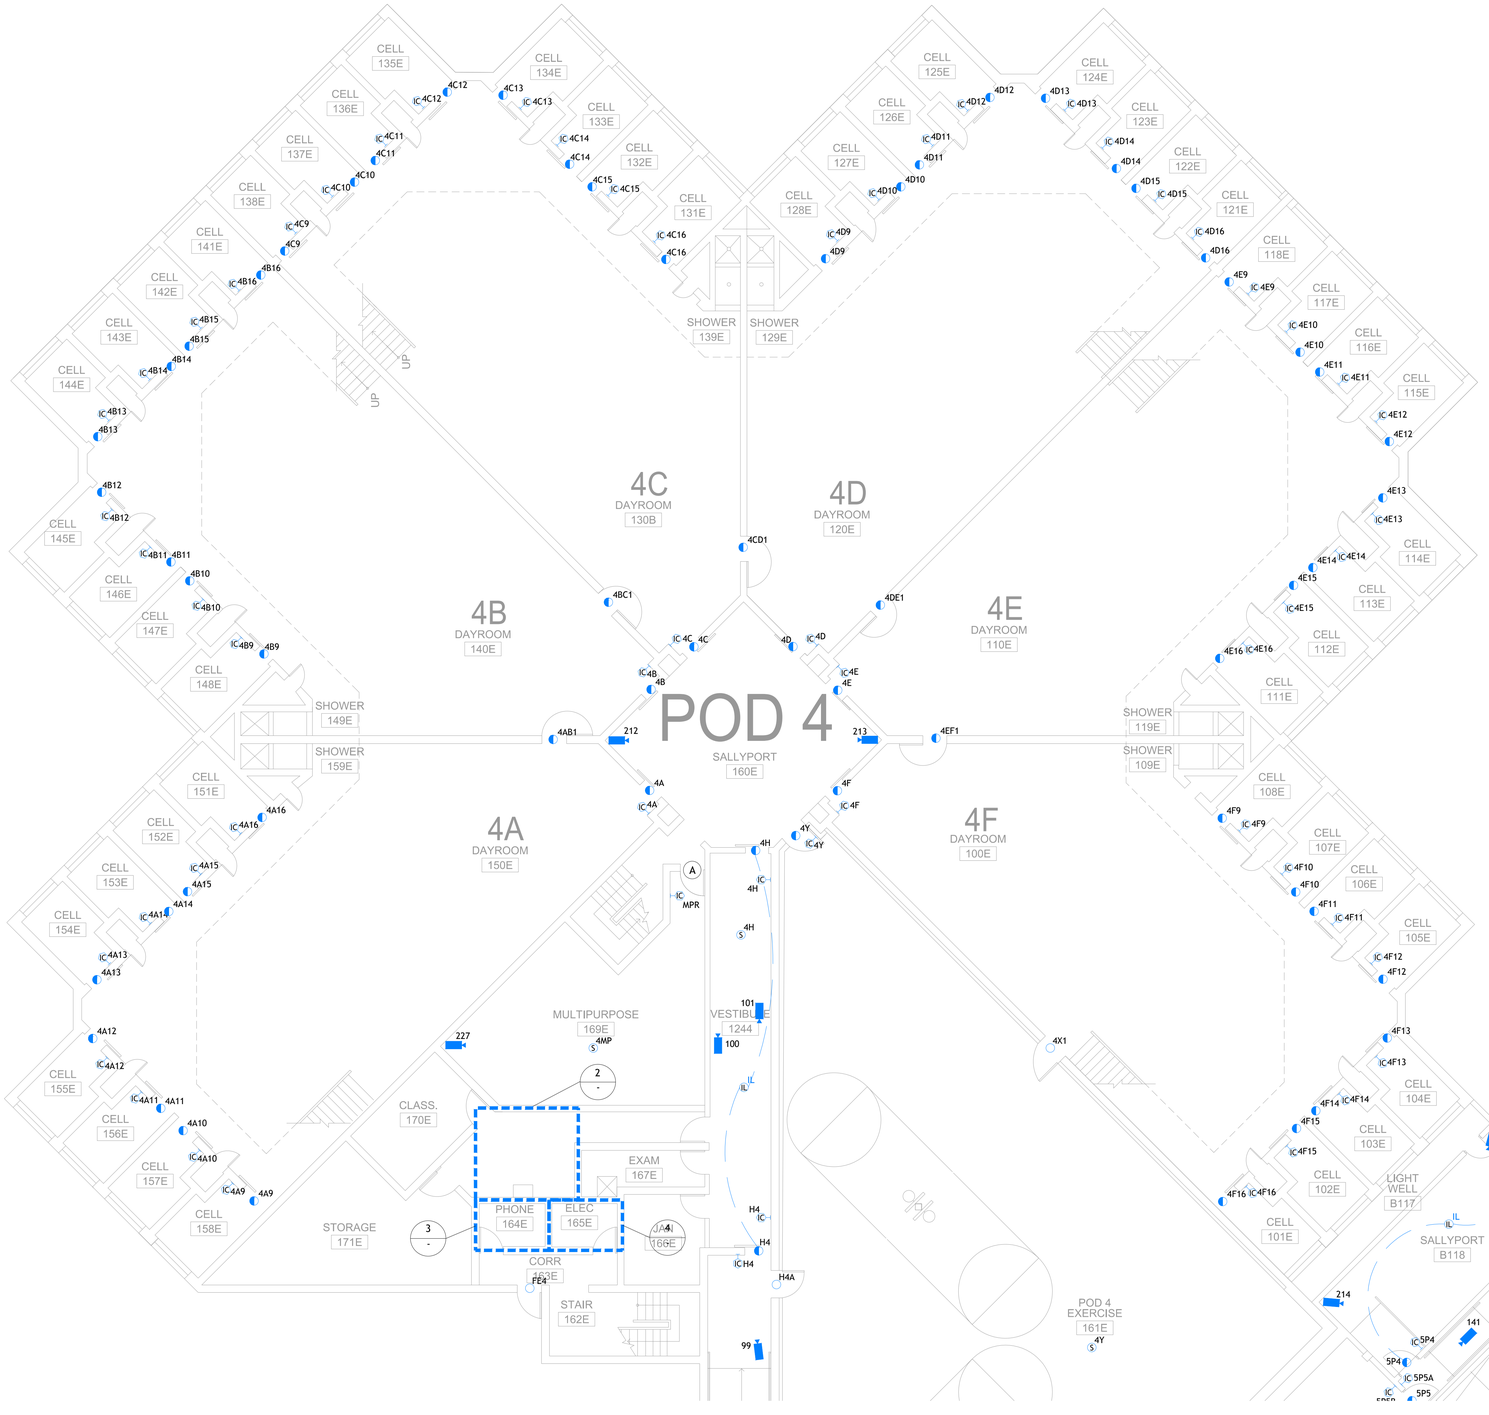


1 SECURITY FLOOR PLAN - JAIL 1ST FLOOR - POD 4
SCALE: 1/8" = 1'-0"

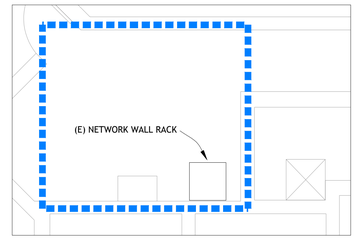

2 RM. 171E DETAIL
SCALE: 1/4" = 1'-0"

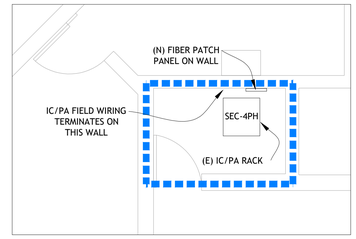


3 RM. 164E DETAIL
SCALE: 1/4" = 1'-0"

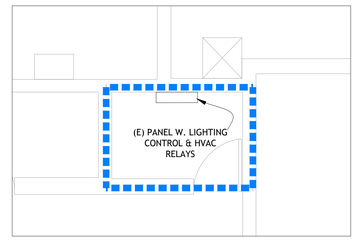

4 RM. 165E DETAIL
SCALE: 1/4" = 1'-0"

SHEET SE106 KEYNOTES:
A.) ELECTRIC LOCK ON THIS DOOR MECHANICALLY DISABLED AND NO LONGER USED.

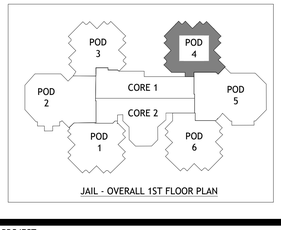

JAIL - OVERALL 1ST FLOOR PLAN

REVISION	DATE	DESCRIPTION
0	11/05/2018	SUBMITTAL
0.1	12/05/2018	JAIL SHEETS FOR D.O.T. REVIEW
1	08/01/2019	AS-BUILT SET
2	09/13/2019	ADDED CAMERAS FOR BOOKING, MEDICAL, AND OUTPATIENT
3	10/03/2019	ADDED CAMERAS IN PODS 1-6
4	12/26/2019	PEDESTAL INTERCOM "IC-G5" ADDED
5	01/23/2020	ACTALL ADDITIONS
6	04/02/2020	ADDED COURT CAMERAS
7	09/09/2020	ADDED POD-1 DURESS BUTTON
8	11/30/2020	2021 CCTV CAMERA REPLACEMENTS
9	07/22/2022	CH2 3RD FLOOR REMODEL (5) PANIC BUTTON RELOCATIONS, (2) DSI ALARMS
10	10/26/2022	CH2 3RD FLOOR REMODEL - ADDED DOOR F388X DSI ALARM (PER ASI NO. 4A)
11	11/08/2022	CH2 3RD FLOOR REMODEL - ADDED A 6TH PANIC ALARM FOR THE MEETING ROOM
12	07/19/2023	CH1 3RD FLOOR - RELOCATED "INTERPRETER" PANIC TO 307 COURTROOM.
13	10/05/2023	ADDITION OF SE GATE - CONTROL, INTERCOM, CAMERA
14	07/09/2024	REMOVAL OF GATE G4 - AS PART OF 2024 ADDITION/REMODEL CONSTRUCTION
15	09/05/2024	CH2 3RD FLOOR REMODEL (PHASE 2) (5) PANIC BUTTON RELOCATIONS, (4) DSI ALARMS
16	10/10/2024	(6) ADDED CAMERAS IN CH1 / CH2
17	04/28/2025	PHASE 2 REMODEL
18	06/15/2025	ADDED JAIL CAMERAS
19	07/24/2025	CH2 3RD FLOOR REMODEL / ADDITIONAL ALARMS (3) PANIC BUTTONS, (2) DSI ALARMS


[redacted]

PROJECT
ARAPAHOE COUNTY JUSTICE CENTER
7375 S. POTOMAC STREET
CENTENNIAL, CO 80112

SHEET NAME
SECURITY FLOOR PLAN -
JAIL 1ST FLOOR - POD 4

SHEET NUMBER
SE106


REVISION
19

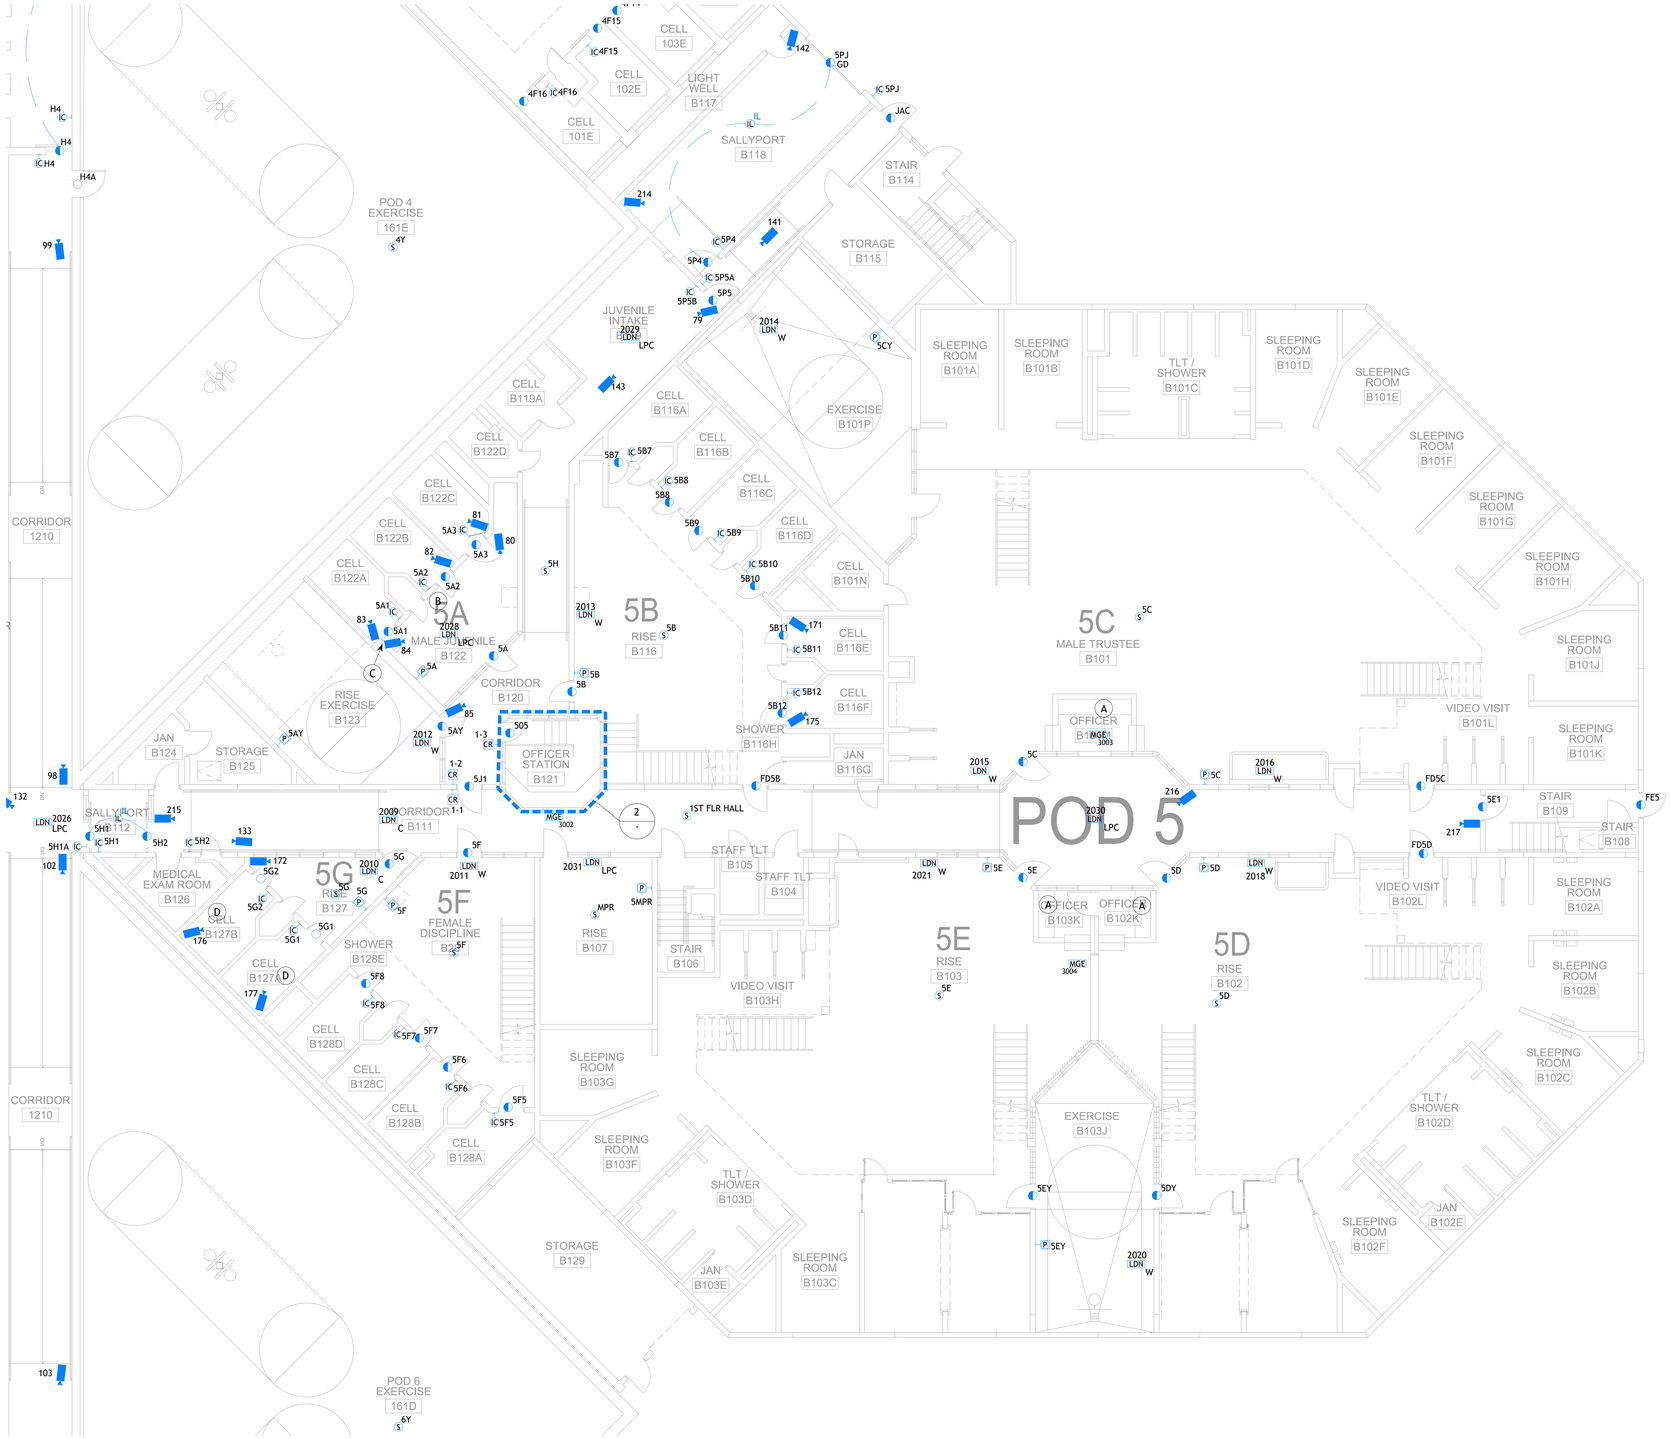

1 SECURITY FLOOR PLAN - JAIL 1ST FLOOR - POD 5
SCALE: 1/8" = 1'-0"

2 RM. B121 DETAIL
SCALE: 1/4" = 1'-0"

SHEET SE107 KEYNOTES:
A.) OFFICER STATIONS HAVE SWITCHES FOR LOCAL TV AND LIGHTING CONTROL.
B.) NEW CAMERAS IN 5A SHALL UTILIZE SURFACE MOUNT EMT STRAPPED TO WALL FOR CAT6 RUNS.
C.) ROUTE SURFACE MOUNT EMT DOWN THE WALL TO THE FLOOR AND INTO CRAWL SPACE IN THIS CORNER.
D.) ACTALL DURESS BUTTON MOUNTED UNDER DESK.

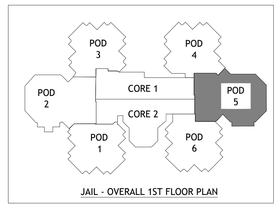

JAIL - OVERALL 1ST FLOOR PLAN

REVISION	DATE	DESCRIPTION
0	11/05/2018	SUBMITTAL
0.1	12/05/2018	JAIL SHEETS FOR D.O.T. REVIEW
1	08/01/2019	AS-BUILT SET
2	09/13/2019	ADDED CAMERAS FOR BOOKING, MEDICAL, AND OUTPATIENT
3	10/03/2019	ADDED CAMERAS IN PODS 1-6
4	12/26/2019	PEDESTAL INTERCOM "IC-G5" ADDED
5	01/23/2020	ACTALL ADDITIONS
6	04/02/2020	ADDED COURT CAMERAS
7	09/09/2020	ADDED POD-1 DURESS BUTTON
8	11/30/2020	2021 CCTV CAMERA REPLACEMENTS
9	07/22/2022	CH2 3RD FLOOR REMODEL (5) PANIC BUTTON RELOCATIONS, (2) DSI ALARMS
10	10/26/2022	CH2 3RD FLOOR REMODEL - ADDED DOOR F388X DSI ALARM (PER ASI NO. 4A)
11	11/08/2022	CH2 3RD FLOOR REMODEL - ADDED A 6TH PANIC ALARM FOR THE MEETING ROOM
12	07/19/2023	CH1 3RD FLOOR - RELOCATED "INTERPRETER" PANIC TO 307 COURTROOM.
13	10/05/2023	ADDITION OF SE GATE - CONTROL, INTERCOM, CAMERA
14	07/09/2024	REMOVAL OF GATE G4 - AS PART OF 2024 ADDITION/REMODEL CONSTRUCTION
15	09/05/2024	CH2 3RD FLOOR REMODEL (PHASE 2) (5) PANIC BUTTON RELOCATIONS, (4) DSI ALARMS
16	10/10/2024	(6) ADDED CAMERAS IN CH1 / CH2
17	04/28/2025	PHASE 2 REMODEL
18	06/15/2025	ADDED JAIL CAMERAS
19	07/24/2025	CH2 3RD FLOOR REMODEL / ADDITIONAL ALARMS (3) PANIC BUTTONS, (2) DSI ALARMS


[redacted]

PROJECT
ARAPAHOE COUNTY JUSTICE CENTER
7375 S. POTOMAC STREET
CENTENNIAL, CO 80112


SHEET NAME
SECURITY FLOOR PLAN -
JAIL 1ST FLOOR - POD 5

SHEET NUMBER
SE107


REVISION
19

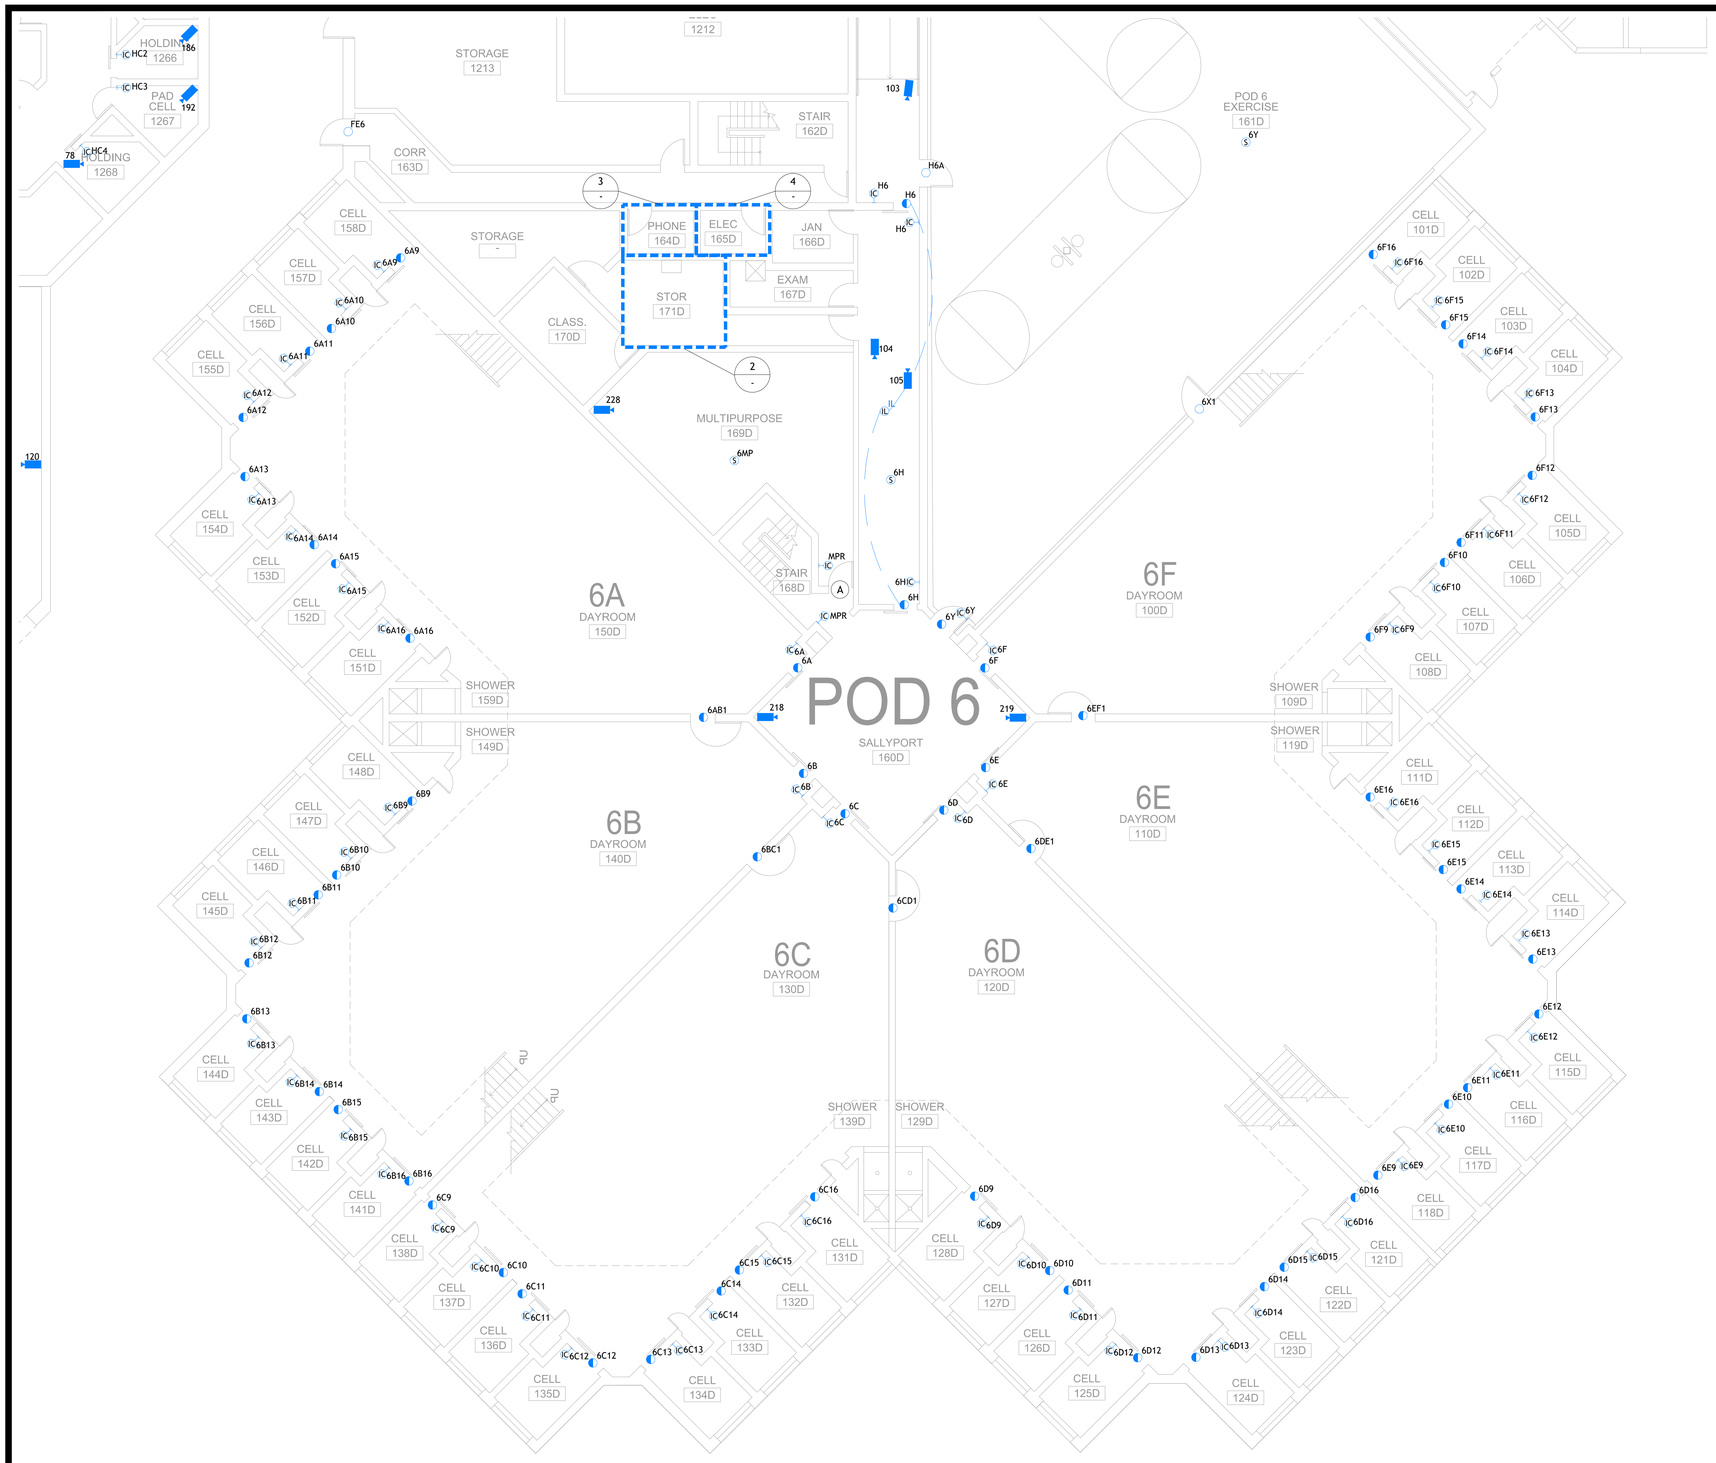


1 SECURITY FLOOR PLAN - JAIL 1ST FLOOR - POD 6
SCALE: 1/8" = 1'-0"

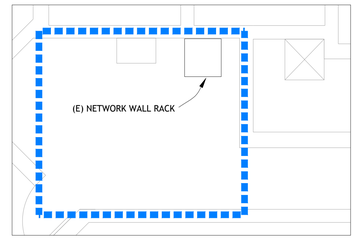

2 RM. 171D DETAIL
SCALE: 1/4" = 1'-0"

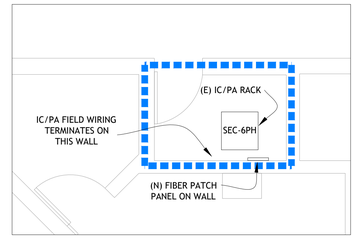


3 RM. 164D DETAIL
SCALE: 1/4" = 1'-0"

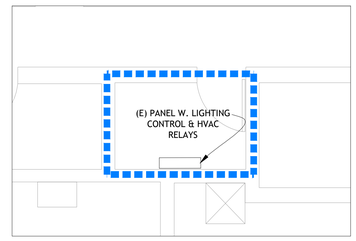

4 RM. 165D DETAIL
SCALE: 1/4" = 1'-0"

SHEET SE108 KEYNOTES:
A.) ELECTRIC LOCK ON THIS DOOR MECHANICALLY DISABLED AND NO LONGER USED.

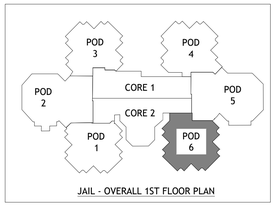

JAIL - OVERALL 1ST FLOOR PLAN

REVISION	DATE	DESCRIPTION
0	11/05/2018	SUBMITTAL
0.1	12/05/2018	JAIL SHEETS FOR D.O.T. REVIEW
1	08/01/2019	AS-BUILT SET
2	09/13/2019	ADDED CAMERAS FOR BOOKING, MEDICAL, AND OUTPATIENT
3	10/03/2019	ADDED CAMERAS IN PODS 1-6
4	12/26/2019	PEDESTAL INTERCOM "IC-G5" ADDED
5	01/23/2020	ACTALL ADDITIONS
6	04/02/2020	ADDED COURT CAMERAS
7	09/09/2020	ADDED POD-1 DURESS BUTTON
8	11/30/2020	2021 CCTV CAMERA REPLACEMENTS
9	07/22/2022	CH2 3RD FLOOR REMODEL (5) PANIC BUTTON RELOCATIONS, (2) DSI ALARMS
10	10/26/2022	CH2 3RD FLOOR REMODEL - ADDED DOOR F388X DSI ALARM (PER ASI NO. 4A)
11	11/08/2022	CH2 3RD FLOOR REMODEL - ADDED A 6TH PANIC ALARM FOR THE MEETING ROOM
12	07/19/2023	CH1 3RD FLOOR - RELOCATED "INTERPRETER" PANIC TO 307 COURTROOM.
13	10/05/2023	ADDITION OF SE GATE - CONTROL, INTERCOM, CAMERA
14	07/09/2024	REMOVAL OF GATE G4 - AS PART OF 2024 ADDITION/REMODEL CONSTRUCTION
15	09/05/2024	CH2 3RD FLOOR REMODEL (PHASE 2) (5) PANIC BUTTON RELOCATIONS, (4) DSI ALARMS
16	10/10/2024	(6) ADDED CAMERAS IN CH1 / CH2
17	04/28/2025	PHASE 2 REMODEL
18	06/15/2025	ADDED JAIL CAMERAS
19	07/24/2025	CH2 3RD FLOOR REMODEL / ADDITIONAL ALARMS (3) PANIC BUTTONS, (2) DSI ALARMS


[redacted]

PROJECT
ARAPAHOE COUNTY JUSTICE CENTER
7375 S. POTOMAC STREET
CENTENNIAL, CO 80112

SHEET NAME
SECURITY FLOOR PLAN -
JAIL 1ST FLOOR - POD 6

SHEET NUMBER
SE108

REVISION
19

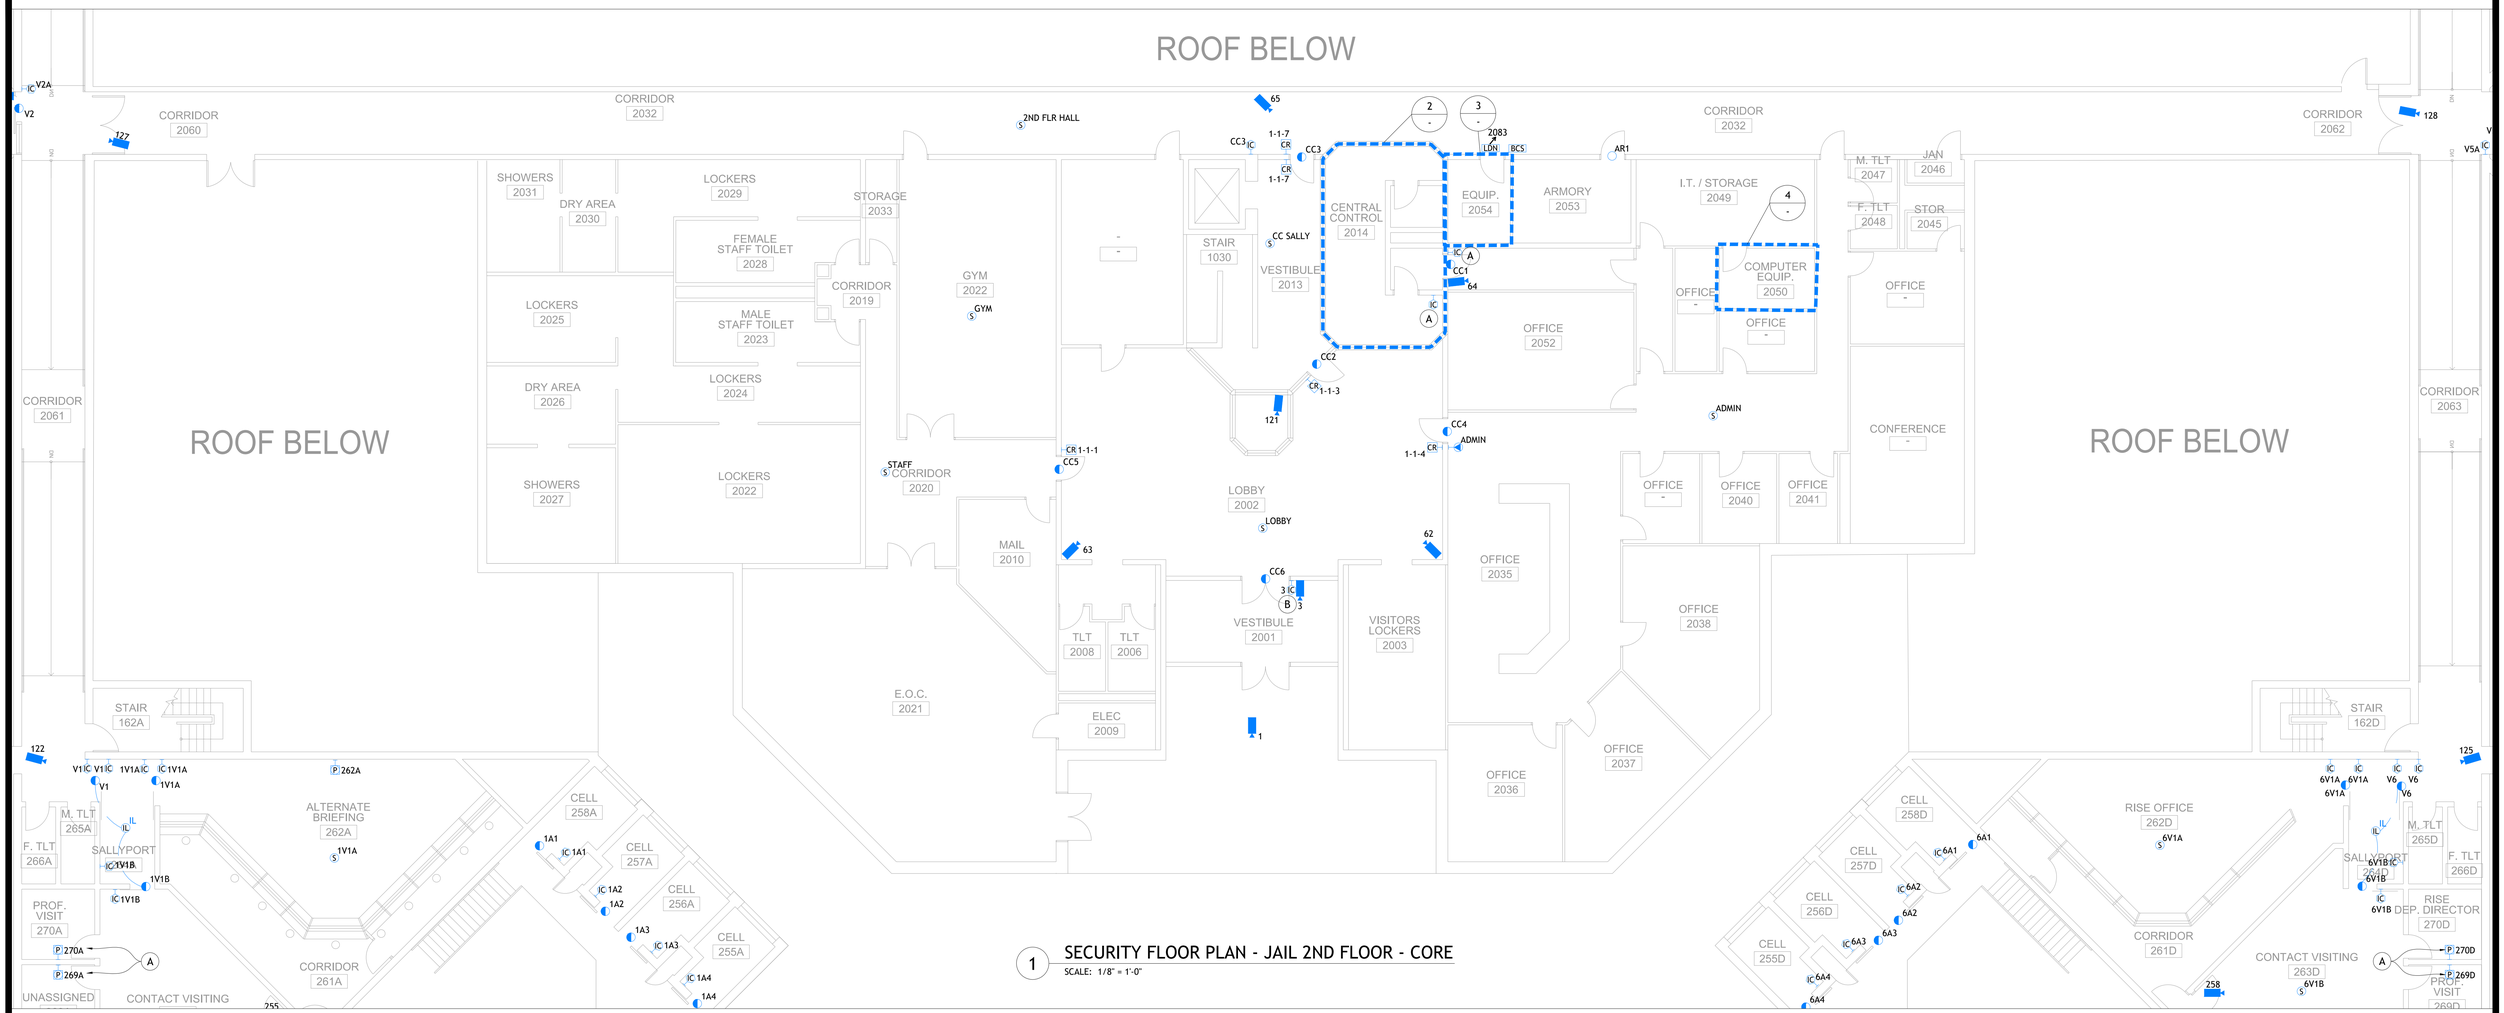


1 SECURITY FLOOR PLAN - JAIL 2ND FLOOR - CORE
SCALE: 1/8" = 1'-0"

2 RM. 2015 DETAIL
SCALE: 1/4" = 1'-0"

3 RM. 2054 DETAIL
SCALE: 1/4" = 1'-0"

4 RM. 2050 DETAIL
SCALE: 1/4" = 1'-0"

SHEET SE109 KEYNOTES:
A.) POTENTIAL LOCATION OF TEMPORARY CENTRAL CONTROL KEY AND TASER CHECKOUT DURING SYSTEM CUT-OVER.
B.) INTERCOM IS A LOCAL AIRPHONE INTERCOM (EXISTING TO REMAIN).
C.) VIDEO INTERCOM STATION.

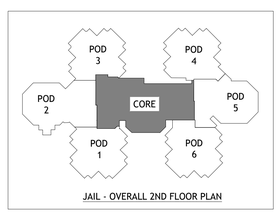

JAIL - OVERALL 2ND FLOOR PLAN

REVISION	DATE	DESCRIPTION
0	11/05/2018	SUBMITTAL
0.1	12/05/2018	JAIL SHEETS FOR D.O.T. REVIEW
1	08/01/2019	AS-BUILT SET
2	09/13/2019	ADDED CAMERAS FOR BOOKING, MEDICAL, AND OUTPATIENT
3	10/03/2019	ADDED CAMERAS IN PODS 1-6
4	12/26/2019	PEDESTAL INTERCOM "IC-G5" ADDED
5	01/23/2020	ACTALL ADDITIONS
6	04/02/2020	ADDED COURT CAMERAS
7	09/09/2020	ADDED POD-1 DURESS BUTTON
8	11/30/2020	2021 CCTV CAMERA REPLACEMENTS
9	07/22/2022	CH2 3RD FLOOR REMODEL (5) PANIC BUTTON RELOCATIONS, (2) DSI ALARMS
10	10/26/2022	CH2 3RD FLOOR REMODEL - ADDED DOOR F388X DSI ALARM (PER ASI NO. 4A)
11	11/08/2022	CH2 3RD FLOOR REMODEL - ADDED A 6TH PANIC ALARM FOR THE MEETING ROOM
12	07/19/2023	CH1 3RD FLOOR - RELOCATED "INTERPRETER" PANIC TO 307 COURTROOM.
13	10/05/2023	ADDITION OF SE GATE - CONTROL, INTERCOM, CAMERA
14	07/09/2024	REMOVAL OF GATE G4 - AS PART OF 2024 ADDITION/REMODEL CONSTRUCTION
15	09/05/2024	CH2 3RD FLOOR REMODEL (PHASE 2) (5) PANIC BUTTON RELOCATIONS, (4) DSI ALARMS
16	10/10/2024	(6) ADDED CAMERAS IN CH1 / CH2
17	04/28/2025	PHASE 2 REMODEL
18	06/15/2025	ADDED JAIL CAMERAS
19	07/24/2025	CH2 3RD FLOOR REMODEL / ADDITIONAL ALARMS (3) PANIC BUTTONS, (2) DSI ALARMS


[redacted]

PROJECT
ARAPAHOE COUNTY JUSTICE CENTER
7375 S. POTOMAC STREET
CENTENNIAL, CO 80112


SHEET NAME
SECURITY FLOOR PLAN -
JAIL 2ND FLOOR - CORE

SHEET NUMBER
SE109

REVISION
19

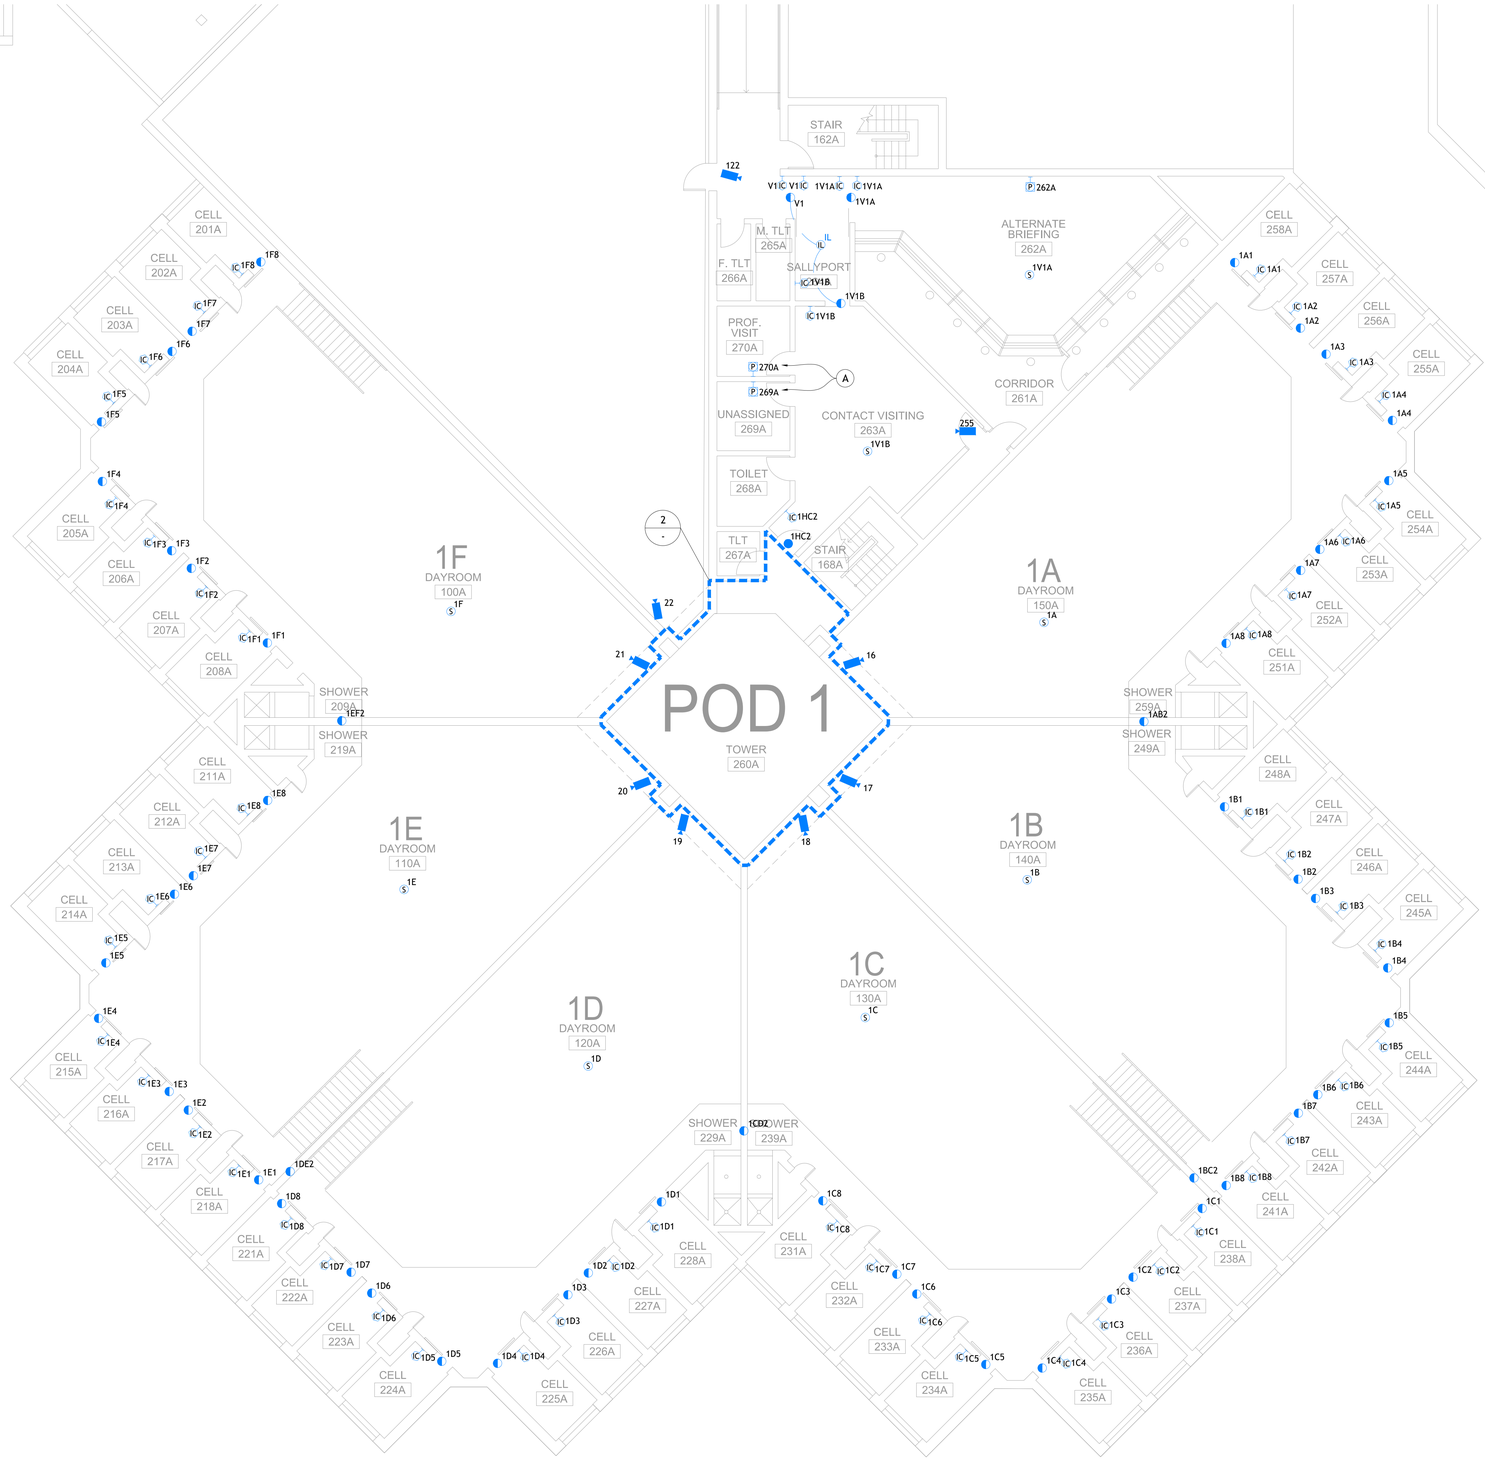


1 SECURITY FLOOR PLAN - JAIL 2ND FLOOR - POD 1
SCALE: 1/8" = 1'-0"

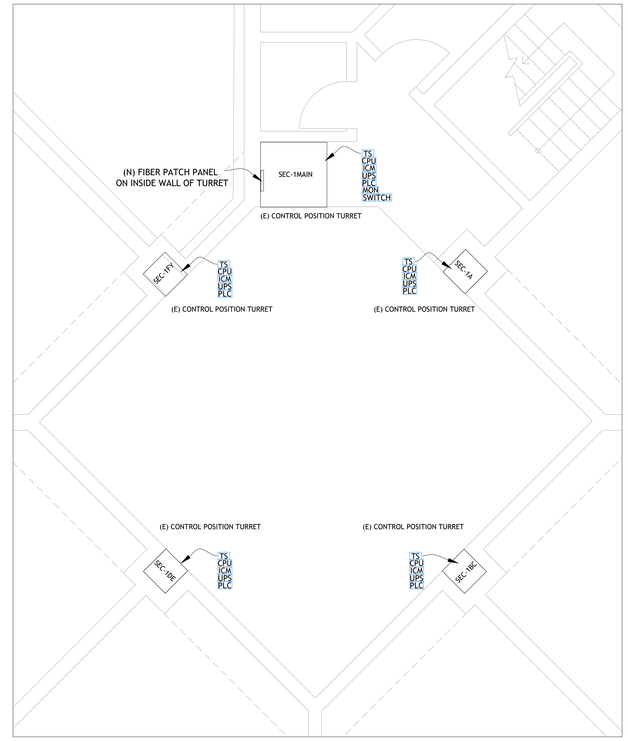

2 RM. 260A DETAIL
SCALE: 1/4" = 1'-0"

SHEET SE110 KEYNOTES:
A.) PANIC BUTTONS ARE WIRED TOGETHER IN SERIES.

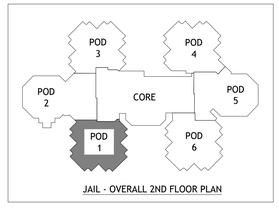

JAIL - OVERALL 2ND FLOOR PLAN

REVISION	DATE	DESCRIPTION
0	11/05/2018	SUBMITTAL
0.1	12/05/2018	JAIL SHEETS FOR D.O.T. REVIEW
1	08/01/2019	AS-BUILT SET
2	09/13/2019	ADDED CAMERAS FOR BOOKING, MEDICAL, AND OUTPATIENT
3	10/03/2019	ADDED CAMERAS IN PODS 1-6
4	12/26/2019	PEDESTAL INTERCOM "IC-G5" ADDED
5	01/23/2020	ACTALL ADDITIONS
6	04/02/2020	ADDED COURT CAMERAS
7	09/09/2020	ADDED POD-1 DURESS BUTTON
8	11/30/2020	2021 CCTV CAMERA REPLACEMENTS
9	07/22/2022	CH2 3RD FLOOR REMODEL (5) PANIC BUTTON RELOCATIONS, (2) DSI ALARMS
10	10/26/2022	CH2 3RD FLOOR REMODEL - ADDED DOOR F388X DSI ALARM (PER ASI NO. 4A)
11	11/08/2022	CH2 3RD FLOOR REMODEL - ADDED A 6TH PANIC ALARM FOR THE MEETING ROOM
12	07/19/2023	CH1 3RD FLOOR - RELOCATED "INTERPRETER" PANIC TO 307 COURTROOM.
13	10/05/2023	ADDITION OF SE GATE - CONTROL, INTERCOM, CAMERA
14	07/09/2024	REMOVAL OF GATE G4 - AS PART OF 2024 ADDITION/REMODEL CONSTRUCTION
15	09/05/2024	CH2 3RD FLOOR REMODEL (PHASE 2) (5) PANIC BUTTON RELOCATIONS, (4) DSI ALARMS
16	10/10/2024	(6) ADDED CAMERAS IN CH1 / CH2
17	04/28/2025	PHASE 2 REMODEL
18	06/15/2025	ADDED JAIL CAMERAS
19	07/24/2025	CH2 3RD FLOOR REMODEL / ADDITIONAL ALARMS (3) PANIC BUTTONS, (2) DSI ALARMS


[redacted]

PROJECT
ARAPAHOE COUNTY JUSTICE CENTER
7375 S. POTOMAC STREET
CENTENNIAL, CO 80112


SHEET NAME
SECURITY FLOOR PLAN -
JAIL 2ND FLOOR - POD 1

SHEET NUMBER
SE110


REVISION
19

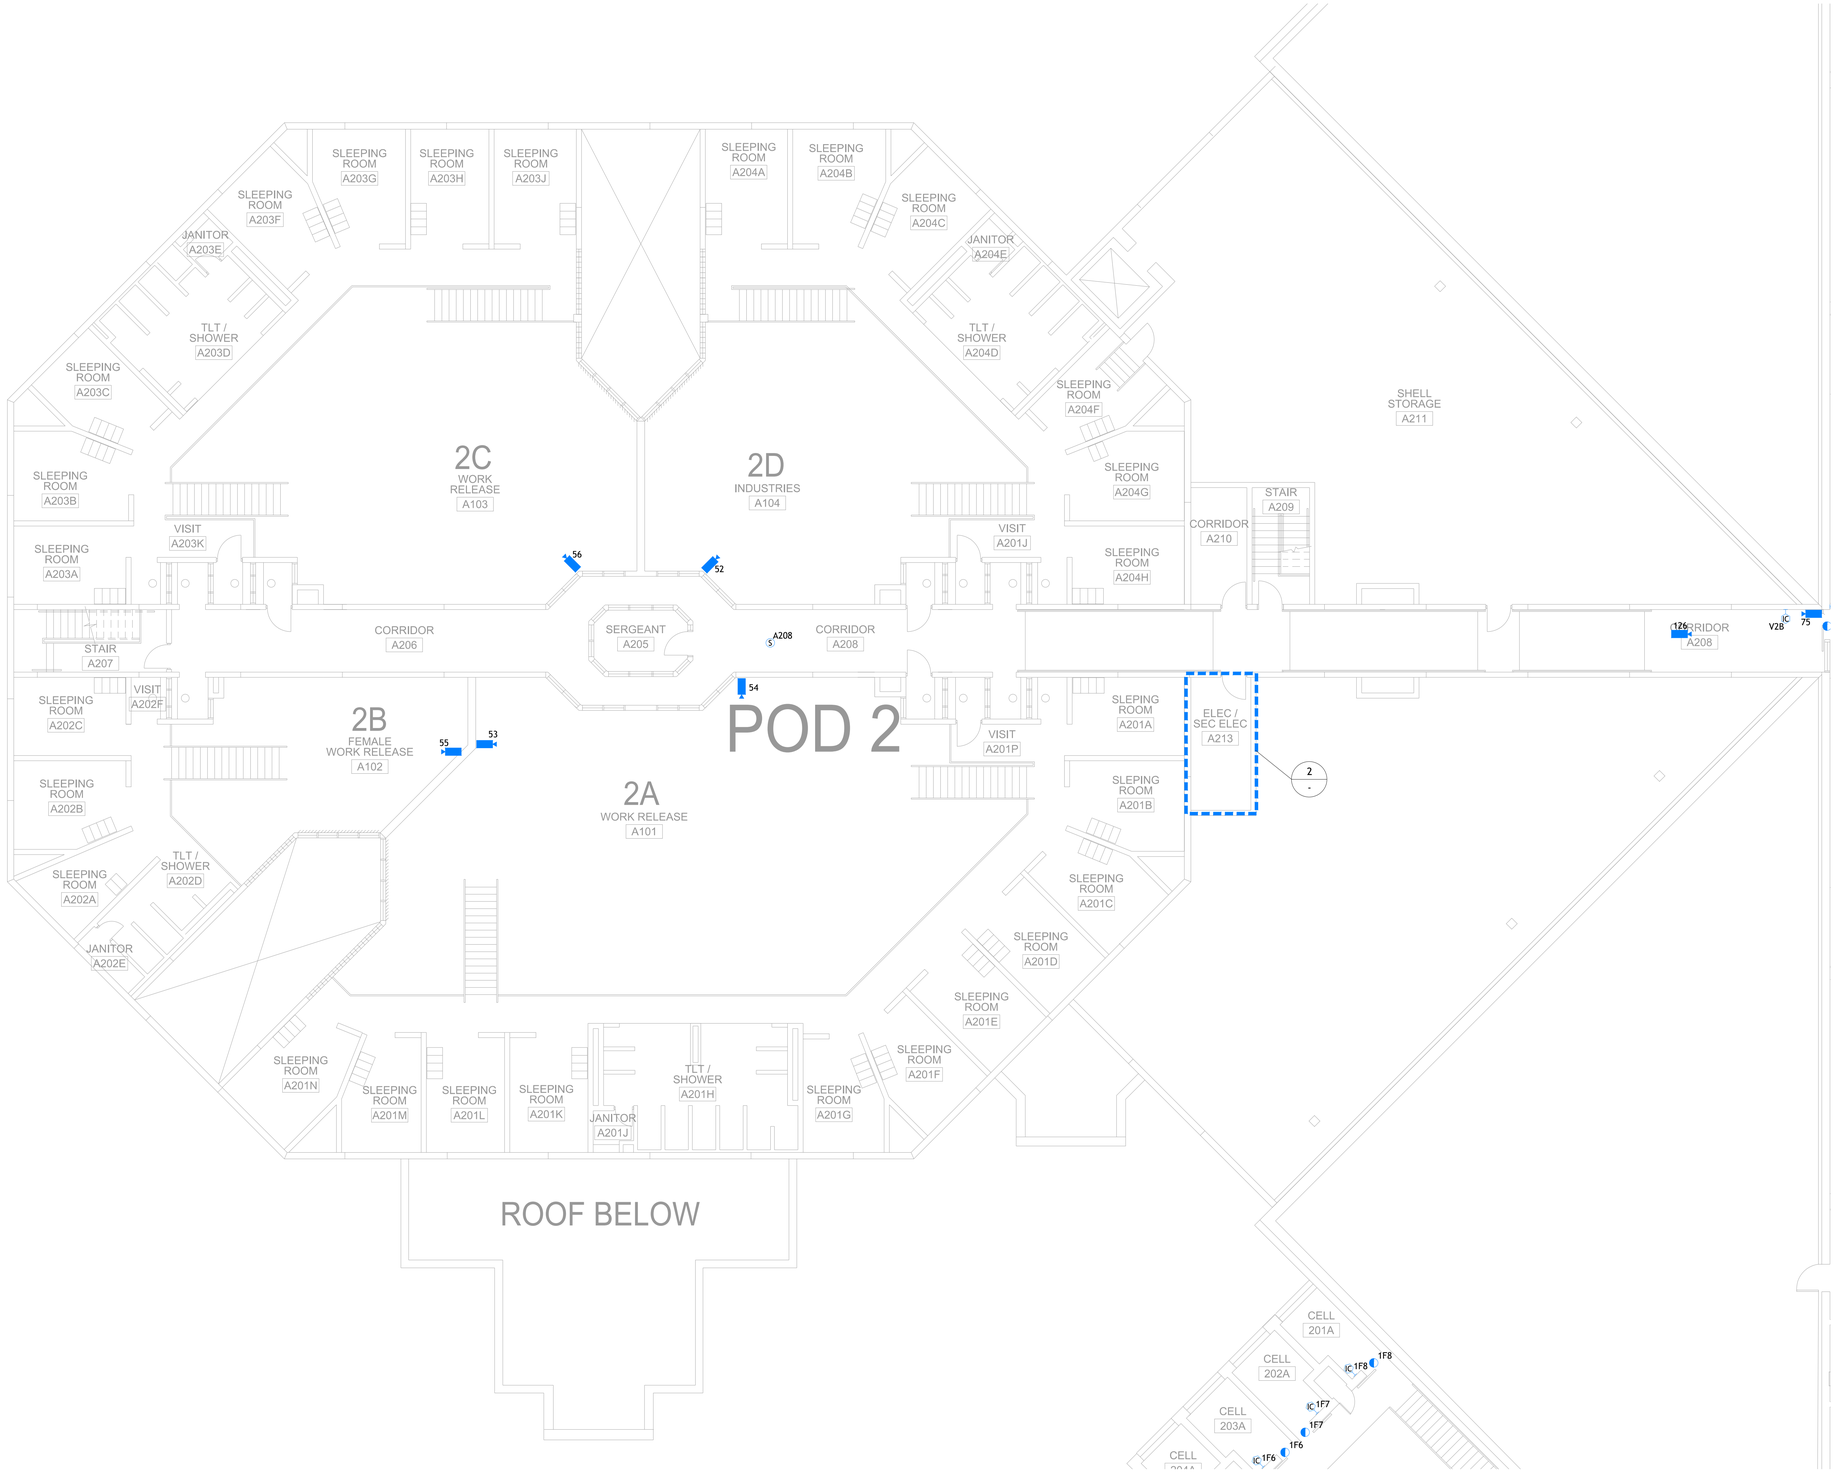

1 SECURITY FLOOR PLAN - JAIL 2ND FLOOR - POD 2
SCALE: 1/4" = 1'-0"

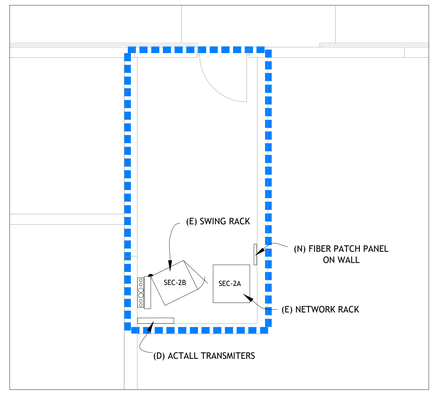

2 RM. A213 DETAIL
SCALE: 1/4" = 1'-0"

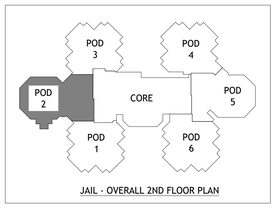

JAIL - OVERALL 2ND FLOOR PLAN

REVISION	DATE	DESCRIPTION
0	11/05/2018	SUBMITTAL
0.1	12/05/2018	JAIL SHEETS FOR D.O.T. REVIEW
1	08/01/2019	AS-BUILT SET
2	09/13/2019	ADDED CAMERAS FOR BOOKING, MEDICAL, AND OUTPATIENT
3	10/03/2019	ADDED CAMERAS IN PODS 1-6
4	12/26/2019	PEDESTAL INTERCOM "IC-GS" ADDED
5	01/23/2020	ACTALL ADDITIONS
6	04/02/2020	ADDED COURT CAMERAS
7	09/09/2020	ADDED POD-1 DURESS BUTTON
8	11/30/2020	2021 CCTV CAMERA REPLACEMENTS
9	07/22/2022	CH2 3RD FLOOR REMODEL (5) PANIC BUTTON RELOCATIONS, (2) DSI ALARMS
10	10/26/2022	CH2 3RD FLOOR REMODEL - ADDED DOOR F388X DSI ALARM (PER ASI NO. 4A)
11	11/08/2022	CH2 3RD FLOOR REMODEL - ADDED A 6TH PANIC ALARM FOR THE MEETING ROOM
12	07/19/2023	CH1 3RD FLOOR - RELOCATED "INTERPRETER" PANIC TO 307 COURTROOM.
13	10/05/2023	ADDITION OF SE GATE - CONTROL, INTERCOM, CAMERA
14	07/09/2024	REMOVAL OF GATE G4 - AS PART OF 2024 ADDITION/REMODEL CONSTRUCTION
15	09/05/2024	CH2 3RD FLOOR REMODEL (PHASE 2) (5) PANIC BUTTON RELOCATIONS, (4) DSI ALARMS
16	10/10/2024	(6) ADDED CAMERAS IN CH1 / CH2
17	04/28/2025	PHASE 2 REMODEL
18	06/15/2025	ADDED JAIL CAMERAS
19	07/24/2025	CH2 3RD FLOOR REMODEL / ADDITIONAL ALARMS (3) PANIC BUTTONS, (2) DSI ALARMS

KUBL GROUP
WWW.KUBLGROUP.COM
970.818.2588


KUBL GROUP, LLC
3201 E MULBERRY ST, UNIT H
FORT COLLINS, CO 80524

KUBL GROUP PROJECT NUMBER: 18.23
DRAWN BY / DATE: NCS / 11.30.2020


PROJECT
ARAPAHOE COUNTY JUSTICE CENTER
7375 S. POTOMAC STREET
CENTENNIAL, CO 80112

SHEET NAME
SECURITY FLOOR PLAN -
JAIL 2ND FLOOR - POD 2

SHEET NUMBER: SE111
REVISION: 19

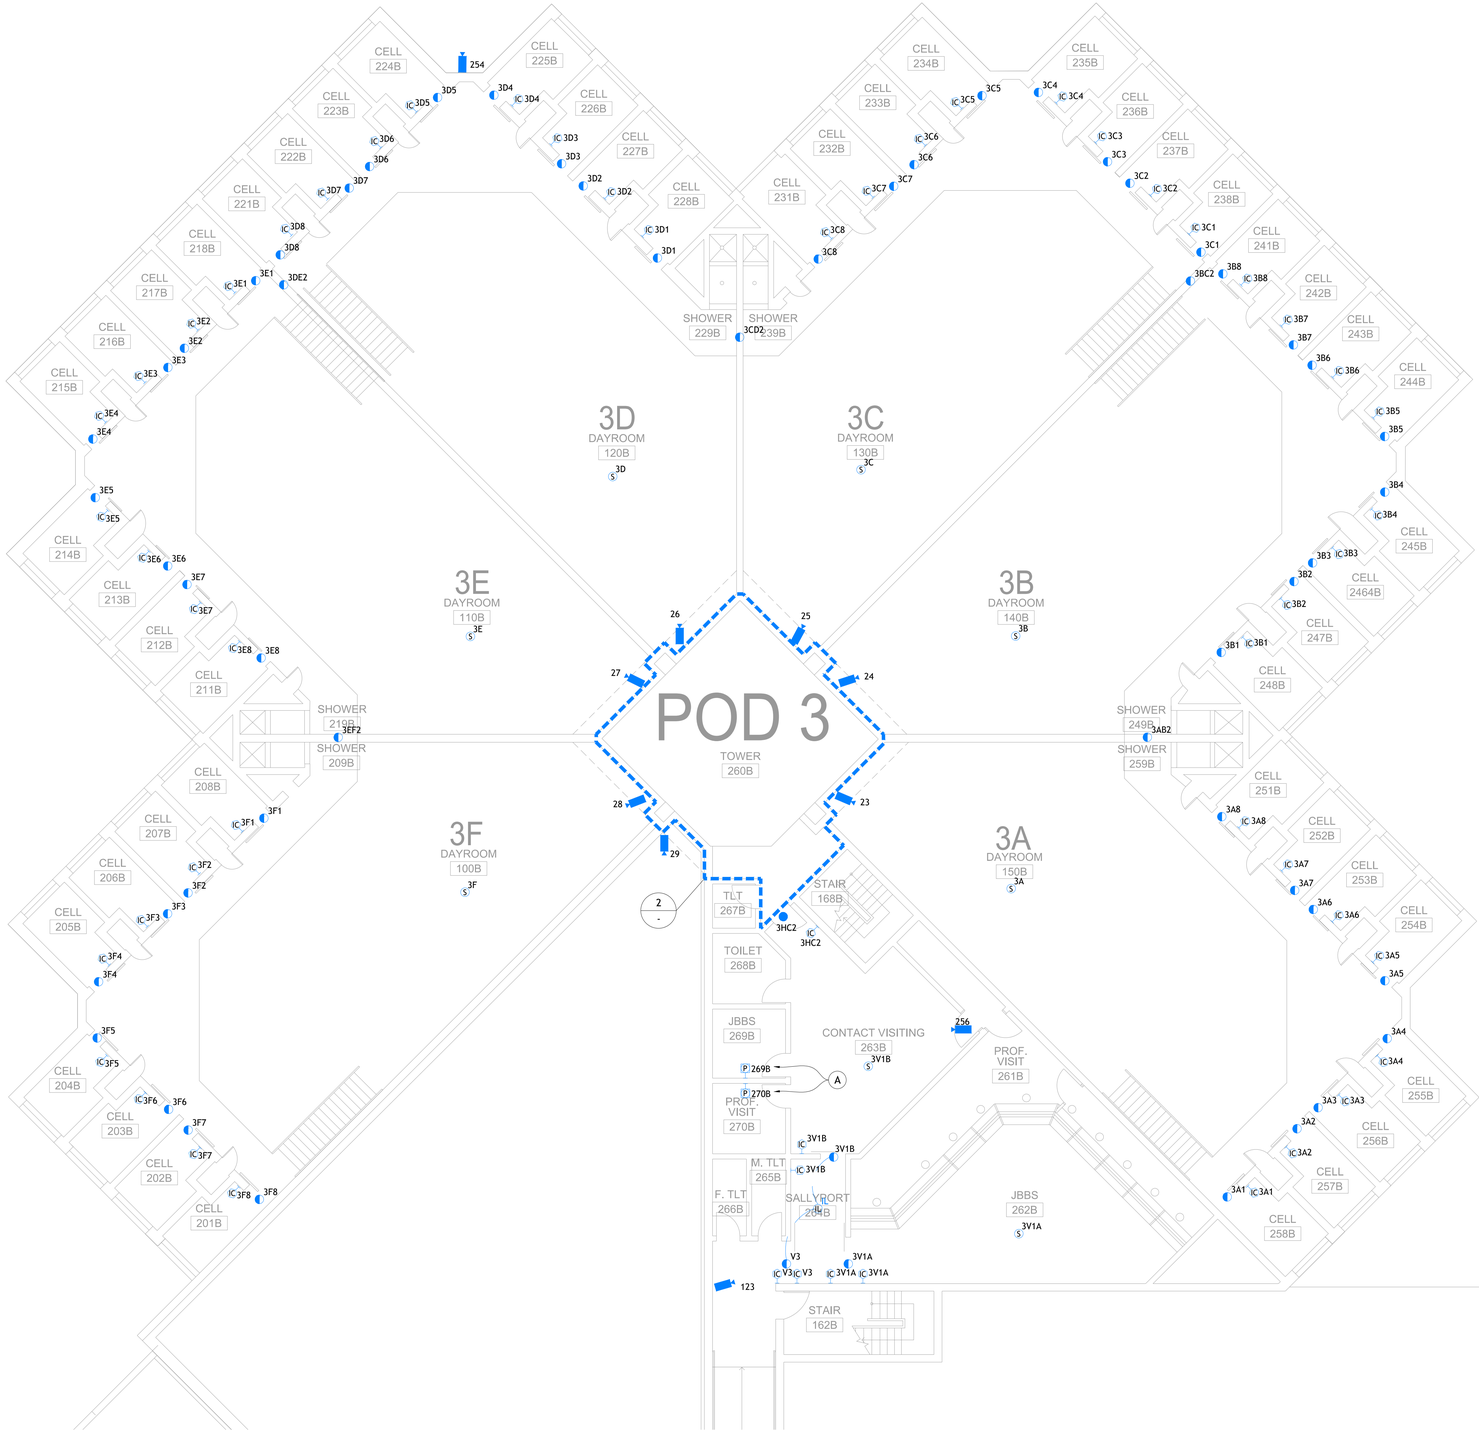


1 SECURITY FLOOR PLAN - JAIL 2ND FLOOR - POD 3
SCALE: 1/8" = 1'-0"

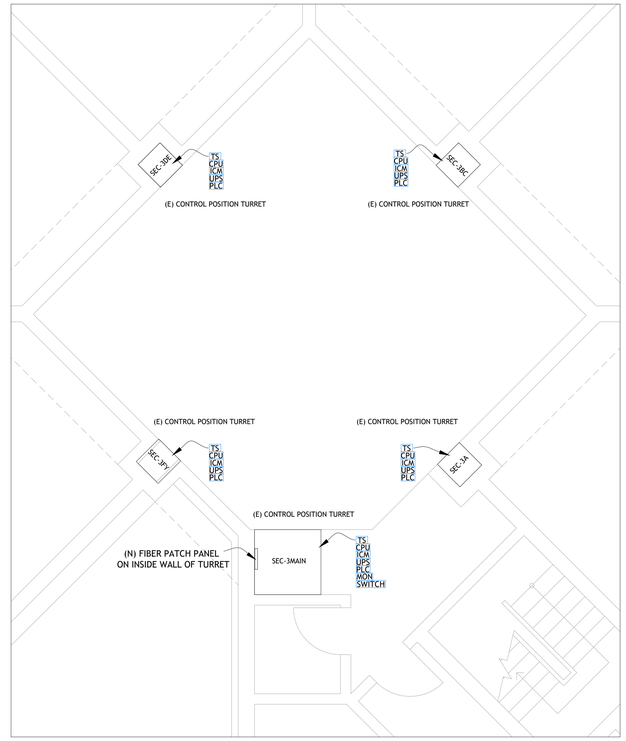

2 RM. 260B DETAIL
SCALE: 1/4" = 1'-0"

SHEET SE112 KEYNOTES:
A.) PANIC BUTTONS ARE WIRED TOGETHER IN SERIES.

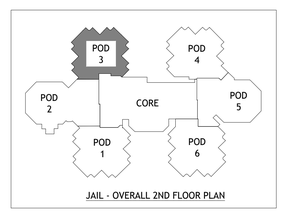

JAIL - OVERALL 2ND FLOOR PLAN

REVISION	DATE	DESCRIPTION
0	11/05/2018	SUBMITTAL
0.1	12/05/2018	JAIL SHEETS FOR D.O.T. REVIEW
1	08/01/2019	AS-BUILT SET
2	09/13/2019	ADDED CAMERAS FOR BOOKING, MEDICAL, AND OUTPATIENT
3	10/03/2019	ADDED CAMERAS IN PODS 1-6
4	12/26/2019	PEDESTAL INTERCOM "IC-G5" ADDED
5	01/23/2020	ACTALL ADDITIONS
6	04/02/2020	ADDED COURT CAMERAS
7	09/09/2020	ADDED POD-1 DURESS BUTTON
8	11/30/2020	2021 CCTV CAMERA REPLACEMENTS
9	07/22/2022	CH2 3RD FLOOR REMODEL (5) PANIC BUTTON RELOCATIONS, (2) DSI ALARMS
10	10/26/2022	CH2 3RD FLOOR REMODEL - ADDED DOOR F388X DSI ALARM (PER ASI NO. 4A)
11	11/08/2022	CH2 3RD FLOOR REMODEL - ADDED A 6TH PANIC ALARM FOR THE MEETING ROOM
12	07/19/2023	CH1 3RD FLOOR - RELOCATED "INTERPRETER" PANIC TO 307 COURTROOM.
13	10/05/2023	ADDITION OF SE GATE - CONTROL, INTERCOM, CAMERA
14	07/09/2024	REMOVAL OF GATE G4 - AS PART OF 2024 ADDITION/REMODEL CONSTRUCTION
15	09/05/2024	CH2 3RD FLOOR REMODEL (PHASE 2) (5) PANIC BUTTON RELOCATIONS, (4) DSI ALARMS
16	10/10/2024	(6) ADDED CAMERAS IN CH1 / CH2
17	04/28/2025	PHASE 2 REMODEL
18	06/15/2025	ADDED JAIL CAMERAS
19	07/24/2025	CH2 3RD FLOOR REMODEL / ADDITIONAL ALARMS (3) PANIC BUTTONS, (2) DSI ALARMS


[redacted]

PROJECT
ARAPAHOE COUNTY JUSTICE CENTER
7375 S. POTOMAC STREET
CENTENNIAL, CO 80112

SHEET NAME
SECURITY FLOOR PLAN - JAIL 2ND FLOOR - POD 3


SHEET NUMBER
SE112

REVISION
19

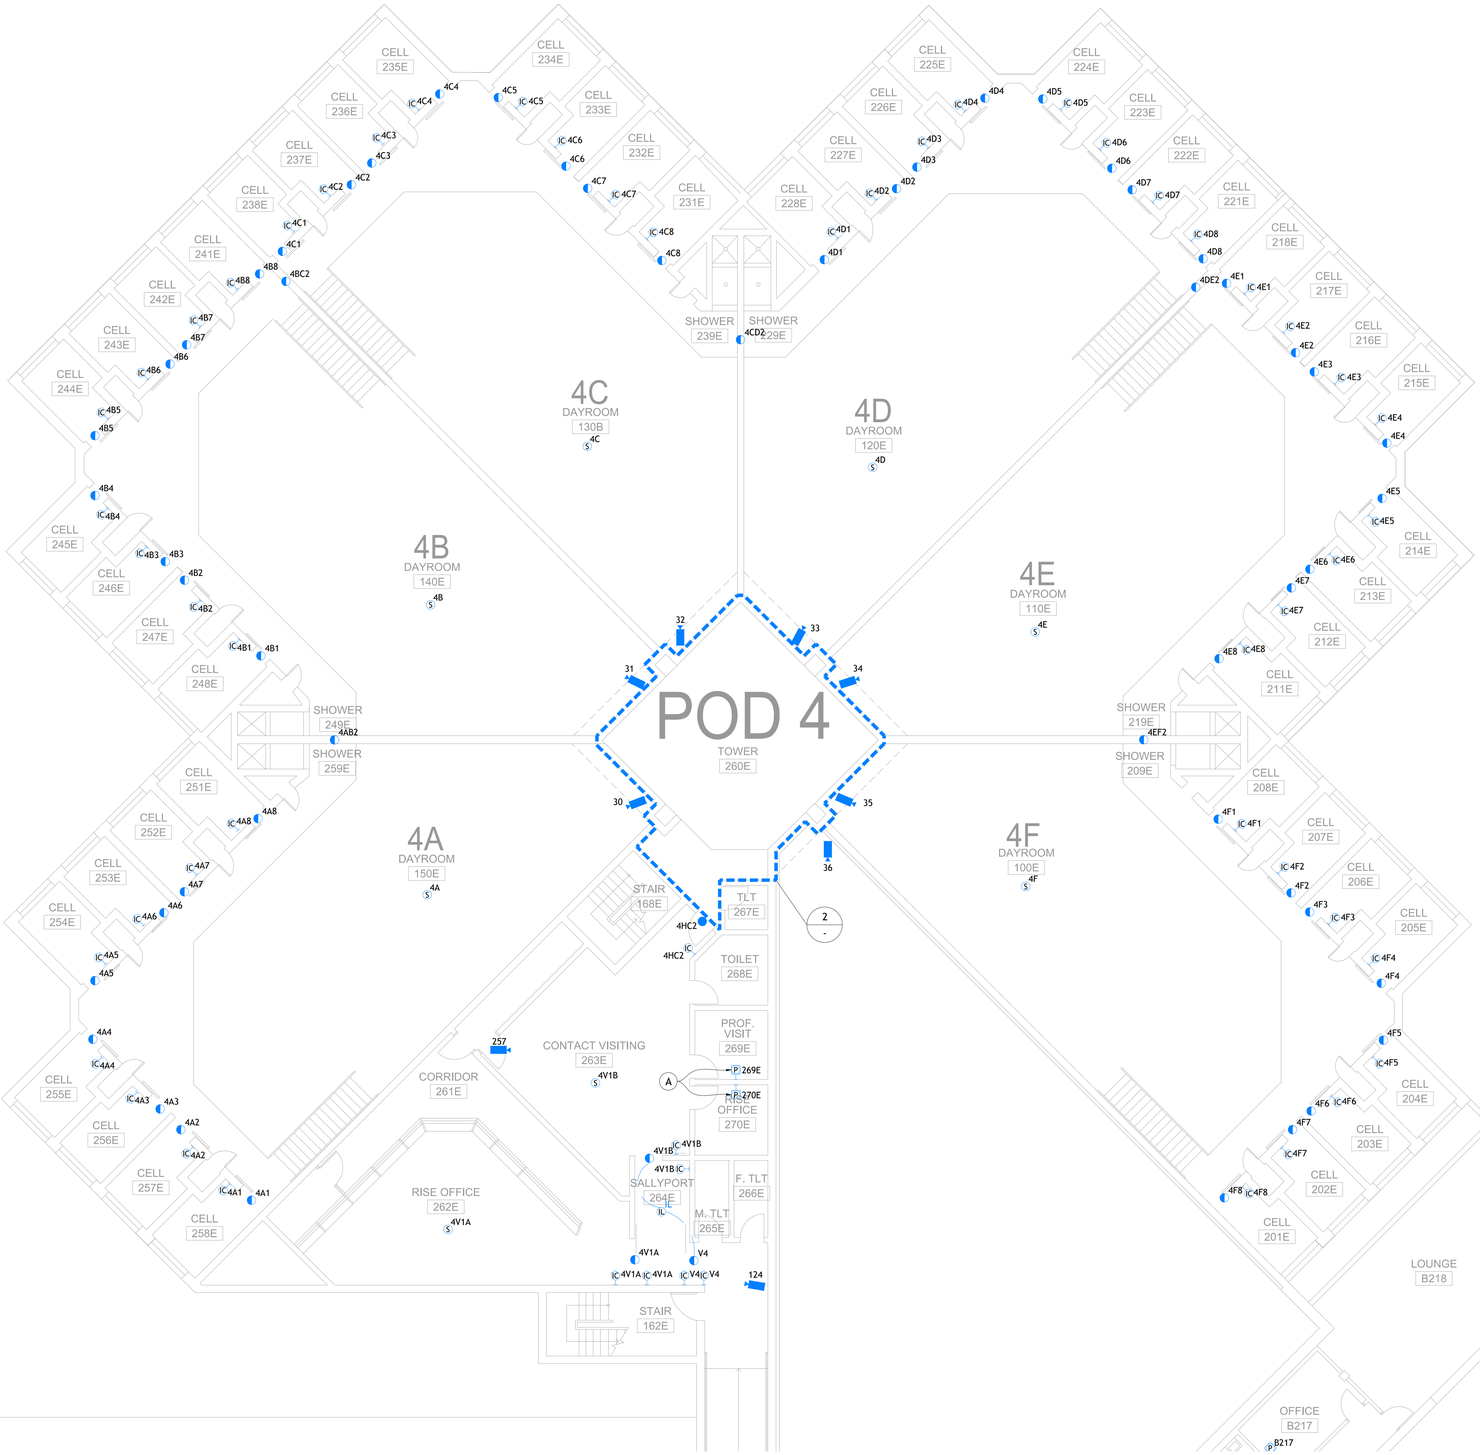

1 SECURITY FLOOR PLAN - JAIL 2ND FLOOR - POD 4


SCALE: 1/8" = 1'-0"

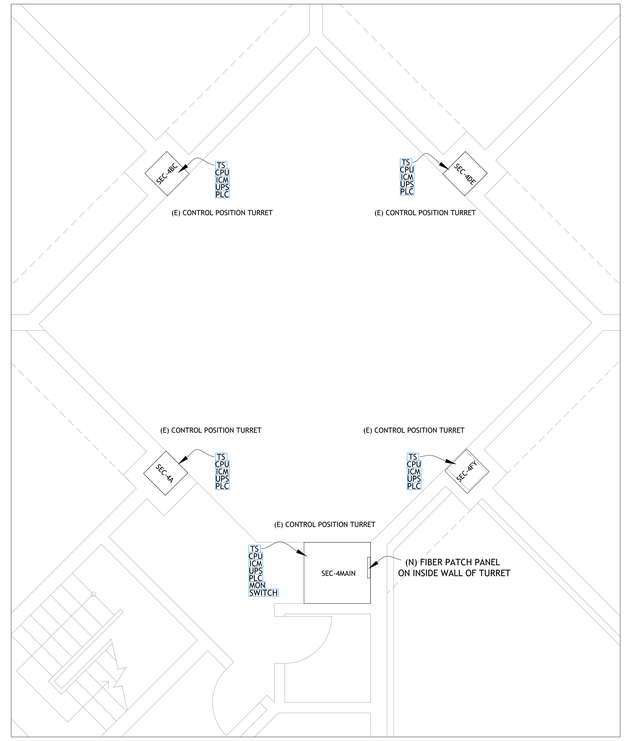

2 RM. 260E DETAIL

SCALE: 1/4" = 1'-0"

SHEET SE113 KEYNOTES:
A.) PANIC BUTTONS ARE WIRED TOGETHER IN SERIES.

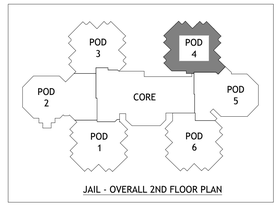

JAIL - OVERALL 2ND FLOOR PLAN

REVISION	DATE	DESCRIPTION
0	11/05/2018	SUBMITTAL
0.1	12/05/2018	JAIL SHEETS FOR D.O.T. REVIEW
1	08/01/2019	AS-BUILT SET
2	09/13/2019	ADDED CAMERAS FOR BOOKING, MEDICAL, AND OUTPATIENT
3	10/03/2019	ADDED CAMERAS IN PODS 1-6
4	12/26/2019	PEDESTAL INTERCOM "IC-G5" ADDED
5	01/23/2020	ACTALL ADDITIONS
6	04/02/2020	ADDED COURT CAMERAS
7	09/09/2020	ADDED POD-1 DURESS BUTTON
8	11/30/2020	2021 CCTV CAMERA REPLACEMENTS
9	07/22/2022	CH2 3RD FLOOR REMODEL (5) PANIC BUTTON RELOCATIONS, (2) DSI ALARMS
10	10/26/2022	CH2 3RD FLOOR REMODEL - ADDED DOOR F388X DSI ALARM (PER ASI NO. 4A)
11	11/08/2022	CH2 3RD FLOOR REMODEL - ADDED A 6TH PANIC ALARM FOR THE MEETING ROOM
12	07/19/2023	CH1 3RD FLOOR - RELOCATED "INTERPRETER" PANIC TO 307 COURTROOM.
13	10/05/2023	ADDITION OF SE GATE - CONTROL, INTERCOM, CAMERA
14	07/09/2024	REMOVAL OF GATE G4 - AS PART OF 2024 ADDITION/REMODEL CONSTRUCTION
15	09/05/2024	CH2 3RD FLOOR REMODEL (PHASE 2) (5) PANIC BUTTON RELOCATIONS, (4) DSI ALARMS
16	10/10/2024	(6) ADDED CAMERAS IN CH1 / CH2
17	04/28/2025	PHASE 2 REMODEL
18	06/15/2025	ADDED JAIL CAMERAS
19	07/24/2025	CH2 3RD FLOOR REMODEL / ADDITIONAL ALARMS (3) PANIC BUTTONS, (2) DSI ALARMS

[redacted]

PROJECT

ARAPAHOE COUNTY JUSTICE CENTER
7375 S. POTOMAC STREET
CENTENNIAL, CO 80112

SHEET NAME


SECURITY FLOOR PLAN -
JAIL 2ND FLOOR - POD 4

SHEET NUMBER

SE113


REVISION

19

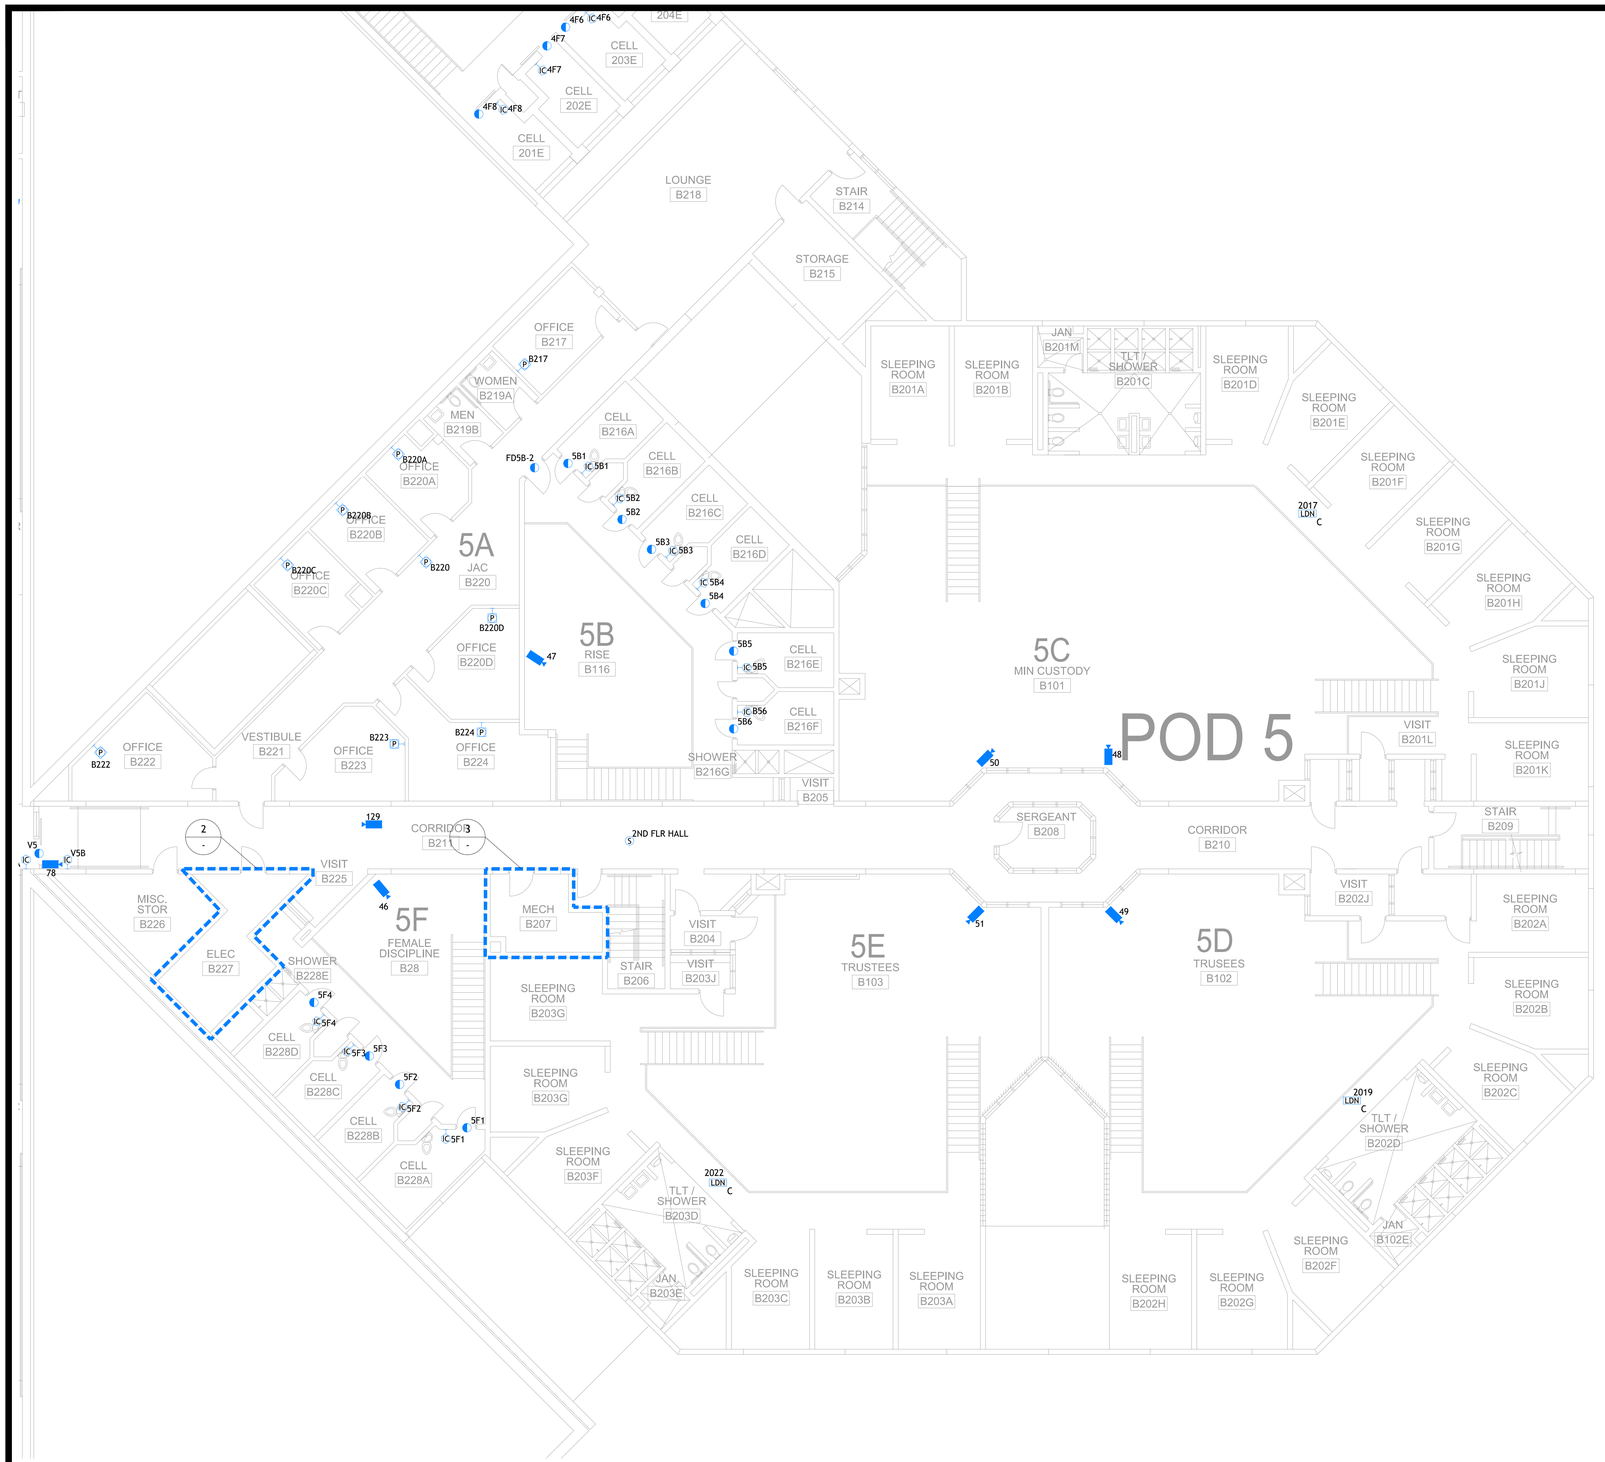


1 SECURITY FLOOR PLAN - JAIL 2ND FLOOR - POD 5

SCALE: 1/8" = 1'-0"

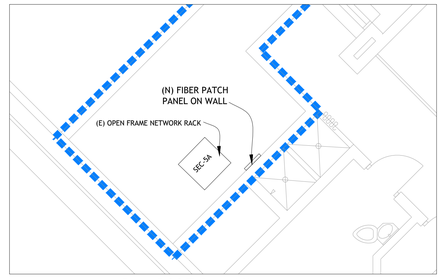


2 RM. B227 DETAIL

SCALE: 1/4" = 1'-0"

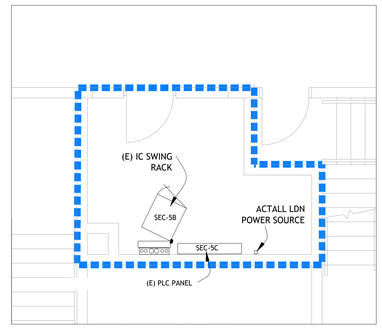

3 RM. B207 DETAIL

SCALE: 1/4" = 1'-0"

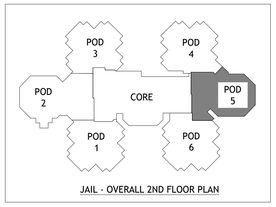

JAIL - OVERALL 2ND FLOOR PLAN

REVISION	DATE	DESCRIPTION
0	11/05/2018	SUBMITTAL
0.1	12/05/2018	JAIL SHEETS FOR D.O.T. REVIEW
1	08/01/2019	AS-BUILT SET
2	09/13/2019	ADDED CAMERAS FOR BOOKING, MEDICAL, AND OUTPATIENT
3	10/03/2019	ADDED CAMERAS IN PODS 1-6
4	12/26/2019	PEDESTAL INTERCOM "IC-G5" ADDED
5	01/23/2020	ACTALL ADDITIONS
6	04/02/2020	ADDED COURT CAMERAS
7	09/09/2020	ADDED POD-1 DURESS BUTTON
8	11/30/2020	2021 CCTV CAMERA REPLACEMENTS
9	07/22/2022	CH2 3RD FLOOR REMODEL (5) PANIC BUTTON RELOCATIONS, (2) DSI ALARMS
10	10/26/2022	CH2 3RD FLOOR REMODEL - ADDED DOOR F388X DSI ALARM (PER ASI NO. 4A)
11	11/08/2022	CH2 3RD FLOOR REMODEL - ADDED A 6TH PANIC ALARM FOR THE MEETING ROOM
12	07/19/2023	CH1 3RD FLOOR - RELOCATED "INTERPRETER" PANIC TO 307 COURTROOM.
13	10/05/2023	ADDITION OF SE GATE - CONTROL, INTERCOM, CAMERA
14	07/09/2024	REMOVAL OF GATE G4 - AS PART OF 2024 ADDITION/REMODEL CONSTRUCTION
15	09/05/2024	CH2 3RD FLOOR REMODEL (PHASE 2) (5) PANIC BUTTON RELOCATIONS, (4) DSI ALARMS
16	10/10/2024	(6) ADDED CAMERAS IN CH1 / CH2
17	04/28/2025	PHASE 2 REMODEL
18	06/15/2025	ADDED JAIL CAMERAS
19	07/24/2025	CH2 3RD FLOOR REMODEL / ADDITIONAL ALARMS (3) PANIC BUTTONS, (2) DSI ALARMS

[redacted]

PROJECT

ARAPAHOE COUNTY JUSTICE CENTER
7375 S. POTOMAC STREET
CENTENNIAL, CO 80112

SHEET NAME


SECURITY FLOOR PLAN -
JAIL 2ND FLOOR - POD 5

SHEET NUMBER

SE114


REVISION

19

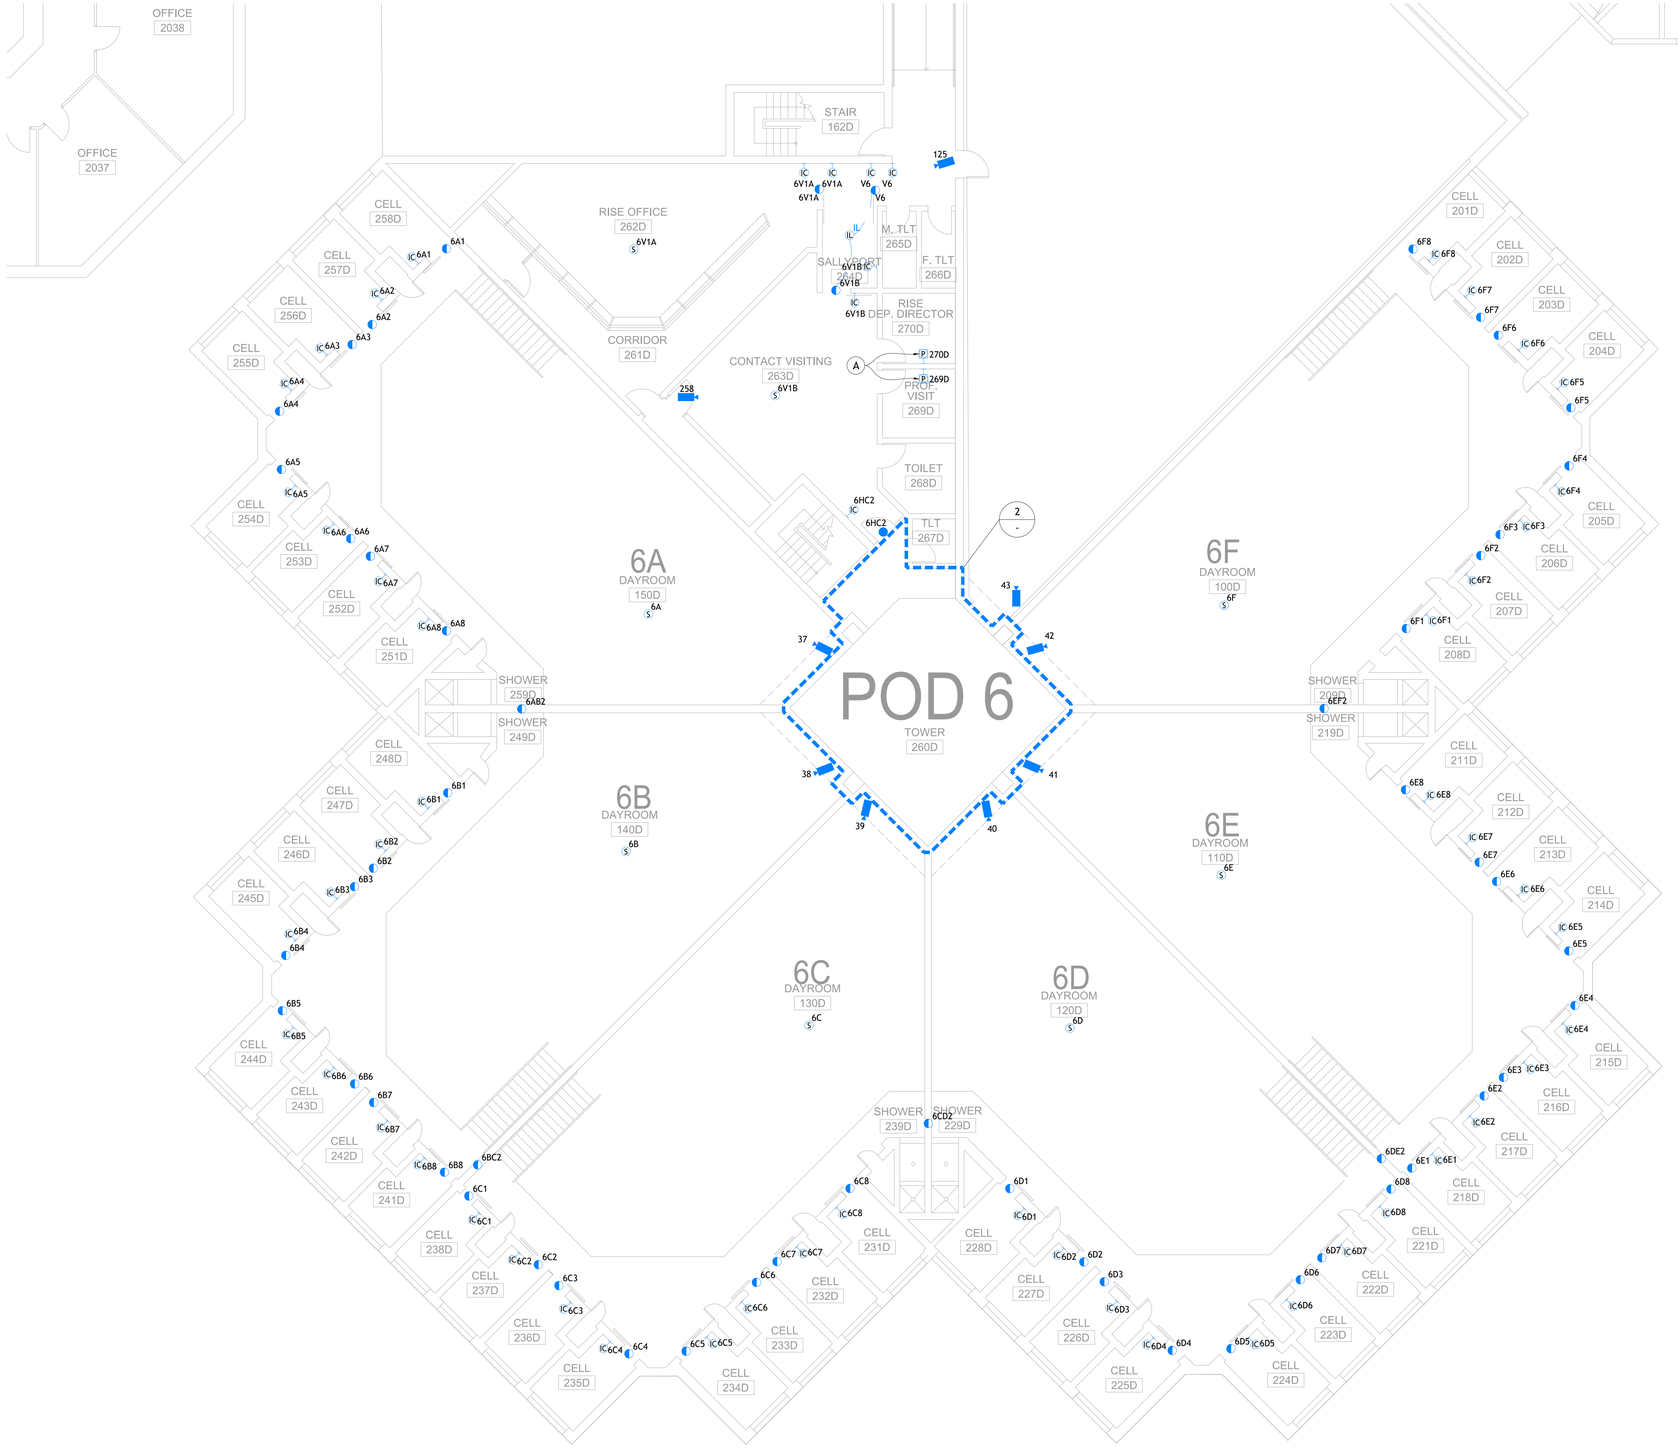

1 SECURITY FLOOR PLAN - JAIL 2ND FLOOR - POD 6


SCALE: 1/8" = 1'-0"

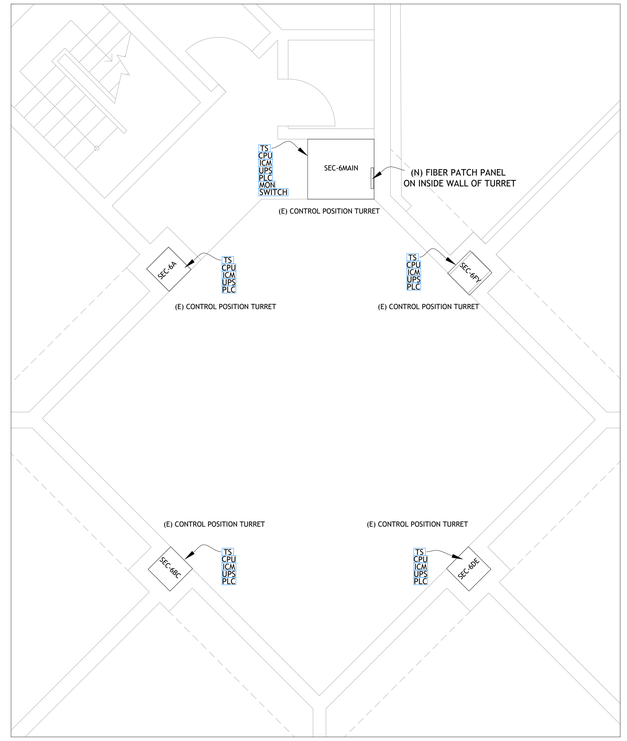

2 RM. 260D DETAIL

SCALE: 1/4" = 1'-0"

SHEET SE115 KEYNOTES:
A.) PANIC BUTTONS ARE WIRED TOGETHER IN SERIES.

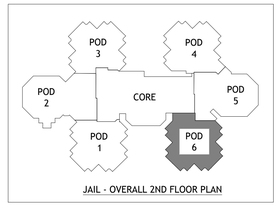

REVISION	DATE	DESCRIPTION
0	11/05/2018	SUBMITTAL
0.1	12/05/2018	JAIL SHEETS FOR D.O.T. REVIEW
1	08/01/2019	AS-BUILT SET
2	09/13/2019	ADDED CAMERAS FOR BOOKING, MEDICAL, AND OUTPATIENT
3	10/03/2019	ADDED CAMERAS IN PODS 1-6
4	12/26/2019	PEDESTAL INTERCOM "IC-G5" ADDED
5	01/23/2020	ACTALL ADDITIONS
6	04/02/2020	ADDED COURT CAMERAS
7	09/09/2020	ADDED POD-1 DURESS BUTTON
8	11/30/2020	2021 CCTV CAMERA REPLACEMENTS
9	07/22/2022	CH2 3RD FLOOR REMODEL (5) PANIC BUTTON RELOCATIONS, (2) DSI ALARMS
10	10/26/2022	CH2 3RD FLOOR REMODEL - ADDED DOOR F388X DSI ALARM (PER ASI NO. 4A)
11	11/08/2022	CH2 3RD FLOOR REMODEL - ADDED A 6TH PANIC ALARM FOR THE MEETING ROOM
12	07/19/2023	CH1 3RD FLOOR - RELOCATED "INTERPRETER" PANIC TO 307 COURTROOM.
13	10/05/2023	ADDITION OF SE GATE - CONTROL, INTERCOM, CAMERA
14	07/09/2024	REMOVAL OF GATE G4 - AS PART OF 2024 ADDITION/REMODEL CONSTRUCTION
15	09/05/2024	CH2 3RD FLOOR REMODEL (PHASE 2) (5) PANIC BUTTON RELOCATIONS, (4) DSI ALARMS
16	10/10/2024	(6) ADDED CAMERAS IN CH1 / CH2
17	04/28/2025	PHASE 2 REMODEL
18	06/15/2025	ADDED JAIL CAMERAS
19	07/24/2025	CH2 3RD FLOOR REMODEL / ADDITIONAL ALARMS (3) PANIC BUTTONS, (2) DSI ALARMS

PROJECT

ARAPAHOE COUNTY JUSTICE CENTER
7375 S. POTOMAC STREET
CENTENNIAL, CO 80112

SHEET NAME

SECURITY FLOOR PLAN -
JAIL 2ND FLOOR - POD 6

SHEET NUMBER

SE115

REVISION

19



SHEET SE116 KEYNOTES:

A.) DOOR CONTROL HOME RUNS TO CENTRAL CONTROL IN THE JAIL.
B.) ELEVATOR 1 CONTROL BOX
C.) ELEVATOR 2 CONTROL BOX
D.) LONG HALLWAY SHORTENED TO FIT ON SHEET
E.) CAMERAS FROM HERE ON ARE ON THE JAIL NETWORK.
F.) CAMERAS FROM HERE ON ARE ON THE COURT NETWORK.
G.) STAIRS EXIT ABOVE THRU DOOR "T1" IN BOOKING.
H.) NEW 1 1/2" CONDUIT FOR SEC CABLING.

1 SECURITY FLOOR PLAN - CH1 BASEMENT

SCALE: APPROX. 1/8" = 1'-0"

2 RM. 2A DETAIL

SCALE: APPROX. 1/4" = 1'-0"

REVISION	DATE	DESCRIPTION
0	11/05/2018	SUBMITTAL
0.1	12/05/2018	JAIL SHEETS FOR D.O.T. REVIEW
1	08/01/2019	AS-BUILT SET
2	09/13/2019	ADDED CAMERAS FOR BOOKING, MEDICAL, AND OUTPATIENT
3	10/03/2019	ADDED CAMERAS IN PODS 1-6
4	12/26/2019	PEDESTAL INTERCOM "IC-G5" ADDED
5	01/23/2020	ACTALL ADDITIONS
6	04/02/2020	ADDED COURT CAMERAS
7	09/09/2020	ADDED POD-1 DURESS BUTTON
8	11/30/2020	2021 CCTV CAMERA REPLACEMENTS
9	07/22/2022	CH2 3RD FLOOR REMODEL (5) PANIC BUTTON RELOCATIONS, (2) DSI ALARMS
10	10/26/2022	CH2 3RD FLOOR REMODEL - ADDED DOOR F388X DSI ALARM (PER ASI NO. 4A)
11	11/08/2022	CH2 3RD FLOOR REMODEL - ADDED A 6TH PANIC ALARM FOR THE MEETING ROOM
12	07/19/2023	CH1 3RD FLOOR - RELOCATED "INTERPRETER" PANIC TO 307 COURTROOM.
13	10/05/2023	ADDITION OF SE GATE - CONTROL, INTERCOM, CAMERA
14	07/09/2024	REMOVAL OF GATE G4 - AS PART OF 2024 ADDITION/REMODEL CONSTRUCTION
15	09/05/2024	CH2 3RD FLOOR REMODEL (PHASE 2) (5) PANIC BUTTON RELOCATIONS, (4) DSI ALARMS
16	10/10/2024	(6) ADDED CAMERAS IN CH1 / CH2
17	04/28/2025	PHASE 2 REMODEL
18	06/15/2025	ADDED JAIL CAMERAS
19	07/24/2025	CH2 3RD FLOOR REMODEL / ADDITIONAL ALARMS (3) PANIC BUTTONS, (2) DSI ALARMS

[redacted]

PROJECT

ARAPAHOE COUNTY JUSTICE CENTER
7375 S. POTOMAC STREET
CENTENNIAL, CO 80112

SHEET NAME

SECURITY FLOOR PLAN -
CH1 BASEMENT


SHEET NUMBER

SE116

REVISION

19



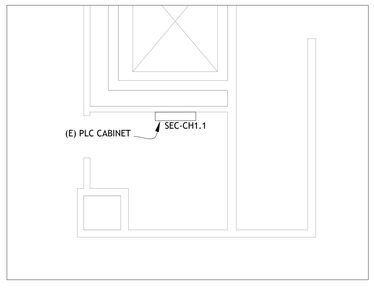

2 RM. C104C DETAIL

SCALE: APPROX. 1/4" = 1'-0"

3 RM. 111 DETAIL

SCALE: APPROX. 1/4" = 1'-0"

1 SECURITY FLOOR PLAN - CH1 FIRST FLOOR

SCALE: APPROX. 1/8" = 1'-0"

REVISION	DATE	DESCRIPTION
0	11/05/2018	SUBMITTAL
0.1	12/05/2018	JAIL SHEETS FOR D.O.T. REVIEW
1	08/01/2019	AS-BUILT SET
2	09/13/2019	ADDED CAMERAS FOR BOOKING, MEDICAL, AND OUTPATIENT
3	10/03/2019	ADDED CAMERAS IN PODS 1-6
4	12/26/2019	PEDESTAL INTERCOM "IC-G5" ADDED
5	01/23/2020	ACTALL ADDITIONS
6	04/02/2020	ADDED COURT CAMERAS
7	09/09/2020	ADDED POD-1 DURESS BUTTON
8	11/30/2020	2021 CCTV CAMERA REPLACEMENTS
9	07/22/2022	CH2 3RD FLOOR REMODEL (5) PANIC BUTTON RELOCATIONS, (2) DSI ALARMS
10	10/26/2022	CH2 3RD FLOOR REMODEL - ADDED DOOR F388X DSI ALARM (PER ASI NO. 4A)
11	11/08/2022	CH2 3RD FLOOR REMODEL - ADDED A 6TH PANIC ALARM FOR THE MEETING ROOM
12	07/19/2023	CH1 3RD FLOOR - RELOCATED "INTERPRETER" PANIC TO 307 COURTROOM.
13	10/05/2023	ADDITION OF SE GATE - CONTROL, INTERCOM, CAMERA
14	07/09/2024	REMOVAL OF GATE G4 - AS PART OF 2024 ADDITION/REMODEL CONSTRUCTION
15	09/05/2024	CH2 3RD FLOOR REMODEL (PHASE 2) (5) PANIC BUTTON RELOCATIONS, (4) DSI ALARMS
16	10/10/2024	(6) ADDED CAMERAS IN CH1 / CH2
17	04/28/2025	PHASE 2 REMODEL
18	06/15/2025	ADDED JAIL CAMERAS
19	07/24/2025	CH2 3RD FLOOR REMODEL / ADDITIONAL ALARMS (3) PANIC BUTTONS, (2) DSI ALARMS

[redacted]

ROJECT

ARAPAHOE COUNTY JUSTICE CENTER
7375 S. POTOMAC STREET
CENTENNIAL, CO 80112

HEET NAME

SECURITY FLOOR PLAN -
CH1 1ST FLOOR

HEET NUMBER

SE117

REVISION

19



1 SECURITY FLOOR PLAN - CH1 2ND FLOOR

SCALE: APPROX. 1/8" = 1'-0"

2 RM. 220 DETAIL

SCALE: APPROX. 1/4" = 1'-0"

REVISION	DATE	DESCRIPTION
0	11/05/2018	SUBMITTAL
0.1	12/05/2018	JAIL SHEETS FOR D.O.T. REVIEW
1	08/01/2019	AS-BUILT SET
2	09/13/2019	ADDED CAMERAS FOR BOOKING, MEDICAL, AND OUTPATIENT
3	10/03/2019	ADDED CAMERAS IN PODS 1-6
4	12/26/2019	PEDESTAL INTERCOM "IC-G5" ADDED
5	01/23/2020	ACTALL ADDITIONS
6	04/02/2020	ADDED COURT CAMERAS
7	09/09/2020	ADDED POD-1 DURESS BUTTON
8	11/30/2020	2021 CCTV CAMERA REPLACEMENTS
9	07/22/2022	CH2 3RD FLOOR REMODEL (5) PANIC BUTTON RELOCATIONS, (2) DSI ALARMS
10	10/26/2022	CH2 3RD FLOOR REMODEL - ADDED DOOR F388X DSI ALARM (PER ASI NO. 4A)
11	11/08/2022	CH2 3RD FLOOR REMODEL - ADDED A 6TH PANIC ALARM FOR THE MEETING ROOM
12	07/19/2023	CH1 3RD FLOOR - RELOCATED "INTERPRETER" PANIC TO 307 COURTROOM.
13	10/05/2023	ADDITION OF SE GATE - CONTROL, INTERCOM, CAMERA
14	07/09/2024	REMOVAL OF GATE G4 - AS PART OF 2024 ADDITION/REMODEL CONSTRUCTION
15	09/05/2024	CH2 3RD FLOOR REMODEL (PHASE 2) (5) PANIC BUTTON RELOCATIONS, (4) DSI ALARMS
16	10/10/2024	(6) ADDED CAMERAS IN CH1 / CH2
17	04/28/2025	PHASE 2 REMODEL
18	06/15/2025	ADDED JAIL CAMERAS
19	07/24/2025	CH2 3RD FLOOR REMODEL / ADDITIONAL ALARMS (3) PANIC BUTTONS, (2) DSI ALARMS

[redacted]

PROJECT

ARAPAHOE COUNTY JUSTICE CENTER
7375 S. POTOMAC STREET
CENTENNIAL, CO 80112

SHEET NAME

SECURITY FLOOR PLAN - CH1 2ND FLOOR

SHEET NUMBER

SE118

REVISION

19



1 SECURITY FLOOR PLAN -CH1 3RD FLOOR

SCALE: APPROX. 1/8" = 1'-0"

2 RM 313C DETAIL

SCALE: APPROX. 1/4" = 1'-0"

REVISION	DATE	DESCRIPTION
0	11/05/2018	SUBMITTAL
0.1	12/05/2018	JAIL SHEETS FOR D.O.T. REVIEW
1	08/01/2019	AS-BUILT SET
2	09/13/2019	ADDED CAMERAS FOR BOOKING, MEDICAL, AND OUTPATIENT
3	10/03/2019	ADDED CAMERAS IN PODS 1-6
4	12/26/2019	PEDESTAL INTERCOM "IC-G5" ADDED
5	01/23/2020	ACTALL ADDITIONS
6	04/02/2020	ADDED COURT CAMERAS
7	09/09/2020	ADDED POD-1 DURESS BUTTON
8	11/30/2020	2021 CCTV CAMERA REPLACEMENTS
9	07/22/2022	CH2 3RD FLOOR REMODEL (5) PANIC BUTTON RELOCATIONS, (2) DSI ALARMS
10	10/26/2022	CH2 3RD FLOOR REMODEL - ADDED DOOR F388X DSI ALARM (PER ASI NO. 4A)
11	11/08/2022	CH2 3RD FLOOR REMODEL - ADDED A 6TH PANIC ALARM FOR THE MEETING ROOM
12	07/19/2023	CH1 3RD FLOOR - RELOCATED "INTERPRETER" PANIC TO 307 COURTROOM.
13	10/05/2023	ADDITION OF SE GATE - CONTROL, INTERCOM, CAMERA
14	07/09/2024	REMOVAL OF GATE G4 - AS PART OF 2024 ADDITION/REMODEL CONSTRUCTION
15	09/05/2024	CH2 3RD FLOOR REMODEL (PHASE 2) (5) PANIC BUTTON RELOCATIONS, (4) DSI ALARMS
16	10/10/2024	(6) ADDED CAMERAS IN CH1 / CH2
17	04/28/2025	PHASE 2 REMODEL
18	06/15/2025	ADDED JAIL CAMERAS
19	07/24/2025	CH2 3RD FLOOR REMODEL / ADDITIONAL ALARMS (3) PANIC BUTTONS, (2) DSI ALARMS

[redacted]

PROJECT

ARAPAHOE COUNTY JUSTICE CENTER
7375 S. POTOMAC STREET
CENTENNIAL, CO 80112

SHEET NAME

SECURITY FLOOR PLAN - CH1 3RD FLOOR

SHEET NUMBER

SE119

REVISION

19



1 SECURITY FLOOR PLAN - CH1 4TH FLOOR

SCALE: APPROX. 1/8" = 1'-0"

2 RM. 409G DETAIL

SCALE: APPROX. 1/4" = 1'-0"

REVISION	DATE	DESCRIPTION
0	11/05/2018	SUBMITTAL
0.1	12/05/2018	JAIL SHEETS FOR D.O.T. REVIEW
1	08/01/2019	AS-BUILT SET
2	09/13/2019	ADDED CAMERAS FOR BOOKING, MEDICAL, AND OUTPATIENT
3	10/03/2019	ADDED CAMERAS IN PODS 1-6
4	12/26/2019	PEDESTAL INTERCOM "IC-G5" ADDED
5	01/23/2020	ACTALL ADDITIONS
6	04/02/2020	ADDED COURT CAMERAS
7	09/09/2020	ADDED POD-1 DURESS BUTTON
8	11/30/2020	2021 CCTV CAMERA REPLACEMENTS
9	07/22/2022	CH2 3RD FLOOR REMODEL (5) PANIC BUTTON RELOCATIONS, (2) DSI ALARMS
10	10/26/2022	CH2 3RD FLOOR REMODEL - ADDED DOOR F388X DSI ALARM (PER ASI NO. 4A)
11	11/08/2022	CH2 3RD FLOOR REMODEL - ADDED A 6TH PANIC ALARM FOR THE MEETING ROOM
12	07/19/2023	CH1 3RD FLOOR - RELOCATED "INTERPRETER" PANIC TO 307 COURTROOM.
13	10/05/2023	ADDITION OF SE GATE - CONTROL, INTERCOM, CAMERA
14	07/09/2024	REMOVAL OF GATE G4 - AS PART OF 2024 ADDITION/REMODEL CONSTRUCTION
15	09/05/2024	CH2 3RD FLOOR REMODEL (PHASE 2) (5) PANIC BUTTON RELOCATIONS, (4) DSI ALARMS
16	10/10/2024	(6) ADDED CAMERAS IN CH1 / CH2
17	04/28/2025	PHASE 2 REMODEL
18	06/15/2025	ADDED JAIL CAMERAS
19	07/24/2025	CH2 3RD FLOOR REMODEL / ADDITIONAL ALARMS (3) PANIC BUTTONS, (2) DSI ALARMS

[redacted]

PROJECT

ARAPAHOE COUNTY JUSTICE CENTER
7375 S. POTOMAC STREET
CENTENNIAL, CO 80112

SHEET NAME


SECURITY FLOOR PLAN - CH1 4TH FLOOR

SHEET NUMBER


SE120

REVISION


19

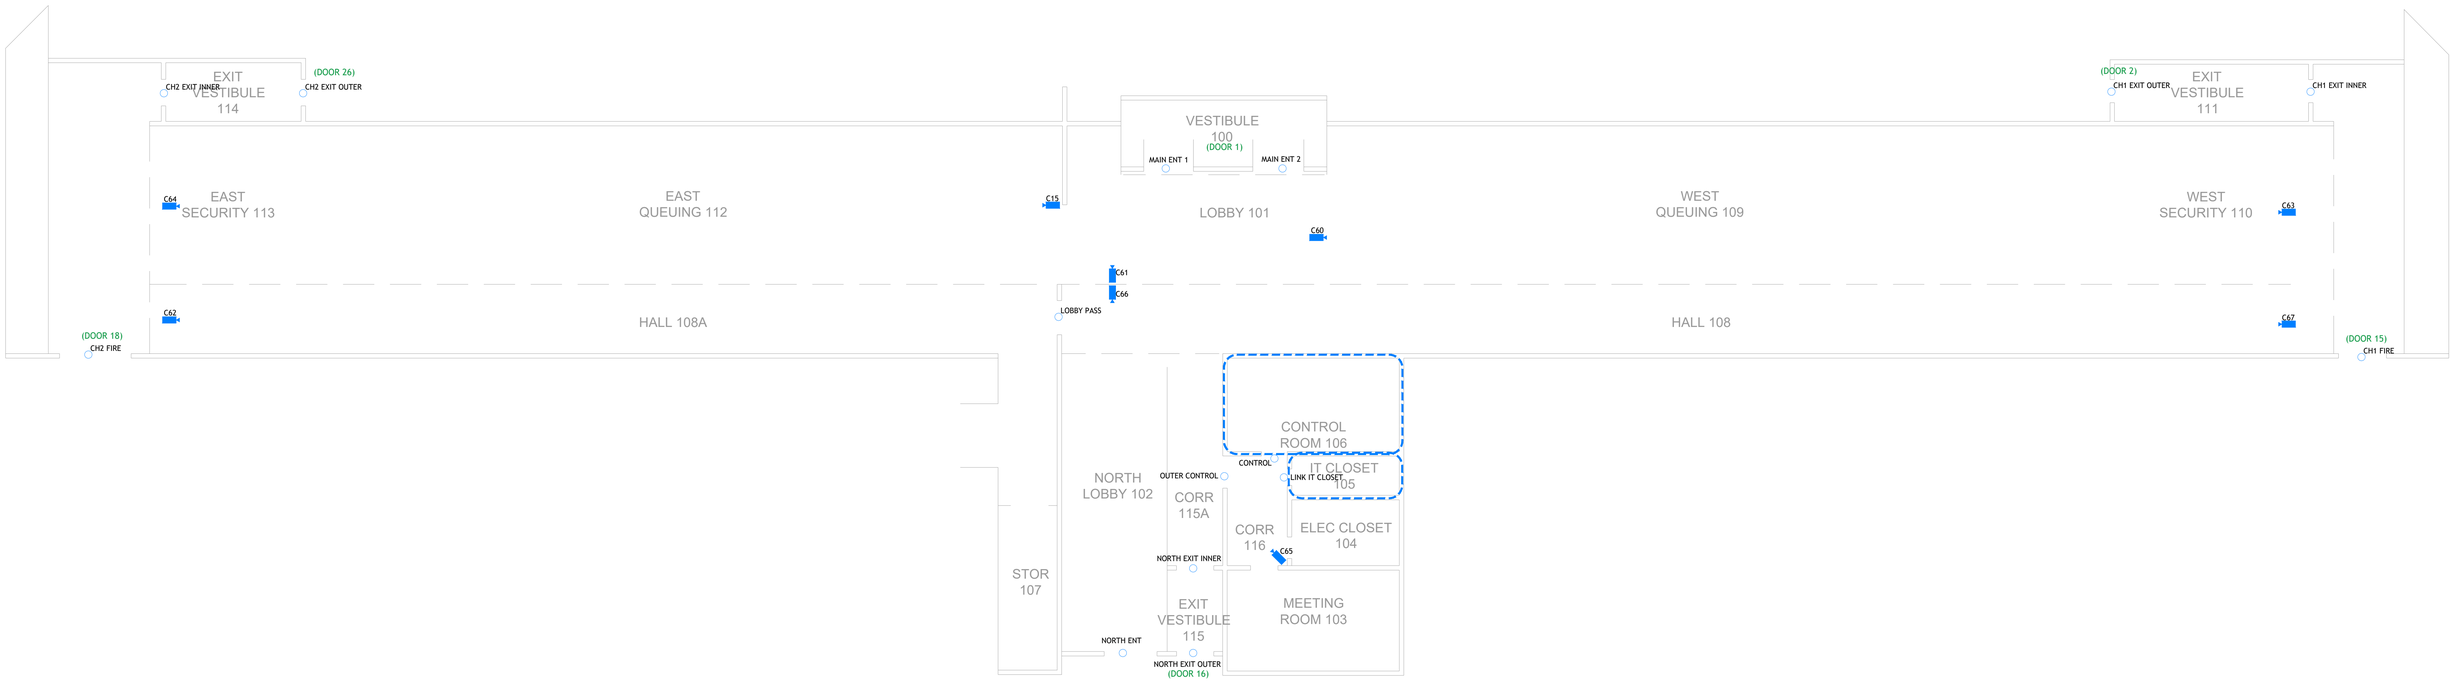


1 SECURITY FLOOR PLAN - LINK
SCALE: APPROX. 1/8" = 1'-0"

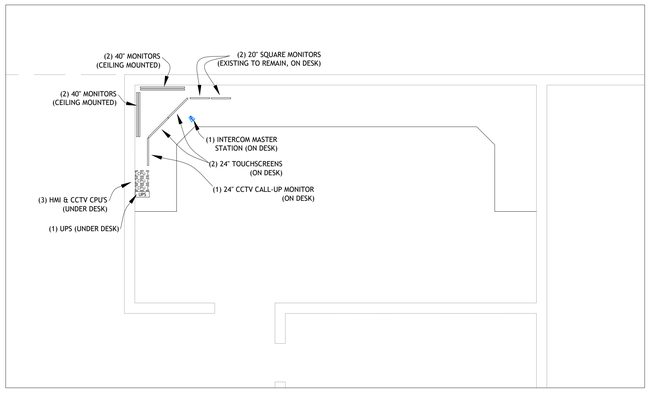

1 RM. 106 DETAIL
SCALE: APPROX. 1/4" = 1'-0"

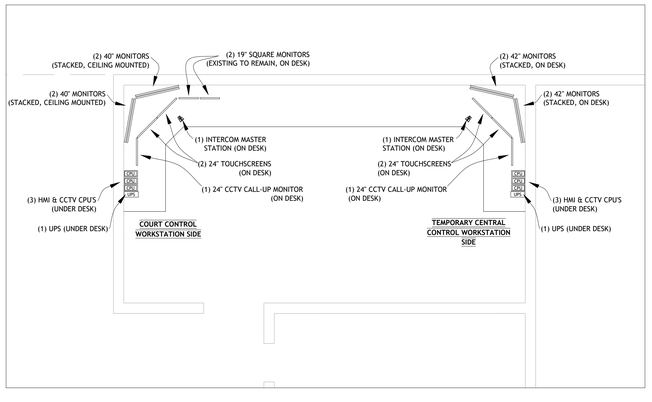

2 RM. 106 DETAIL - TEMPORARY SETUP WITH CENTRAL CONTROL
SCALE: APPROX. 1/4" = 1'-0"

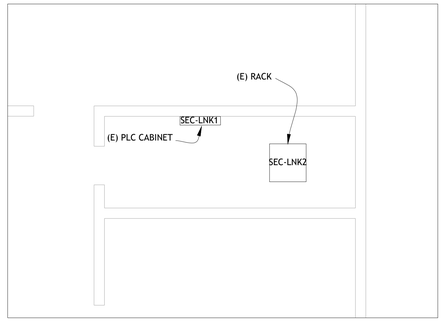

3 RM. 105 DETAIL
SCALE: APPROX. 1/4" = 1'-0"


REVISION	DATE	DESCRIPTION	REVISION	DATE	DESCRIPTION	REVISION	DATE	DESCRIPTION
0	11/05/2018	SUBMITTAL	6	04/02/2020	ADDED COURT CAMERAS	13	10/05/2023	ADDITION OF SE GATE - CONTROL, INTERCOM, CAMERA
0.1	12/05/2018	JAIL SHEETS FOR D.O.T. REVIEW	7	09/09/2020	ADDED POD-1 DURESS BUTTON	14	07/09/2024	REMOVAL OF GATE G4 - AS PART OF 2024 ADDITION/REMODEL CONSTRUCTION
1	08/01/2019	AS-BUILT SET	8	11/30/2020	2021 CCTV CAMERA REPLACEMENTS	15	09/05/2024	CH2 3RD FLOOR REMODEL (PHASE 2) (5) PANIC BUTTON RELOCATIONS, (4) DSI ALARMS
2	09/13/2019	ADDED CAMERAS FOR BOOKING, MEDICAL, AND OUTPATIENT	9	07/22/2022	CH2 3RD FLOOR REMODEL (5) PANIC BUTTON RELOCATIONS, (2) DSI ALARMS	16	10/10/2024	(6) ADDED CAMERAS IN CH1 / CH2
3	10/03/2019	ADDED CAMERAS IN PODS 1-6	10	10/26/2022	CH2 3RD FLOOR REMODEL - ADDED DOOR F388X DSI ALARM (PER ASI NO. 4A)	17	04/28/2025	PHASE 2 REMODEL
4	12/26/2019	PEDESTAL INTERCOM "IC-G5" ADDED	11	11/08/2022	CH2 3RD FLOOR REMODEL - ADDED A 6TH PANIC ALARM FOR THE MEETING ROOM	18	06/15/2025	ADDED JAIL CAMERAS
5	01/23/2020	ACTALL ADDITIONS	12	07/19/2023	CH1 3RD FLOOR - RELOCATED "INTERPRETER" PANIC TO 307 COURTROOM.	19	07/24/2025	CH2 3RD FLOOR REMODEL / ADDITIONAL ALARMS (3) PANIC BUTTONS, (2) DSI ALARMS

PROJECT
ARAPAHOE COUNTY JUSTICE CENTER
7375 S. POTOMAC STREET
CENTENNIAL, CO 80112

SHEET NAME
SECURITY FLOOR PLAN - LINK

SHEET NUMBER
SE121

REVISION
19

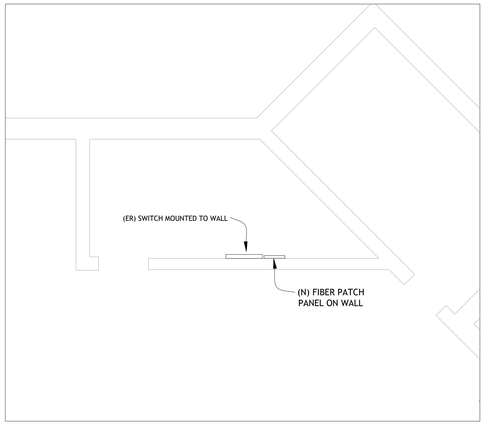

2 **RM. 003 DETAIL**
SCALE: APPROX. 1/4" = 1'-0"



SHEET SE122 KEYNOTES:
A.) CCTV WORKSTATION DISPLAYING A STATIC VIEW OF THE INTERIOR OF CH2 JUDGE ELEVATOR.

1 **SECURITY FLOOR PLAN - CH2 BASEMENT**
SCALE: APPROX. 1/8" = 1'-0"

REVISION	DATE	DESCRIPTION	REVISION	DATE	DESCRIPTION	REVISION	DATE	DESCRIPTION
0	11/05/2018	SUBMITTAL	6	04/02/2020	ADDED COURT CAMERAS	13	10/05/2023	ADDITION OF SE GATE - CONTROL, INTERCOM, CAMERA
0.1	12/05/2018	JAIL SHEETS FOR D.O.T. REVIEW	7	09/09/2020	ADDED POD-1 DURESS BUTTON	14	07/09/2024	REMOVAL OF GATE G4 - AS PART OF 2024 ADDITION/REMODEL CONSTRUCTION
1	08/01/2019	AS-BUILT SET	8	11/30/2020	2021 CCTV CAMERA REPLACEMENTS	15	09/05/2024	CH2 3RD FLOOR REMODEL (PHASE 2) (5) PANIC BUTTON RELOCATIONS, (4) DSI ALARMS
2	09/13/2019	ADDED CAMERAS FOR BOOKING, MEDICAL, AND OUTPATIENT	9	07/22/2022	CH2 3RD FLOOR REMODEL (5) PANIC BUTTON RELOCATIONS, (2) DSI ALARMS	16	10/10/2024	(6) ADDED CAMERAS IN CH1 / CH2
3	10/03/2019	ADDED CAMERAS IN PODS 1-6	10	10/26/2022	CH2 3RD FLOOR REMODEL - ADDED DOOR F388X DSI ALARM (PER ASI NO. 4A)	17	04/28/2025	PHASE 2 REMODEL
4	12/26/2019	PEDESTAL INTERCOM "IC-G5" ADDED	11	11/08/2022	CH2 3RD FLOOR REMODEL - ADDED A 6TH PANIC ALARM FOR THE MEETING ROOM	18	06/15/2025	ADDED JAIL CAMERAS
5	01/23/2020	ACTALL ADDITIONS	12	07/19/2023	CH1 3RD FLOOR - RELOCATED "INTERPRETER" PANIC TO 307 COURTROOM.	19	07/24/2025	CH2 3RD FLOOR REMODEL / ADDITIONAL ALARMS (3) PANIC BUTTONS, (2) DSI ALARMS

[redacted]

PROJECT
ARAPAHOE COUNTY JUSTICE CENTER
7375 S. POTOMAC STREET
CENTENNIAL, CO 80112

SHEET NAME
SECURITY FLOOR PLAN - CH2 BASEMENT

SHEET NUMBER
SE122

REVISION
19

2 **RM. 111 DETAIL**
SCALE: APPROX. 1/4" = 1'-0"



1 **SECURITY FLOOR PLAN - CH2 FIRST FLOOR**
SCALE: APPROX. 1/8" = 1'-0"

REVISION	DATE	DESCRIPTION
0	11/05/2018	SUBMITTAL
0.1	12/05/2018	JAIL SHEETS FOR D.O.T. REVIEW
1	08/01/2019	AS-BUILT SET
2	09/13/2019	ADDED CAMERAS FOR BOOKING, MEDICAL, AND OUTPATIENT
3	10/03/2019	ADDED CAMERAS IN PODS 1-6
4	12/26/2019	PEDESTAL INTERCOM "IC-G5" ADDED
5	01/23/2020	ACTALL ADDITIONS
6	04/02/2020	ADDED COURT CAMERAS
7	09/09/2020	ADDED POD-1 DURESS BUTTON
8	11/30/2020	2021 CCTV CAMERA REPLACEMENTS
9	07/22/2022	CH2 3RD FLOOR REMODEL (5) PANIC BUTTON RELOCATIONS, (2) DSI ALARMS
10	10/26/2022	CH2 3RD FLOOR REMODEL - ADDED DOOR F388X DSI ALARM (PER ASI NO. 4A)
11	11/08/2022	CH2 3RD FLOOR REMODEL - ADDED A 6TH PANIC ALARM FOR THE MEETING ROOM
12	07/19/2023	CH1 3RD FLOOR - RELOCATED "INTERPRETER" PANIC TO 307 COURTROOM.
13	10/05/2023	ADDITION OF SE GATE - CONTROL, INTERCOM, CAMERA
14	07/09/2024	REMOVAL OF GATE G4 - AS PART OF 2024 ADDITION/REMODEL CONSTRUCTION
15	09/05/2024	CH2 3RD FLOOR REMODEL (PHASE 2) (5) PANIC BUTTON RELOCATIONS, (4) DSI ALARMS
16	10/10/2024	(6) ADDED CAMERAS IN CH1 / CH2
17	04/28/2025	PHASE 2 REMODEL
18	06/15/2025	ADDED JAIL CAMERAS
19	07/24/2025	CH2 3RD FLOOR REMODEL / ADDITIONAL ALARMS (3) PANIC BUTTONS, (2) DSI ALARMS

[redacted]

PROJECT
ARAPAHOE COUNTY JUSTICE CENTER
7375 S. POTOMAC STREET
CENTENNIAL, CO 80112

SHEET NAME
SECURITY FLOOR PLAN -
CH2 1ST FLOOR

SHEET NUMBER
SE123

REVISION
19

2 RM. 211 DETAIL

SCALE: APPROX. 1/4" = 1'-0"



1 SECURITY FLOOR PLAN -CH2 2ND FLOOR

SCALE: APPROX. 1/8" = 1'-0"

REVISION	DATE	DESCRIPTION	REVISION	DATE	DESCRIPTION	REVISION	DATE	DESCRIPTION
0	11/05/2018	SUBMITTAL	6	04/02/2020	ADDED COURT CAMERAS	13	10/05/2023	ADDITION OF SE GATE - CONTROL, INTERCOM, CAMERA
0.1	12/05/2018	JAIL SHEETS FOR D.O.T. REVIEW	7	09/09/2020	ADDED POD-1 DURESS BUTTON	14	07/09/2024	REMOVAL OF GATE G4 - AS PART OF 2024 ADDITION/REMODEL CONSTRUCTION
1	08/01/2019	AS-BUILT SET	8	11/30/2020	2021 CCTV CAMERA REPLACEMENTS	15	09/05/2024	CH2 3RD FLOOR REMODEL (PHASE 2) (5) PANIC BUTTON RELOCATIONS, (4) DSI ALARMS
2	09/13/2019	ADDED CAMERAS FOR BOOKING, MEDICAL, AND OUTPATIENT	9	07/22/2022	CH2 3RD FLOOR REMODEL (5) PANIC BUTTON RELOCATIONS, (2) DSI ALARMS	16	10/10/2024	(6) ADDED CAMERAS IN CH1 / CH2
3	10/03/2019	ADDED CAMERAS IN PODS 1-6	10	10/26/2022	CH2 3RD FLOOR REMODEL - ADDED DOOR F388X DSI ALARM (PER ASI NO. 4A)	17	04/28/2025	PHASE 2 REMODEL
4	12/26/2019	PEDESTAL INTERCOM "IC-G5" ADDED	11	11/08/2022	CH2 3RD FLOOR REMODEL - ADDED A 6TH PANIC ALARM FOR THE MEETING ROOM	18	06/15/2025	ADDED JAIL CAMERAS
5	01/23/2020	ACTALL ADDITIONS	12	07/19/2023	CH1 3RD FLOOR - RELOCATED "INTERPRETER" PANIC TO 307 COURTROOM.	19	07/24/2025	CH2 3RD FLOOR REMODEL / ADDITIONAL ALARMS (3) PANIC BUTTONS, (2) DSI ALARMS

PROJECT

ARAPAHOE COUNTY JUSTICE CENTER
7375 S. POTOMAC STREET
CENTENNIAL, CO 80112

SHEET NAME

SECURITY FLOOR PLAN - CH2 2ND FLOOR

SHEET NUMBER

SE124

REVISION

19

2 RM. 334 DETAIL

SCALE: APPROX. 1/4" = 1'-0"



1 SECURITY FLOOR PLAN - CH2 3RD FLOOR

SCALE: APPROX. 1/8" = 1'-0"

REVISION	DATE	DESCRIPTION
0	11/05/2018	SUBMITTAL
0.1	12/05/2018	JAIL SHEETS FOR D.O.T. REVIEW
1	08/01/2019	AS-BUILT SET
2	09/13/2019	ADDED CAMERAS FOR BOOKING, MEDICAL, AND OUTPATIENT
3	10/03/2019	ADDED CAMERAS IN PODS 1-6
4	12/26/2019	PEDESTAL INTERCOM "IC-G5" ADDED
5	01/23/2020	ACTALL ADDITIONS
6	04/02/2020	ADDED COURT CAMERAS
7	09/09/2020	ADDED POD-1 DURESS BUTTON
8	11/30/2020	2021 CCTV CAMERA REPLACEMENTS
9	07/22/2022	CH2 3RD FLOOR REMODEL (5) PANIC BUTTON RELOCATIONS, (2) DSI ALARMS
10	10/26/2022	CH2 3RD FLOOR REMODEL - ADDED DOOR F388X DSI ALARM (PER ASI NO. 4A)
11	11/08/2022	CH2 3RD FLOOR REMODEL - ADDED A 6TH PANIC ALARM FOR THE MEETING ROOM
12	07/19/2023	CH1 3RD FLOOR - RELOCATED "INTERPRETER" PANIC TO 307 COURTROOM.
13	10/05/2023	ADDITION OF SE GATE - CONTROL, INTERCOM, CAMERA
14	07/09/2024	REMOVAL OF GATE G4 - AS PART OF 2024 ADDITION/REMODEL CONSTRUCTION
15	09/05/2024	CH2 3RD FLOOR REMODEL (PHASE 2) (5) PANIC BUTTON RELOCATIONS, (4) DSI ALARMS
16	10/10/2024	(6) ADDED CAMERAS IN CH1 / CH2
17	04/28/2025	PHASE 2 REMODEL
18	06/15/2025	ADDED JAIL CAMERAS
19	07/24/2025	CH2 3RD FLOOR REMODEL / ADDITIONAL ALARMS (3) PANIC BUTTONS, (2) DSI ALARMS

PROJECT

ARAPAHOE COUNTY JUSTICE CENTER
7375 S. POTOMAC STREET
CENTENNIAL, CO 80112

SHEET NAME

SECURITY FLOOR PLAN - CH2 3RD FLOOR

SHEET NUMBER

SE125

REVISION

19