FAN SCHEDULE - BASEMENT FLOOR


MARK	DESCRIPTION	PERFORMANCE				ELECTRICAL				
		CFM	TSP	RPM	BHP	HP	POWER	MODEL	WT.	REMARKS
EF-6	STORAGE EXHAUST	400	0.50"	1075	-	1/3	120/1P	COOK GEMINI 16-10N		BASEMENT STORAGE EXHAUST
EF-11	EQUIP. ROOM EXHAUST	1000	0.125"	1075	-	1/2	120/1P	COOK GEMINI 18-10N		BASEMENT STORAGE EXHAUST
TF-12	EQUIP. ROOM EXHAUST	1000	0.125"	1075	-	1/2	120/1P	COOK GEMINI 18-10N		BASEMENT ELECTRICAL ROOM
TF-13	EQUIP. ROOM EXHAUST	1000	0.125"	1075	-	1/2	120/1P	COOK GEMINI 18-10N		BASEMENT ELECTRICAL ROOM
TF-14	EQUIP. ROOM EXHAUST	1000	0.125"	1075	-	1/2	120/1P	COOK GEMINI 18-10N		BASEMENT SERVER ROOM

MECHANICAL SYMBOLS

EXISTING DUCTWORK	6x10
EXTERIOR DUCTWORK	6x10
REGISTERS & DIFFUSERS	
EXISTING DENOTED AS	(E)
EQUIPMENT TAG	503
THERMOSTAT	T
SWITCH	S
DIRECTIONAL ARROW	
UNDERCUT DOOR DENOTED AS	U.C.
PIPING DROP	
PIPING RISE	
PIPING TEE	
EXISTING PIPE END	
FIRE/SMOKE DAMPER	F/SD
FIRE DAMPER	FD
RADIATION DAMPER	RD
HOT WATER SUPPLY	HWS
HOT WATER RETURN	HWR
COLD WATER SUPPLY	CWS
COLD WATER RETURN	CWR

VARIABLE AIR VOLUME TERMINAL UNIT SCHEDULE - BASEMENT FLOOR

MARK	EXISTING /NEW	COOLING CFM	MIN CFM	FAN CFM	INLET DIA.	FAN POWER	FAN HP	MODEL	REMARKS
B-1	E	900	405	-	10	-	-	KRUEGER LMHS	-
B-2	E	650	195	-	8	-	-	KRUEGER LMHS	-
B-3	E	800	272	-	8	-	-	KRUEGER LMHS	-
B-4	E	500	150	-	8	-	-	KRUEGER LMHS	-
B-5	E	1200	360	-	10	-	-	KRUEGER LMHS	-
B-6	E	500	155	-	8	-	-	KRUEGER LMHS	-
B-7	E	500	275	-	8	-	-	KRUEGER LMHS	-
B-8	E	300	132	-	6	-	-	KRUEGER LMHS	-
B-9	E	400	160	-	6	-	-	KRUEGER LMHS	-
B-10	E	1400	420	-	12	-	-	KRUEGER LMHS	-
B-11	E	1050	315	-	10	-	-	KRUEGER LMHS	-
B-12	E	1100	362	-	10	-	-	KRUEGER LMHS	UNABLE TO VERIFY ENTIRE HVAC SYSTEM DUE TO DR. OFF. SECURITY CONSTRAINTS
B-13	E	375	113	-	6	-	-	KRUEGER LMHS	-
B-14	E	450	171	-	8	-	-	KRUEGER LMHS	-

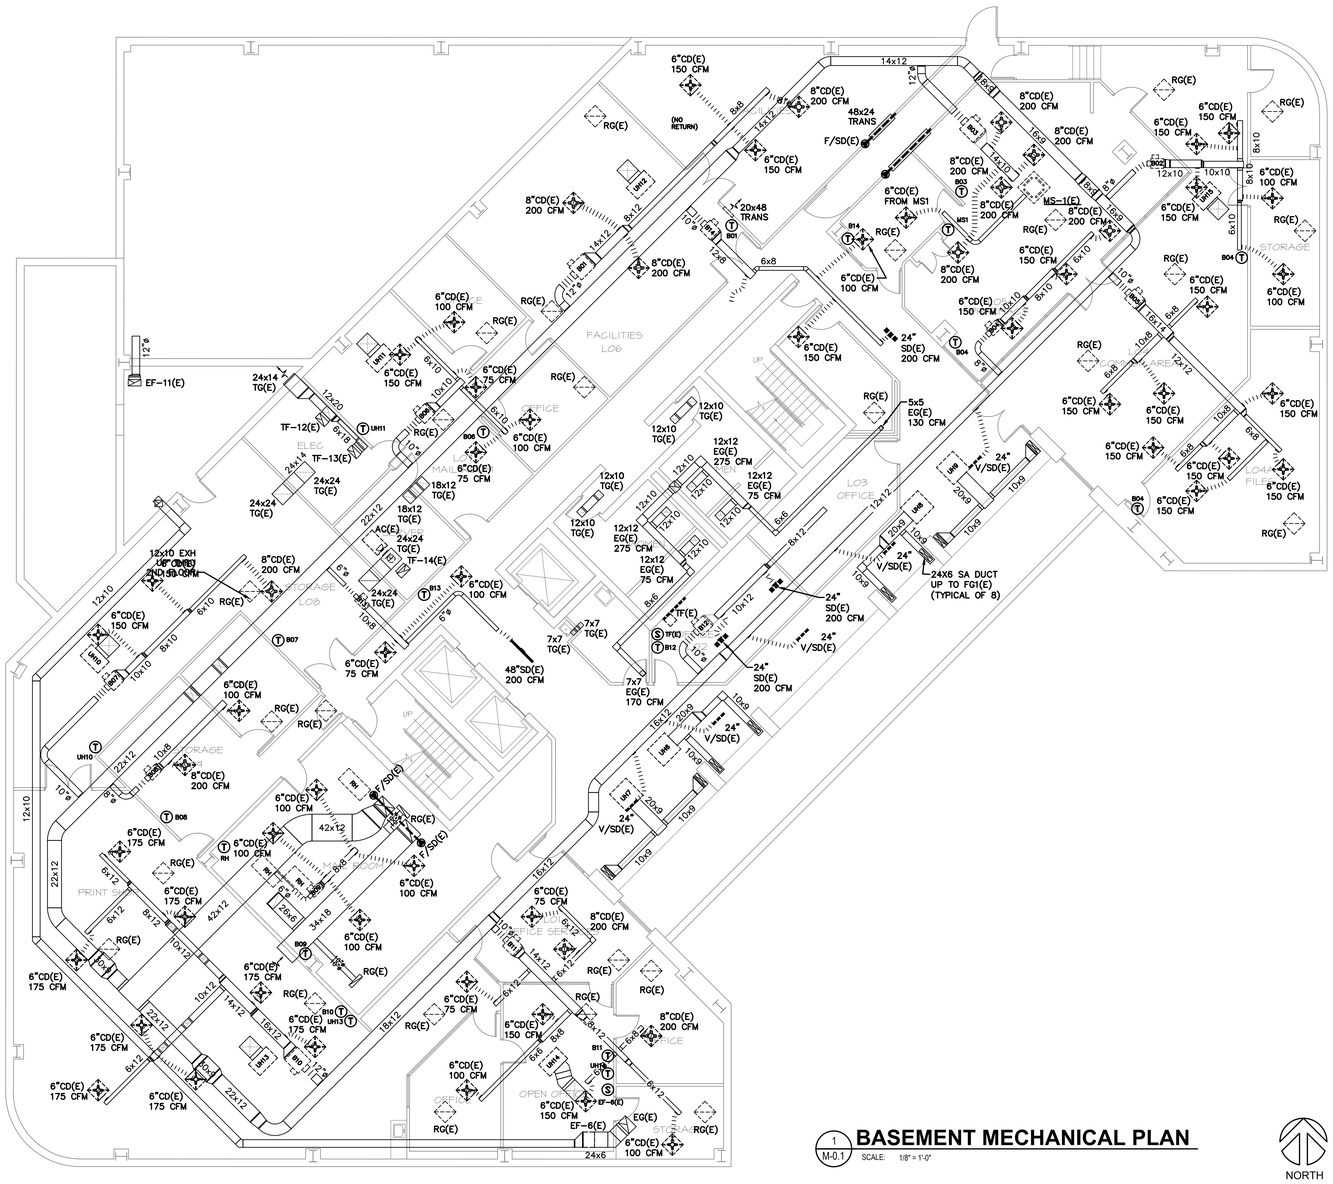

1 M-0.1 **BASEMENT MECHANICAL PLAN**

SCALE: 1/8" = 1'-0"

NORTH

Chavez Tiffany & Ayers Engineering Corporation

119 West Cucharras Street
Colorado Springs, Colorado 80903
P (719)636-0021

COLORADO LICENSED DOMINIC A. PAPPALARDO 43979 PROFESSIONAL ENGINEER

06/30/20

CITY ADMINISTRATION BUILDING

AS BUILT DRAWINGS OF EXISTING HVAC
30 SOUTH NEVADA
COLORADO SPRINGS, COLORADO

ISSUE HISTORY:

1	99% AS BUILT	03/30/20
2	FINAL AS BUILT	06/30/20

DRAWN BY	KSP
CHECKED BY	DAT
DATE	6/30/20

DRAWING TITLE
BASEMENT MECHANICAL PLAN


DRAWING NO.
M-0.1

MECHANICAL SYMBOLS

EXISTING DUCTWORK	6x10
EXTERIOR DUCTWORK	6x10
REGISTERS & DIFFUSERS	
EXISTING DENOTED AS	(E)
EQUIPMENT TAG	503
THERMOSTAT	T
SWITCH	S
DIRECTIONAL ARROW	
UNDERCUT DOOR DENOTED AS	U.C.
PIPING DROP	
PIPING RISE	
PIPING TEE	
EXISTING PIPE END	
FIRE/SMOKE DAMPER	F/SD
FIRE DAMPER	FD
RADIATION DAMPER	RD
HOT WATER SUPPLY	HWS
HOT WATER RETURN	HWR
COLD WATER SUPPLY	CWS
COLD WATER RETURN	CWR

UNIT HEATER SCHEDULE - BASEMENT FLOOR

MARK	DESCRIPTION	BTU INPUT	GPM	WATER EWT	WATER LWT	ELECTRICAL HP	ELECTRICAL POWER	MODEL	REMARKS
UH-6	HYDRONIC UNIT HEATER	40.0 MBH	4.0	200	180	2.8 FLA	120/1P	CARRIER 42DC-2	SERVING ATRIUM ABOVE
UH-7	HYDRONIC UNIT HEATER	40.0 MBH	4.0	200	180	2.8 FLA	120/1P	CARRIER 42DC-2	SERVING ATRIUM ABOVE
UH-8	HYDRONIC UNIT HEATER	40.0 MBH	4.0	200	180	2.8 FLA	120/1P	CARRIER 42DC-2	SERVING ATRIUM ABOVE
UH-9	HYDRONIC UNIT HEATER	40.0 MBH	4.0	200	180	2.8 FLA	120/1P	CARRIER 42DC-2	SERVING ATRIUM ABOVE
UH-10	HYDRONIC UNIT HEATER	10.5 MBH	1.0	200	180	2.6 FLA	120/1P	CARRIER 42DE-1	BASEMENT STORAGE
UH-11	HYDRONIC UNIT HEATER	10.5 MBH	1.0	200	180	2.6 FLA	120/1P	CARRIER 42DE-1	BASEMENT OFFICE
UH-12	HYDRONIC UNIT HEATER	10.5 MBH	1.0	200	180	2.6 FLA	120/1P	CARRIER 42DE-1	BASEMENT STORAGE
UH-13	HYDRONIC UNIT HEATER	10.5 MBH	1.0	200	180	2.6 FLA	120/1P	CARRIER 42DE-1	BASEMENT PRINT ROOM
UH-14	HYDRONIC UNIT HEATER	10.5 MBH	1.0	200	180	2.6 FLA	120/1P	CARRIER 42DE-1	BASEMENT OFFICE
UH-15	HYDRONIC UNIT HEATER	10.5 MBH	1.0	200	180	2.6 FLA	120/1P	CARRIER 42DE-1	BASEMENT BREAKROOM

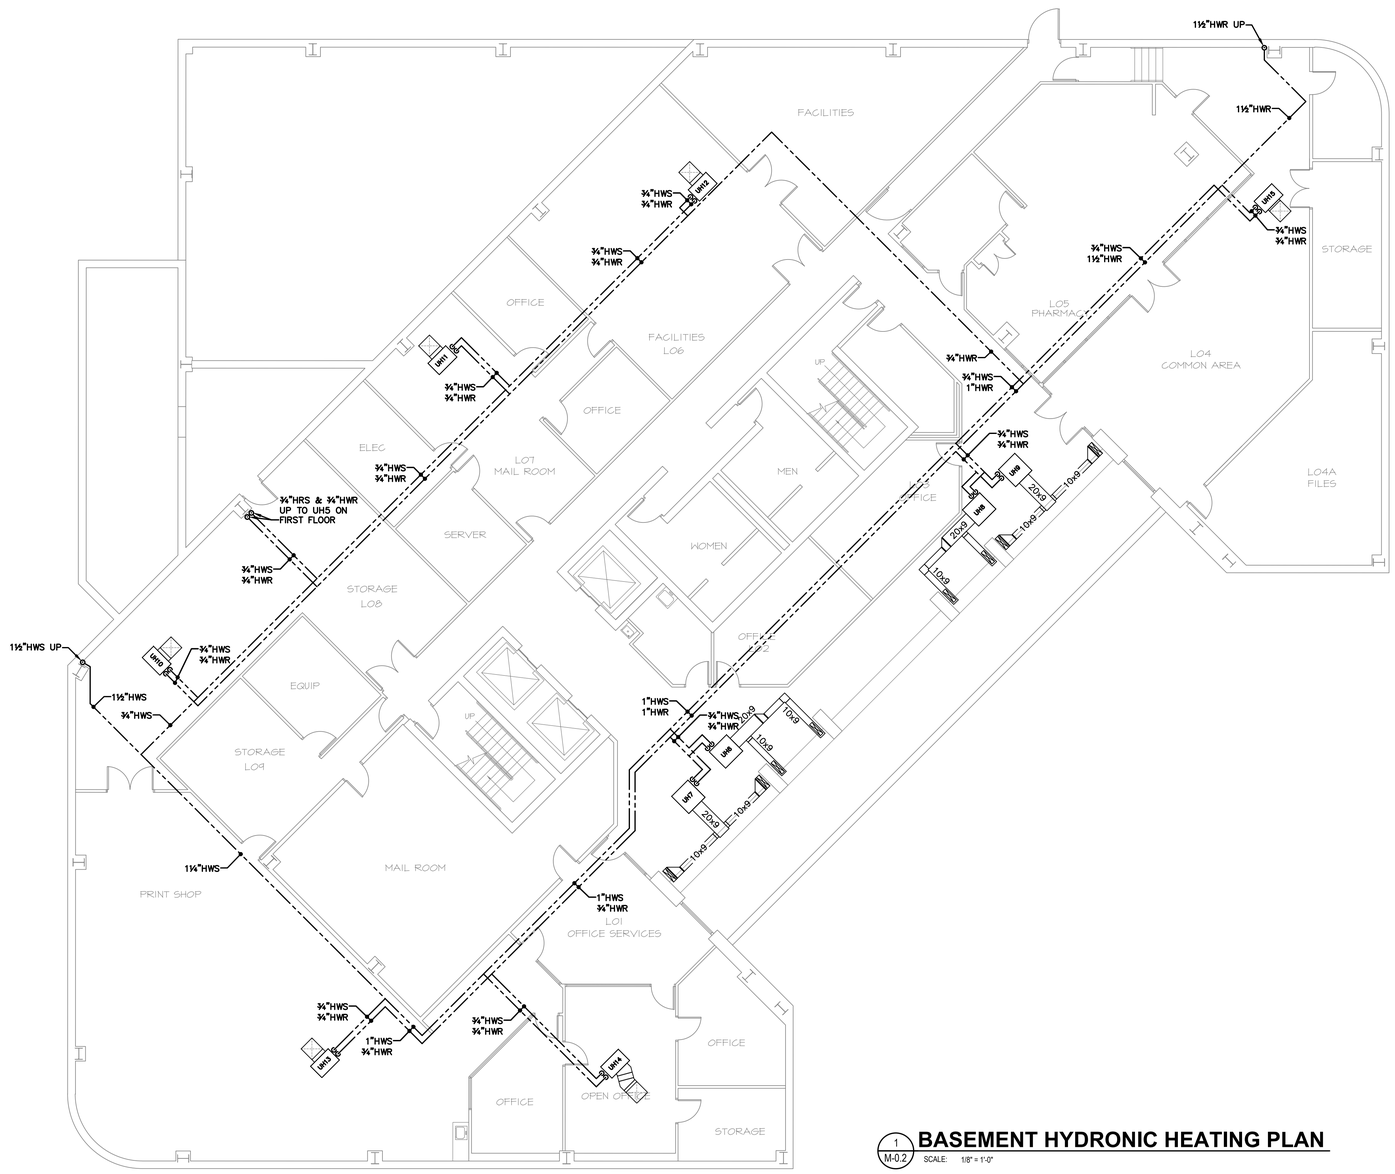

1 M-0.2 **BASEMENT HYDRONIC HEATING PLAN**

SCALE: 1/8" = 1'-0"

Chavez Tiffany & Ayers Engineering Corporation

119 West Cucharras Street
Colorado Springs, Colorado 80903
P (719)636-0021

COLORADO LICENSED DARWIN A. TIFFANY 43979 PROFESSIONAL ENGINEER

06/30/20

CITY ADMINISTRATION BUILDING

AS BUILT DRAWINGS OF EXISTING HVAC
30 SOUTH NEVADA
COLORADO SPRINGS, COLORADO

ISSUE HISTORY:

1	99% AS BUILT	03/30/20
2	FINAL AS BUILT	06/30/20

DRAWN BY	KSP
CHECKED BY	DAT
DATE	6/30/20

DRAWING TITLE
BASEMENT HYDRONIC HEATING PLAN


DRAWING NO.
M-0.2

MECHANICAL SYMBOLS

EXISTING DUCTWORK	6x10
EXTERIOR DUCTWORK	6x10
REGISTERS & DIFFUSERS	
EXISTING DENOTED AS	(E)
EQUIPMENT TAG	503
THERMOSTAT	T
SWITCH	S
DIRECTIONAL ARROW	
UNDERCUT DOOR DENOTED AS	U.C.
PIPING DROP	
PIPING RISE	
PIPING TEE	
EXISTING PIPE END	
FIRE/SMOKE DAMPER	F/SD
FIRE DAMPER	FD
RADIATION DAMPER	RD
HOT WATER SUPPLY	HWS
HOT WATER RETURN	HWR
COLD WATER SUPPLY	CWS
COLD WATER RETURN	CWR

VARIABLE AIR VOLUME TERMINAL UNIT SCHEDULE - FIRST FLOOR

MARK	EXISTING /NEW	COOLING CFM	MIN CFM	FAN CFM	INLET DIA.	FAN POWER	FAN HP	MODEL	REMARKS
101	E	475	143	-	8	-	-	KRUEGER LMHS	-
102	E	400	120	-	6	-	-	KRUEGER LMHS	-
103	E	575	179	-	8	-	-	KRUEGER LMHS	-
104	E	150	60	-	4	-	-	KRUEGER LMHS	-
105	E	475	157	-	8	-	-	KRUEGER LMHS	-
106	E	230	69	-	4	-	-	KRUEGER LMHS	BOX LABEL DATA - COOLING CFM 200 / MIN CFM 60
109	E	725	219	-	8	-	-	KRUEGER LMHS	-
110	E	225	77	-	5	-	-	KRUEGER LMHS	-
111	E	325	117	-	6	-	-	KRUEGER LMHS	-
112	E	800	240	-	8	-	-	KRUEGER LMHS	-
113	E	250	85	-	5	-	-	KRUEGER LMHS	-
114	E	375	138	-	6	-	-	KRUEGER LMHS	-
115	E	800	240	-	8	-	-	KRUEGER LMHS	-
116	E	550	223	-	8	-	-	KRUEGER LMHS	-
117	E	700	210	-	8	-	-	KRUEGER LMHS	-
118	E	575	208	-	8	-	-	KRUEGER LMHS	DIFFUSER TOTAL EQUALS 275 COOLING CFM
119	E	500	150	-	8	-	-	KRUEGER LMHS	-
120	E	800	240	-	8	-	-	KRUEGER LMHS	-
121	E	1000	300	-	10	-	-	KRUEGER LMHS	-
122	E	800	240	-	8	-	-	KRUEGER LMHS	-
123	E	440	132	-	6	-	-	KRUEGER LMHS	BOX LABEL DATA - COOLING CFM 400 / MIN CFM 130
VV-5	E	1800	800	-	10	-	-	CARRIER 35BBSS	SERVING 1ST FLOOR ASSEMBLY ROOM
VV-6	E	1800	800	-	10	-	-	CARRIER 35BBSS	SERVING 1ST FLOOR ASSEMBLY ROOM

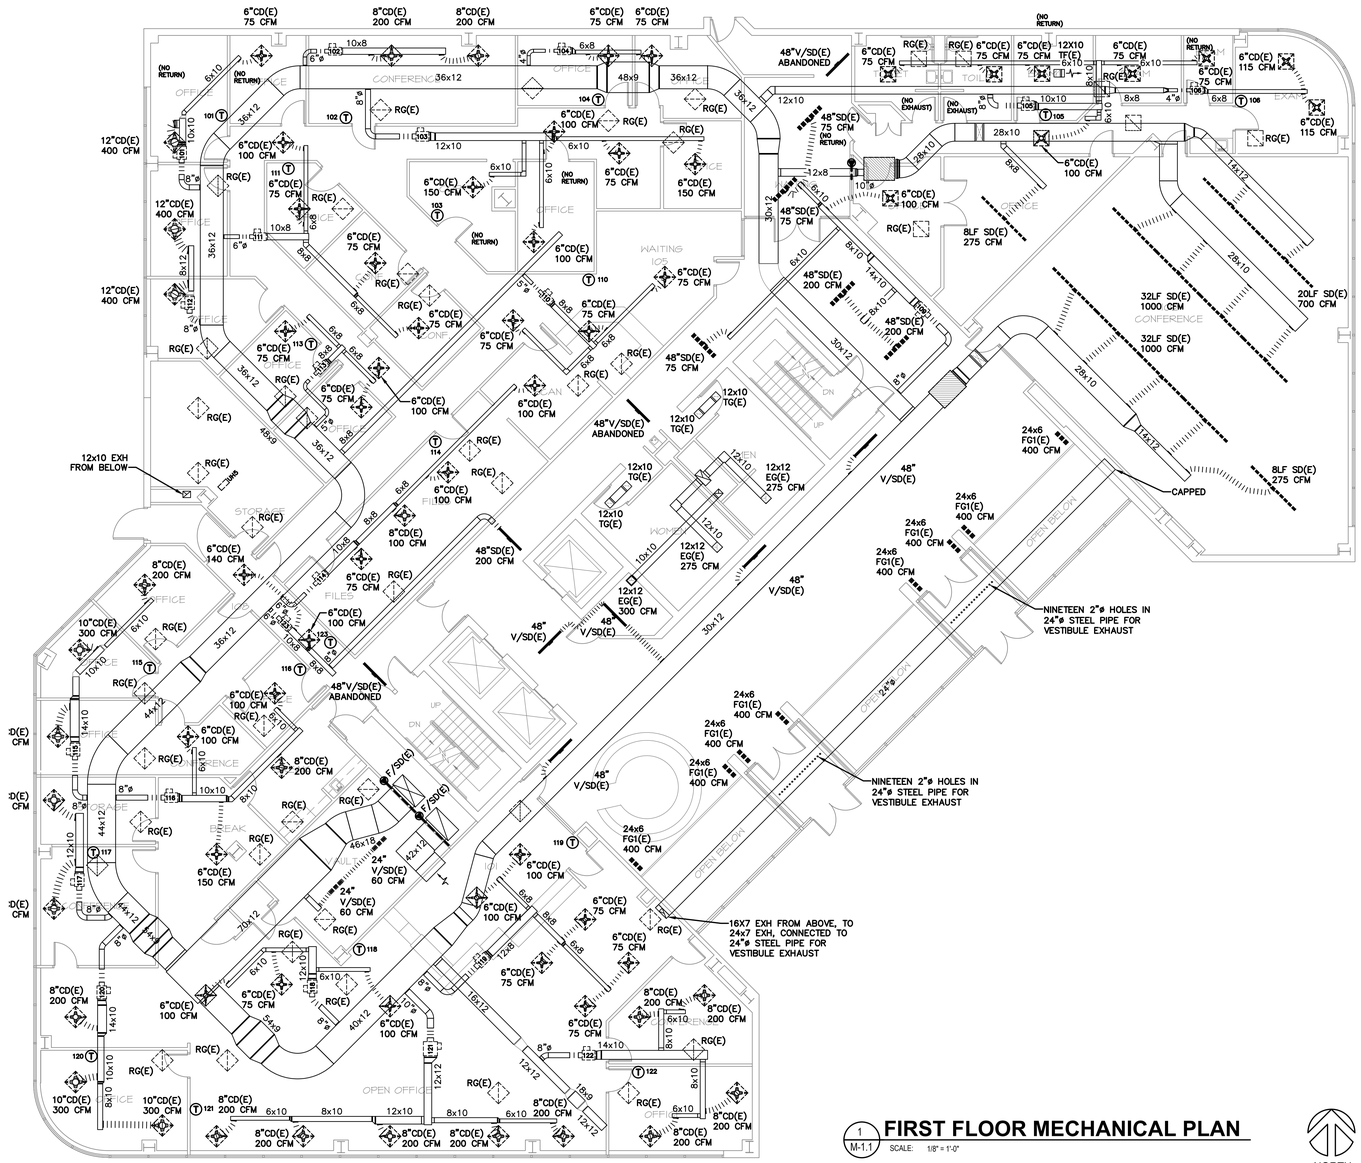

1 M-1.1 **FIRST FLOOR MECHANICAL PLAN**

SCALE: 1/8" = 1'-0"

NORTH

Chavez Tiffany & Ayers Engineering Corporation

119 West Cucharras Street
Colorado Springs, Colorado 80903
P (719)636-0021

COLORADO LICENSED DAWN A. TIFFANY 43379 PROFESSIONAL ENGINEER

06/30/20

CITY ADMINISTRATION BUILDING

AS BUILT DRAWINGS OF EXISTING HVAC
30 SOUTH NEVADA
COLORADO SPRINGS, COLORADO

ISSUE HISTORY:

1	99% AS BUILT	03/30/20
2	FINAL AS BUILT	06/30/20

DRAWN BY	KSP
CHECKED BY	DAT
DATE	6/30/20

DRAWING TITLE
FIRST FLOOR MECHANICAL PLAN

DRAWING NO.
M-1.1

MECHANICAL SYMBOLS


EXISTING DUCTWORK	6x10
EXTERIOR DUCTWORK	6x10
REGISTERS & DIFFUSERS	
EXISTING DENOTED AS	(E)
EQUIPMENT TAG	503
THERMOSTAT	T
SWITCH	S
DIRECTIONAL ARROW	
UNDERCUT DOOR DENOTED AS	U.C.
PIPING DROP	
PIPING RISE	
PIPING TEE	
EXISTING PIPE END	
FIRE/SMOKE DAMPER	F/SD
FIRE DAMPER	FD
RADIATION DAMPER	RD
HOT WATER SUPPLY	HWS
HOT WATER RETURN	HWR
COLD WATER SUPPLY	CWS
COLD WATER RETURN	CWR

UNIT HEATER SCHEDULE - FIRST FLOOR

MARK	DESCRIPTION	BTU INPUT	GPM	WATER		ELECTRICAL		MODEL	REMARKS
				EWT	LWT	HP	POWER		
UH-5	HYDRONIC UNIT HEATER	35.0 MBH	3.5	200	180	1/12	120/1P	MODINE HS-63	1ST FLOOR RECEIVING

HYDRONIC BASEBOARD HEATER SCHEDULE - FIRST FLOOR

MARK	DESCRIPTION	MFR. & MODEL	CAPACITY	REMARKS
BBH	BASEBOARD RADIATION HEATER	SLANT-FIN	700 BTU/LF	-

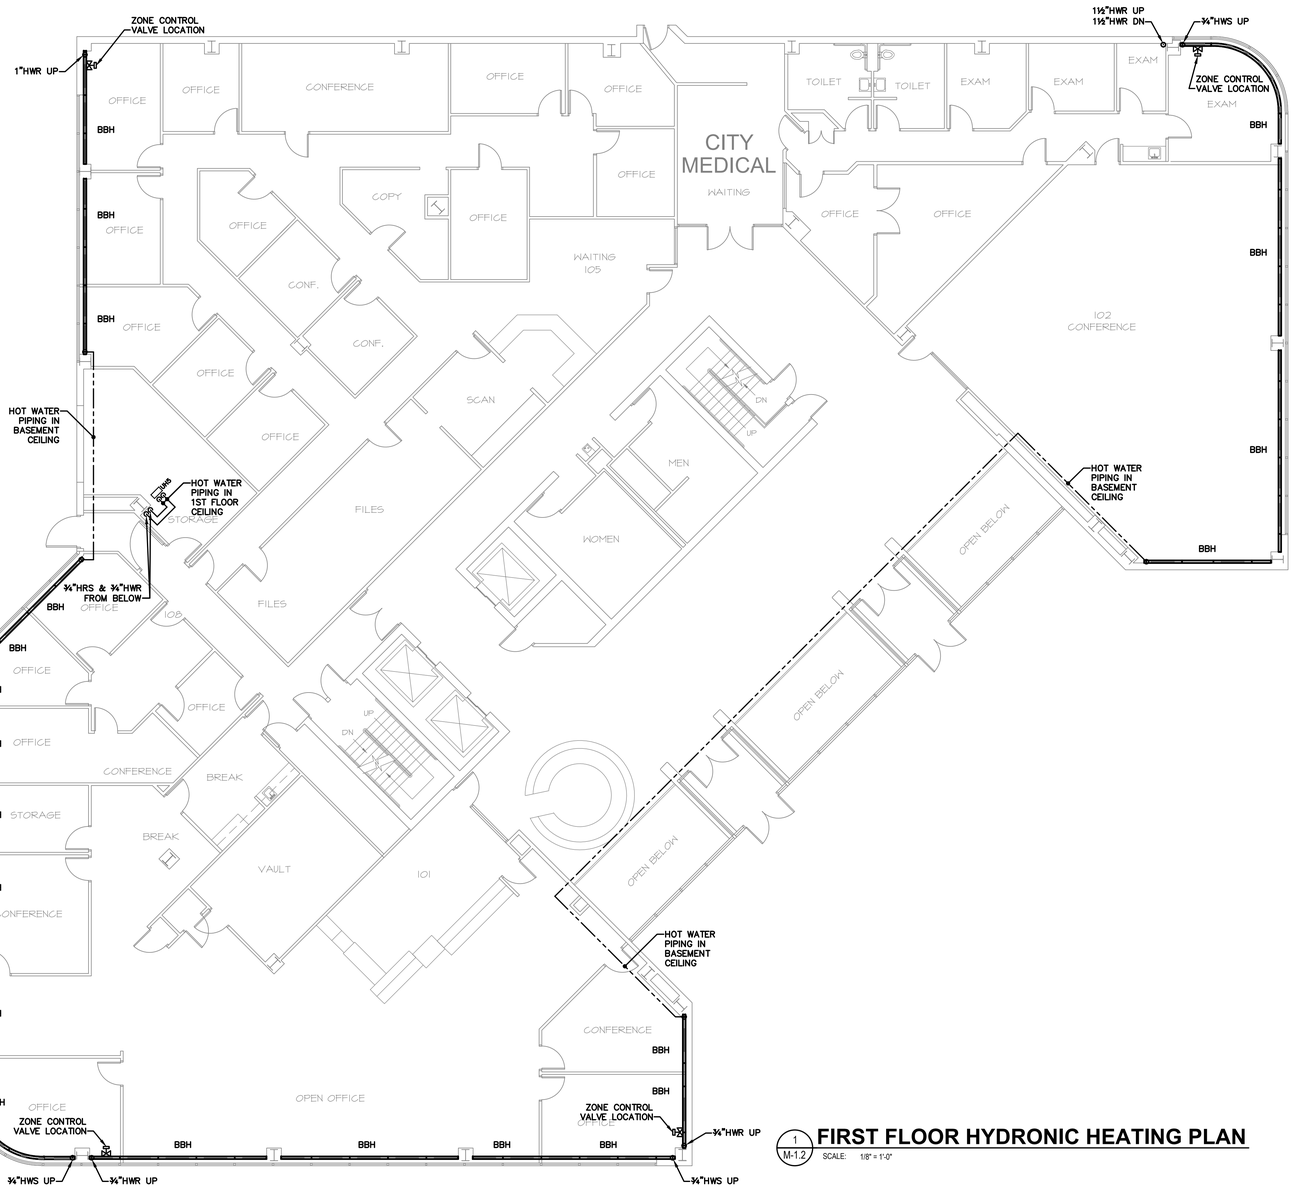

FIRST FLOOR HYDRONIC HEATING PLAN

1 M-1.2 SCALE: 1/8" = 1'-0"

Chavez Tiffany & Ayers Engineering Corporation

119 West Cucharras Street
Colorado Springs, Colorado 80903
P (719)636-0021

COLORADO LICENSED DARWIN A. TIFFANY 43979 PROFESSIONAL ENGINEER

06/30/20

CITY ADMINISTRATION BUILDING

AS BUILT DRAWINGS OF EXISTING HVAC
30 SOUTH NEVADA
COLORADO SPRINGS, COLORADO

ISSUE HISTORY:

1	99% AS BUILT	03/30/20
2	FINAL AS BUILT	06/30/20

DRAWN BY	KSP
CHECKED BY	DAT
DATE	6/30/20

DRAWING TITLE
FIRST FLOOR HYDRONIC HEATING PLAN

DRAWING NO.
M-1.2

FAN SCHEDULE - SECOND FLOOR


MARK	DESCRIPTION	PERFORMANCE				ELECTRICAL				
		CFM	TSP	RPM	BHP	HP	POWER	MODEL	WT.	REMARKS
EF-5	VESTIBULE EXHAUST	360	0.125"	1075	-	1/6	120/1P	COOK GEMINI 14-10N		LOCATED ON 2ND FLOOR
TF-6	OFFICE EXHAUST	400	0.50"	1075	-	1/3	120/1P	COOK GEMINI 16-10N		2ND FLOOR OFFICE
TF-9	CONF. ROOM EXHAUST	350	0.20"	1075	-	1/6	120/1P	COOK GEMINI 14-10N		2ND FLOOR CONFERENCE ROOM
TF-10	CONF. ROOM EXHAUST	350	0.20"	1075	-	1/6	120/1P	COOK GEMINI 14-10N		2ND FLOOR CONFERENCE ROOM

MECHANICAL SYMBOLS

EXISTING DUCTWORK	6x10
EXTERIOR DUCTWORK	6x10
REGISTERS & DIFFUSERS	
EXISTING DENOTED AS	(E)
EQUIPMENT TAG	503
THERMOSTAT	T
SWITCH	S
DIRECTIONAL ARROW	
UNDERCUT DOOR DENOTED AS	U.C.
PIPING DROP	
PIPING RISE	
PIPING TEE	
EXISTING PIPE END	
FIRE/SMOKE DAMPER	F/SD
FIRE DAMPER	FD
RADIATION DAMPER	RD
HOT WATER SUPPLY	HWS
HOT WATER RETURN	HWR
COLD WATER SUPPLY	CWS
COLD WATER RETURN	CWR

VARIABLE AIR VOLUME TERMINAL UNIT SCHEDULE - SECOND FLOOR

MARK	EXISTING /NEW	COOLING CFM	MIN CFM	FAN CFM	INLET DIA.	FAN POWER	FAN HP	MODEL	REMARKS
201	E	400	120	-	6	-	-	KRUEGER LMHS	DIFFUSER IN PLENUM, BLOCKED BY CEILING TILE
202	E	700	210	-	8	-	-	KRUEGER LMHS	-
203	E	700	210	-	8	-	-	KRUEGER LMHS	-
204	E	400	120	-	6	-	-	KRUEGER LMHS	-
205	E	700	210	-	8	-	-	KRUEGER LMHS	BOX LABEL DATA - COOLING CFM 600 / MIN CFM 180
206	E	650	195	-	8	-	-	KRUEGER LMHS	BOX LABEL DATA - COOLING CFM 600 / MIN CFM 180
207	E	920	276	-	8	-	-	KRUEGER LMHS	BOX LABEL DATA - COOLING CFM 800 / MIN CFM 240
208	E	1200	424	-	10	-	-	KRUEGER LMHS	-
209	E	800	240	-	8	-	-	KRUEGER LMHS	-
210	E	300	90	-	5	-	-	KRUEGER LMHS	-
211	E	700	230	-	8	-	-	KRUEGER LMHS	-
212	E	1000	300	-	10	-	-	KRUEGER LMHS	-
213	E	800	240	-	8	-	-	KRUEGER LMHS	-
214	E	600	180	-	8	-	-	KRUEGER LMHS	MISSING DIFFUSER, FLEX DUCT BLOWING INTO PLENUM
215	E	400	124	-	6	-	-	KRUEGER LMHS	-
216	E	925	278	-	8	-	-	KRUEGER LMHS	BOX LABEL DATA - COOLING CFM 600 / MIN CFM 180
217	E	775	233	-	8	-	-	KRUEGER LMHS	-
218	E	800	240	-	8	-	-	KRUEGER LMHS	BOX LABEL DATA - COOLING CFM 700 / MIN CFM 210
219	E	700	302	-	8	-	-	KRUEGER LMHS	-
220	E	1300	390	-	10	-	-	KRUEGER LMHS	BOX LABEL DATA - COOLING CFM 1100 / MIN CFM 330
221	E	360	108	-	5	-	-	KRUEGER LMHS	BOX LABEL DATA - COOLING CFM 300 / MIN CFM 90
222	E	520	156	-	6	-	-	KRUEGER LMHS	BOX LABEL DATA - COOLING CFM 500 / MIN CFM 150
VV-1	E	2200	1000	-	20x12	-	-	CARRIER 35BB65	SERVING MAIN ENTRY / ATRIUM
VV-2	E	2200	1000	-	20x12	-	-	CARRIER 35BB65	SERVING MAIN ENTRY / ATRIUM
ZD1	E	200	-	-	6	-	-	DURADRIVE NAS40	SERVING 2ND FLOOR CORRIDOR
ZD2	E	100	-	-	6	-	-	DURADRIVE NAS40	SERVING 2ND FLOOR CORRIDOR
ZD3	E	100	-	-	6	-	-	DURADRIVE NAS40	SERVING 2ND FLOOR CORRIDOR
ZD4	E	100	-	-	6	-	-	DURADRIVE NAS40	SERVING 2ND FLOOR CORRIDOR

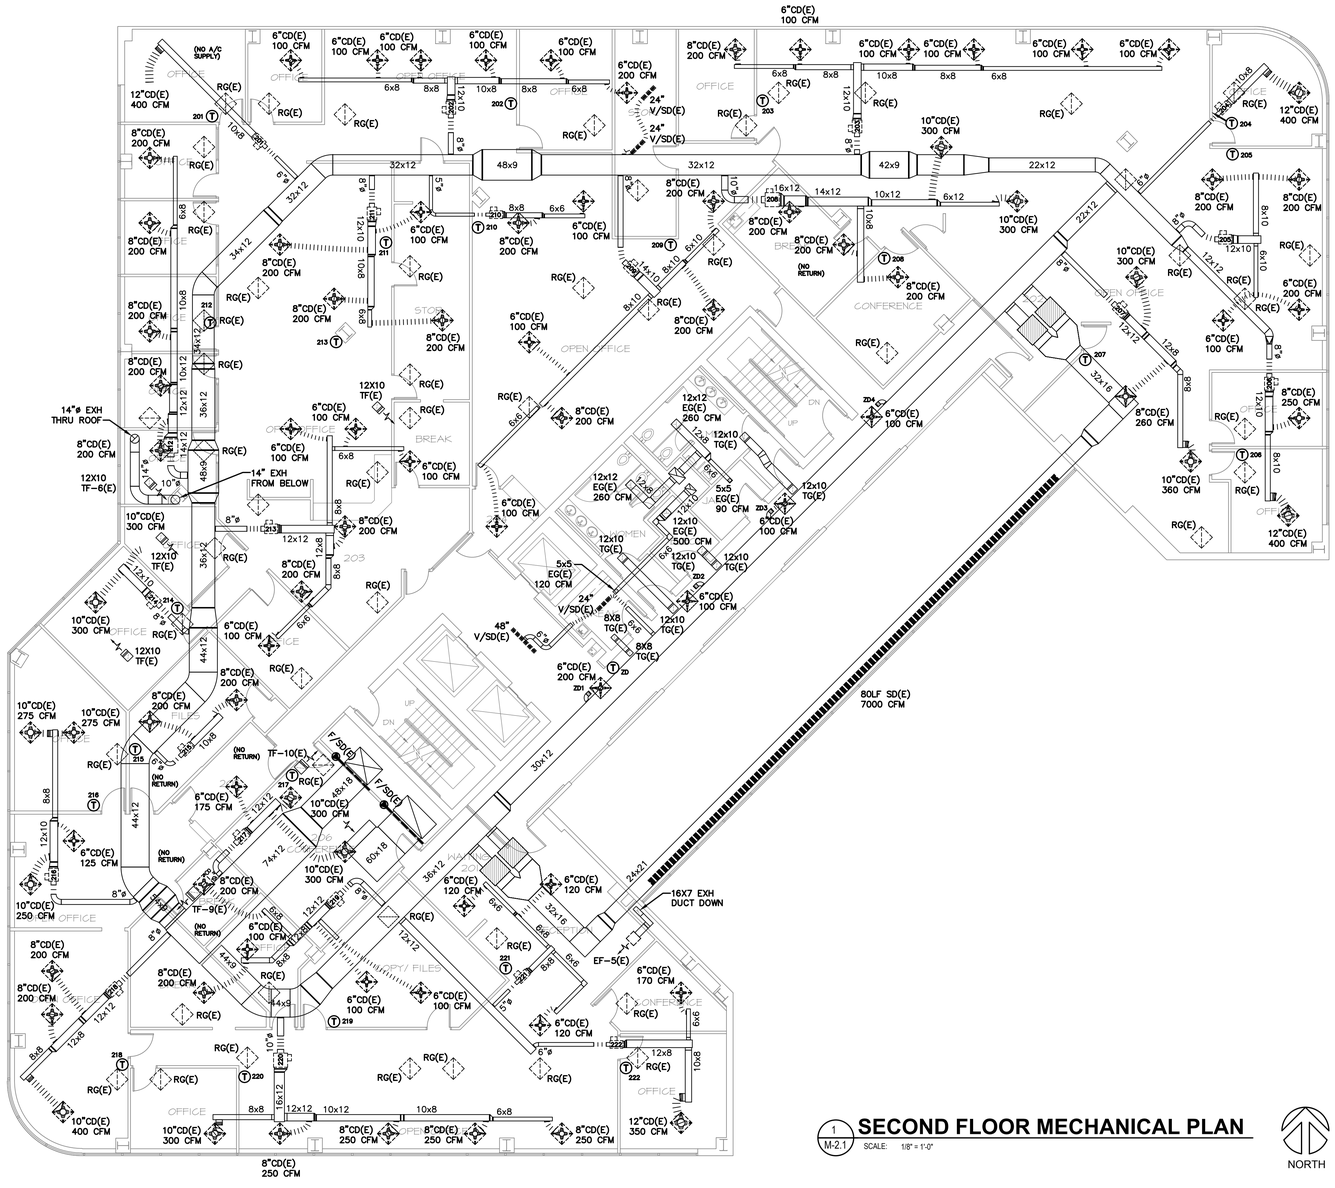

SECOND FLOOR MECHANICAL PLAN

1 / M-2.1 SCALE: 1/8" = 1'-0"

NORTH

Chavez Tiffany & Ayers Engineering Corporation

119 West Cucharras Street
Colorado Springs, Colorado 80903
P (719)636-0021

COLORADO LICENSED TIMOTHY A. TIFFANY 43379 PROFESSIONAL ENGINEER

06/30/20

CITY ADMINISTRATION BUILDING

AS BUILT DRAWINGS OF EXISTING HVAC
30 SOUTH NEVADA
COLORADO SPRINGS, COLORADO

ISSUE HISTORY:

1	99% AS BUILT	03/30/20
2	FINAL AS BUILT	06/30/20

DRAWN BY	KSP
CHECKED BY	DAT
DATE	6/30/20

DRAWING TITLE
SECOND FLOOR MECHANICAL PLAN


DRAWING NO.
M-2.1

MECHANICAL SYMBOLS

EXISTING DUCTWORK	6x10
EXTERIOR DUCTWORK	6x10
REGISTERS & DIFFUSERS	
EXISTING DENOTED AS	(E)
EQUIPMENT TAG	503
THERMOSTAT	T
SWITCH	S
DIRECTIONAL ARROW	
UNDERCUT DOOR DENOTED AS	U.C.
PIPING DROP	
PIPING RISE	
PIPING TEE	
EXISTING PIPE END	
FIRE/SMOKE DAMPER	F/SD
FIRE DAMPER	FD
RADIATION DAMPER	RD
HOT WATER SUPPLY	HWS
HOT WATER RETURN	HWR
COLD WATER SUPPLY	CWS
COLD WATER RETURN	CWR

HYDRONIC BASEBOARD HEATER SCHEDULE - SECOND FLOOR

MARK	DESCRIPTION	MFR. & MODEL	CAPACITY	REMARKS
BBH	BASEBOARD RADIATION HEATER	SLANT-FIN	700 BTU/LF	-

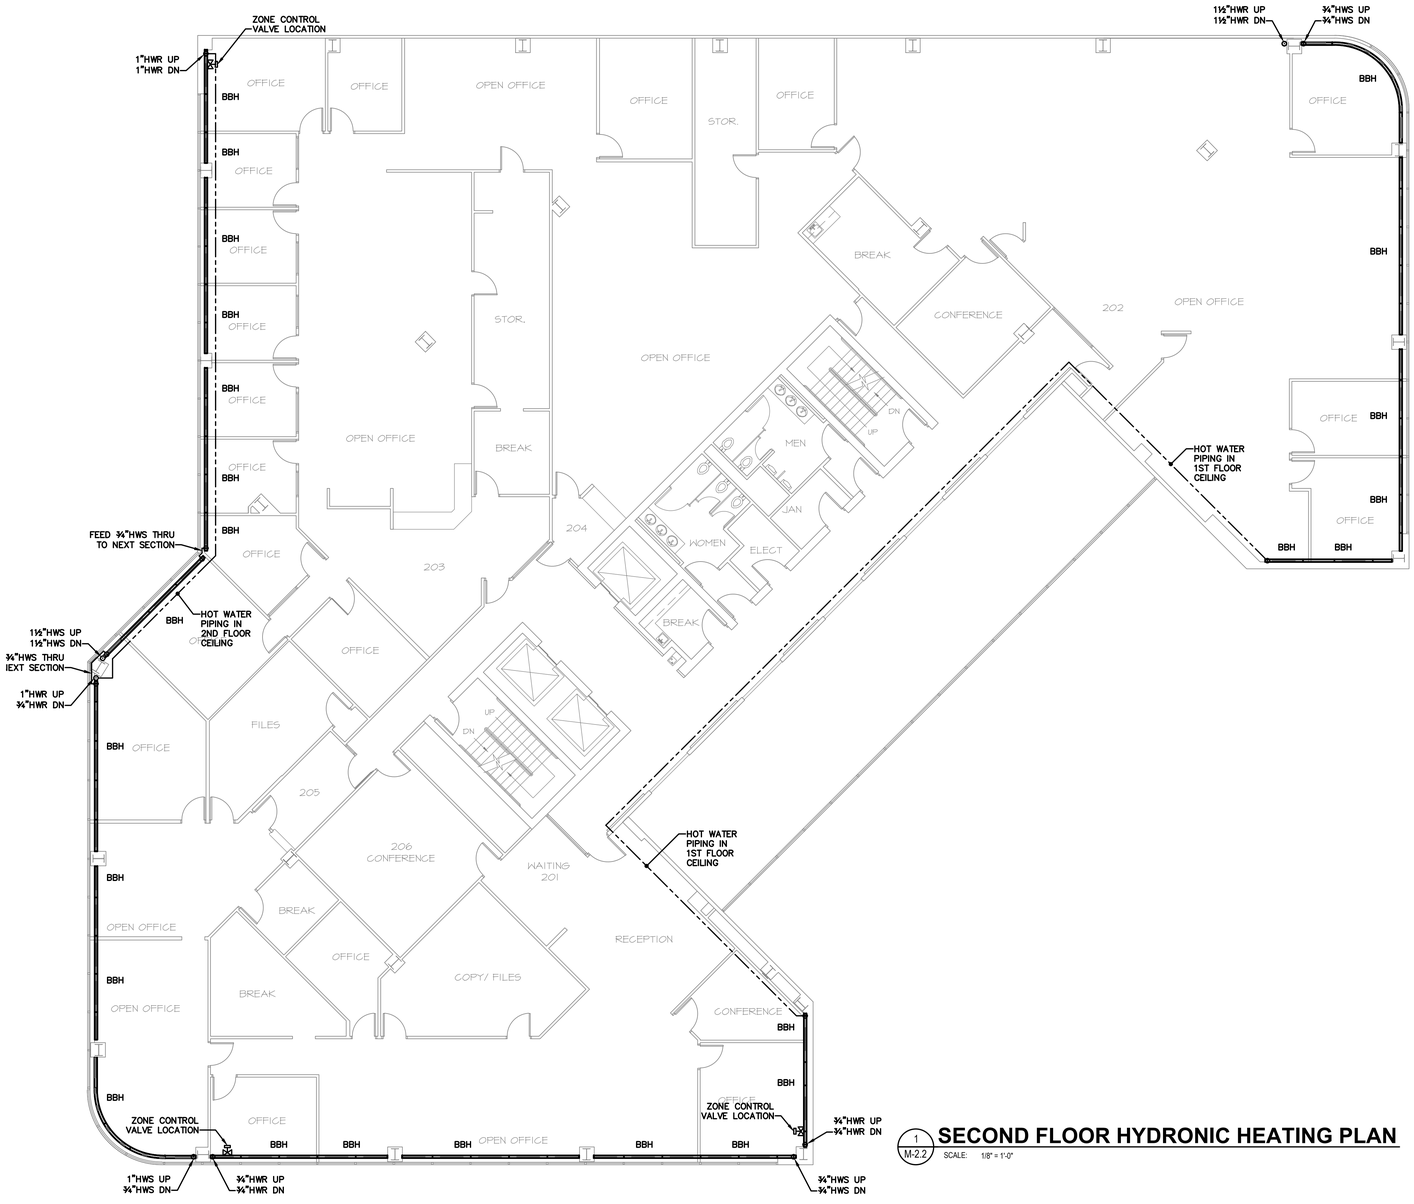

1 M-2.2 **SECOND FLOOR HYDRONIC HEATING PLAN**

SCALE: 1/8" = 1'-0"

Chavez Tiffany & Ayers Engineering Corporation

119 West Cucharras Street
Colorado Springs, Colorado 80903
P (719)636-0021

COLORADO LICENSED DARWIN A. TIFFANY 43379 PROFESSIONAL ENGINEER

06/30/20

CITY ADMINISTRATION BUILDING

AS BUILT DRAWINGS OF EXISTING HVAC
30 SOUTH NEVADA
COLORADO SPRINGS, COLORADO

ISSUE HISTORY:

1	99% AS BUILT	03/30/20
2	FINAL AS BUILT	06/30/20

DRAWN BY	KSP
CHECKED BY	DAT
DATE	6/30/20

DRAWING TITLE
SECOND FLOOR HYDRONIC HEATING PLAN

DRAWING NO.
M-2.2

FAN SCHEDULE - THIRD FLOOR


MARK	DESCRIPTION	PERFORMANCE				ELECTRICAL		MODEL	WT.	REMARKS
		CFM	TSP	RPM	BHP	HP	POWER			
TF-16	CONF. ROOM TRANSFER	200	0.125"	-	-	1/40	120/1P	GREENHECK SP-25	-	3RD FLOOR CONFERENCE ROOM
TF-17	CONF. ROOM TRANSFER	200	0.125"	-	-	1/40	120/1P	GREENHECK SP-25	-	3RD FLOOR CONFERENCE ROOM

MECHANICAL SYMBOLS

EXISTING DUCTWORK	6x10
EXTERIOR DUCTWORK	6x10
REGISTERS & DIFFUSERS	
EXISTING DENOTED AS	(E)
EQUIPMENT TAG	503
THERMOSTAT	T
SWITCH	S
DIRECTIONAL ARROW	
UNDERCUT DOOR DENOTED AS	U.C.
PIPING DROP	
PIPING RISE	
PIPING TEE	
EXISTING PIPE END	
FIRE/SMOKE DAMPER	F/SD
FIRE DAMPER	FD
RADIATION DAMPER	RD
HOT WATER SUPPLY	HWS
HOT WATER RETURN	HWR
COLD WATER SUPPLY	CWS
COLD WATER RETURN	CWR

VARIABLE AIR VOLUME TERMINAL UNIT SCHEDULE - THIRD FLOOR

MARK	EXISTING /NEW	COOLING CFM	MIN CFM	FAN CFM	INLET DIA.	FAN POWER	FAN HP	MODEL	REMARKS
301	E	475	143	-	8	-	-	KRUEGER LMHS	-
302	E	500	150	-	8	-	-	KRUEGER LMHS	-
303	E	200	72	-	4	-	-	KRUEGER LMHS	-
304	E	350	105	-	5	-	-	KRUEGER LMHS	BOX LABEL DATA - COOLING CFM 300 / MIN CFM 90
305	E	650	190	-	8	-	-	KRUEGER LMHS	BOX LABEL DATA - COOLING CFM 600 / MIN CFM 180
306	E	600	180	-	8	-	-	KRUEGER LMHS	BOX LABEL DATA - COOLING CFM 500 / MIN CFM 150
307	E	450	135	-	6	-	-	KRUEGER LMHS	-
308	E	600	180	-	8	-	-	KRUEGER LMHS	-
309	E	850	236	-	8	-	-	KRUEGER LMHS	BOX LABEL DATA - COOLING CFM 725 / MIN CFM 236
310	E	900	270	-	10	-	-	KRUEGER LMHS	-
311	E	905	285	-	10	-	-	KRUEGER LMHS	BOX LABEL DATA - COOLING CFM 950 / MIN CFM 285
312	E	400	138	-	6	-	-	KRUEGER LMHS	-
313	E	700	231	-	8	-	-	KRUEGER LMHS	-
314	E	925	278	-	8	-	-	KRUEGER LMHS	BOX LABEL DATA - COOLING CFM 800 / MIN CFM 240
315	E	400	120	-	6	-	-	KRUEGER LMHS	-
316	E	1050	360	-	10	-	-	KRUEGER LMHS	BOX LABEL DATA - COOLING CFM 1200 / MIN CFM 360
317	E	425	153	-	6	-	-	KRUEGER LMHS	-
318	E	520	120	-	6	-	-	KRUEGER LMHS	BOX LABEL DATA - COOLING CFM 425 / MIN CFM 153
319	E	300	90	-	5	-	-	KRUEGER LMHS	-
320	E	520	200	-	6	-	-	KRUEGER LMHS	BOX LABEL DATA - COOLING CFM 500 / MIN CFM 193
321	E	1425	413	-	10	-	-	KRUEGER LMHS	BOX LABEL DATA - COOLING CFM 1050 / MIN CFM 315
322	E	350	112	-	6	-	-	KRUEGER LMHS	-

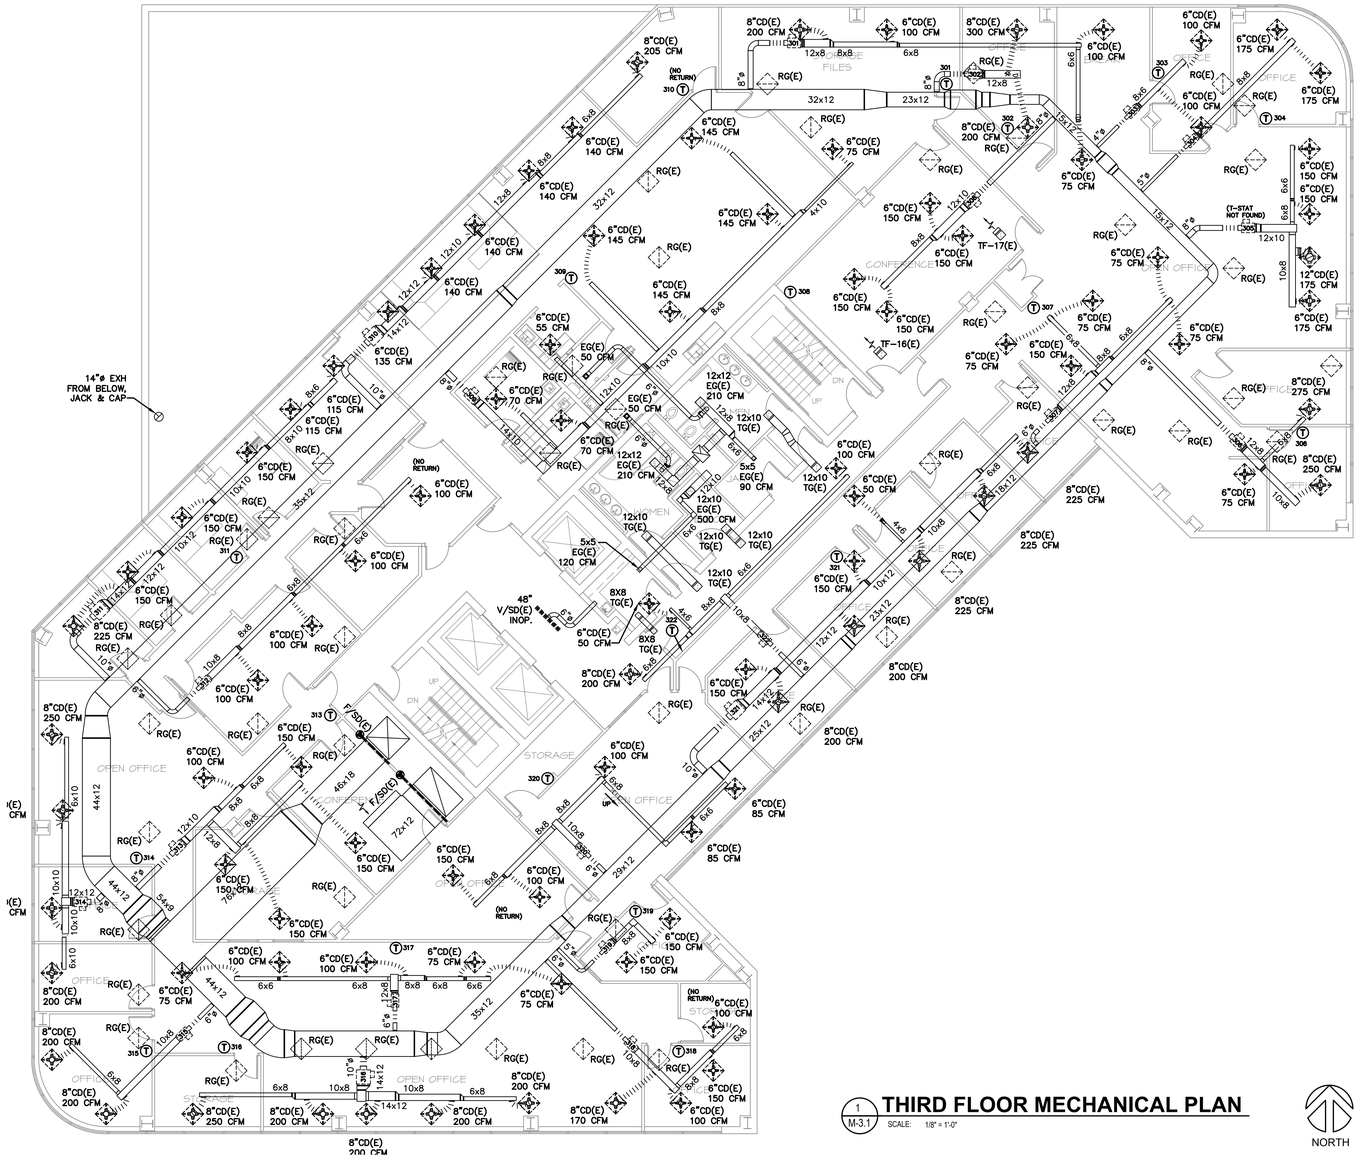

1 M-3.1 **THIRD FLOOR MECHANICAL PLAN**

SCALE: 1/8" = 1'-0"

NORTH

Chavez Tiffany & Ayers Engineering Corporation

119 West Cucharras Street
Colorado Springs, Colorado 80903
P (719)636-0021

COLORADO LICENSED DARWIN A. TIFFANY 43979 PROFESSIONAL ENGINEER

06/30/20

CITY ADMINISTRATION BUILDING
AS BUILT DRAWINGS OF EXISTING HVAC
30 SOUTH NEVADA
COLORADO SPRINGS, COLORADO

ISSUE HISTORY:

1	99% AS BUILT	03/30/20
2	FINAL AS BUILT	06/30/20

DRAWN BY	KSP
CHECKED BY	DAT
DATE	6/30/20

DRAWING TITLE
THIRD FLOOR MECHANICAL PLAN

DRAWING NO.
M-3.1

MECHANICAL SYMBOLS

EXISTING DUCTWORK	6x10
EXTERIOR DUCTWORK	6x10
REGISTERS & DIFFUSERS	
EXISTING DENOTED AS	(E)
EQUIPMENT TAG	503
THERMOSTAT	T
SWITCH	S
DIRECTIONAL ARROW	
UNDERCUT DOOR DENOTED AS	U.C.
PIPING DROP	
PIPING RISE	
PIPING TEE	
EXISTING PIPE END	
FIRE/SMOKE DAMPER	F/SD
FIRE DAMPER	FD
RADIATION DAMPER	RD
HOT WATER SUPPLY	HWS
HOT WATER RETURN	HWR
COLD WATER SUPPLY	CWS
COLD WATER RETURN	CWR

HYDRONIC BASEBOARD HEATER SCHEDULE - THIRD FLOOR

MARK	DESCRIPTION	MFR. & MODEL	CAPACITY	REMARKS
BBH	BASEBOARD RADIATION HEATER	SLANT-FIN	700 BTU/LF	-



1 M-3.2 **THIRD FLOOR HYDRONIC HEATING PLAN**

SCALE: 1/8" = 1'-0"

Chavez Tiffany & Ayers Engineering Corporation

119 West Cucharras Street
Colorado Springs, Colorado 80903
P (719)636-0021

COLORADO LICENSED DARWIN A. TIFFANY 43279 PROFESSIONAL ENGINEER

06/30/20

CITY ADMINISTRATION BUILDING

AS BUILT DRAWINGS OF EXISTING HVAC
30 SOUTH NEVADA
COLORADO SPRINGS, COLORADO

ISSUE HISTORY:

1	99% AS BUILT	03/30/20
2	FINAL AS BUILT	06/30/20

DRAWN BY	KSP
CHECKED BY	DAT
DATE	6/30/20

DRAWING TITLE
THIRD FLOOR HYDRONIC HEATING PLAN

DRAWING NO.
M-3.2

FAN SCHEDULE - FOURTH FLOOR


MARK	DESCRIPTION	PERFORMANCE				ELECTRICAL		MODEL	WT.	REMARKS
		CFM	TSP	RPM	BHP	HP	POWER			
TF-18	CONF. ROOM TRANSFER	200	0.125"	-	-	1/40	120/1P	GREENHECK SP-25	-	4TH FLOOR CONFERENCE ROOM
TF-19	CONF. ROOM TRANSFER	200	0.125"	-	-	1/40	120/1P	GREENHECK SP-25	-	4TH FLOOR CONFERENCE ROOM

MECHANICAL SYMBOLS

EXISTING DUCTWORK	6x10
EXTERIOR DUCTWORK	6x10
REGISTERS & DIFFUSERS	
EXISTING DENOTED AS	(E)
EQUIPMENT TAG	503
THERMOSTAT	T
SWITCH	S
DIRECTIONAL ARROW	
UNDERCUT DOOR DENOTED AS	U.C.
PIPING DROP	
PIPING RISE	
PIPING TEE	
EXISTING PIPE END	
FIRE/SMOKE DAMPER	F/SD
FIRE DAMPER	FD
RADIATION DAMPER	RD
HOT WATER SUPPLY	HWS
HOT WATER RETURN	HWR
COLD WATER SUPPLY	CWS
COLD WATER RETURN	CWR

VARIABLE AIR VOLUME TERMINAL UNIT SCHEDULE - FOURTH FLOOR

MARK	EXISTING /NEW	COOLING CFM	MIN CFM	FAN CFM	INLET DIA.	FAN POWER	FAN HP	MODEL	REMARKS
401	E	300	90	-	5	-	-	KRUEGER LMHS	-
402	E	900	270	-	10	-	-	KRUEGER LMHS	-
403	E	600	115	-	8	-	-	KRUEGER LMHS	BOX LABEL DATA - COOLING CFM 600 / MIN CFM 180
404	E	675	270	-	8	-	-	KRUEGER LMHS	BOX LABEL DATA - COOLING CFM 800 / MIN CFM 240
405	E	725	150	-	8	-	-	KRUEGER LMHS	BOX LABEL DATA - COOLING CFM 500 / MIN CFM 150
406	E	800	240	-	8	-	-	KRUEGER LMHS	-
407	E	800	262	-	8	-	-	KRUEGER LMHS	-
408	E	800	240	-	8	-	-	KRUEGER LMHS	-
409	E	700	210	-	8	-	-	KRUEGER LMHS	-
410	E	300	90	-	5	-	-	KRUEGER LMHS	-
411	E	700	210	-	8	-	-	KRUEGER LMHS	-
412	E	850	255	-	10	-	-	KRUEGER LMHS	-
413	E	925	278	-	8	-	-	KRUEGER LMHS	BOX LABEL DATA - COOLING CFM 800 / MIN CFM 240
414	E	600	180	-	8	-	-	KRUEGER LMHS	-
415	E	600	180	-	8	-	-	KRUEGER LMHS	-
416	E	1200	420	-	10	-	-	KRUEGER LMHS	BOX LABEL DATA - COOLING CFM 1000 / MIN CFM 300
417	E	700	210	-	8	-	-	KRUEGER LMHS	-
418	E	520	156	-	6	-	-	KRUEGER LMHS	BOX LABEL DATA - COOLING CFM 400 / MIN CFM 120
419	E	520	156	-	6	-	-	KRUEGER LMHS	BOX LABEL DATA - COOLING CFM 350 / MIN CFM 105
420	E	925	278	-	8	-	-	KRUEGER LMHS	BOX LABEL DATA - COOLING CFM 800 / MIN CFM 240
421	E	800	240	-	8	-	-	KRUEGER LMHS	-
422	E	1275	383	-	10	-	-	KRUEGER LMHS	-
423	E	350	105	-	6	-	-	KRUEGER LMHS	-

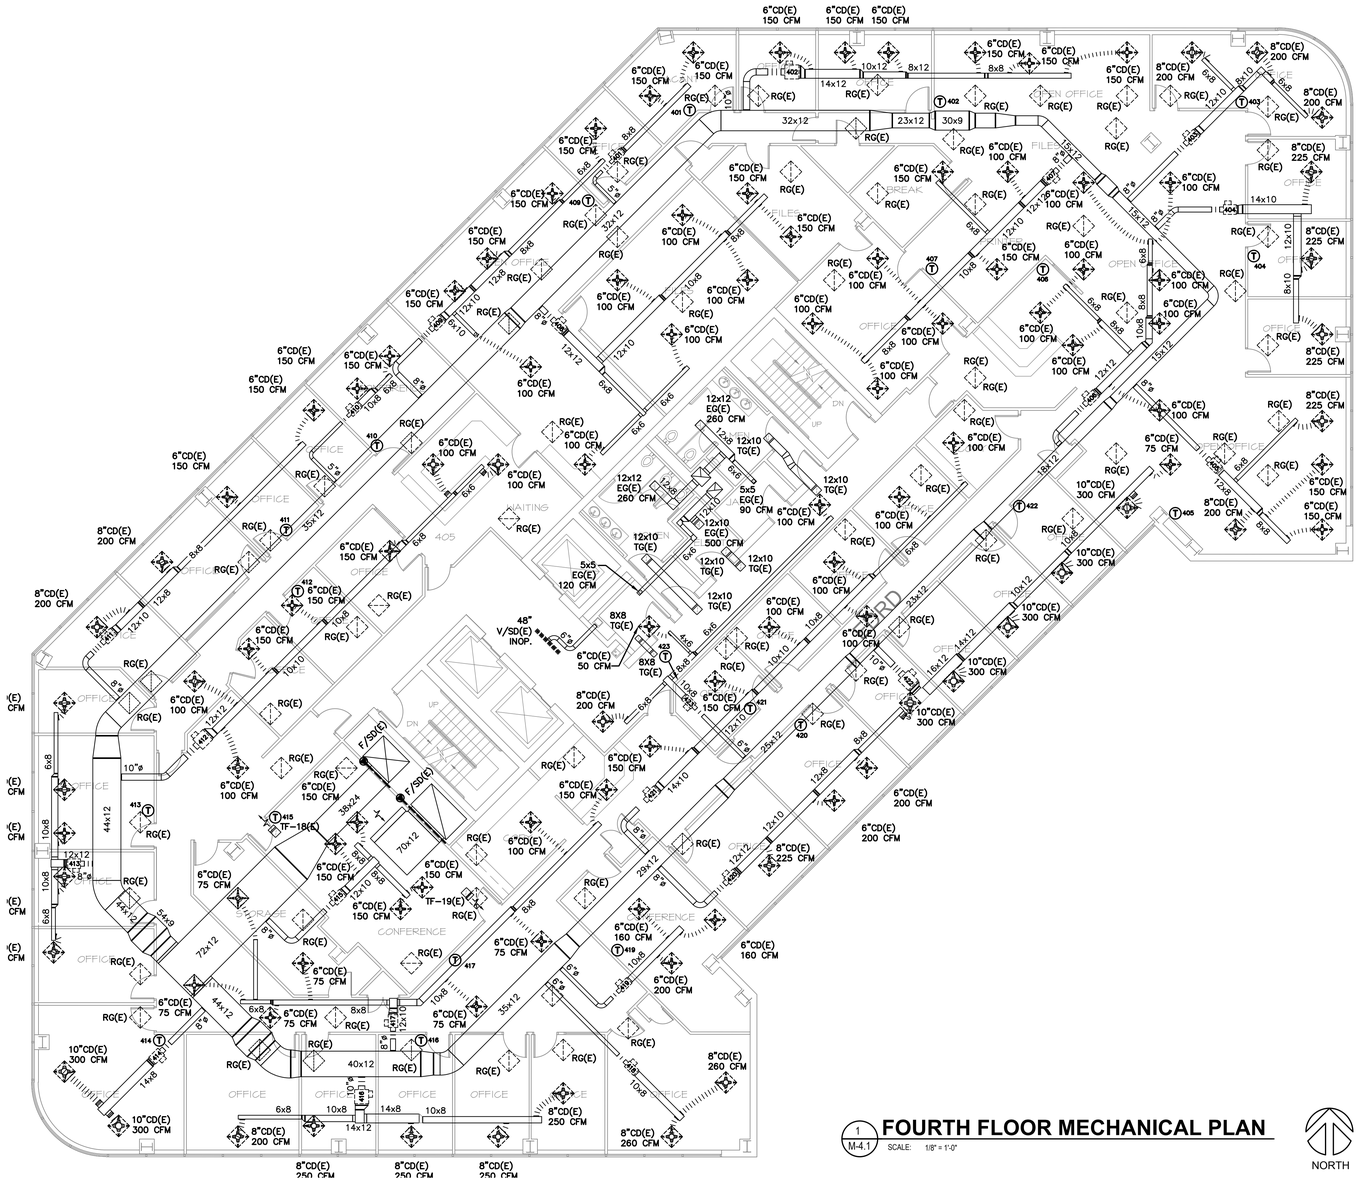

FOURTH FLOOR MECHANICAL PLAN

1 / M-4.1 SCALE: 1/8" = 1'-0"

NORTH

Chavez Tiffany & Ayers Engineering Corporation

119 West Cucharras Street
Colorado Springs, Colorado 80903
P (719)636-0021

COLORADO LICENSED DARWIN A. TIFFANY 43979 PROFESSIONAL ENGINEER

06/30/20

CITY ADMINISTRATION BUILDING

AS BUILT DRAWINGS OF EXISTING HVAC
30 SOUTH NEVADA
COLORADO SPRINGS, COLORADO

ISSUE HISTORY:

1	99% AS BUILT	03/30/20
2	FINAL AS BUILT	06/30/20

DRAWN BY	KSP
CHECKED BY	DAT
DATE	6/30/20

DRAWING TITLE
FOURTH FLOOR MECHANICAL PLAN


DRAWING NO.
M-4.1

MECHANICAL SYMBOLS

EXISTING DUCTWORK	6x10
EXTERIOR DUCTWORK	6x10
REGISTERS & DIFFUSERS	
EXISTING DENOTED AS	(E)
EQUIPMENT TAG	503
THERMOSTAT	T
SWITCH	S
DIRECTIONAL ARROW	
UNDERCUT DOOR DENOTED AS	U.C.
PIPING DROP	
PIPING RISE	
PIPING TEE	
EXISTING PIPE END	
FIRE/SMOKE DAMPER	F/SD
FIRE DAMPER	FD
RADIATION DAMPER	RD
HOT WATER SUPPLY	HWS
HOT WATER RETURN	HWR
COLD WATER SUPPLY	CWS
COLD WATER RETURN	CWR

HYDRONIC BASEBOARD HEATER SCHEDULE - FOURTH FLOOR

MARK	DESCRIPTION	MFR. & MODEL	CAPACITY	REMARKS
BBH	BASEBOARD RADIATION HEATER	SLANT-FIN	700 BTU/LF	-

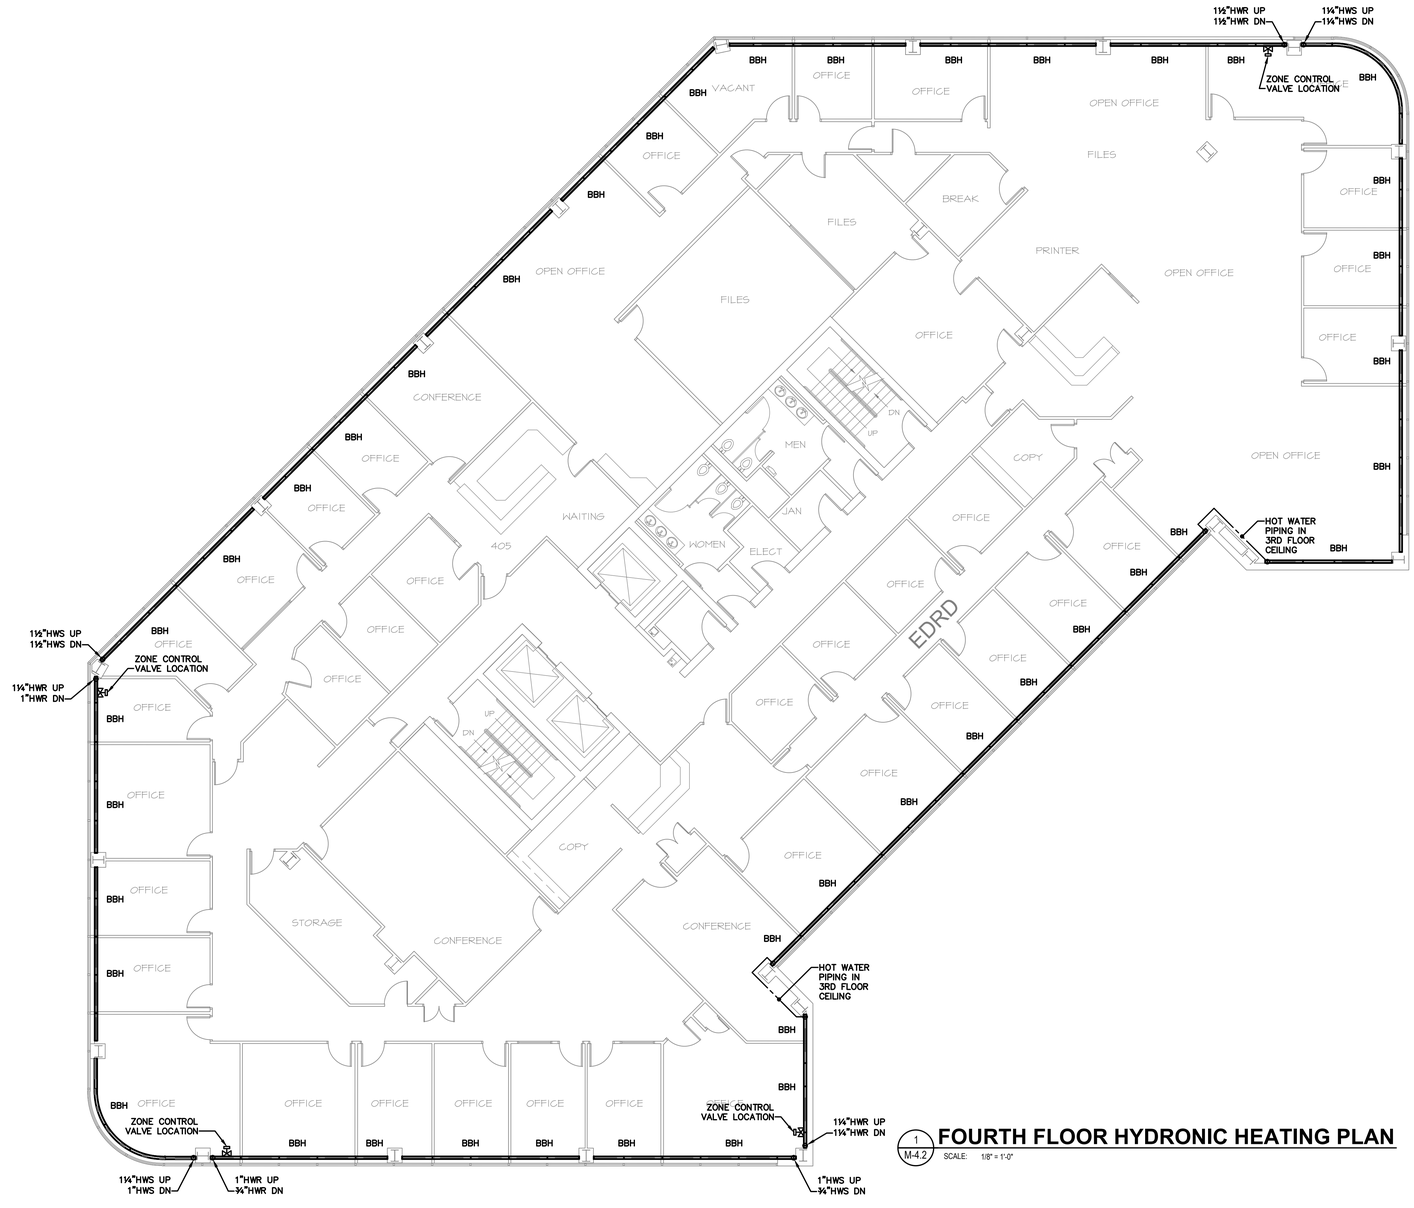

1 M-4.2 **FOURTH FLOOR HYDRONIC HEATING PLAN**

SCALE: 1/8" = 1'-0"

Chavez Tiffany & Ayers Engineering Corporation

119 West Cucharras Street
Colorado Springs, Colorado 80903
P (719)636-0021

COLORADO LICENSED DARWIN A. TIFFANY 43379 PROFESSIONAL ENGINEER

06/30/20

CITY ADMINISTRATION BUILDING
AS BUILT DRAWINGS OF EXISTING HVAC
30 SOUTH NEVADA
COLORADO SPRINGS, COLORADO

ISSUE HISTORY:

1	99% AS BUILT	03/30/20
2	FINAL AS BUILT	06/30/20

DRAWN BY	KSP
CHECKED BY	DAT
DATE	6/30/20

DRAWING TITLE
FOURTH FLOOR HYDRONIC HEATING PLAN

DRAWING NO.
M-4.2

FAN SCHEDULE - FIFTH FLOOR


MARK	DESCRIPTION	PERFORMANCE				ELECTRICAL		MODEL	WT.	REMARKS
		CFM	TSP	RPM	BHP	HP	POWER			
TF-20	CONF. ROOM TRANSFER	200	0.125"	-	-	1/40	120/1P	GREENHECK SP-25	-	5TH FLOOR CONFERENCE ROOM
TF-21	CONF. ROOM TRANSFER	200	0.125"	-	-	1/40	120/1P	GREENHECK SP-25	-	5TH FLOOR CONFERENCE ROOM

MECHANICAL SYMBOLS

EXISTING DUCTWORK	6x10
EXTERIOR DUCTWORK	6x10
REGISTERS & DIFFUSERS	
EXISTING DENOTED AS	(E)
EQUIPMENT TAG	503
THERMOSTAT	T
SWITCH	S
DIRECTIONAL ARROW	
UNDERCUT DOOR DENOTED AS	U.C.
PIPING DROP	
PIPING RISE	
PIPING TEE	
EXISTING PIPE END	
FIRE/SMOKE DAMPER	F/SD
FIRE DAMPER	FD
RADIATION DAMPER	RD
HOT WATER SUPPLY	HWS
HOT WATER RETURN	HWR
COLD WATER SUPPLY	CWS
COLD WATER RETURN	CWR

VARIABLE AIR VOLUME TERMINAL UNIT SCHEDULE - FIFTH FLOOR

MARK	EXISTING /NEW	COOLING CFM	MIN CFM	FAN CFM	INLET DIA.	FAN POWER	FAN HP	MODEL	REMARKS
501	E	1000	300	-	10	-	-	KRUEGER LMHS	-
502	E	650	195	-	8	-	-	KRUEGER LMHS	-
503	E	600	180	-	8	-	-	KRUEGER LMHS	BOX LABEL DATA - COOLING CFM 800 / MIN CFM 240
504	E	800	240	-	8	-	-	KRUEGER LMHS	BOX LABEL DATA - COOLING CFM 600 / MIN CFM 180
505	E	750	225	-	8	-	-	KRUEGER LMHS	-
506	E	400	140	-	6	-	-	KRUEGER LMHS	-
507	E	1275	420	-	10	-	-	KRUEGER LMHS	BOX LABEL DATA - COOLING CFM 1075 / MIN CFM 323
508	E	1050	315	-	10	-	-	KRUEGER LMHS	-
509	E	300	90	-	5	-	-	KRUEGER LMHS	-
510	E	1000	300	-	10	-	-	KRUEGER LMHS	-
511	E	750	229	-	8	-	-	KRUEGER LMHS	-
512	E	400	120	-	6	-	-	KRUEGER LMHS	-
513	E	975	293	-	10	-	-	KRUEGER LMHS	BOX LABEL DATA - COOLING CFM 900 / MIN CFM 270
514	E	600	180	-	8	-	-	KRUEGER LMHS	-
515	E	600	182	-	8	-	-	KRUEGER LMHS	-
516	E	1450	420	-	12	-	-	KRUEGER LMHS	BOX LABEL DATA - COOLING CFM 1550 / MIN CFM 465
517	E	520	160	-	6	-	-	KRUEGER LMHS	BOX LABEL DATA - COOLING CFM 400/ MIN CFM 120
518	E	600	212	-	8	-	-	KRUEGER LMHS	-
519	E	250	75	-	5	-	-	KRUEGER LMHS	-
520	E	925	278	-	8	-	-	KRUEGER LMHS	BOX LABEL DATA - COOLING CFM 700 / MIN CFM 210
521	E	1050	315	-	10	-	-	KRUEGER LMHS	BOX LABEL DATA - COOLING CFM 1000 / MIN CFM 300
522	E	675	223	-	8	-	-	KRUEGER LMHS	-
523	E	350	112	-	6	-	-	KRUEGER LMHS	-

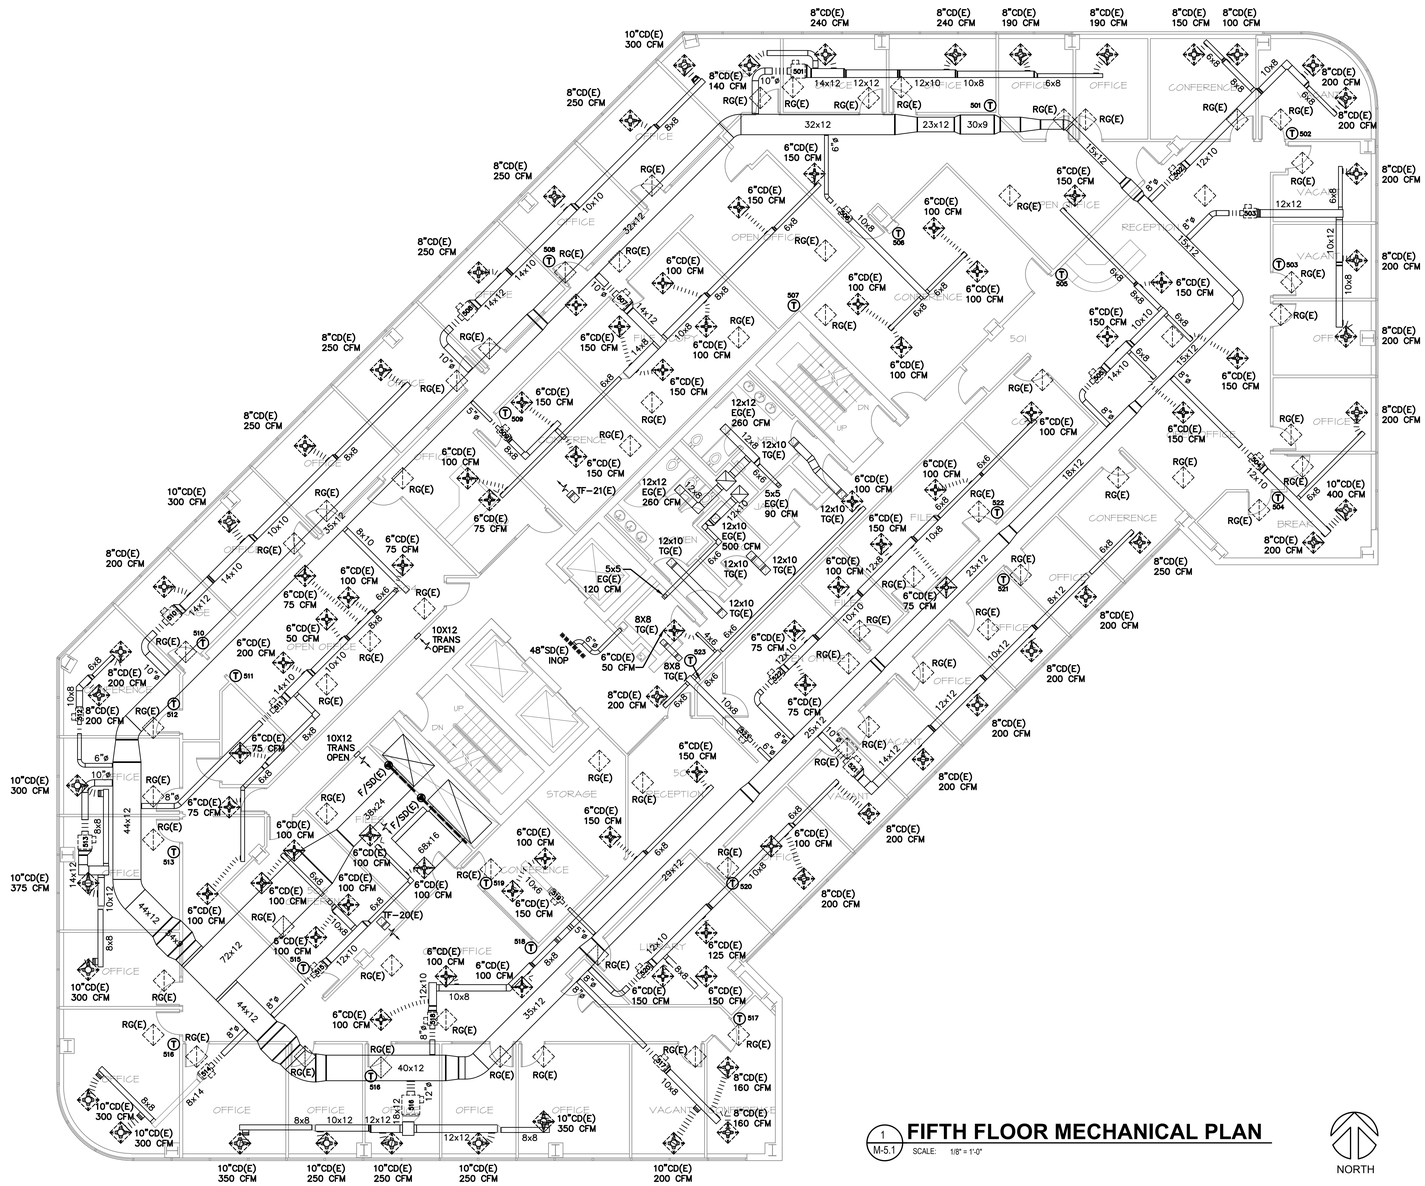

8"CD(E) 240 CFM
8"CD(E) 240 CFM
8"CD(E) 190 CFM
8"CD(E) 190 CFM
8"CD(E) 150 CFM
8"CD(E) 100 CFM
10"CD(E) 300 CFM
8"CD(E) 140 CFM
8"CD(E) 250 CFM
8"CD(E) 200 CFM
8"CD(E) 250 CFM
8"CD(E) 250 CFM
8"CD(E) 200 CFM
10"CD(E) 300 CFM
8"CD(E) 200 CFM
10"CD(E) 375 CFM
10"CD(E) 300 CFM
8"CD(E) 250 CFM
8"CD(E) 250 CFM
8"CD(E) 250 CFM
8"CD(E) 250 CFM
8"CD(E) 200 CFM
8"CD(E) 200 CFM
8"CD(E) 200

MECHANICAL SYMBOLS

EXISTING DUCTWORK	6x10
EXTERIOR DUCTWORK	6x10
REGISTERS & DIFFUSERS	
EXISTING DENOTED AS	(E)
EQUIPMENT TAG	503
THERMOSTAT	T
SWITCH	S
DIRECTIONAL ARROW	
UNDERCUT DOOR DENOTED AS	U.C.
PIPING DROP	
PIPING RISE	
PIPING TEE	
EXISTING PIPE END	
FIRE/SMOKE DAMPER	F/SD
FIRE DAMPER	FD
RADIATION DAMPER	RD
HOT WATER SUPPLY	HWS
HOT WATER RETURN	HWR
COLD WATER SUPPLY	CWS
COLD WATER RETURN	CWR

HYDRONIC BASEBOARD HEATER SCHEDULE - FIFTH FLOOR

MARK	DESCRIPTION	MFR. & MODEL	CAPACITY	REMARKS
BBH	BASEBOARD RADIATION HEATER	SLANT-FIN	700 BTU/LF	-

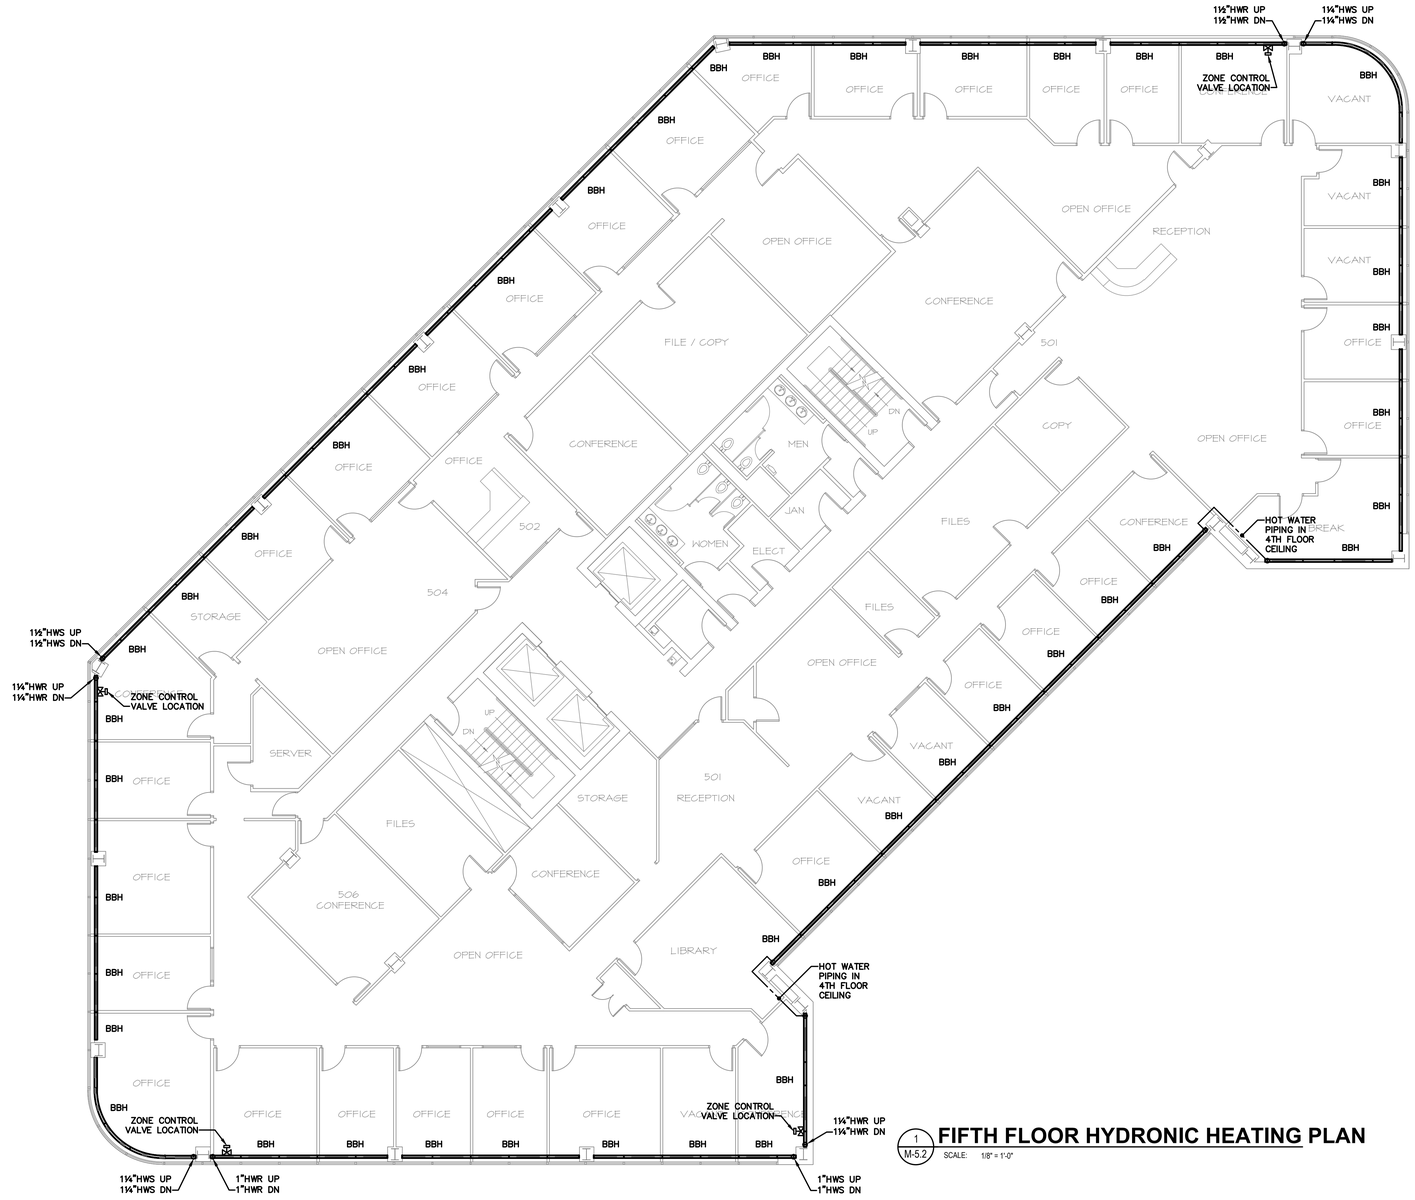

1 M-5.2 **FIFTH FLOOR HYDRONIC HEATING PLAN**

SCALE: 1/8" = 1'-0"

Chavez Tiffany & Ayers Engineering Corporation

119 West Cucharras Street
Colorado Springs, Colorado 80903
P (719)636-0021

COLORADO LICENSED DARWIN A. TIFFANY 43279 PROFESSIONAL ENGINEER

06/30/20

CITY ADMINISTRATION BUILDING

AS BUILT DRAWINGS OF EXISTING HVAC
30 SOUTH NEVADA
COLORADO SPRINGS, COLORADO

ISSUE HISTORY:

1	99% AS BUILT	03/30/20
2	FINAL AS BUILT	06/30/20

DRAWN BY	KSP
CHECKED BY	DAT
DATE	6/30/20

DRAWING TITLE
FIFTH FLOOR HYDRONIC HEATING PLAN

DRAWING NO.
M-5.2

FAN SCHEDULE - SIXTH FLOOR


MARK	DESCRIPTION	PERFORMANCE				ELECTRICAL		MODEL	WT.	REMARKS
		CFM	TSP	RPM	BHP	HP	POWER			
TF-23	CONF. ROOM TRANSFER	400	0.125"	-	-	1/15	120/1P	GREENHECK SP-50	-	6TH FLOOR CONFERENCE ROOM
TF-24	CONF. ROOM TRANSFER	200	0.125"	-	-	1/40	120/1P	GREENHECK SP-25	-	6TH FLOOR CONFERENCE ROOM
TF-25	CONF. ROOM TRANSFER	200	0.125"	-	-	1/40	120/1P	GREENHECK SP-25	-	6TH FLOOR CONFERENCE ROOM
TF-26	CONF. ROOM TRANSFER	200	0.125"	-	-	1/40	120/1P	GREENHECK SP-25	-	6TH FLOOR CONFERENCE ROOM

MECHANICAL SYMBOLS

EXISTING DUCTWORK	6x10
EXTERIOR DUCTWORK	6x10
REGISTERS & DIFFUSERS	
EXISTING DENOTED AS	(E)
EQUIPMENT TAG	503
THERMOSTAT	T
SWITCH	S
DIRECTIONAL ARROW	
UNDERCUT DOOR DENOTED AS	U.C.
PIPING DROP	
PIPING RISE	
PIPING TEE	
EXISTING PIPE END	
FIRE/SMOKE DAMPER	F/SD
FIRE DAMPER	FD
RADIATION DAMPER	RD
HOT WATER SUPPLY	HWS
HOT WATER RETURN	HWR
COLD WATER SUPPLY	CWS
COLD WATER RETURN	CWR

VARIABLE AIR VOLUME TERMINAL UNIT SCHEDULE - SIXTH FLOOR

MARK	EXISTING /NEW	COOLING CFM	MIN CFM	FAN CFM	INLET DIA.	FAN POWER	FAN HP	MODEL	REMARKS
601	E	1100	330	-	10	-	-	KRUEGER LMHS	-
602	E	700	210	-	8	-	-	KRUEGER LMHS	-
603	E	925 725	278	-	8	-	-	KRUEGER LMHS	BOX LABEL DATA - COOLING CFM 800 / MIN CFM 240
604	E	975	293	-	10	-	-	KRUEGER LMHS	-
605	E	450	135	-	6	-	-	KRUEGER LMHS	-
606	E	1000	300	-	10	-	-	KRUEGER LMHS	-
607	E	300	90	-	5	-	-	KRUEGER LMHS	-
608	E	700	210	-	8	-	-	KRUEGER LMHS	-
609	E	875	283	-	10	-	-	KRUEGER LMHS	-
610	E	400	120	-	6	-	-	KRUEGER LMHS	-
611	E	950	285	-	10	-	-	KRUEGER LMHS	-
612	E	900	270	-	10	-	-	KRUEGER LMHS	-
613	E	1100	330	-	10	-	-	KRUEGER LMHS	BOX LABEL DATA - COOLING CFM 1000 / MIN CFM 300
614	E	600	180	-	8	-	-	KRUEGER LMHS	-
615	E	1100	330	-	10	-	-	KRUEGER LMHS	-
616	E	750	225	-	8	-	-	KRUEGER LMHS	-
617	E	520	155	-	6	-	-	KRUEGER LMHS	BOX LABEL DATA - COOLING CFM 400 / MIN CFM 120
618	E	200	85	-	6	-	-	KRUEGER LMHS	BOX LABEL DATA - COOLING CFM 400 / MIN CFM 120
619	E	800	240	-	8	-	-	KRUEGER LMHS	-
620	E	400	120	-	6	-	-	KRUEGER LMHS	-
621	E	1150	345	-	10	-	-	KRUEGER LMHS	BOX LABEL DATA - COOLING CFM 1000 / MIN CFM 300
622	E	1025	308	-	10	-	-	KRUEGER LMHS	BOX LABEL DATA - COOLING CFM 900 / MIN CFM 270
623	E	450	167	-	6	-	-	KRUEGER LMHS	-
624	E	350	105	-	6	-	-	KRUEGER LMHS	-
625 - #3	E	500	150	-	6	-	-	KRUEGER LMHS	-

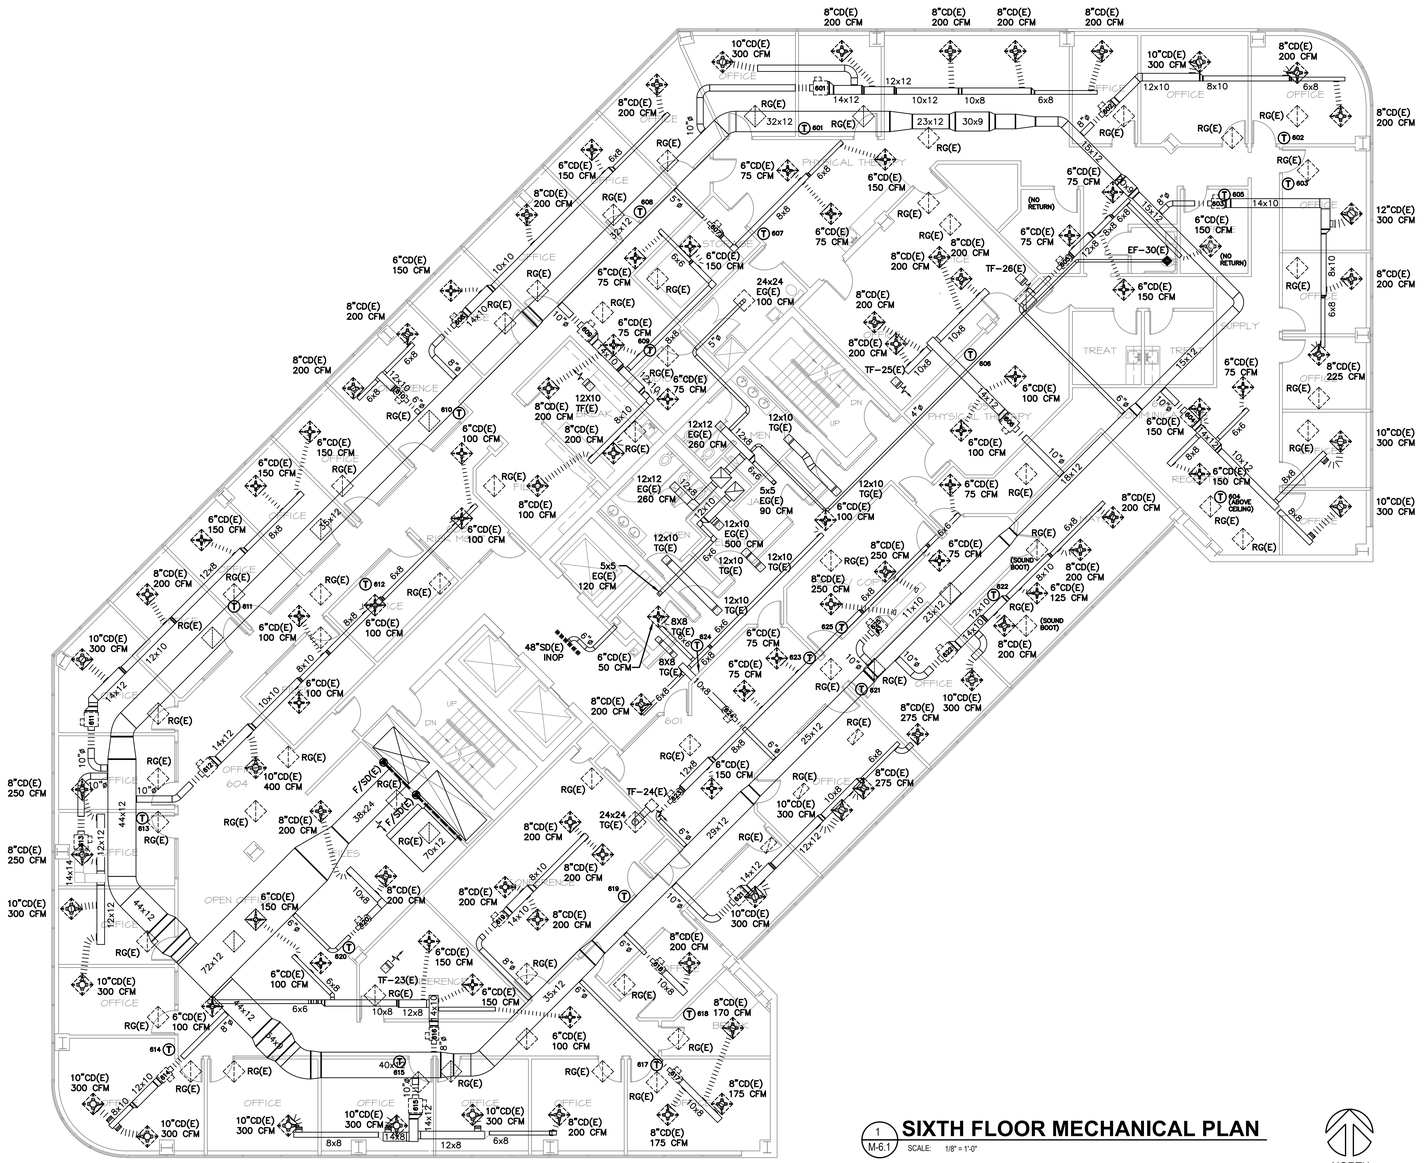

1 M-6.1 **SIXTH FLOOR MECHANICAL PLAN**

SCALE: 1/8" = 1'-0"

NORTH

Chavez Tiffany & Ayers Engineering Corporation

119 West Cucharras Street
Colorado Springs, Colorado 80903
P (719)636-0021

COLORADO LICENSED DAWN A. TIFFANY 43979 PROFESSIONAL ENGINEER

06/30/20

CITY ADMINISTRATION BUILDING

AS BUILT DRAWINGS OF EXISTING HVAC
30 SOUTH NEVADA
COLORADO SPRINGS, COLORADO

ISSUE HISTORY:

1	99% AS BUILT	03/30/20
2	FINAL AS BUILT	06/30/20

DRAWN BY	KSP
CHECKED BY	DAT
DATE	6/30/20

DRAWING TITLE
SIXTH FLOOR MECHANICAL PLAN


DRAWING NO.
M-6.1

MECHANICAL SYMBOLS

EXISTING DUCTWORK	6x10
EXTERIOR DUCTWORK	6x10
REGISTERS & DIFFUSERS	
EXISTING DENOTED AS	(E)
EQUIPMENT TAG	503
THERMOSTAT	T
SWITCH	S
DIRECTIONAL ARROW	
UNDERCUT DOOR DENOTED AS	U.C.
PIPING DROP	
PIPING RISE	
PIPING TEE	
EXISTING PIPE END	
FIRE/SMOKE DAMPER	F/SD
FIRE DAMPER	FD
RADIATION DAMPER	RD
HOT WATER SUPPLY	HWS
HOT WATER RETURN	HWR
COLD WATER SUPPLY	CWS
COLD WATER RETURN	CWR

HYDRONIC BASEBOARD HEATER SCHEDULE - SIXTH FLOOR

MARK	DESCRIPTION	MFR. & MODEL	CAPACITY	REMARKS
BBH	BASEBOARD RADIATION HEATER	SLANT-FIN	700 BTU/LF	-

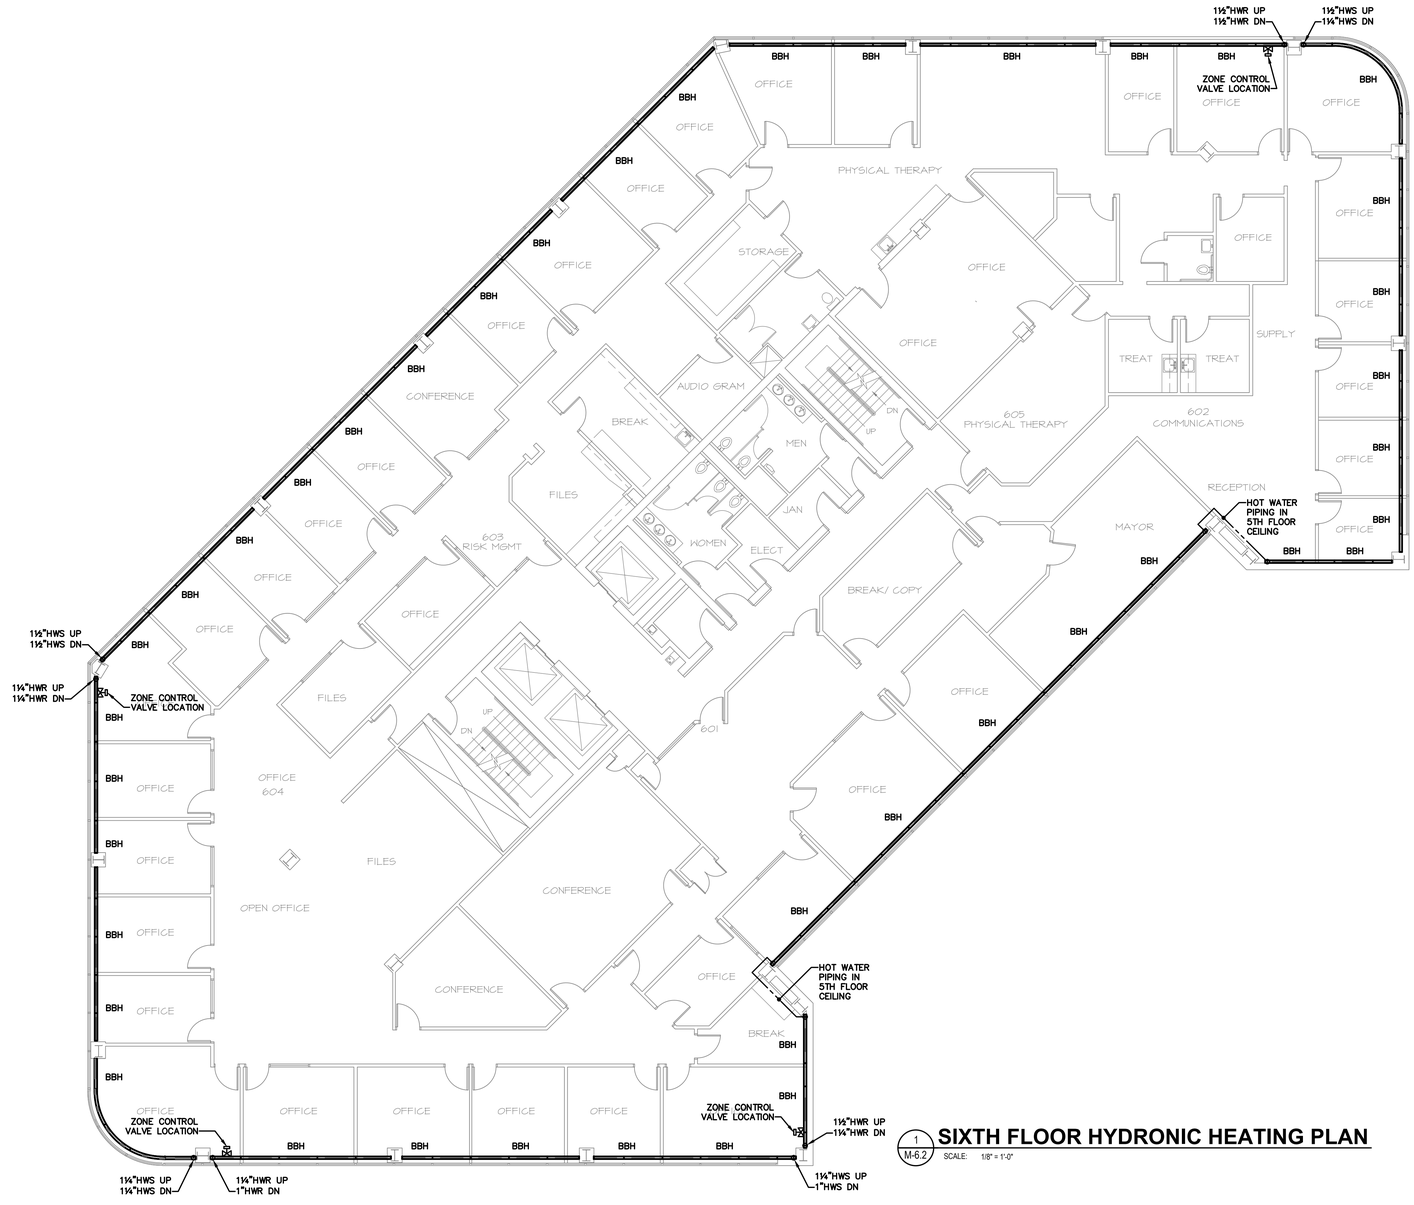

1 M-6.2 **SIXTH FLOOR HYDRONIC HEATING PLAN**

SCALE: 1/8" = 1'-0"

Chavez Tiffany & Ayers Engineering Corporation

119 West Cucharras Street
Colorado Springs, Colorado 80903
P (719)636-0021

COLORADO LICENSED DARWIN A. TIFFANY 43379 PROFESSIONAL ENGINEER

06/30/20

CITY ADMINISTRATION BUILDING

AS BUILT DRAWINGS OF EXISTING HVAC
30 SOUTH NEVADA
COLORADO SPRINGS, COLORADO

ISSUE HISTORY:

1	99% AS BUILT	03/30/20
2	FINAL AS BUILT	06/30/20

DRAWN BY	KSP
CHECKED BY	DAT
DATE	6/30/20

DRAWING TITLE
SIXTH FLOOR HYDRONIC HEATING PLAN

DRAWING NO.
M-6.2

FAN SCHEDULE - SEVENTH FLOOR


MARK	DESCRIPTION	PERFORMANCE				ELECTRICAL		MODEL	WT.	REMARKS
		CFM	TSP	RPM	BHP	HP	POWER			
TF-27	CONF. ROOM TRANSFER	200	0.125"	-	-	1/40	120/1P	GREENHECK SP-25	-	7TH FLOOR CONFERENCE ROOM
TF-28	CONF. ROOM TRANSFER	200	0.125"	-	-	1/40	120/1P	GREENHECK SP-25	-	7TH FLOOR CONFERENCE ROOM

MECHANICAL SYMBOLS

EXISTING DUCTWORK	6x10
EXTERIOR DUCTWORK	6x10
REGISTERS & DIFFUSERS	
EXISTING DENOTED AS	(E)
EQUIPMENT TAG	503
THERMOSTAT	T
SWITCH	S
DIRECTIONAL ARROW	
UNDERCUT DOOR DENOTED AS	U.C.
PIPING DROP	
PIPING RISE	
PIPING TEE	
EXISTING PIPE END	
FIRE/SMOKE DAMPER	F/SD
FIRE DAMPER	FD
RADIATION DAMPER	RD
HOT WATER SUPPLY	HWS
HOT WATER RETURN	HWR
COLD WATER SUPPLY	CWS
COLD WATER RETURN	CWR

VARIABLE AIR VOLUME TERMINAL UNIT SCHEDULE - SEVENTH FLOOR

MARK	EXISTING /NEW	COOLING CFM	MIN CFM	FAN CFM	INLET DIA.	FAN POWER	FAN HP	MODEL	REMARKS
701	E	900	270	-	10	-	-	KRUEGER LMHS	-
702	E	500	150	-	8	-	-	KRUEGER LMHS	-
703	E	950	285	-	10	-	-	KRUEGER LMHS	-
704	E	500	150	-	8	-	-	KRUEGER LMHS	-
705	E	250	90	-	5	-	-	KRUEGER LMHS	-
706	E	300	108	-	5	-	-	KRUEGER LMHS	-
707	E	700	224	-	8	-	-	KRUEGER LMHS	-
708	E	400	120	-	6	-	-	KRUEGER LMHS	-
709	E	300	90	-	5	-	-	KRUEGER LMHS	-
710	E	900	270	-	10	-	-	KRUEGER LMHS	-
711	E	950	285	-	10	-	-	KRUEGER LMHS	-
712	E	200	60	-	4	-	-	KRUEGER LMHS	-
713	E	775	294	-	10	-	-	KRUEGER LMHS	BOX LABEL DATA - COOLING CFM 875 / MIN CFM 180
714	E	1300	390	-	12	-	-	KRUEGER LMHS	-
715	E	700	210	-	8	-	-	KRUEGER LMHS	-
716	E	500	150	-	6	-	-	KRUEGER LMHS	-
717	E	1500	450	-	12	-	-	KRUEGER LMHS	-
718	E	650	195	-	8	-	-	KRUEGER LMHS	-
719	E	600	180	-	8	-	-	KRUEGER LMHS	-
720	E	900	270	-	10	-	-	KRUEGER LMHS	-
721	E	325	98	-	6	-	-	KRUEGER LMHS	-
722	E	1200	360	-	10	-	-	KRUEGER LMHS	-
723	E	500	161	-	8	-	-	KRUEGER LMHS	-
724	E	350	105	-	6	-	-	KRUEGER LMHS	-

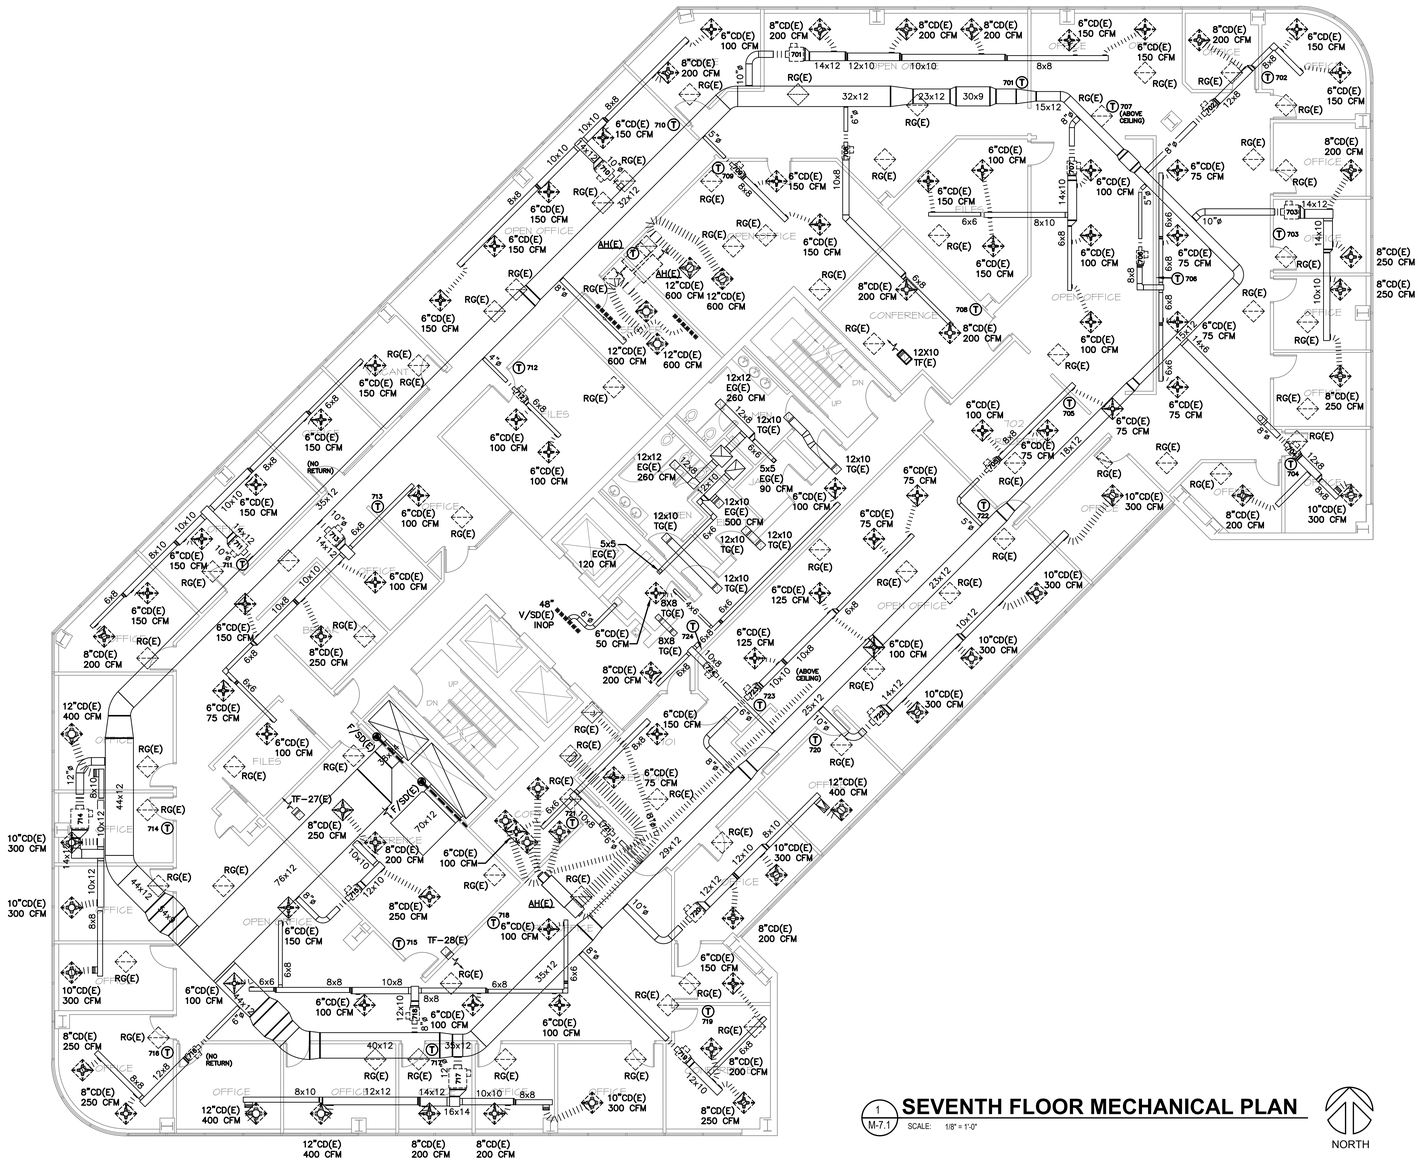

1 M-7.1 **SEVENTH FLOOR MECHANICAL PLAN**

SCALE: 1/8" = 1'-0"

NORTH

Chavez Tiffany & Ayers Engineering Corporation

119 West Cucharras Street
Colorado Springs, Colorado 80903
P (719)636-0021

COLORADO LICENSED ROBIN A. TIFFANY 43979 PROFESSIONAL ENGINEER

06/30/20

CITY ADMINISTRATION BUILDING

AS BUILT DRAWINGS OF EXISTING HVAC
30 SOUTH NEVADA
COLORADO SPRINGS, COLORADO

ISSUE HISTORY:

1	99% AS BUILT	03/30/20
2	FINAL AS BUILT	06/30/20

DRAWN BY	KSP
CHECKED BY	DAT
DATE	6/30/20

DRAWING TITLE
SEVENTH FLOOR MECHANICAL PLAN


DRAWING NO.
M-7.1

MECHANICAL SYMBOLS

EXISTING DUCTWORK	6x10
EXTERIOR DUCTWORK	6x10
REGISTERS & DIFFUSERS	
EXISTING DENOTED AS	(E)
EQUIPMENT TAG	503
THERMOSTAT	T
SWITCH	S
DIRECTIONAL ARROW	
UNDERCUT DOOR DENOTED AS	U.C.
PIPING DROP	
PIPING RISE	
PIPING TEE	
EXISTING PIPE END	
FIRE/SMOKE DAMPER	F/SD
FIRE DAMPER	FD
RADIATION DAMPER	RD
HOT WATER SUPPLY	HWS
HOT WATER RETURN	HWR
COLD WATER SUPPLY	CWS
COLD WATER RETURN	CWR

HYDRONIC BASEBOARD HEATER SCHEDULE - SEVENTH FLOOR

MARK	DESCRIPTION	MFR. & MODEL	CAPACITY	REMARKS
BBH	BASEBOARD RADIATION HEATER	SLANT-FIN	700 BTU/LF	-

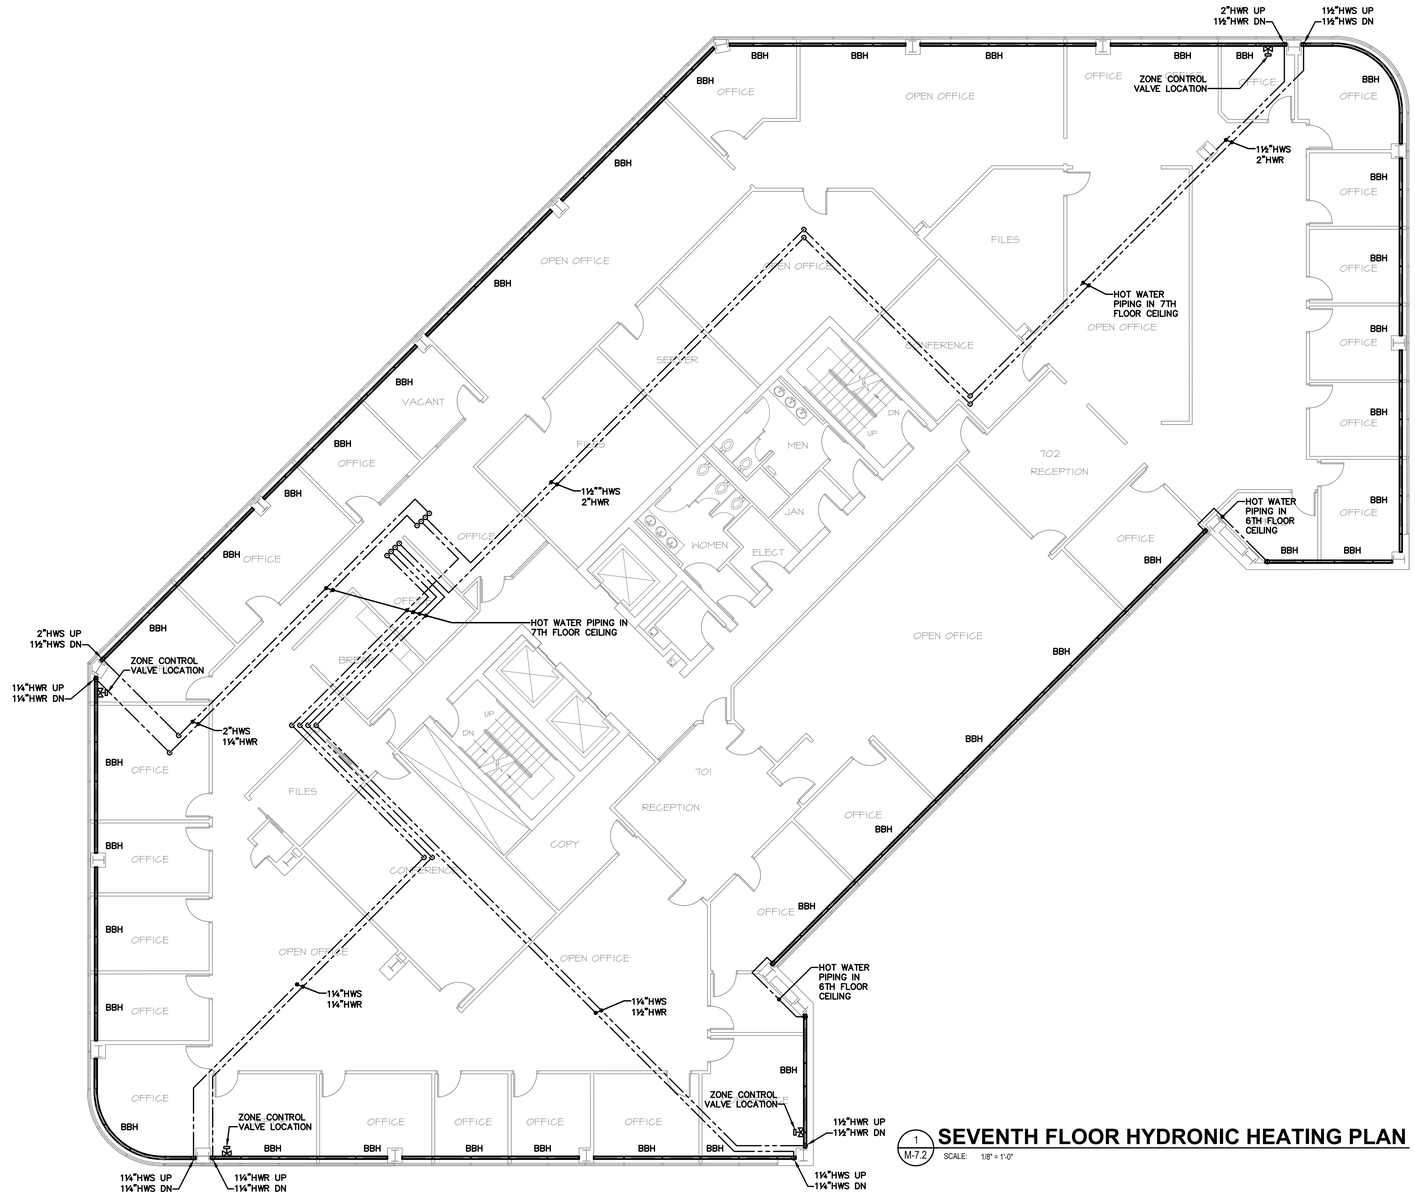

1 M-7.2 **SEVENTH FLOOR HYDRONIC HEATING PLAN**

SCALE: 1/8" = 1'-0"

Chavez Tiffany & Ayers Engineering Corporation

119 West Cucharras Street
Colorado Springs, Colorado 80903
P (719)636-0021

COLORADO LICENSED DARWIN A. TIFFANY 43379 PROFESSIONAL ENGINEER

06/30/20

CITY ADMINISTRATION BUILDING
AS BUILT DRAWINGS OF EXISTING HVAC
30 SOUTH NEVADA
COLORADO SPRINGS, COLORADO

ISSUE HISTORY:

1	99% AS BUILT	03/30/20
2	FINAL AS BUILT	06/30/20

DRAWN BY	KSP
CHECKED BY	DAT
DATE	6/30/20

DRAWING TITLE
SEVENTH FLOOR HYDRONIC HEATING PLAN


DRAWING NO.
M-7.2

MECHANICAL SYMBOLS

EXISTING DUCTWORK	6x10
EXTERIOR DUCTWORK	6x10
REGISTERS & DIFFUSERS	
EXISTING DENOTED AS	(E)
EQUIPMENT TAG	503
THERMOSTAT	T
SWITCH	S
DIRECTIONAL ARROW	
UNDERCUT DOOR DENOTED AS	U.C.
PIPING DROP	
PIPING RISE	
PIPING TEE	
EXISTING PIPE END	
FIRE/SMOKE DAMPER	F/SD
FIRE DAMPER	FD
RADIATION DAMPER	RD
HOT WATER SUPPLY	HWS
HOT WATER RETURN	HWR
COLD WATER SUPPLY	CWS
COLD WATER RETURN	CWR

FAN SCHEDULE - PENTHOUSE FLOOR

MARK	DESCRIPTION	PERFORMANCE				ELECTRICAL		MODEL	WT.	REMARKS
		CFM	TSP	RPM	BHP	HP	POWER			
SF-1	SUPPLY FAN	56000	6.67"	1760	67.0	75	460/3P	FLAKT 112-5-8 FVAC	1440	TAGGED - FAN-CAB-S01
SF-2	SUPPLY FAN	56000	6.67"	1760	67.0	75	460/3P	FLAKT 112-5-8 FVAC	1440	TAGGED - FAN-CAB-S02
RF-1	RETURN FAN	50000	2.0"	1180	17.0	20	460/3P	FLAKT 125-5-6-FVAC	1210	TAGGED - FAN-CAB-R01
RF-2	RETURN FAN	50000	2.0"	1180	17.0	20	460/3P	FLAKT 125-5-6-FVAC	1210	TAGGED - FAN-CAB-E01
EF-1	TOILET EXHAUST	5420	0.85"	1735	-	2	460/3P	GREENHECK SFB 20 20	-	TAGGED - FAN-CAB-E01
EF-2	GENERAL EXHAUST	4220	1.0"	1740	-	2	460/3P	GREENHECK SFB 18 20	-	TAGGED - FAN-CAB-E02
EF-3	PENTHOUSE EXHAUST	14400	0.25"	575	-	2	460/3P	COOK 24UR6B	-	-

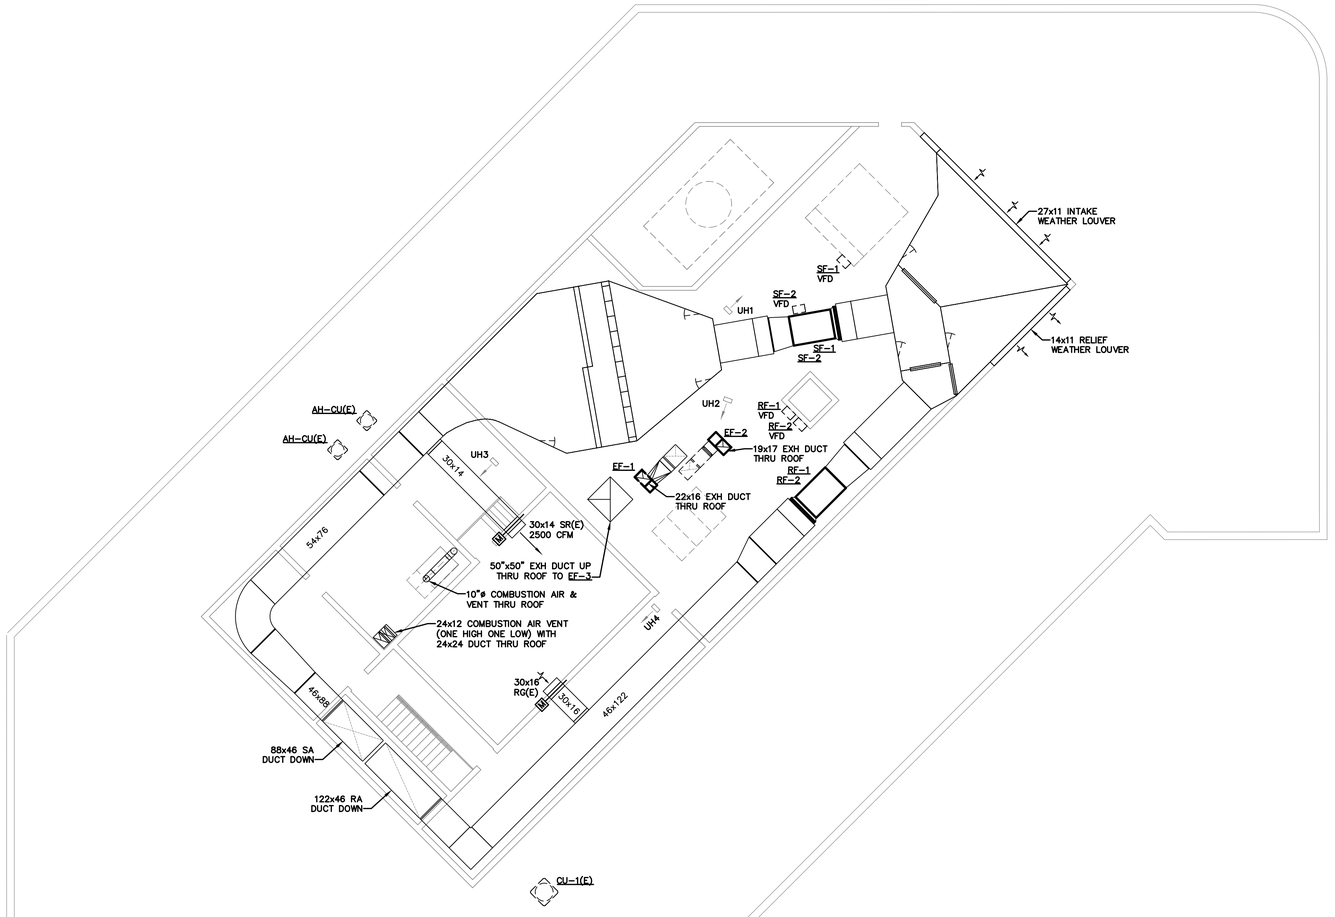

1 M-8.1 **PENTHOUSE FLOOR MECHANICAL PLAN**

SCALE: 1/8" = 1'-0"

NORTH

Chavez Tiffany & Ayers
Engineering Corporation

119 West Cucharras Street
Colorado Springs, Colorado 80903
P (719)636-0021

COLORADO LICENSED
DARWIN A. TIFFANY
43279
PROFESSIONAL ENGINEER

06/30/20

CITY ADMINISTRATION BUILDING
AS BUILT DRAWINGS OF EXISTING HVAC
30 SOUTH NEVADA
COLORADO SPRINGS, COLORADO

ISSUE HISTORY:

1	99% AS BUILT	03/30/20
2	FINAL AS BUILT	06/30/20

DRAWN BY	KSP
CHECKED BY	DAT
DATE	6/30/20

DRAWING TITLE
PENTHOUSE FLOOR
MECHANICAL PLAN

DRAWING NO.
M-8.1

PUMP SCHEDULE

MARK	DESCRIPTION	GPM	TDH	RPM	ELECTRICAL HP	ELECTRICAL POWER	MODEL	WT.	REMARKS
P-1	PRIMARY HW PUMP	138	30	1750	2.00	460/3P	ARMSTRONG 3D-4380 B.F.	-	REPLACED 3/12/14
P-2	STAND-BY PUMP	138	30	1750	2.00	460/3P	ARMSTRONG 3D-4380 B.F.	-	REPLACED 9/22/17
P-3	SECONDARY HW PUMP	55	55	1745	1.50	460/3P	ARMSTRONG 1.5D-4380 B.F.	-	TAGGED - PMP-CAB-C03
P-4	SECONDARY HW PUMP	16	55	1725	1.50	460/3P	ARMSTRONG 1.5D-4380 B.F.	-	TAGGED - PMP-CAB-C04
P-5	SECONDARY HW PUMP	28	55	1725	1.50	460/3P	ARMSTRONG 1.5D-4380 B.F.	-	TAGGED - PMP-CAB-C05
P-6	SECONDARY HW PUMP	18	55	1745	1.50	460/3P	ARMSTRONG 1.5D-4380 B.F.	-	TAGGED - PMP-CAB-C06
P-7	CHILLED WATER PUMP	560	45	1800	10.00	460/3P	AURORA PUMP 80-11230	-	TAGGED - PMP-CAB-C10
P-8	CONDENSER WATER PUMP	900	50	1800	15.00	460/3P	AURORA PUMP 80-11231	-	TAGGED - PMP-CAB-C11

UNIT HEATER SCHEDULE - PENTHOUSE FLOOR

MARK	DESCRIPTION	BTU INPUT	GPM	WATER EWT	WATER LWT	ELECTRICAL HP	ELECTRICAL POWER	MODEL	REMARKS
UH-1	HYDRONIC UNIT HEATER	22.5 MBH	2.3	200	180	1/12	120/1P	MODINE HS-47	PENTHOUSE
UH-2	HYDRONIC UNIT HEATER	22.5 MBH	2.3	200	180	1/12	120/1P	MODINE HS-47	PENTHOUSE
UH-3	HYDRONIC UNIT HEATER	15.0 MBH	1.5	200	180	1/25	120/1P	MODINE HS-24	PENTHOUSE
UH-4	HYDRONIC UNIT HEATER	15.0 MBH	1.5	200	180	1/25	120/1P	MODINE HS-24	PENTHOUSE
UH-16	HYDRONIC UNIT HEATER	300.0 MBH	30.0	200	180	-	460/3P	MODINE V-385	PENTHOUSE AIR HANDLER
UH-17	HYDRONIC UNIT HEATER	391.0 MBH	30.0	200	180	-	460/3P	MODINE V-500	PENTHOUSE AIR HANDLER

EXPANSION TANK SCHEDULE

MARK	DESCRIPTION	VOLUME	MODEL	REMARKS
ET-1	EXPANSION TANK	67 GALLONS	AMTROL AX-120	-
ET-2	EXPANSION TANK	10.9 GALLONS	AMTROL AX-20	-

MECHANICAL SYMBOLS

EXISTING DUCTWORK	6x10
EXTERIOR DUCTWORK	6x10
REGISTERS & DIFFUSERS	
EXISTING DENOTED AS	(E)
EQUIPMENT TAG	503
THERMOSTAT	T
SWITCH	S
DIRECTIONAL ARROW	
UNDERCUT DOOR DENOTED AS	U.C.
PIPING DROP	
PIPING RISE	
PIPING TEE	
EXISTING PIPE END	
FIRE/SMOKE DAMPER	F/SD
FIRE DAMPER	FD
RADIATION DAMPER	RD
HOT WATER SUPPLY	HWS
HOT WATER RETURN	HWR
COLD WATER SUPPLY	CWS
COLD WATER RETURN	CWR

BOILER SCHEDULE

MARK	DESCRIPTION	CAPACITY (MBH) IN-PUT	CAPACITY (MBH) OUT-PUT	ELECTRICAL HP	ELECTRICAL POWER	MODEL	WT.	REMARKS
B-1	HOT WATER BOILER	2160	2078	-	120/1P	VIESSMANN CT3-57	-	TAGGED AS - BLR-CAB-01

CHILLER SCHEDULE

MARK	DESCRIPTION	EXAPORATOR GPM	EWT	LWT	DT	CONDENSOR GPM	EWT	LWT	DT	ELECTRICAL KW	POWER	MODEL	WT.	REMARKS
C-1	COLD WATER CHILLER	-	-	-	-	-	-	-	-	-	460/3P	MULTISTACK MS80T1H2W	-	-
C-2	COLD WATER CHILLER	-	-	-	-	-	-	-	-	-	460/3P	MULTISTACK MS80T1H2W	-	-
C-3	COLD WATER CHILLER	-	-	-	-	-	-	-	-	-	460/3P	MULTISTACK MS80T1H2W	-	-

COOLING TOWER SCHEDULE

MARK	DESCRIPTION	NOM CAPACITY 90°-80°/63° WB	GPM	ELECTRICAL HP	ELECTRICAL POWER	MODEL	WT.	REMARKS
CT-1	COOLING TOWER	360 TONS	1090	10.00	460/3P	MARLEY NC-8807	12360.0	TAGGED AS - CTW-CAB-01

COIL SCHEDULE

MARK	DESCRIPTION	ROWS	FINS/INCH	SIZES	CAPACITY (MBH)	AIR SIDE ENT. AIR	AIR SIDE LVG. AIR	EWT	LWT	GPM	MODEL	REMARKS
CC-1	COOLING COIL	6.0	SERIES 14	28-102	2932 TOTAL	83°DB/ 50°WB	50°DB/55°WB	45°	57°	560.0	CARRIER 28-102-SW	-



1 M-8.2 **PENTHOUSE FLOOR HYDRONIC HEATING PLAN**

SCALE: 1/8" = 1'-0"

Chavez Tiffany & Ayers Engineering Corporation

119 West Cucharras Street
Colorado Springs, Colorado 80903
P (719)636-0021

COLORADO LICENSED DARWIN A. THOMAS 43579 PROFESSIONAL ENGINEER

06/30/20

CITY ADMINISTRATION BUILDING

AS BUILT DRAWINGS OF EXISTING HVAC
30 SOUTH NEVADA
COLORADO SPRINGS, COLORADO

ISSUE HISTORY:

1	99% AS BUILT	03/30/20
2	FINAL AS BUILT	06/30/20

DRAWN BY	KSP
CHECKED BY	DAT
DATE	6/30/20

DRAWING TITLE
PENTHOUSE FLOOR HYDRONIC HEATING PLAN

DRAWING NO.
M-8.2