DAO ARCHITECTURE
7230 Meade Street
Westminster, CO 80030
Phone: 720-273-0431
Email: dan@daoarch.com

Date: 11/12/2026
Project: Westminster Public Schools – 2026 Bond Projects – ECC Renovations
DAO Project No.: 2025-033

Addendum 001

The following revisions are to be incorporated into the Construction Documents, dated September 25, 2026

I. SPECIFICATIONS

None at this time

II. DRAWINGS

Cover – Sheet reissued in its entirety – Incorporating Civil Scope.

Sheet G0.1 – Sheet reissued in its entirety – Clarifying Project Scope.

Sheet C001 – Sheet Issued in its entirety – Incorporating Civil Scope

Sheet C100 – Sheet Issued in its entirety – Incorporating Civil Scope

Sheet C300 – Sheet Issued in its entirety – Incorporating Civil Scope

Sheet CD301 – Sheet Issued in its entirety – Incorporating Civil Scope

Sheet C500 – Sheet Issued in its entirety – Incorporating Civil Scope

Sheet CD501 – Sheet Issued in its entirety – Incorporating Civil Scope

Sheet A1.0 – Sheet reissued in its entirety – Incorporating Civil Scope.

Sheet A2.0 – Sheet reissued in its entirety – Clarifying Project Scope.

Sheet A8.0 – Sheet reissued in its entirety – Incorporating Civil Scope

Sheet P0.1 – Sheet reissued in its entirety – Clarifying Project Scope.

III. OTHER

None issued at this time.

Westminster Public Schools

2026 Bond Projects

ECC Renovations
8030 Irving St. Westminster, CO 80031
DAO No.: 2025-033
100% Construction Documents
September 25, 2026



DRAWING INDEX

GENERAL

Cover	Cover Sheet
G0.0	Standard Symbols, Abbreviations & General Notes
G0.1	Building Code Data

CIVIL

C001	General Notes
C100	Demolition Plan
C300	Grading and Drainage Plan
CD301	Drainage Details
C500	Horizontal Control Plan
CD501	Horizontal Control Details

ARCHITECTURE

AD1.0	Partial Demolition Plan
AD2.0	Demolition Exterior Elevations
A1.0	First Floor Plans
A2.0	Exterior Elevations
A4.0	Wall Sections, Interior Elevations
A8.0	Details, Door Schedule

STRUCTURAL

S0.1	General Notes, Details, And Plan

PLUMBING

P1.0	First Floor Plumbing Plan, Details, And General Notes

DAO ARCHITECTURE

7230 Meade St.
Westminster, CO 80030

Phone: 720.273.0431
Email: dan@daoarch.com
Web: www.daoarch.com

OWNER:
WESTMINSTER PUBLIC SCHOOLS
7002 RALEIGH STREET
WESTMINSTER, CO 80030
CONTACT: DON CIANCIO
PHONE : 720.542.5100

ARCHITECT:
DAO ARCHITECTURE
7230 MEADE ST
WESTMINSTER, CO 80030
CONTACT: DAN ORECCHIO
PHONE : 720.273.0431

STRUCTURAL ENGINEER:
TJF STRUCTURAL
5995 GREENWOOD VILLAGE PLAZA BLVD, STE. 120
GREENWOOD VILLAGE, CO 80111
CONTACT: TROY FORNSTROM
PHONE: 303.618.4555

PLUMBING ENGINEER:
THE BALLARD GROUP
2525 S WADSWORTH BLVD, STE. 200
LAKEWOOD, CO 80227
CONTACT: NATE RUST
PHONE: 303.988.4514

CIVIL ENGINEER:
CONTERRA ENGINEERING
242 LINDEN STREET, No. 5943
FORT COLLINS, CO 80524
CONTACT: ERIK NAKOS
PHONE: 970.391.7862

Rev. #	Description	Rev. Date
1	Addendum 01	11/12/2026

Revision Schedule

Westminster Public Schools

2026 Bond Projects - ECC Renovations
8030 Irving St. Westminster, CO 80031

DAO No.: 2025-033

September 25, 2026

CONSTRUCTION DOCUMENTS

Cover

Autodesk Docs://WPS 2026 Bond Projects - ECC Renovations/WPS ECC (Revit 2026).rvt
11/12/2026 10:44:48 AM

CODE REVIEW

This project entails the replacement of existing waterproofing, addition of a foundation drain, and limited interior alterations to the Early Childhood Center in Westminster, Colorado. 1

This building is an existing E Occupancy building and will remain an E Occupancy.

In general, the scope of the addition and renovations will consist of the replacement of exterior finishes and the replacement of exterior waterproofing. There will be modifications to a small area of interior space, including the relocation of a door and the demolition of (2) walls.

2021 IEBC
The project is considered an Repair and Alteration per prescriptive section 503 of the 2021 IEBC. As such, any alterations shall comply with the requirements for the 2021 International Building Code, and the existing building shall be no less conforming to the provisions of the IBC than the existing building was prior to the alteration. This project's work area is less than 50% of the building area (0 / 78,843 square feet = 0% of the building).

Chapter 3 - Provisions for All Compliance Methods
301 - Administration
301.2 Repairs - Repairs shall comply with the requirements of Chapter 4.
301.3 Alteration, addition, or change of occupancy - The alteration of this existing building shall comply with section 301.3.1.
301.3.1 - Prescriptive compliance method - Alterations complying with Chapter 5 of this code in buildings complying with the International Fire Code shall be considered in compliance with the provisions of this code
302 - General Provisions
302.3 Existing Materials - Materials already in use in a building in compliance with requirements or approvals in effect at the time of their erection or installation shall be permitted to remain in use unless determined by the code official to be unsafe.
302.4 New and replacement materials - Except as otherwise required or permitted by this code, materials permitted by the applicable code shall be used. Like materials shall be permitted for repairs or alterations, provided that unsafe conditions are not created. Hazardous materials shall not be used where the code for new construction would not permit their use in buildings of similar occupancy, purpose, and location.

Chapter 4 - Repairs
401 - General
401.2 Compliance - The work shall not make the building less complying than it was before the repair was undertaken.
403 - Fire Protection
403.1 General - Repairs shall be done in a manner that maintains the level of fire protection provided.
404 - Means of Egress
404.1 General - Repairs shall be done in a manner that maintains the level of protection provided for the means of egress.

Chapter 5 - Prescriptive Compliance Method
Section 503 - Alterations
503.1 - General - Alterations to any building or structure shall comply with the requirements of the International Building Code for new construction. Alterations shall be such that the existing building or structure is not less complying with the provisions of the International Building Code than the existing building or structure was prior to the alteration.
503.3 & 503.4 - This project is not altering the existing structural gravity or lateral systems in such a way as to trigger compliance with sections 503.3 or 503.4.

2021 IBC
Chapter 3 - Use and Occupancy Classification
305 - Educational: Group E
The Occupancy type and use of the space are not changing as a part of this project.

Chapter 4 - Special Detailed Requirements Based on Use and Occupancy
Not Applicable

Chapter 5 - General Building Heights and Areas

504 - Building height and Number of Stories
Building Height is existing and will not be altered by the scope of this project
506 - Building Area
Building Area is existing and will not be altered by the scope of this project.

Chapter 6 - Types of Construction
602 - Construction Classification
602.3 - Type IIIB - The existing building is assumed to be type IIIB, as the exterior walls are of noncombustible materials, and the interior building elements are of any material permitted by IBC.

Chapter 7 - Fire and Smoke Protection Features
707 - Fire Barriers
707.3.10 Fire Areas - Existing Fire Areas will not be altered by the scope of this project.

Chapter 8 - Interior Finishes
Not Applicable

Chapter 9 - Fire Protection Systems
903 - Automatic Sprinkler Systems
903.2.3 Group E - *The existing building is unsprinklered. Sprinklers would not otherwise be required as no area of the building exceeds 12,000SF*
Fire Area A-1 = 11,762 SF
Fire Area A-2 = 9,103 SF
Fire Area A-3 = 3,282 SF
As such, fire sprinklers are not required.
907 - Fire Alarm and Detection Systems
Fire alarm and detection systems are existing and will not be impacted by the scope of this work, with the exception of the relocation of a pull station within a room. A deferred submittal for this scope will be submitted. 1

Chapter 10 - Means of Egress
1006 - Number of Exits
1006.2.1 - Spaces with (1) Exit A and B occupancies, Unsprinklered: 49 Ocupants, 75'
1017 - Exit Access Travel Distance
1017.2 Exist Access Travel Distance- A and B occupancies, Unsprinklered, 200'

Chapter 11 - Accessibility
Accessibility features are existing conditions that will not be altered by this scope of work

Chapter 13 - Energy Efficiency
The existing building thermal envelope is existing and will not be altered by this scope of work.

Chapter 29 - Plumbing Systems
Plumbing features are existing conditions that will not be altered by this scope of work

Colorado Model Electric Ready and Solar Ready Code
CMERSRC is not applicable to the scope of this project as it is not a major renovation, addition, or first tenant finish to the building.

APPLICABLE BUILDING CODES

All new work shall comply with the requirements of the codes and standards adopted by the State of Colorado.
The primary Applicable Codes and Standards are:

The 2021 International Code Series:
The 2021 International Existing Building Code (IEBC)
The 2021 International Building Code (IBC)
The 2021 International Fire Code (IFC)
The 2021 International Mechanical Code (IMC)
The 2021 International Energy Conservation Code (IECC)
The 2024 Colorado Plumbing Code (CPC)
The 2024 Colorado Fuel Gas Code (CFGC)
The 2013 National Electrical Code
The 2026 ICC A117.1, Accessible and Usable Buildings and Facilities
The 2023 Colorado Model Electric and Solar Ready Code

EGRESS TRAVEL DISTANCES	
PATH NAME	DISTANCE
1A	50' - 11"

LIFE SAFETY SYMBOLS

1

FEC — FIRE EXTINGUISHER CABINET (EXISTING)
1 HOUR FIRE PARTITION (EXISTING)
2 HOUR FIRE BARRIER (EXISTING)
PATH OF TRAVEL (FOR CUMULATIVE DISTANCES REFER TO SCHEDULE)
XX — EXIT DISCHARGE
P: XX"
R: XX" — WIDTH PROVIDED / WIDTH REQUIRED


Table 2902.1

Classification	Occupancy	Description	Water Closets Male	Water Closets Female	Lavatories Male	Lavatories Female	Bathtubs/ Showers	Drinking Fountains	Other
Educational	E	Educational facilities	329 / 50	329 / 50	329 / 50	329 / 50	N/A	658 / 100	1 Service Sink
			6.58	**6.58**	**6.58**	**6.58**		**6.58**	
		Total Required	**6.58**	**6.58**	**6.58**	**6.58**	N/A	**6.58**	1 Service Sink
		Total Provided	**10**	**9**	**14**	**14**	N/A	**19**	**1 Service Sink**

*ALL PLUMBING FIXTURES ARE EXISTING-TO-REMAIN AND WILL NOT BE ALTERED BY THIS PROJECT

Occupant Load Table

Number	Name	Occupancy Classification	Area	Area Function	SF Per Occupant	Occupant Load	Required Exiting Width
000	Vestibule	(none)	109 SF	(none)		0	0
1	Classroom	(IBC) E	742 SF	IBC_Educational: Classroom area	20 SF	38	7.5
2	Classroom	(IBC) E	747 SF	IBC_Educational: Classroom area	20 SF	38	7.6
3	Classroom	(IBC) E	761 SF	IBC_Educational: Classroom area	20 SF	39	7.7
4	Classroom	(IBC) E	761 SF	IBC_Educational: Classroom area	20 SF	39	7.7
5	Classroom	(IBC) E	747 SF	IBC_Educational: Classroom area	20 SF	38	7.6
6	Classroom	(IBC) E	746 SF	IBC_Educational: Classroom area	20 SF	38	7.6
7	Classroom	(IBC) E	745 SF	IBC_Educational: Classroom area	20 SF	38	7.6
8	Hearing and Vision	(IBC) E	566 SF	IBC_Educational: Classroom area	20 SF	29	5.8
9	Classroom	(IBC) E	748 SF	IBC_Educational: Classroom area	20 SF	38	7.6
10	Classroom	(IBC) E	746 SF	IBC_Educational: Classroom area	20 SF	38	7.6
11	Classroom	(IBC) E	747 SF	IBC_Educational: Classroom area	20 SF	38	7.6
12	Classroom	(IBC) E	763 SF	IBC_Educational: Classroom area	20 SF	39	7.7
13	Classroom	(IBC) E	763 SF	IBC_Educational: Classroom area	20 SF	39	7.7
14	Classroom	(IBC) E	747 SF	IBC_Educational: Classroom area	20 SF	38	7.6
15	Classroom	(IBC) E	833 SF	IBC_Educational: Classroom area	20 SF	42	8.4
16	Corridor	(none)	270 SF	(none)		0	0
17	Corridor	(none)	307 SF	(none)		0	0
18	Corridor	(none)	268 SF	(none)		0	0
19	Corridor	(none)	1230 SF	(none)		0	0
26	Corridor	(none)	542 SF	(none)		0	0
39	Corridor	(none)	301 SF	(none)		0	0
40	Corridor	(none)	394 SF	(none)		0	0
43	Gym Storage	(IBC) S-1	449 SF	IBC_Accessory storage areas, mechanical equipment room	300 SF	2	0.4
45	Corridor	(none)	158 SF	(none)		0	0
47	Vestibule	(none)	59 SF	(none)		0	0
48	Vestibule	(none)	59 SF	(none)		0	0
100A	Reception / Waiting	(IBC) B	313 SF	IBC_Business areas	100 SF	4	0.7
100B	Sec.	(IBC) B	115 SF	IBC_Business areas	100 SF	2	0.3
100C	Infirmary	(IBC) B	94 SF	IBC_Business areas	100 SF	1	0.3
100D	Workarea	(IBC) B	70 SF	IBC_Business areas	100 SF	1	0.2
100E	Principal	(IBC) B	200 SF	IBC_Business areas	100 SF	2	0.5
100F	Storage	(IBC) B	94 SF	IBC_Accessory storage areas, mechanical equipment room	300 SF	1	0.2
120	Girls	(none)	123 SF	(none)		0	0
121	Kitchen	(IBC) B	465 SF	IBC_Kitchens, commercial	200 SF	3	0.6
123	Elec.	(IBC) E	60 SF	IBC_Accessory storage areas, mechanical equipment room	300 SF	1	0.1
124	Boys	(none)	124 SF	(none)		0	0
125	Girls	(none)	165 SF	(none)		0	0
126	Boiler	(IBC) E	315 SF	IBC_Accessory storage areas, mechanical equipment room	300 SF	2	0.3
127	Boys	(none)	157 SF	(none)		0	0
128	MDF	(IBC) E	129 SF	IBC_Accessory storage areas, mechanical equipment room	300 SF	1	0.2
130	Workroom / Lounge	(IBC) E	607 SF	IBC_Assembly: without fixed seats - Unconcentrated (tables and chairs)	15 SF	41	8.2
132	Flex	(IBC) E	194 SF	IBC_Assembly: without fixed seats - Unconcentrated (tables and chairs)	15 SF	13	2.7
133	Flex	(IBC) E	237 SF	IBC_Assembly: without fixed seats - Unconcentrated (tables and chairs)	15 SF	16	3.3
134	Storage	(IBC) S-1	180 SF	IBC_Accessory storage areas, mechanical equipment room	300 SF	1	0.2
135	Janitor	(none)	73 SF	IBC_Accessory storage areas, mechanical equipment room	300 SF	1	0.1
136	Storage	(IBC) S-1	91 SF	IBC_Accessory storage areas, mechanical equipment room	300 SF	1	0.2
137a	Toilet	(none)	52 SF	(none)		0	0
137b	Toilet	(none)	50 SF	(none)		0	0
: 49			19214 SF			658	131.6
All Purpose Room							
41	All Purpose Room	(IBC) E	3163 SF	IBC_Assembly: without fixed seats - Concentrated (chairs only - not fixed)	7 SF	452	90.5
All Purpose Room: 1			3163 SF			452	90.5
Health Clinic							
42	Health Clinic	(IBC) B	1154 SF	IBC_Business areas	100 SF	12	2.4
Health Clinic: 1			1154 SF			12	2.4
Grand total: 51			23531 SF			1122	224.4

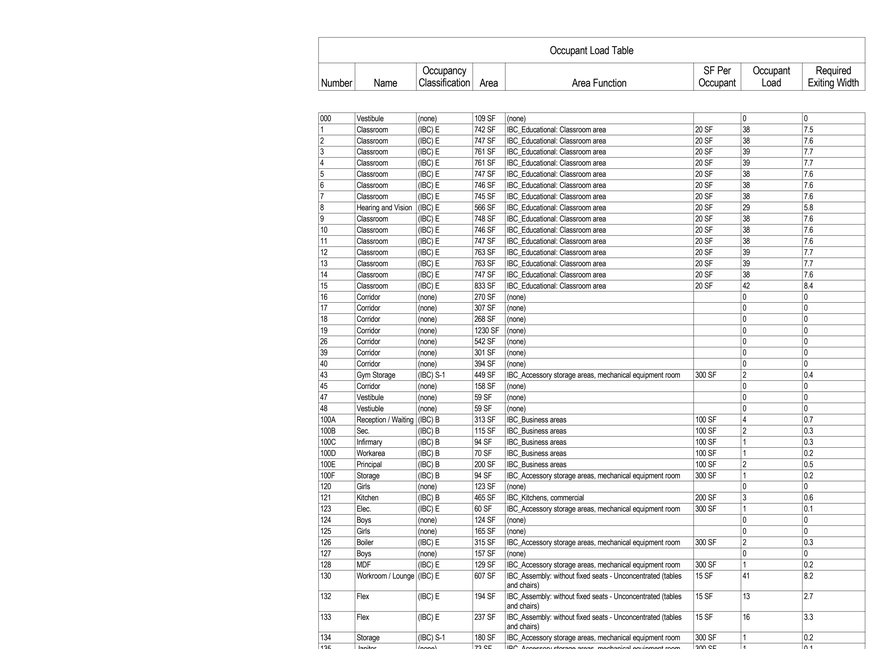

Life Safety Plan
SCALE: 1/16" = 1'-0"

DAO ARCHITECTURE
7230 Meade St.
Westminster, CO 80030
Phone: 720.273.0431
Email: dan@daoarch.com
Web: www.daoarch.com

Rev. #	Description	Rev. Date
1	Addendum 01	11/12/2026
Revision Schedule		

Westminster Public Schools

2026 Bond Projects - ECC Renovations

8030 Irving St.
Westminster, CO 80031

DAO No.: 2025-033

September 25, 2026

Building Code Data

G0.1

Autodesk Docs://WPS 2026 Bond Projects - ECC Renovations/WPS ECC (Revit 2026).rvt
11/12/2026 8:32:36 AM

GENERAL CONSTRUCTION NOTES

1. **COMPLIANCE AND DOCUMENTATION**:
   - ENSURE ALL MATERIALS AND WORKMANSHIP ADHERE TO THE LATEST STANDARDS AND SPECIFICATIONS OF THE RELEVANT AUTHORITY HAVING JURISDICTION, UTILITY DISTRICTS, STATE DEPARTMENT OF TRANSPORTATION, JURISDICTIONAL FIRE PROTECTION REQUIREMENTS, AND ALL APPLICABLE STATE AND LOCAL STANDARDS.
   - CIVIL SPECIFICATION PROVIDED FOR THIS PROJECT SHALL SUPERSEDE ANY CONFLICTS ON THIS PLAN SET.
   - CONTRACTOR SHALL KEEP A SIGNED COPY OF THE APPROVED PLANS, REPORTS, STANDARDS, AND SPECIFICATIONS AT THE JOB SITE AT ALL TIMES. THE CONTRACTOR SHALL MAINTAIN AN ASBUILT REDLINE SET OF PLANS ON THE SITE AT ALL TIMES.
   - CONTRACTOR SHALL MAINTAIN EMERGENCY ACCESS ROUTES AS REQUIRED BY THE JURISDICTIONAL FIRE PROTECTION DISTRICT.
   - OBTAIN WRITTEN APPROVAL FOR ANY VARIANCES FROM THESE DOCUMENTS.
   - NOTIFY THE ENGINEER OF ANY CONFLICTING STANDARDS OR SPECIFICATIONS. IN CASE OF CONFLICTS, THE STRICTER OR HIGHER QUALITY STANDARD WILL APPLY.
2. **PERMITS AND APPROVALS**:
   - THE CONTRACTOR IS RESPONSIBLE FOR ACQUIRING AND ADHERING TO ALL NECESSARY CODES, LICENSES, PERMITS, BONDS, AND STANDARD SPECIFICATIONS REQUIRED FOR THE WORK. THIS INCLUDES LOCAL AND STATE GROUNDWATER DISCHARGE PERMITS.
3. **NOTIFICATIONS**:
   - NOTIFY THE REQUIRED PARTIES (OWNER, OWNER'S REPRESENTATIVE, MUNICIPAL/DISTRICT INSPECTOR, GEOTECHNICAL ENGINEER, ENGINEER, AND/OR UTILITY OWNER) AT LEAST 48 HOURS BEFORE STARTING CONSTRUCTION, PRIOR TO BACKFILLING, AND AS REQUIRED BY JURISDICTIONAL AUTHORITY OR PROJECT SPECIFICATIONS.
4. **UTILITIES**:
   - THE TYPE, SIZE, LOCATION, AND NUMBER OF ALL KNOWN UNDERGROUND UTILITIES IN THE AREA OF CONSTRUCTION HAVE BEEN SHOWN PER FIELD INVESTIGATION BY OTHERS AND AVAILABLE UTILITY RECORDS AND ARE APPROXIMATE ONLY. THE CONTRACTOR SHALL CONTACT THE UTILITY NOTIFICATION CENTER A MINIMUM OF 24 HOURS BEFORE PUTTING A TOOL TO EARTH. IT SHALL BE THE RESPONSIBILITY OF THE CONTRACTOR TO VERIFY THE EXISTENCE AND LOCATION OF ALL UNDERGROUND UTILITIES, SHOWN OR NOT SHOWN ON THESE PLANS, ALONG THE ROUTE OF WORK AND TO COORDINATE CONSTRUCTION SCHEDULES WITH THE UTILITY OWNERS AND TO SCHEDULE UTILITY ADJUSTMENTS TO ELIMINATE CONFLICT WITH PROGRESS OF THE WORK. THE CONTRACTOR SHALL NOTE ALL UTILITIES MAY NOT APPEAR ON THESE PLANS AND THAT THE POTENTIAL CONFLICT WITH UTILITIES SHALL BE CONSIDERED IN THE PREPARATION OF ANY BIDS. THE CONTRACTOR SHALL BE RESPONSIBLE FOR THE PROTECTION OF ALL UTILITIES WHETHER SHOWN ON THE PLANS OR NOT AND SHALL HOLD THE OWNERS AND THE ENGINEER HARMLESS FOR DAMAGE ARISING FROM FAILURE TO ADEQUATELY PROTECT UTILITIES.
   - VERIFY THE EXACT SIZE, LOCATION, AND TYPE OF ALL EXISTING UTILITIES BEFORE STARTING WORK.
   - THE CONTRACTOR IS SOLELY RESPONSIBLE FOR ANY DAMAGE AND COSTS DUE TO FAILURE TO LOCATE AND PRESERVE UTILITIES.
   - NOTIFY PUBLIC AND PRIVATE UTILITY COMPANIES TO DETERMINE THE LOCATION OF ALL EXISTING UTILITIES BEFORE GRADING AND CONSTRUCTION.
   - PERFORM AND INSPECT ALL WORK IN UTILITY AREAS ACCORDING TO THE UTILITY OWNER'S REQUIREMENTS.
   - OBTAIN APPROVAL FROM THE MUNICIPALITY/UTILITY OWNER AND ENGINEER BEFORE RELOCATING ANY ENCOUNTERED UTILITIES.
   - ENSURE ALL SERVICE CONNECTIONS AND RELOCATIONS ARE COORDINATED WITH THE UTILITY OWNER AND ENGINEER.
   - IMMEDIATELY NOTIFY THE ENGINEER OF ANY UTILITY DISCREPANCIES OR CONFLICTS.
5. **SITE CONDITIONS AND SAFETY**:
   - THE CONTRACTOR IS SOLELY RESPONSIBLE FOR THE JOB SITE CONDITIONS, INCLUDING SAFETY DURING THE WORK. CONTRACTOR AGREES THAT HE SHALL ASSUME SOLE AND COMPLETE RESPONSIBILITY FOR JOB SITE CONDITIONS DURING THE COURSE OF PROJECT CONSTRUCTION, INCLUDING SAFETY OF ALL PERSONS AND PROPERTY. THIS REQUIREMENT SHALL APPLY CONTINUOUSLY AND NOT BE LIMITED TO NORMAL WORKING HOURS AND THAT THE CONTRACTOR SHALL DEFEND, INDEMNIFY AND HOLD HARMLESS FROM ALL LIABILITY, REAL OR ALLEGED, IN CONNECTION WITH THE PERFORMANCE OF WORK.
   - PREPARE A TRAFFIC CONTROL PLAN FOR APPROVAL AND PROVIDE ALL NECESSARY DEVICES FOR PUBLIC SAFETY.
   - COMPLY WITH THE TRAFFIC CONTROL PLAN AND THE "MANUAL ON UNIFORM TRAFFIC CONTROL DEVICES" (MUTCD) FOR CONSTRUCTION SIGNAGE AND TRAFFIC CONTROL.
6. **GROUNDWATER MANAGEMENT**:
   - THE CONTRACTOR SHALL BE RESPONSIBLE TO REMOVE ANY ENCOUNTERED GROUNDWATER DURING CONSTRUCTION IN A MANNER THAT PREVENTS FLOODING OR EROSION AND APPLIES TO ALL STATE AND LOCAL GROUNDWATER DISCHARGE PERMIT REQUIREMENTS.
7. **ELEVATION CALLOUTS AND ADJUSTMENTS**:
   - ADJUST RIMS, COVERS AND GRATE ELEVATIONS TO MATCH THE FINAL PAVEMENT AND FINISHED GRADE ELEVATIONS, REGARDLESS OF ELEVATIONS SHOWN ON PLANS.
   - THE EXISTING AND PROPOSED ELEVATIONS SHOWN ON THE PLANS ARE BASED ON EXTRAPOLATED FIELD SURVEY INFORMATION PROVIDED BY OTHERS. CONTRACTOR SHALL CONFIRM ALL ELEVATIONS AT JOINS TO EXISTING FEATURES INCLUDING PAVING, PIPING, FLATWORK, EARTHWORK GRADING, ETC. PRIOR TO CONSTRUCTION. ANY DISCREPANCIES IN ELEVATIONS FROM THOSE SHOWN ON THE PLANS SHALL BE BROUGHT TO THE ENGINEERS ATTENTION PRIOR TO CONSTRUCTION. ALL FLATWORK MUST PREVENT PONDING AND PROVIDE POSITIVE DRAINAGE AWAY FROM STRUCTURES, EQUIPMENT, ETC. TOWARDS THE INTENDED DRAINAGE FEATURE.
   - FLOW LINE ELEVATION NOTES: ELEVATIONS AT INLETS CALLED OUT AS FLOW LINE (FL) ARE THE PROJECTION OF THE CURB FLOW LINE AND DO NOT TAKE INTO ACCOUNT THE LOCALIZED DEPRESSION OF THE INLET. CONTRACTOR IS RESPONSIBLE TO STAKE THE INLET CORRECTLY BASED OFF THE ADJUSTMENT NEEDED BETWEEN THE "FL" ELEVATION AND THE ACTUAL FLOW LINE AT THE LOCAL DEPRESSION FOR THE SPECIFIC INLET CALLED OUT.
   - RETAINING WALL ELEVATION NOTES: UNLESS OTHERWISE NOTED, ALL ELEVATIONS CALLED OUT ALONG RETAINING WALLS ARE THE FINISHED GROUND ELEVATION AT THE FACE OF WALL, FRONT AND BACK, AND NOT THE WALL ELEVATION ITSELF.
8. **FLATWORK AND DRAINAGE**:
   - OBTAIN APPROVAL FOR FORMWORK AT CRITICAL AREAS BEFORE PLACING CONCRETE.
9. **ASPHALT WORK**:
   - PROVIDE SAWCUTTING AND PATCHING TO ACHIEVE POSITIVE DRAINAGE AND SMOOTH TRANSITIONS TO EXISTING ASPHALT WITHIN ACCEPTABLE SLOPES.
   - ADDITIONAL SAWCUTTING AND PATCHING MAY BE REQUIRED AT UTILITY WORK AND CONNECTION POINTS.
10. **PROTECTION OF EXISTING FEATURES**:
    - PROTECT AND MAINTAIN EXISTING MONITORING WELLS, CLEANOUTS, VALVE BOXES, ETC. EXTEND OR LOWER FEATURES TO FINAL SURFACE LEVEL WITH APPROPRIATE CAPS AND LIDS.
    - PROVIDE A CONCRETE COLLAR FOR ALL EXISTING AND PROPOSED MONITORING WELLS, CLEANOUTS, VALVE BOXES, ETC., IN LANDSCAPED AREAS.
11. **CONCRETE WORK**:
    - OBTAIN OWNER APPROVAL FOR PRIVATE CONCRETE FINISHING, JOINT PATTERNS, AND COLORING BEFORE CONSTRUCTION. SUBMIT A JOINT LAYOUT PLAN FOR APPROVAL.
12. **PIPE LENGTHS AND CONTROL POINTS**:
    - ADJUST PIPE LENGTHS TO ACCOUNT FOR STRUCTURES AND FLARED END SECTIONS BASED ON THE STRUCTURE DETAILS.
    - PIPE LENGTHS SHOWN ON PLANS ARE TO THE CENTER OF STRUCTURE. PIPE LENGTHS SHOWN ON PLANS CONNECTED TO FLARED END SECTIONS (FES) AND HEADWALLS INCLUDE THE FULL LENGTH OF FES AND HEADWALLS AND SHOULD BE ADJUSTED ACCORDINGLY.
13. **SITE CLEANUP**:
    - REMOVE ALL SURPLUS MATERIALS, TOOLS, TEMPORARY STRUCTURES, DEBRIS, AND RUBBISH CAUSED BY CONSTRUCTION. RESTORE THE AREA TO ITS ORIGINAL CONDITION WITHIN 48 HOURS OF PROJECT COMPLETION UNLESS DIRECTED OTHERWISE.
14. **EROSION AND SEDIMENT CONTROL**:
    - IMPLEMENT AND MAINTAIN EROSION AND SEDIMENT CONTROL MEASURES IN ACCORDANCE WITH LOCAL AND STATE GUIDELINES.
    - PROHIBIT SILT AND DEBRIS-LADEN RUNOFF FROM LEAVING THE SITE AND KEEP PUBLIC AREAS FREE OF MUD AND DEBRIS.
    - RE-ESTABLISH FINAL GRADES AND REMOVE ACCUMULATED SEDIMENTATION FROM ALL AREAS, INCLUDING SWALES, PIPES, INLETS, CURBS AND DETENTION/WATER QUALITY AREAS.
    - REMOVE TEMPORARY EROSION CONTROL MEASURES AND REPAIR AREAS AFTER VEGETATION IS ESTABLISHED AND ACCEPTED BY THE OWNER AND MUNICIPALITY.
15. **TREE AND VEGETATION PROTECTION**:
    - PROTECT ALL TREES AND VEGETATION BY PLACING CONSTRUCTION FENCING AT THE DRIP LINE OF TREES AND PLANTS NEAR THE WORK ZONE. HAND EXCAVATION IS REQUIRED AT ROOT ZONES WHERE PROPOSED PAVING OR UTILITY WORK IS WITHIN THE DRIPLINE OF TREES.
16. **ASBUILTS**
    - THE CONTRACTOR, AT THE CONTRACTOR'S EXPENSE, SHALL PROVIDE THE OWNER AND ENGINEER OF RECORD A COMPLETE SET OF CONSTRUCTION RECORD DRAWINGS (ASBUILTS) FOR ALL CONSTRUCTED IMPROVEMENTS, IF REQUIRED BY THE OWNER OR AHJ. THE ASBUILT SET SHALL SHOW SUFFICIENT DIMENSION TIES TO PERMANENT SURFACE FEATURES OR NORTHING/EASTING POINTS FOR ALL BURIED FACILITIES TO ALLOW FOR FUTURE LOCATING. THE ASBUILT SET SHALL SHOW ALL APPLICABLE ASBUILT IMPROVEMENTS INCLUDING BUT NOT LIMITED TO: CONTOURS, ELEVATIONS OF ALL FLATWORK, FLOWLINES, GRADE BREAKS, CROSS SLOPES AND ANY OTHER ELEVATIONS TO DEMONSTRATE COMPLIANCE WITH THE PLANS. ALL POND FEATURES INCLUDING TOP, BOTTOM AND GRADE BREAKS, OUTLET FEATURES INCLUDING TOP AND BOTTOM OF OUTLET STRUCTURE, PERFORATION SIZES AND ELEVATIONS ABOVE INVERT, PIPE INVERTS, ETC. ASBUILTS SHALL BE PREPARED BY A PLS.

TOPSOIL NOTE:

- TOPSOIL IS DEFINED AS FERTILE, FRIABLE, NATURAL LOAM, SURFACE SOIL, REASONABLY FREE OF SUBSOIL, CLAY LUMPS, BRUSH, WEEDS, AND OTHER LITTER, AND FREE OF ROCKS, STUMPS, STONES LARGER THAN 2 INCHES IN ANY DIMENSION, AND OTHER EXTRANEOUS OR TOXIC MATTER HARMFUL TO PLANT GROWTH FOR AREAS TO BE SEEDED OR PLANTED. COORDINATE TESTING REQUIREMENTS WITH ENGINEER AND OWNER.
- ALL TOPSOIL SCRAPED FROM THE SITE IS TO BE STOCKPILED AND REDISTRIBUTED AFTER FINAL GRADING IS COMPLETE.
- CLEAN TOPSOIL FREE OF PLANTS AND SEEDS WILL BE SPREAD TO 4-INCH MINIMUM DEPTH OR AS SPECIFIED BY DRAWINGS, WHICHEVER IS GREATER, PRIOR TO SEEDING. ALL DISTURBED AREAS THAT WILL NOT BE PAVED OR OTHERWISE HAVE PERMANENT EROSION MEASURES ESTABLISHED SHALL HAVE CLEAN TOPSOIL SPREAD TO AN EVEN 4-INCH MINIMUM DEPTH UNLESS SPECIFIED OTHERWISE. IN NO CASE SHALL BARE EARTH REMAIN AT THE CONCLUSION OF CONSTRUCTION.

PROJECT COORDINATES:

- SURVEY INFORMATION PROVIDED BY ENGINEERING SERVICE COMPANY(ESC). SEE DESIGN TOPOGRAPHIC SURVEY DATED 10/16/26
- BENCHMARK INFORMATION:

  BENCHMARK: NGS BENCHMARK DESIGNATION Z 452. STAINLESS STEEL ROD SET IN A 5- INCH PVC WITH LOGO LID, STAMPED "Z452 2003" AND SURROUNDED BY A CONCRETE COLLAR, 214 FEET WEST FROM THE CENTERLINE OF FEDERAL BOULEVARD, 90 FEET NORTH FROM SOUTHWEST END OF THE CURB AND SOUND-BARRIER WALL, 3.1 FEET SOUTH FROM A GREEN CARSONITE WITNESS POST.
  - ELEVATION = 5392.96 FEET (NAVD 1988 DATUM)
  - THE CONTOURS SHOWN HEREON ARE AT ONE (1) FOOT INTERVALS

	Sheet Index
Sheet Number	Sheet Title
C001	GENERAL NOTES
C100	DEMOLITION PLAN
C300	GRADING & DRAINAGE PLAN
CD301	DRAINAGE DETAILS
C500	HORIZONTAL CONTROL PLAN
CD501	HORIZONTAL CONTROL PLAN DETAILS

GENERAL ABBREVIATIONS

AASHTO	AMERICAN ASSOC. OF STATE HIGHWAY AND TRANSPORTATION OFFICIALS	CLR	CLEAR	FES	FLARED END SECTION	IRR	IRRIGATION	PCR	POINT OF CURVE RETURN	SQ FT	SQUARE FOOT
		CMP	CORRUGATED METAL PIPE	FF	FINISH FLOOR	JTS	JOINTS	PI	POINT OF INTERSECTION	SQ YD	SQUARE YARD
ABAN	ABANDON	CMU	CONCRETE MASONRY UNIT	FG	FINISH GRADE			PVI	POINT OF VERTICAL INTERSECTION	SS	SANITARY SEWER
AC	ASPHALTIC CONCRETE PAVING	CO	CLEANOUT	FH	FIRE HYDRANT	KO	KNOCKOUT	PL	PROPERTY LINE	SST	STAINLESS STEEL
ADDL	ADDITIONAL	CONC	CONCRETE	FL	FLOW LINE	KPL	KICK PLATE	PE	POLYETHYLENE	STA	STATION
ADDM	ADDENDUM	CONST	CONSTRUCTION	FN	FENCE	KWY	KEYWAY	PREFAB	PREFABRICATED	STD	STANDARD
ADJ	ADJUSTABLE	CONT	CONTINUOUS	FOC	FACE OF CONCRETE			PRELIM	PRELIMINARY	STL	STEEL
AL	ALUMINUM	CR	CONCENTRIC REDUCER	FPM	FEET PER MINUTE	L	LEFT OR LITER	PREP	PREPARATION	STRUCT	STRUCTURAL
ALT	ALTERNATE	CTR	CENTER	FPS	FEET PER SECOND	LSCAPE	LANDSCAPE(ING)	PROP	PROPOSED	SVC	SERVICE
AMT	AMOUNT	CY	CUBIC YARDS	FT	FEET	LF	LINEAR FOOT	PRV	PRESSURE REDUCING VALVE OR PRESSURE RELIEF VALVE	SWMP	STORMWATER MANAGEMENT PLAN
APPROX	APPROXIMATE			FTG	FOOTING OR FITTING	LP	LOW POINT OR LIGHT POLE			SWPPP	STORMWATER POLLUTION PREVENTION PLAN
ARCH	ARCHITECTURAL)	DEMO	DEMOLITION			LT	LIGHT	PSF	POUNDS PER SQUARE FOOT	SYM	SYMMETRICAL
ARV	AIR RELIEF VALVE	DET	DETAIL	G	GAS	LWL	LOW WATER LEVEL	PSI	POUNDS PER SQUARE INCH		
ASTM	AMERICAN SOCIETY FOR TESTING AND MATERIALS	DIA	DIAMETER	GA	GAUGE			PT	POINT OF TANGENCY	TB	THRUST BLOCK
ASPH	ASPHALT	DIAG	DIAGONAL	GAL	GALLON	MAINT	MAINTENANCE	PV	PLUG VALVE	TBC	TOP BACK OF CURB
ASSY	ASSEMBLY	DIP	DUCTILE IRON PIPE	GALV	GALVANIZED	MAN	MANUAL	PVC	POLYVINYL CHLORIDE OR POINT OF VERTICAL CURVATURE	TEMP	TEMPORARY
ASYM	ASYMMETRICAL	DOM	DOMESTIC	GB	GRADE BREAK	MATL	MATERIAL			TG	FINISHED GRADE ADJACENT TO TOP OF WALL
AUTO	AUTOMATIC	DN	DOWN	GIP	GALVANIZED IRON PIPE	MAX	MAXIMUM	PVMT	PAVEMENT	THK	THICK
AVG	AVERAGE	DWG	DRAWING	GND	GROUND	ME	MATCH EXISTING			TOB	TOP OF BANK
AWWA	AMERICAN WATER WORKS ASSOC.			GPD	GALLONS PER DAY	MECH	MECHANICAL	QTY	QUANTITY	TOC	TOP OF CONCRETE OR TOP OF CURB
		E	EAST	GPM	GALLONS PER MINUTE	MEP	MECHANICAL, ELECTRICAL, PLUMBING (ARCH)			TOS	TOP OF STEP
BC	BACK OF CURB	EA	EACH	GR	GRATE	MFR	MANUFACTURER			TOT	TOTAL
BFV	BUTTERFLY VALVE	ECC	ECCENTRIC	GRTG	GRATING	MH	MANHOLE			TW	TOP OF WALL OR CAP OF WALL
BG	FINISHED GRADE ADJACENT TO BOTTOM OF WALL	EJ	EXPANSION JT	GSP	GALVANIZED STEEL PIPE	MIN	MINIMUM	R	RIGHT	TYP	TYPICAL
BLDG	BUILDING	EL	ELEVATION	GV	GATE VALVE	MISC	MISCELLANEOUS	RAD	RADIUS		
BLK	BLOCK	ELB	ELBOW			MJ	MECHANICAL JOINT	RCP	REINFORCED CONCRETE PIPE	UBC	UNIFORM BUILDING CODE
BM	BENCH MARK	ELEC	ELECTRICAL	H	HIGH			RD	ROOF DRAIN	UGE	UNDERGROUND ELECTRIC
BMP	BEST MANAGEMENT PRACTICE	ENGR	ENGINEER	HDWL	HEADWALL	N	NORTH	RE	REFERENCE	UTIL	UTILITY
BS	BACKSIGHT	EOP	EDGE OF PAVEMENT	HNDRL	HAND RAIL	NA	NOT APPLICABLE	RECT	RECTANGULAR	VERT	VERTICAL
BOS	BOTTOM OF STEP	EQ	EQUAL	HORIZ	HORIZONTAL	NIC	NOT IN CONTRACT	REINF	REINFORCE (D) (ING) (MENT)	VC	POINT OF VERTICAL CURVATURE
BOT	BOTTOM	EQUIP	EQUIPMENT	HP	HIGH POINT	NPT	NATIONAL PIPE THREAD	REQD	REQUIRED	VCP	VITRIFIED CLAY PIPE
BSMT	BASEMENT	EQUIV	EQUIVALENT	HR	HOUR	NTS	NOT TO SCALE	ROW	RIGHT OF WAY		
BVCE	BEGIN VERTICAL CURVE ELEVATION	ESMT	EASEMENT	HVAC	HEATING, VENTILATION, AIR CONDITIONING					W	WIDE OR WIDTH
BVCS	BEGIN VERTICAL CURVE STATION	EST	ESTIMATE	HWY	HIGHWAY	OS	OFFSET	SAN	SANITARY	W/	WITH
BW	BOTTOM OF WALL	EVCE	END VERTICAL CURVE ELEVATION	HWL	HIGH WATER LINE	OC	ON CENTER	SC	SAWCUT	W/O	WITHOUT
		EVCS	END VERTICAL CURVE STATION	HYD	HYDRANT	OD	OUTSIDE DIAMETER	SD	STORM DRAIN	WQCV	WATER QUALITY CONTROL VOLUME
CB	CATCH BASIN	EW	EACH WAY			OPP	OPPOSITE	SECT	SECTION	WSE	WATER SURFACE ELEVATION
CDOT	COLORADO DEPARTMENT OF TRANSPORTATION	EXP	JT EXPANSION JOINT	INCL	INCLUDED	OPT	OPTIONAL	SPD	STANDARD PROCTOR DENSITY	WW	WASTEWATER
CIP	CAST IRON PIPE	EXIST	EXISTING	ID	INSIDE DIAMETER			SPEC	SPECIFICATION		
CJ	CONSTRUCTION JOINT			IN	INLET	PC	POINT OF CURVATURE	SQ	SQUARE	X	SECT CROSS SECTION
CL	CENTER LINE	FND	FOUNDATION	INV	INVERT	PCO	PRESSURE CLEAN OUT	SQ IN	SQUARE INCH	XFMR	ELECTRICAL TRANSFORMER

DAO ARCHITECTURE

7230 Meade St.
Westminster, CO 80030

Phone: 720.273.0431
Email: dan@daoarch.com
Web: www.daoarch.com

CONTERRA ENGINEERING

242 Linden Street # 5943
Fort Collins, CO 80524

Phone: 720.689.5806
Email: info@conterraeng.com
Web: www.conterraeng.com

Westminster Public Schools

E.C.C. GYM INFILTRATION RENO


8030 Irving St.
Westminster, CO 80031

DAO No.: 2019-001

November 12, 2026

GENERAL NOTES

C001

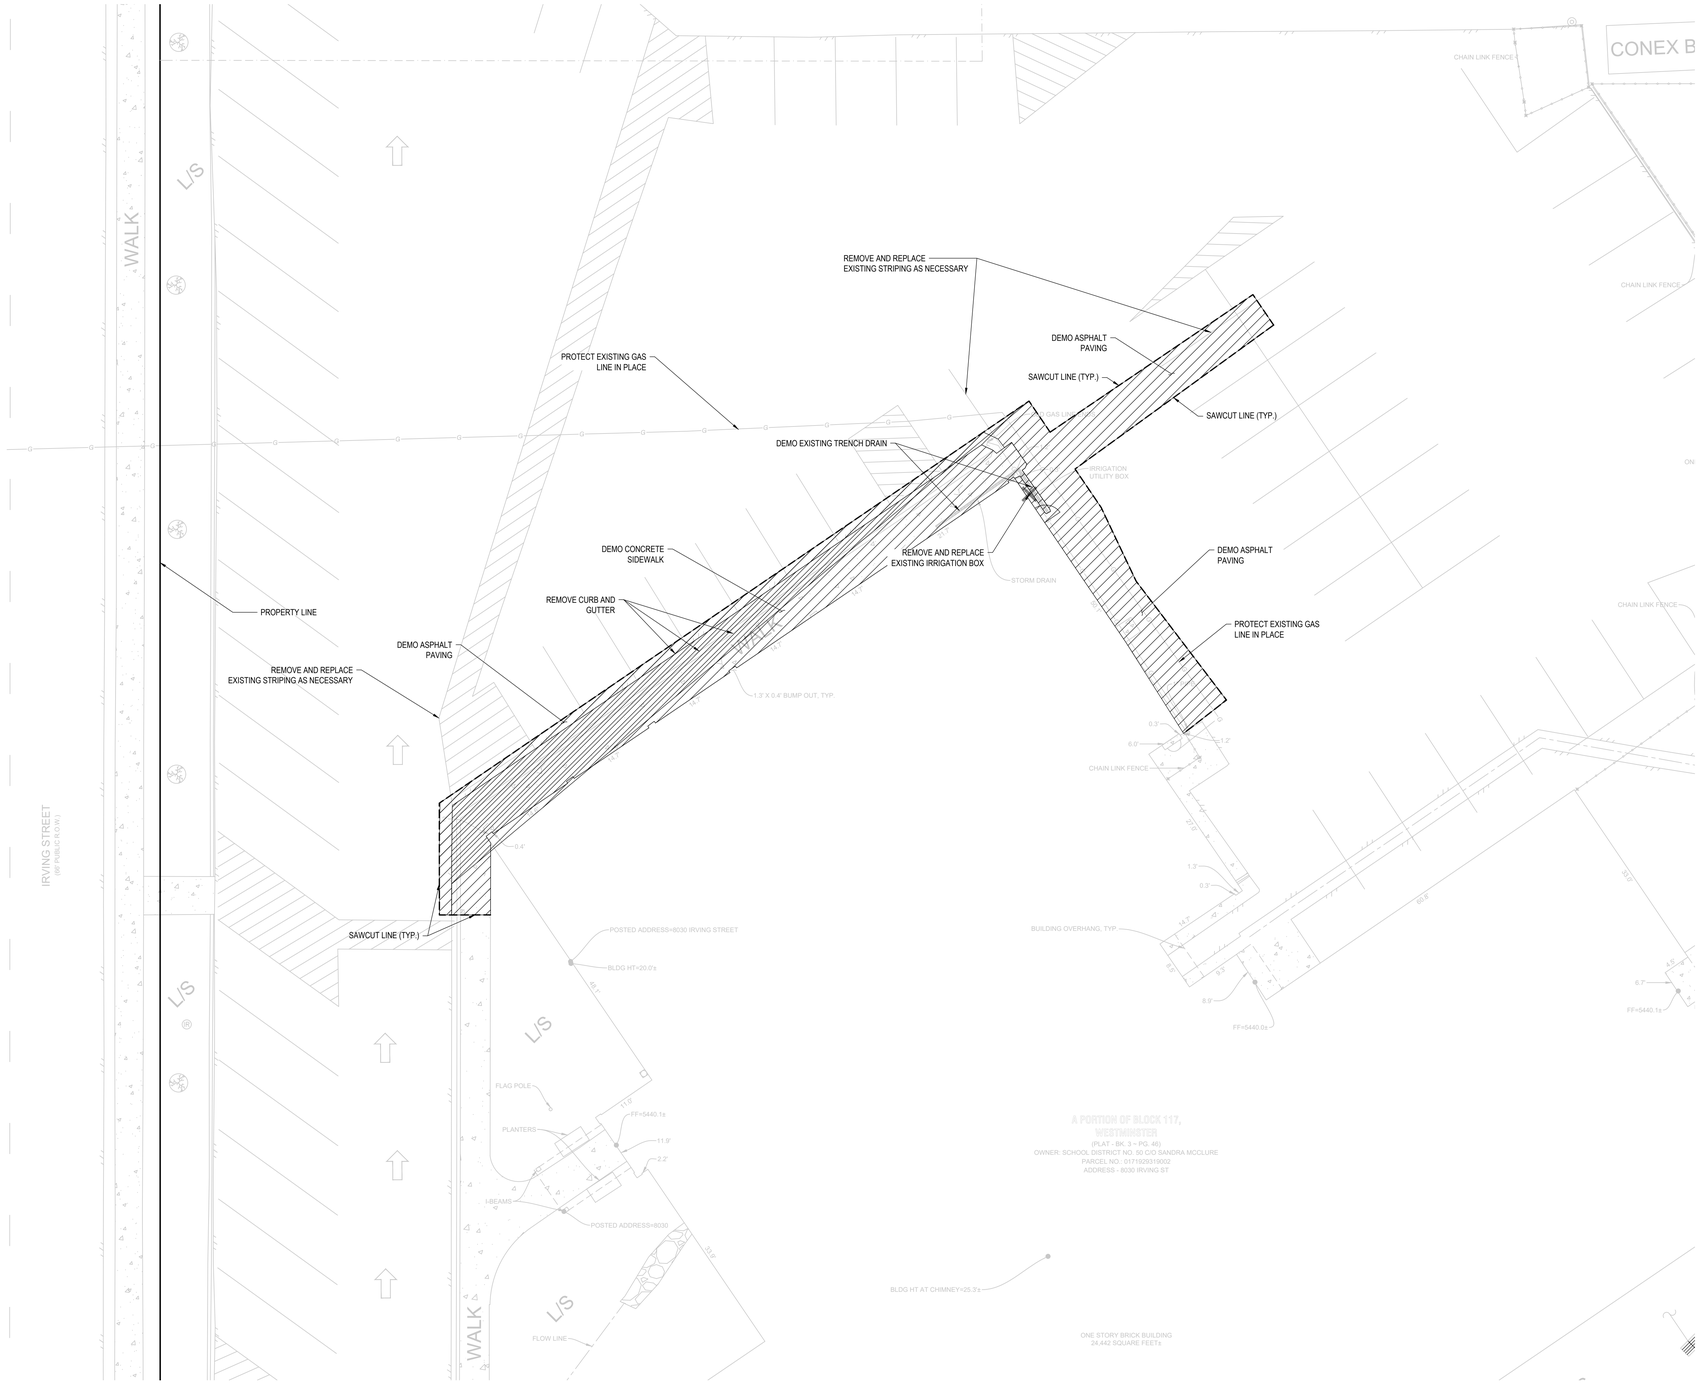

DEMOLITION LEGEND

- SURFACE DEMO
- SUBSURFACE DEMO
- ABANDON SUBSURFACE FEATURE
- PAVEMENT DEMO
- SAWCUT LINE
- SURFACE DEMO

DEMOLITION NOTES

1. DEMOLITION LIMITS MAY VARY — COORDINATE WITH THE OWNER, ARCHITECT, AND ENGINEER TO ADJUST BOUNDARIES, PROTECT ITEMS TO REMAIN (FENCING, TREES, ETC.), AND PHASE THE WORK APPROPRIATELY.
2. REFER TO ARCHITECTURAL PLANS FOR BUILDING LIMITS, MODULAR CLASSROOM REMOVAL, AND SALVAGING SITE FURNISHINGS. CIVIL AND BUILDING DEMOLITION MUST BE COORDINATED TOGETHER.
3. ALL REQUIRED EROSION AND SEDIMENT CONTROL MEASURES MUST BE IN PLACE BEFORE CONSTRUCTION STARTS.
4. CONTRACTOR MUST VERIFY ALL UNDERGROUND UTILITIES BEFORE WORK BEGINS. SEE GENERAL CONSTRUCTION NOTES FOR UTILITY INFO AND SAFETY PRECAUTIONS.
5. COORDINATE ANY DRY UTILITY OR ELECTRICAL DEMOLITION OR RELOCATION WITH THE OWNER, UTILITY PROVIDER, MECHANICAL ENGINEER, AND ARCHITECT.
6. REFER TO GENERAL CONSTRUCTION NOTES AND COORDINATE WITH LANDSCAPE ARCHITECT FOR ANY REQUIRED TREE PROTECTION OR REMOVAL.
7. REPLACE FLATWORK AT UTILITY TRENCHES. SAWCUTTING AND PAVEMENT REMOVAL MUST BE CLEAN AND EXTEND TO THE NEAREST JOINT.
8. COMPLY WITH ALL REGULATIONS FOR HAZARDOUS MATERIAL HANDLING AND DISPOSAL. SEPARATE ABATEMENT COORDINATION AND SCHEDULES MAY BE REQUIRED.
9. MAINTAIN SAFE PEDESTRIAN ROUTES DURING WORK. PROVIDE TEMPORARY SIGNAGE AND PATHWAYS AS NEEDED.
10. ANY UNINTENTIONAL DAMAGE TO SITE ELEMENTS NOT DESIGNATED FOR DEMOLITION MUST BE REPAIRED OR REPLACED BY THE CONTRACTOR.
11. TAKE NECESSARY PRECAUTIONS TO AVOID DISRUPTING EXISTING UTILITIES OR SERVICES DURING CONSTRUCTION.

N

10 0 10 20
SCALE IN FEET

DAO ARCHITECTURE
7230 Meade St.
Westminster, CO 80030
Phone: 720.273.0431
Email: dan@daoarch.com
Web: www.daoarch.com

CONTERRA ENGINEERING
242 Linden Street # 5943
Fort Collins, CO 80524
Phone: 720.689.5806
Email: info@conterraeng.com
Web: www.conterraeng.com

Westminster Public Schools

E.C.C. GYM INFILTRATION RENO

8030 Irving St.
Westminster, CO 80031

DAO No.: 2019-001

November 12, 2026

DEMOLITION PLAN

C100



GENERAL LEGEND

- PROPERTY LINE
- EASEMENT
- EX MINOR CONTOUR
- EX MAJOR CONTOUR
- PR MINOR CONTOUR
- PR MAJOR CONTOUR
- EX SPOT ELEVATION
- PR SPOT ELEVATION
- SLOPE ARROW
- SAWCUT LINE
- FENCE
- GRADE BREAK LINE
- FLOW LINE
- CURB AND GUTTER
- ASPHALT PAVING
- CONCRETE PAVING
- GRAVEL
- BUILDING
- SIGN POST
- STORM DRAIN
- STORM INLET
- FLARED END SECTION (FES)
- SANITARY SEWER
- CLEAN OUT
- MANHOLE
- ELECTRIC LINE
- GAS LINE
- WATERLINE
- HYDRANT
- BENDS
- GATE VALVE

DRY WELL NOTES

1. THE DRY WELL IS TO BE SURROUNDED BY CLEAN, WASHED 3/4" TO 2" CRUSHED ROCK, COMPACTED PER SPECIFICATIONS AND A MINIMUM WIDTH OF 24" THE ENTIRE HEIGHT OF THE RING. EXTEND 18" BELOW BOTTOM RING.
2. THE CRUSHED ROCK AND DRY WELL IS TO BE SURROUNDED BY A NONWOVEN GEOTEXILE FABRIC, MIRAFI 140N OR EQUIVALENT.
3. PROVIDE EXTRA ADJUSTING RINGS TO ALLOW FOR FINAL ADJUSTMENT OF RIM ELEVATION TO FINAL FINISHED GRADE.
4. FINAL DEPTH OF DRY WELL IS DEPENDANT ON GEOTECHNICAL INVESTIGATION OF DRAINAGE LAYER IN THE SOIL. ASSUME DEPTH SHOWN AS MINIMUM.

DAO ARCHITECTURE
7230 Meade St.
Westminster, CO 80030
Phone: 720.273.0431
Email: dan@daoarch.com
Web: www.daoarch.com

CONTERRA ENGINEERING
242 Linden Street # 5943
Fort Collins, CO 80524
Phone: 720.689.5806
Email: info@conterraeng.com
Web: www.conterraeng.com

Westminster Public Schools

E.C.C. GYM INFILTRATION RENO

8030 Irving St.
Westminster, CO 80031


DAO No.: 2019-001

November 12, 2026

GRADING & DRAINAGE PLAN

C300

48" DRYWELL MANHOLE

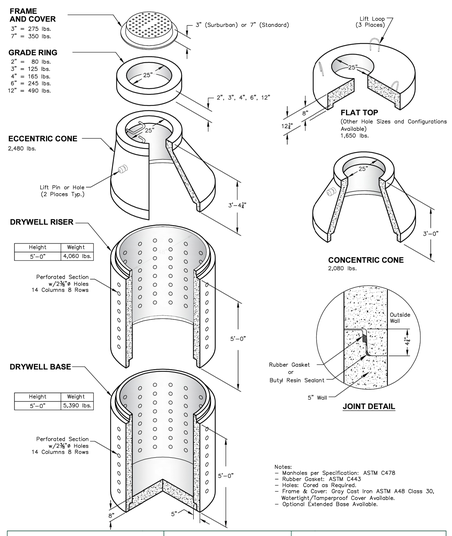


Oldcastle Precast®	48" DRYWELL MANHOLE	48" DRYWELL MANHOLE
PO Box 323, Wilsonville, Oregon 97070-0323	File Name: 020-48MH-D	
Tel: (503) 682-2844 Fax: (503) 682-2657	Issue Date: 2018	
	oldcastleprecast.com/wilsonville	

2.0

NOTES:
1. DRY WELL TO BE OLD CASTLE OR APPROVED EQUIVALENT

1 / C300 DRY WELL DETAIL
NOT TO SCALE

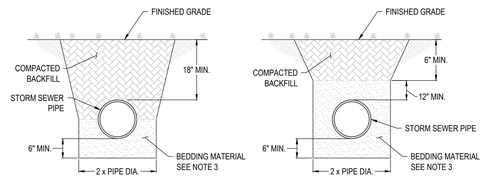

REINFORCED CONCRETE PIPE (RCP) PVC/CMP/HDPE

NOTES:
1. BACKFILL TO BE COMPACTED IN 8" LIFTS MAX.
2. SEE PLANS FOR PIPE DETAILS (SIZE, SLOPE, MATERIAL, LENGTH, ETC.)
3. SEE SPECIFICATION FOR BEDDING MATERIAL. BEDDING MATERIAL TO BE COMPACTED TO 95% OF THE STANDARD PROCTOR MAX DRY DENSITY.
4. REMOVE UNSUITABLE SOILS AND BACKFILL WITH MATERIALS APPROVED BY ENGINEER.

2 / C300 STORM SEWER TRENCH DETAIL
NOT TO SCALE

DAO ARCHITECTURE
7230 Meade St.
Westminster, CO 80030
Phone: 720.273.0431
Email: dan@daoarch.com
Web: www.daoarch.com

CONTERRA ENGINEERING
242 Linden Street # 5943
Fort Collins, CO 80524
Phone: 720.689.5806
Email: info@conterraeng.com
Web: www.conterraeng.com

Westminster Public Schools

E.C.C. GYM INFILTRATION RENO


8030 Irving St.
Westminster, CO 80031

DAO No.: 2019-001

November 12, 2026

DRAINAGE DETAILS

CD301

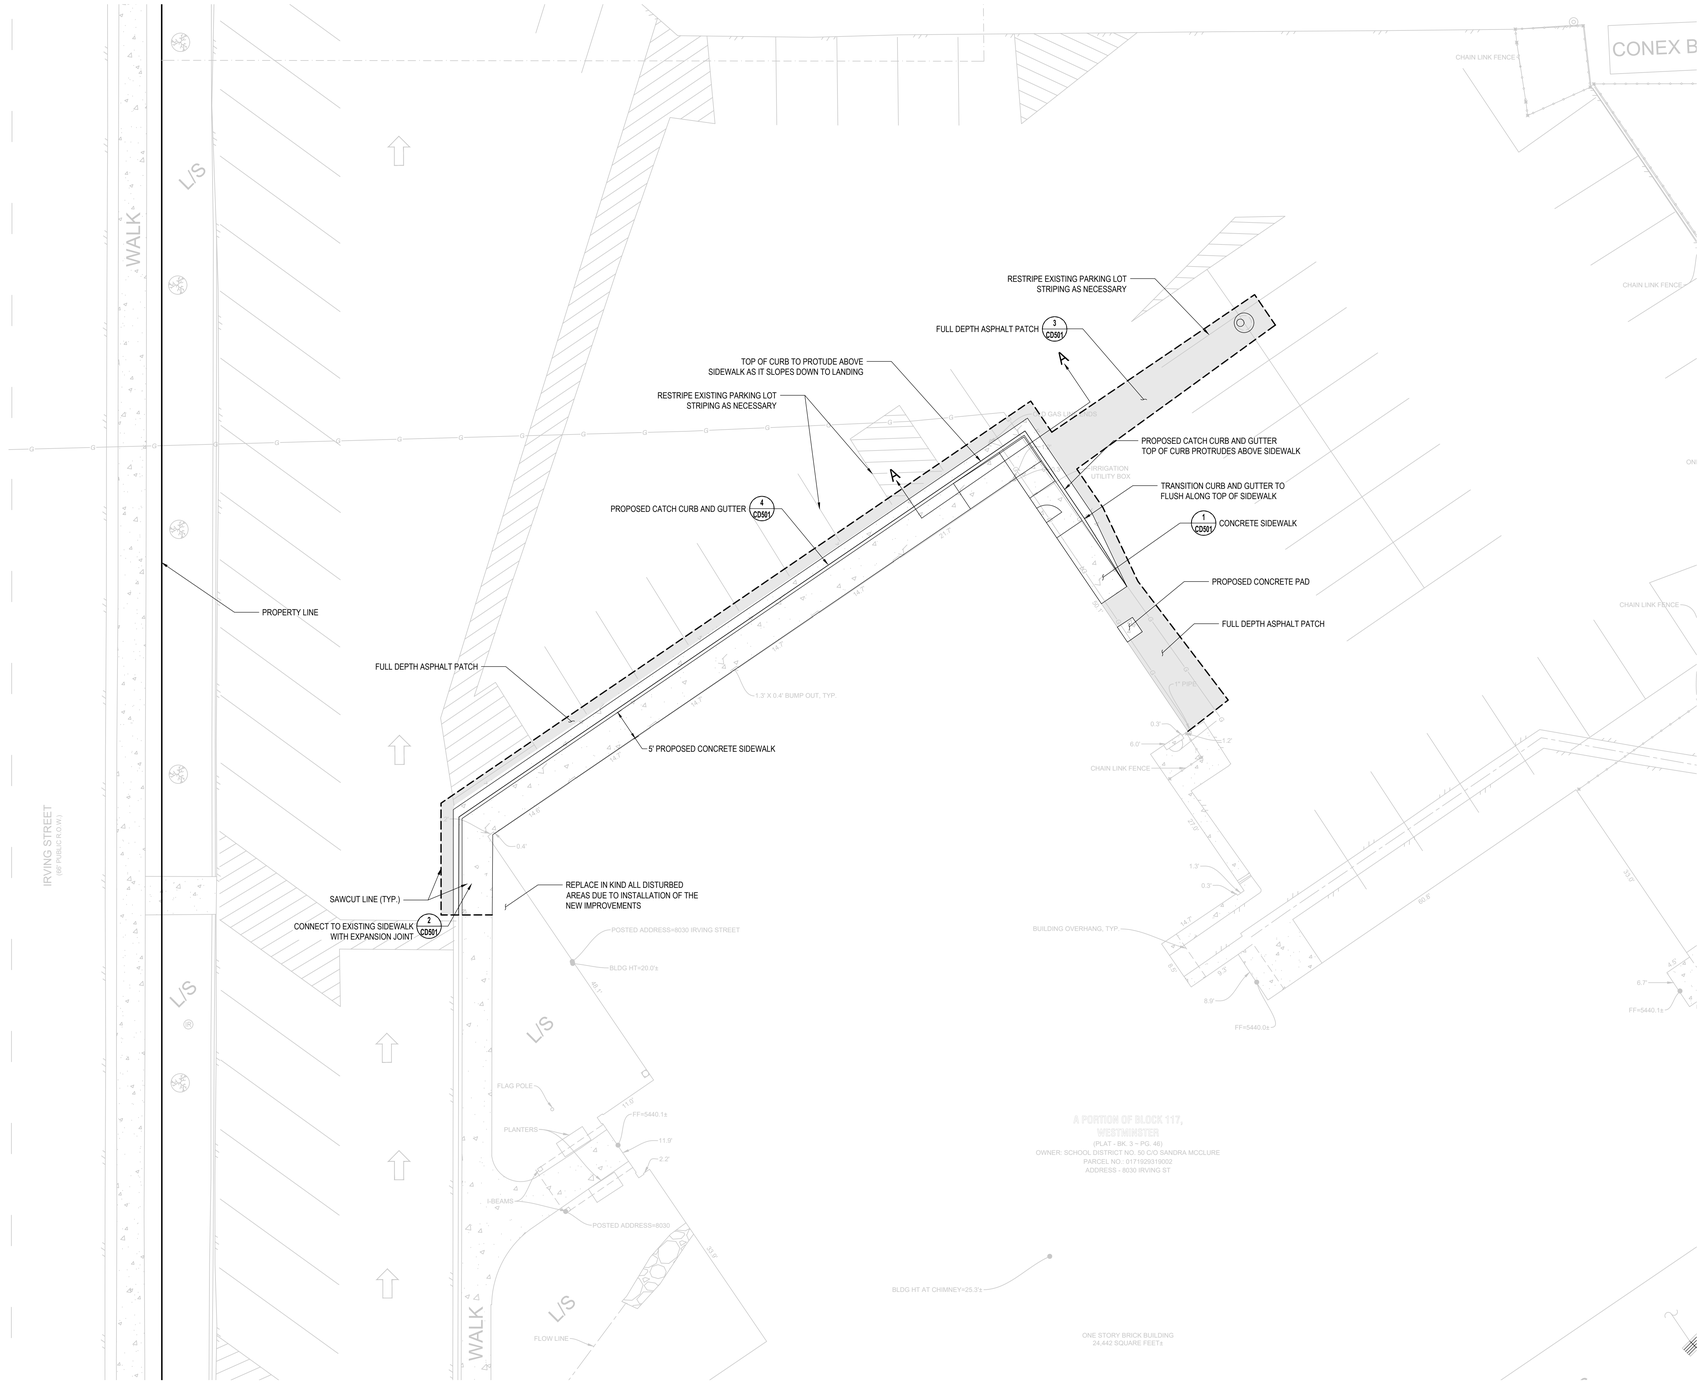

GENERAL LEGEND

- PROPERTY LINE
- EASEMENT
- EX MINOR CONTOUR
- EX MAJOR CONTOUR
- PR MINOR CONTOUR
- PR MAJOR CONTOUR
- EX SPOT ELEVATION
- PR SPOT ELEVATION
- SLOPE ARROW
- SAWCUT LINE
- FENCE
- GRADE BREAK LINE
- FLOW LINE
- CURB AND GUTTER
- ASPHALT PAVING
- CONCRETE PAVING
- GRAVEL
- BUILDING
- SIGN POST
- STORM DRAIN
- STORM INLET
- FLARED END SECTION (FES)
- SANITARY SEWER
- CLEAN OUT
- MANHOLE
- ELECTRIC LINE
- GAS LINE
- WATERLINE
- HYDRANT
- BENDS
- GATE VALVE

DAO ARCHITECTURE
7230 Meade St.
Westminster, CO 80030
Phone: 720.273.0431
Email: dan@daoarch.com
Web: www.daoarch.com

CONTERRA ENGINEERING
242 Linden Street # 5943
Fort Collins, CO 80524
Phone: 720.689.5806
Email: info@conterraeng.com
Web: www.conterraeng.com

Westminster Public Schools

E.C.C. GYM INFILTRATION RENO


8030 Irving St.
Westminster, CO 80031

DAO No.: 2019-001

November 12, 2026


HORIZONTAL CONTROL PLAN

C500

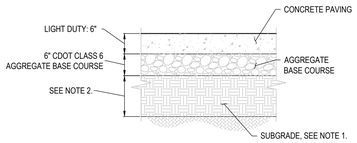


NOTES:
1. SUBGRADE TO BE OVER-EXCAVATED, MOISTURE TREATED, AND RECOMPACTED PER SPECIFICATIONS.
2. SUBGRADE TO BE CONDITIONED AND COMPACTED TO A DEPTH OF AT LEAST 24 INCHES OR A DEPTH THAT REMOVES AND REPLACES ALL UNDOCUMENTED FILL SOILS, WHICHEVER IS GREATER.
3. EXPANSION JOINTS AND CONTRACTION JOINTS SHOWN PER SEPARATE DETAIL.
4. FIBERMESH REINFORCEMENT SHALL BE IN ALL CONCRETE, PER SPECIFICATIONS
5. HEAVY DUTY CONCRETE TO HAVE REINFORCEMENT: #4 REBAR, 12-INCHES ON CENTER EACH WAY, 3-INCHES CLEAR ON ALL SIDES, REFERENCE SPECIFICATIONS.

1 / C500 CONCRETE PAVEMENT SECTION DETAIL
NOT TO SCALE

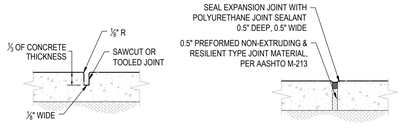

CONTROL/CONTRACTION JOINT

EXPANSION JOINT

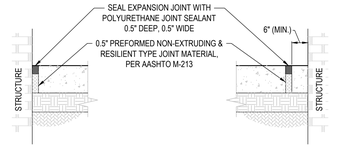


UNIFORM STRUCTURE

NON-UNIFORM STRUCTURE


NOTES:
1. CONTROL/CONTRACTION JOINTS SHALL BE AT INTERVAL TO MATCH WIDTH OF SIDEWALK (6' MAX).
2. PROVIDE EXPANSION JOINTS IN THE CURB AT INTERVALS NOT EXCEEDING 100 FEET AND AT ALL LOCATIONS WHERE NEW SIDEWALK CONNECTS TO EXISTING OR PROPOSED CONCRETE STRUCTURES, UNLESS OTHERWISE NOTED. REFER TO PLAN FOR SPECIFIC LOCATIONS.
3. REMOVE ANY PLASTIC FORMING MATERIAL (E.G., "ZIP STRIPS") FROM THE PREFORMED JOINT FILLER BEFORE APPLYING JOINT SEALANT.

2 / C500 CONCRETE JOINT DETAIL
NOT TO SCALE

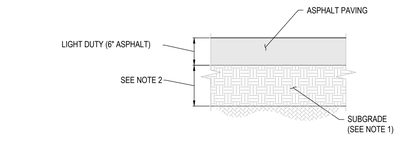


NOTES:
1. SUBGRADE TO BE OVER-EXCAVATED, MOISTURE TREATED, AND RECOMPACTED PER SPECIFICATIONS.
2. SUBGRADE TO BE CONDITIONED AND COMPACTED TO A DEPTH OF AT LEAST 24 INCHES OR A DEPTH THAT REMOVES AND REPLACES ALL UNDOCUMENTED FILL SOILS, WHICHEVER IS GREATER.
3. LIGHT DUTY ASPHALT TO BE INSTALLED FOR CAR PARKING STALLS.
4. HEAVY DUTY ASPHALT TO BE INSTALLED FOR DRIVE LANES, SERVICE DRIVES, AND BUS LOOPS.
5. REFER TO SPECIFICATIONS FOR SURFACE (TOP) COURSE TYPES AND MINIMUM THICKNESS.

3 / C500 FULL DEPTH ASPHALT PAVEMENT SECTION DETAIL
NOT TO SCALE

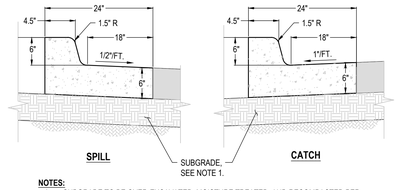

NOTES:
1. SUBGRADE TO BE OVER-EXCAVATED, MOISTURE TREATED, AND RECOMPACTED PER SPECIFICATIONS.
2. EXPANSION JOINTS AND CONTRACTION JOINTS SHOWN PER SEPARATE DETAIL.
3. FIBERMESH REINFORCEMENT SHALL BE IN ALL CONCRETE, PER SPECIFICATIONS.
4. INSTALL EXPANSION JOINTS BETWEEN CONCRETE CURB AND GUTTER ADJACENT TO CONCRETE PAVEMENT.
5. CONTRACTION/EXPANSION JOINTS SHALL BE SPACE 5'-10' APART.
6. TRANSITION BETWEEN SPILL AND CATCH CURB OVER 4'-10'.

4 / C500 CURB & GUTTER DETAIL
NOT TO SCALE

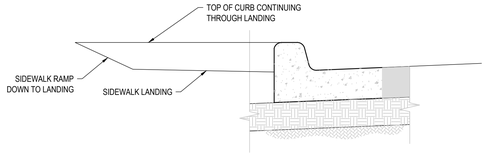

5 / C500 SECTION A-A
NOT TO SCALE

DAO ARCHITECTURE
7230 Meade St.
Westminster, CO 80030
Phone: 720.273.0431
Email: dan@daoarch.com
Web: www.daoarch.com

CONTERRA ENGINEERING
242 Linden Street # 5943
Fort Collins, CO 80524
Phone: 720.689.5806
Email: info@conterraeng.com
Web: www.conterraeng.com

Westminster Public Schools

E.C.C. GYM INFILTRATION RENO


8030 Irving St.
Westminster, CO 80031

DAO No.: 2019-001

November 12, 2026

HORIZONTAL CONTROL PLAN DETAILS

CD501

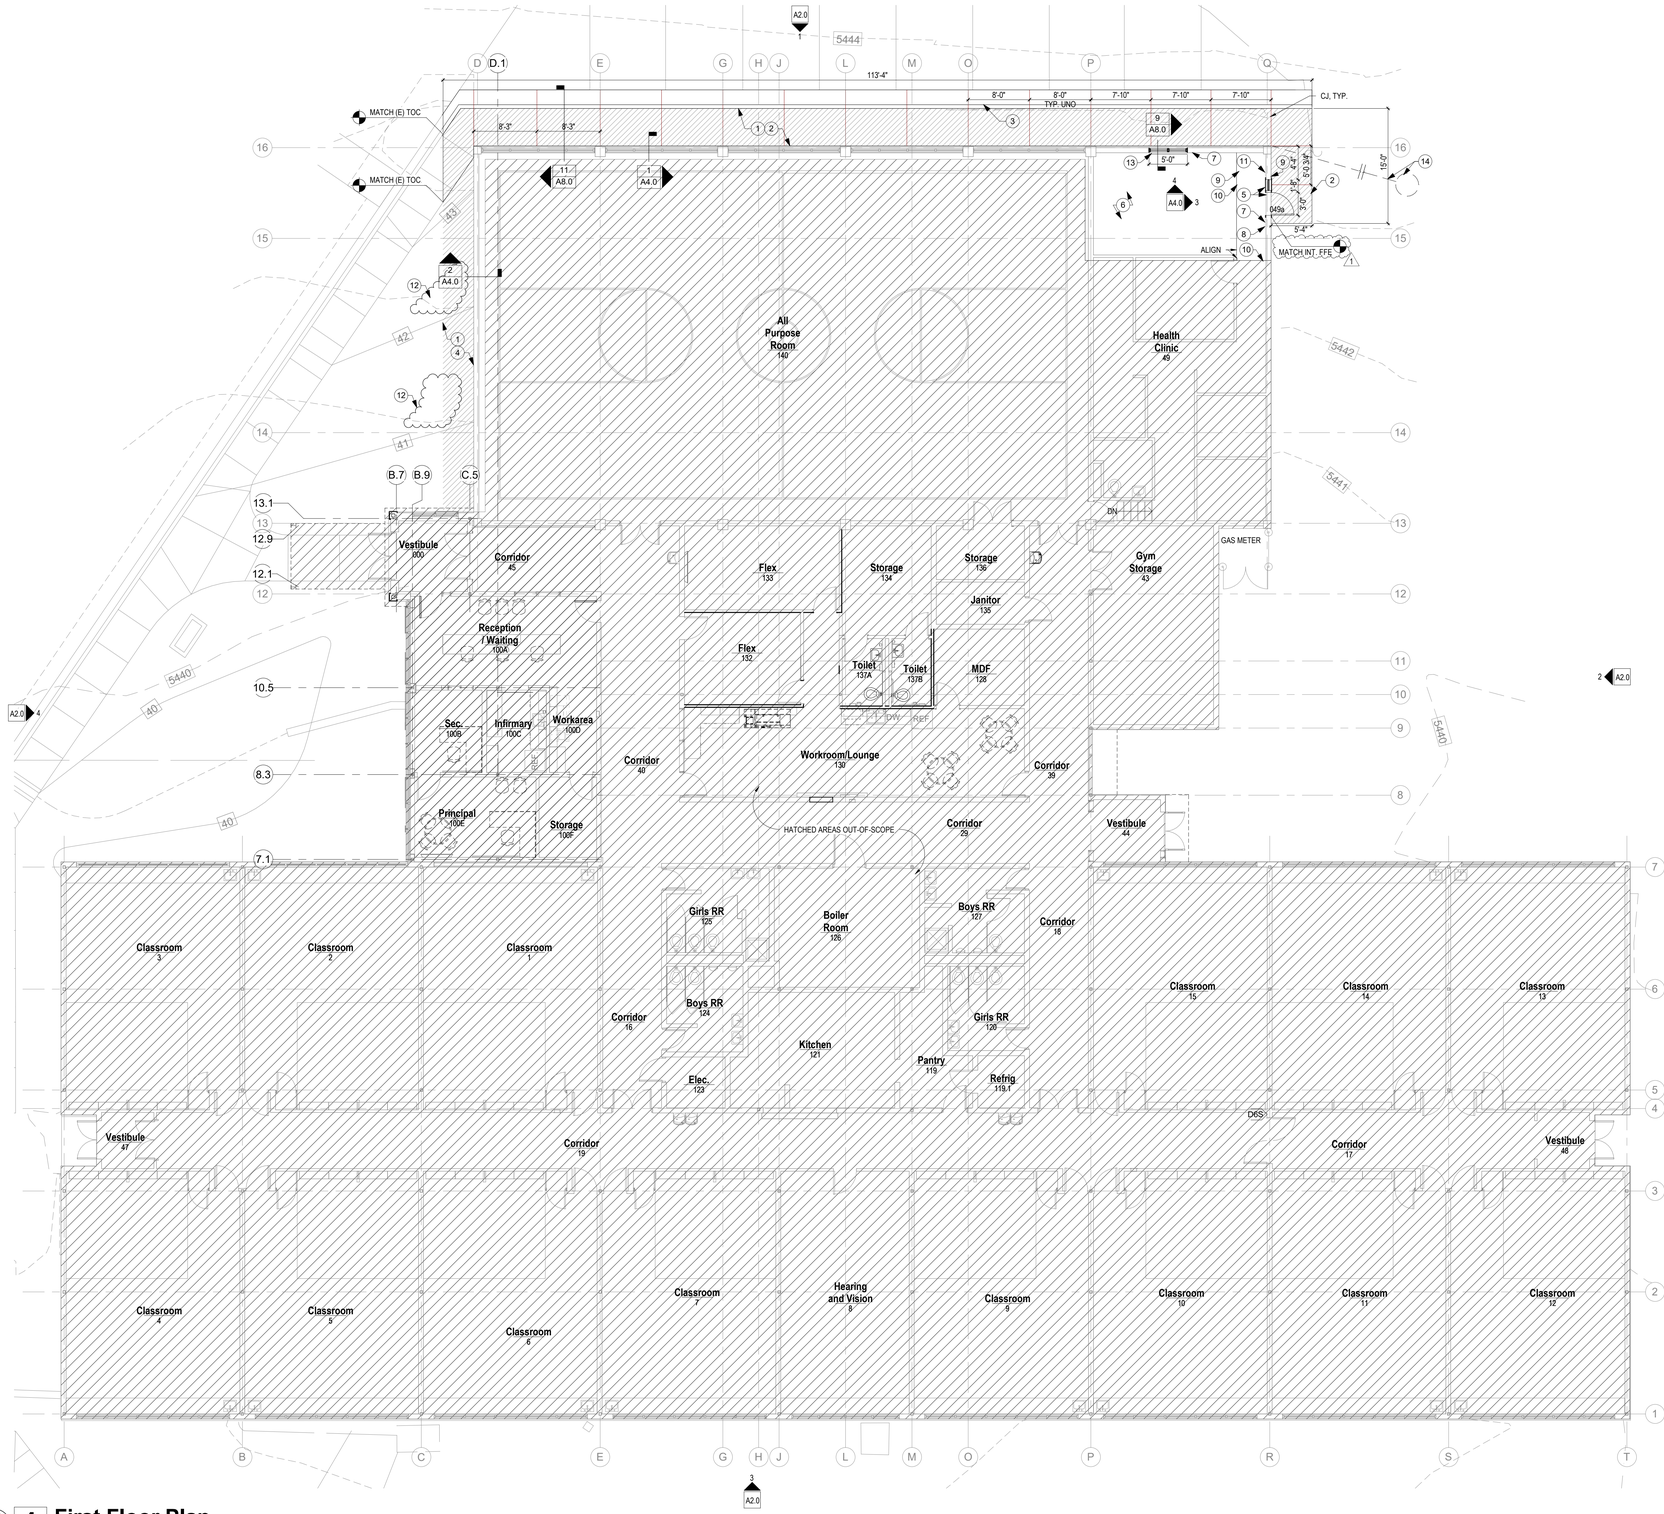

1 First Floor Plan

SCALE: 1/8" = 1'-0"

GENERAL PLAN NOTES

1. DRAWINGS & SPECIFICATIONS ARE COMPLIMENTARY COMPONENTS OF THE CONTRACT DOCUMENTS, REVIEW ALL DRAWINGS AND SPECIFICATIONS FOR THE COMPLETE SCOPE OF WORK. NOTIFY ARCHITECT IMMEDIATELY FOR CLARIFICATION IF INCONSISTENCIES, CONTRADICTIONS OR OMISSIONS ARE DISCOVERED.
2. DO NOT SCALE DRAWINGS, IF DIMENSIONAL INFORMATION IS REQUIRED & NOT FOUND, NOTIFY ARCHITECT IMMEDIATELY FOR CLARIFICATION.
3. ALL DIMENSIONS ARE TO COLUMN CENTERLINES OR FACE OF FINISHED WALLS OR SURFACES UNLESS NOTED OTHERWISE.
4. REFER TO DEMOLITION DRAWINGS FOR WORK REQUIRED IN ADVANCE OF CONSTRUCTION AND COORDINATE ACCORDINGLY.
5. ALL NEW DOOR FRAMES ARE TO BE INSTALLED 4" AWAY OF ADJACENT PERPENDICULAR WALLS UNLESS NOTED OTHERWISE.
6. REFER TO STRUCTURAL, MECHANICAL, ELECTRICAL, PLUMBING, LOW VOLTAGE, ROOF, LANDSCAPE, AND CIVIL DRAWINGS FOR ADDITIONAL INFORMATION.
7. INTERIOR SIGNAGE TO BE PROVIDED BY OWNER.
8. FURNITURE AND EQUIPMENT TO BE PROVIDED BY OWNER.
9. AT ALL LOCATIONS WHERE A NEW OR EXISTING WALL MEETS A STOREFRONT MULLION, SEAL EACH SIDE WITH ACOUSTICAL SEALANT.

KEY NOTES

1. REPLACE BACKFILL REMOVED FOR INSTALLATION OF NEW DAMPPROOFING. COMPACT IN 8" LIFTS TO MINIMUM COMPACTION OF 95% OR MORE AS DETERMINED BY APPLICABLE ASTM TESTING. RE: CIVIL
2. NEW CONCRETE SIDEWALK. RE: CIVIL
3. NEW CONCRETE CURB. RE: CIVIL
4. REPLACE LANDSCAPE MATERIAL, LEVEL AND EQUAL THE DEPTH OF ADJACENT AREAS.
5. NEW INSULATED HOLLOW METAL DOOR AND FRAME ASSEMBLY WITH INSULATED GLAZED SIDE LITE.
6. NEW CARPET, TARKETT POWER BOND VISUAL PATH, 20150. PROVIDE SAMPLES FOR APPROVAL BEFORE INSTALLATION
7. PROVIDE NEW WALL BASE, MATCHING EXISTING WALL BASE. COORDINATE WITH OWNER FOR USE OF ATTIC STOCK
8. RE-INSTALL SALVAGED SECURITY KEY PAD. PROVIDE NEW LOW-VOLTAGE CONNECTIONS AS REQUIRED. COORDINATE WITH OWNER AS REQUIRED TO RE-PROGRAM SECURITY SYSTEM.
9. PROVIDE NEW CARD READER. PROVIDE NEW LOW-VOLTAGE CONNECTIONS AS REQUIRED. COORDINATE WITH OWNER AS REQUIRED TO CONNECT TO POWERED DOOR HARDWARE AND SECURITY SYSTEM.
9. NEW WALK-OFF CARPET, TANDUS ABRASIVE ACTION II 02678 COLOR: WINTER GRAY 19103. PROVIDE SAMPLES FOR APPROVAL BEFORE INSTALLATION
10. FLOORING TRANSITION. JOHNSONITE BY TARKETT SLT OR EQUAL. COLOR BLACK
11. REINSTALL FIRE ALARM PULL STATION. EXTEND EXISTING ADDRESSABLE FIRE ALARM CIRCUIT AS REQUIRED. COORDINATE WITH OWNER FOR EXACT LOCATION.
12. APPROXIMATE LOCATION OF NEW PLANTING. MATCH NUMBER AND TYPE OF PLANTING REMOVED DURING DEMOLITION.
13. ROLLER SHADE AT WINDOW. LUTEK OR EQUAL. MANUAL ROLLER SHADE. FABRIC: ONYX, FASCIA: ANODIZED, HARDWARE: GRAY, FABRIC WRAPPED END CAPS
14. BELOW GRADE DRYWELL AND DRAIN LINE CONNECTED FROM THE NEW FOUNDATION DRAIN. RE: CIVIL

DAO ARCHITECTURE

7230 Meade St.
Westminster, CO 80030

Phone: 720.273.0431
Email: dan@daoarch.com
Web: www.daoarch.com

Rev. #	Description	Rev. Date
1	Addendum 01	11/12/2026

Revision Schedule

Westminster Public Schools

2026 Bond Projects - ECC Renovations

8030 Irving St.
Westminster, CO 80031


DAO No.: 2025-033

September 25, 2026

First Floor Plans

A1.0


Autodesk Docs://WPS 2026 Bond Projects - ECC Renovations/WPS ECC (Revit 2026).rvt
11/12/2026 8:32:38 AM

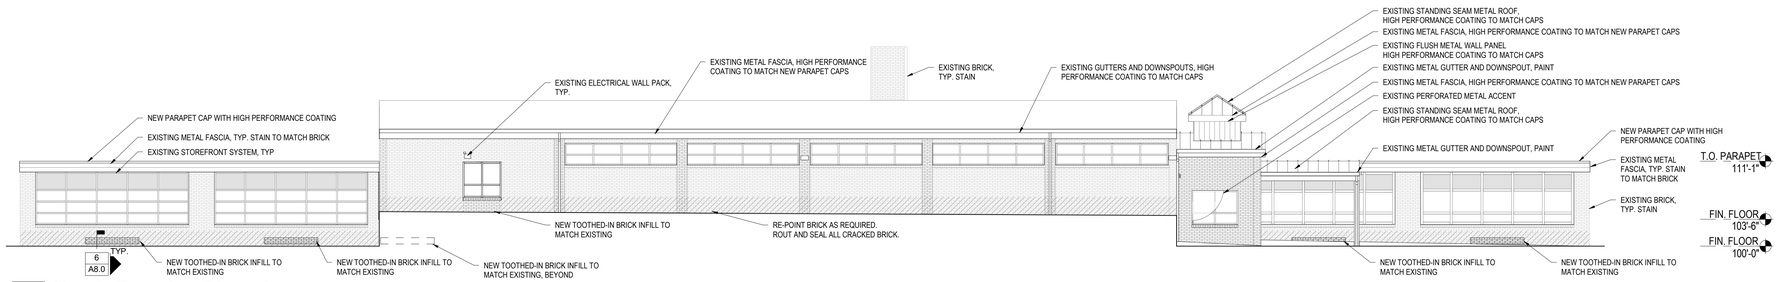

1 North Exterior Elevation

SCALE: 1/8" = 1'-0"


1 A1.0

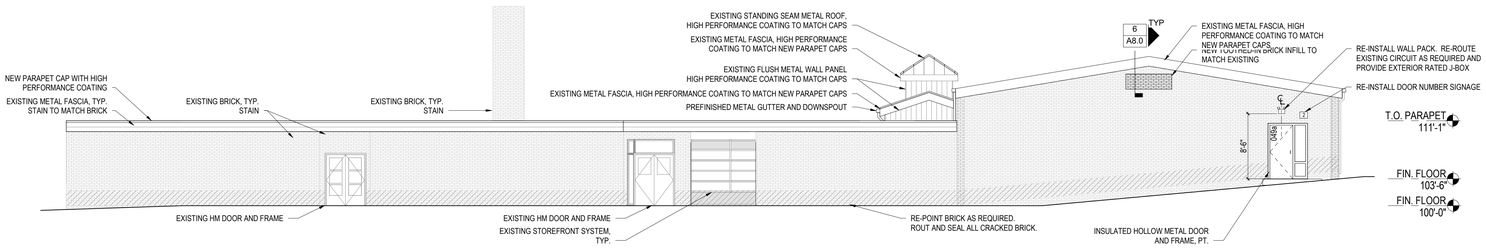

2 East Exterior Elevation

SCALE: 1/8" = 1'-0"


1 A1.0

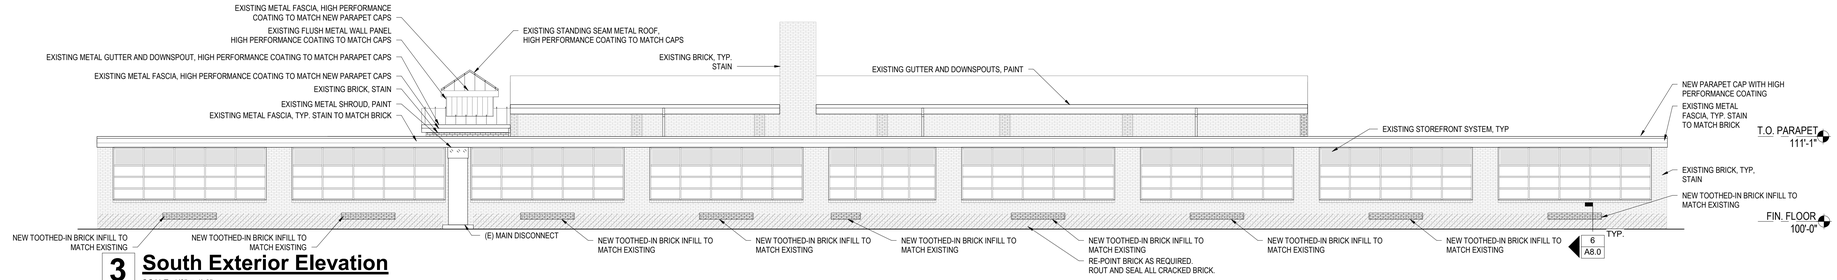

3 South Exterior Elevation

SCALE: 1/8" = 1'-0"

1 A1.0

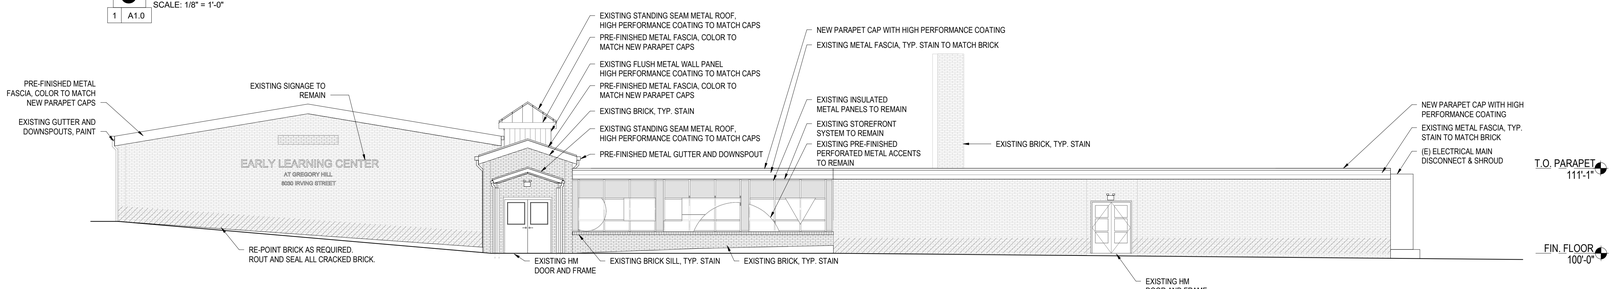

4 West Exterior Elevation

SCALE: 1/8" = 1'-0"

1 A1.0

BASIS OF DESIGN LEGEND

EXISTING BRICK

ALL BRICK TO BE STAINED, BASIS OF DESIGN: BRICK IMAGING, COLOR SELECTED BY ARCHITECT

NEW PRE-FINISHED PARAPET CAPS AND FLASHING, BASIS OF DESIGN: SHERWIN-WILLIAMS GENESIS. COLOR: COPPER PENNY

BRICK REPAIR SCOPE GENERAL NOTES:

1. CONTRACTOR TO FIELD VERIFY EXTENTS OF ALL CRACKED AND/OR DAMAGED BRICK. CONFIRM WITH OWNER FOR DIRECTION ON REPAIR AND REPLACEMENT
2. CONTRACTOR TO PROVIDE NOT-TO-EXCEED PRICING FOR BRICK RE-POINTING AND REPAIR IN AREAS INDICATED ON THE DRAWINGS, ESTIMATED AT 1,800 SF. CONTRACTOR TO PROVIDE UNIT PRICING FOR ADDITIONAL AREAS OF REPAIR, AND/OR TO CREDIT AREAS INDICATED THAT ARE FOUND TO NOT NEED REPAIR.

DOOR PAINTING GENERAL NOTES:

1. ALL EXTERIOR DOORS AND FRAMES TO BE PAINTED. COLOR TO BE SELECTED ONCE STAIN COLOR IS SELECTED.

DAO ARCHITECTURE
7230 Meade St.
Westminster, CO 80030
Phone: 720.273.0431
Email: dan@daoarch.com
Web: www.daoarch.com

Westminster Public Schools

2026 Bond Projects - ECC Renovations
8030 Irving St. Westminster, CO 80031


DAO No.:2025-033

September 25, 2026

Exterior Elevations

A2.0


Autodesk Docs://WPS 2026 Bond Projects - ECC Renovations/WPS ECC (Revit 2026).rvt
11/12/2026 8:32:39 AM

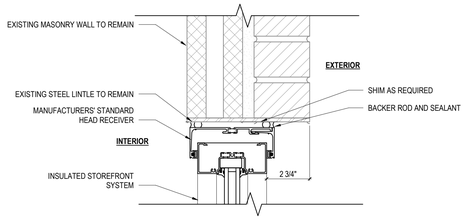

1 Window Infill - Head

SCALE: 3" = 1'-0"


10 | A8.0

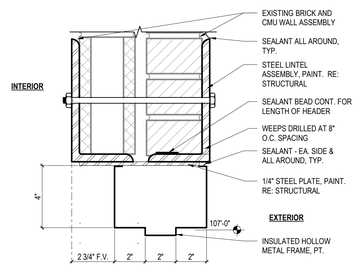

2 Hollow Metal Head


SCALE: 3" = 1'-0"

10 | A8.0

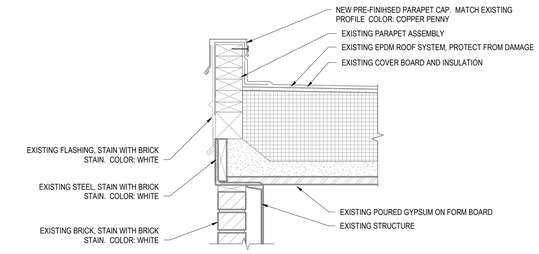

3 New Parapet Cap


SCALE: 1 1/2" = 1'-0"

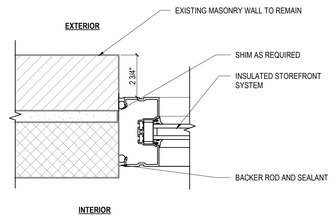

4 Window Infill - Jamb

SCALE: 3" = 1'-0"


10 | A8.0

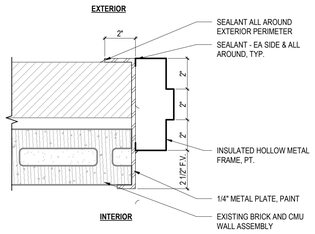

5 Hollow Metal Jamb

SCALE: 3" = 1'-0"


10 | A8.0

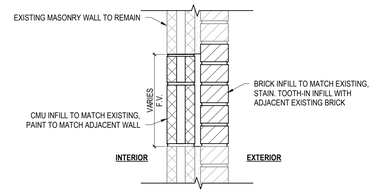

6 Louver Infill Detail

SCALE: 1 1/2" = 1'-0"


1 | A2.0

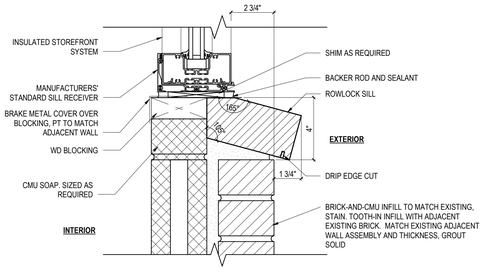

7 Window Infill - Sill

SCALE: 3" = 1'-0"


10 | A8.0

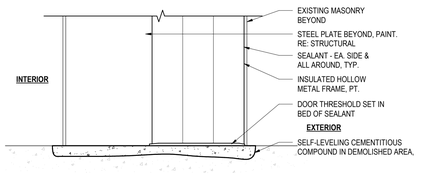

8 Hollow Metal Sill

SCALE: 3" = 1'-0"

10 | A8.0

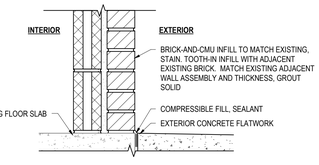

9 Door Infill Detail


SCALE: 1 1/2" = 1'-0"

1 | A1.0

DOOR AND FRAME SCHEDULE

IDENTIFICATION			DOOR						
DOOR NO.	ROOM NO.	ROOM NAME	DIMENSIONS WIDTH	HEIGHT	TYPE	FRAME TYPE	DOOR/FRAME FIRE RATING	HARDWARE	REMARKS
049a	49	Health Clinic	3' - 0"	7' - 0"	HMD-1	HMF-1		01	Storeroom, Card Reader

NOTE:
(E) = EXISTING DOOR AND FRAME
1. GENERAL CONTRACTOR TO VERIFY EXISTING DOORS AND/OR FRAMES AND COORDINATE REQUIRED PREPARATION.
2. DO NOT PAINT ANY EXISTING PRE-FINISHED MULLIONS WHICH ARE TO REMAIN.
3. NEW DOOR LITES SHALL BE PROVIDED WITH THE ANEMOSTAT LOW-PRO INSTALLATION KIT.

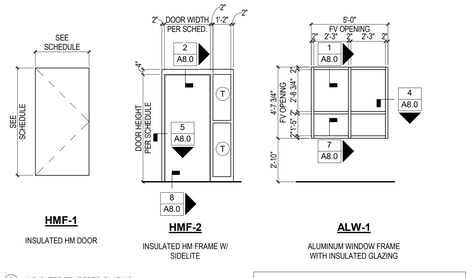

T INDICATES TEMPERED GLAZING AT THESE LOCATIONS


MAXIMUM ASSEMBLY U-FACTOR FOR:
EXTERIOR DOORS: U-0.37
EXTERIOR STOREFRONT: U-0.36

BASIS-OF-DESIGN:
1. EXTERIOR HOLLOW METAL DOORS: CURRIES 707 Q-MAX OR EQUAL
2. EXTERIOR STOREFRONT: KAWNEER 451 UT WITH INSULATED GLAZING. COLOR:CLEAR ANNODIZED

PROVIDE AND INSTALL 3M S800 SECURITY FILM AND CAULKING AT ENTRY DOORS AND ASSOCIATED SIDELITES. COORDINATE FINAL LOCATIONS WITH THE OWNER

10 Door and Frame Types

SCALE: 1/4" = 1'-0"

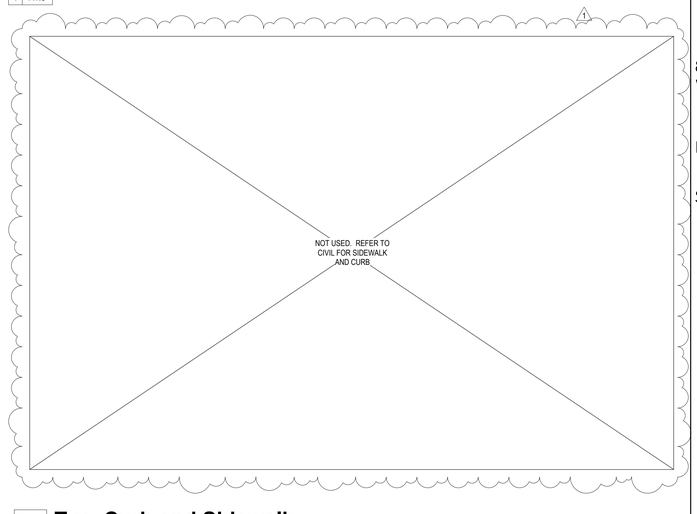

11 Typ. Curb and Sidewalk

SCALE: 1 1/2" = 1'-0"

1 | A1.0

DAO ARCHITECTURE
7230 Meade St.
Westminster, CO 80030
Phone: 720.273.0431
Email: dan@daoarch.com
Web: www.daoarch.com

Rev. #	Description	Rev. Date
1	Addendum 01	11/12/2026

Revision Schedule

Westminster Public Schools

2026 Bond Projects - ECC Renovations

8030 Irving St.
Westminster, CO 80031


DAO No.: 2025-033

September 25, 2026

Details, Door Schedule

A8.0

Autodesk Docs://WPS 2026 Bond Projects - ECC Renovations/WPS ECC (Revit 2026).rvt
11/12/2026 8:32:40 AM

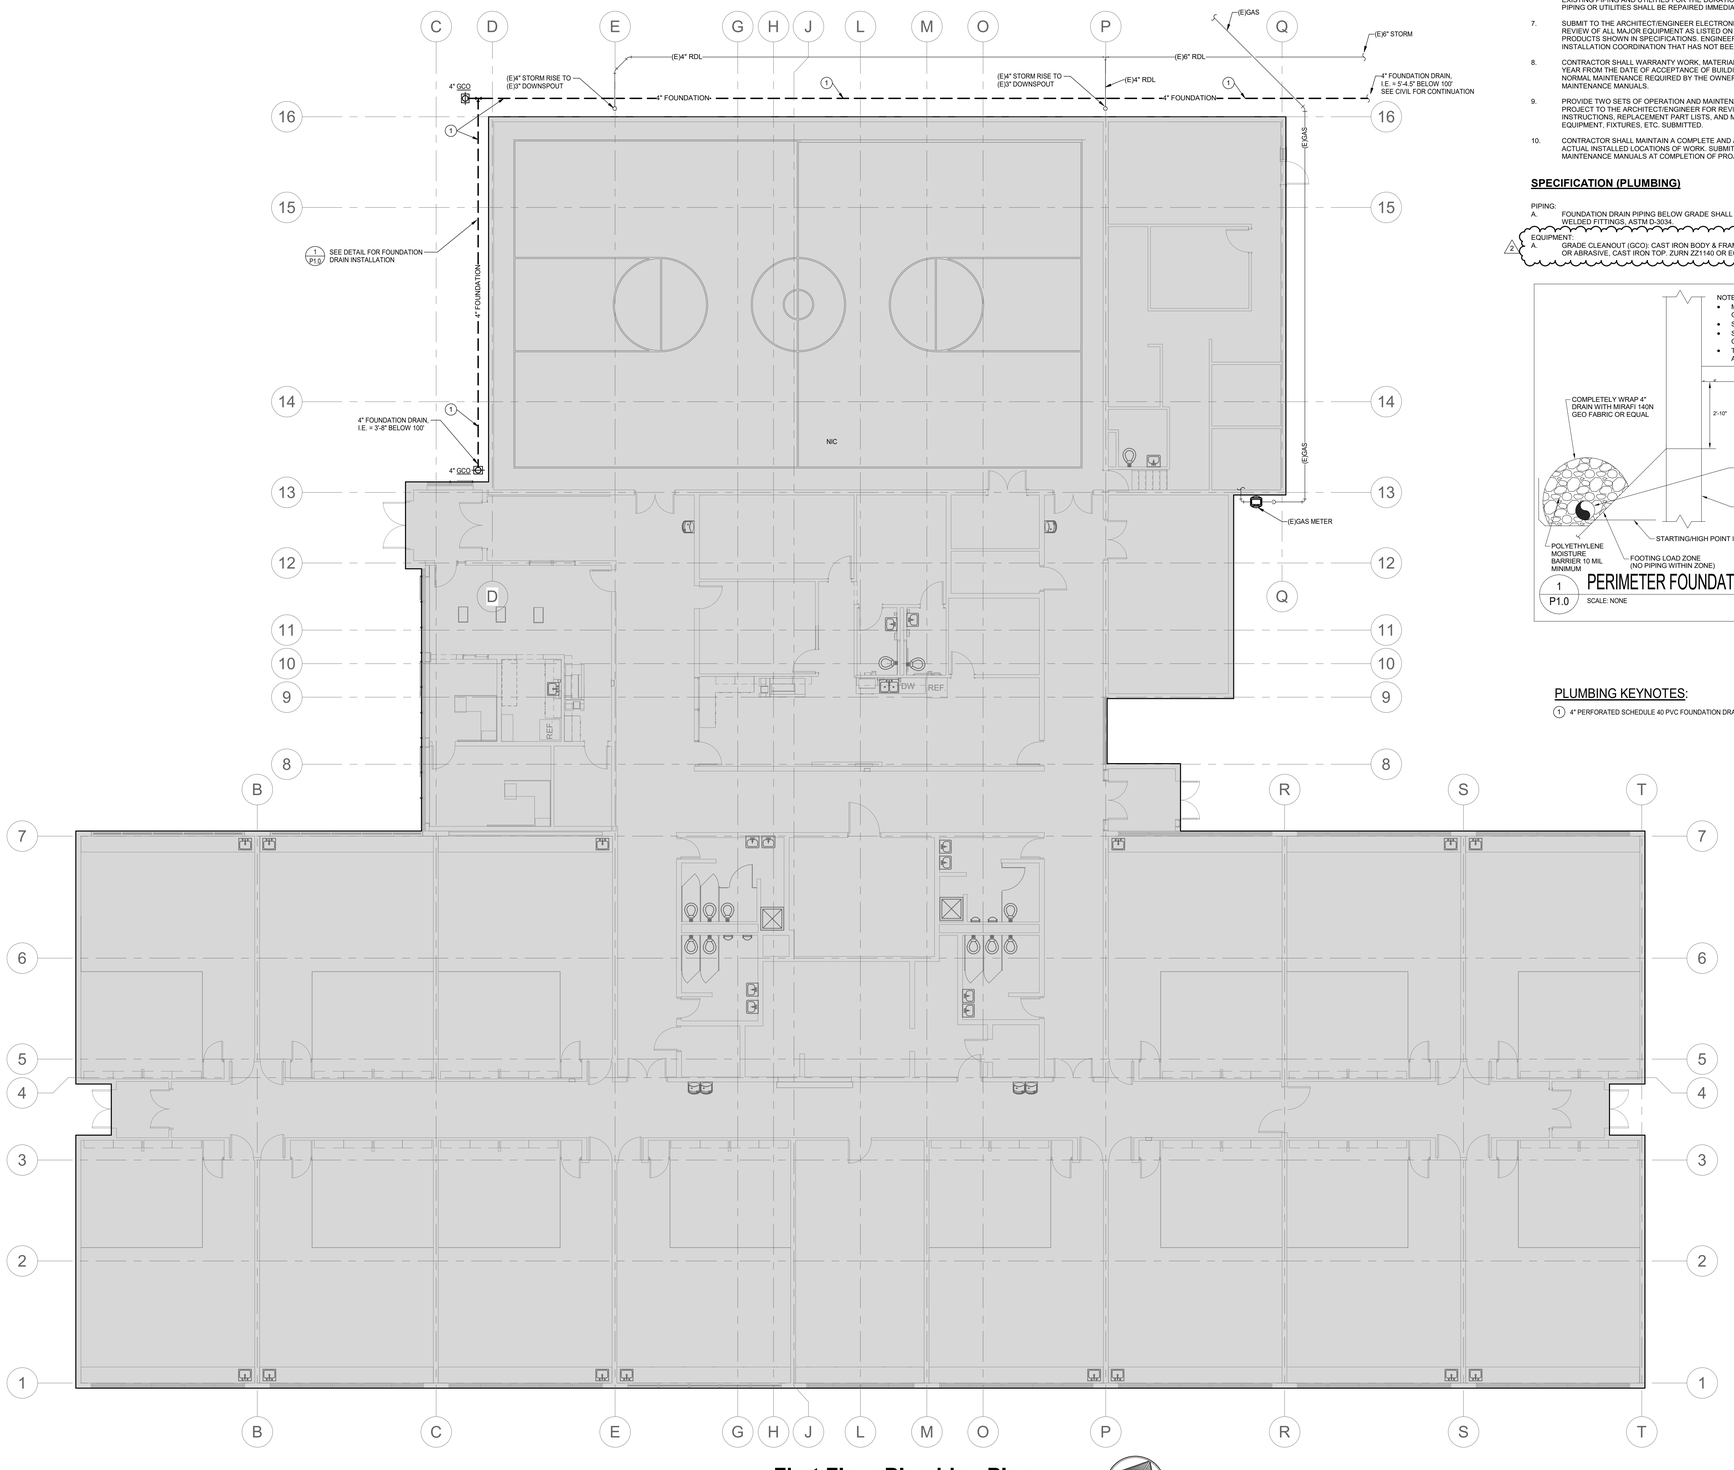

First Floor Plumbing Plan
SCALE: 1/8" = 1'-0"

PLUMBING DEMOLITION GENERAL NOTES

1. COORDINATE DEMOLITION REQUIREMENTS WITH THE GENERAL CONTRACTOR.
2. COORDINATE EXTENT OF DEMOLITION WITH THE NEW CONSTRUCTION AS SHOWN IN THESE DOCUMENTS.
3. EXISTING PLUMBING PIPING, EQUIPMENT ETC IS SHOWN LIGHT.
4. THE GENERAL CONTRACTOR SHALL MAKE REPAIRS TO ALL EXISTING BUILDING COMPONENTS THAT HAVE BEEN AFFECTED BY THE DEMOLITION OF PLUMBING SYSTEMS.


PLUMBING GENERAL NOTES

1. FIELD VERIFY EXACT LOCATION OF ALL CONNECTIONS PRIOR TO CONSTRUCTION.
2. CONTRACTOR SHALL INSPECT SITE TO THOROUGHLY FAMILIARIZE HIMSELF WITH THE AREA OF WORK. ANY DISCREPANCES BETWEEN THESE DOCUMENTS AND ACTUAL CONDITIONS SHALL BE REPORTED TO THE ARCHITECT/ENGINEER FOR RESOLUTION PRIOR TO BID PRICING. NO EXTRAS WILL BE ALLOWED DUE TO LACK OF KNOWLEDGE OF EXISTING CONDITIONS.
3. COMPLY WITH ALL BUILDING AND HEALTH DEPARTMENT REGULATIONS FOR PLUMBING INSTALLATION. VERIFY ALL REQUIREMENTS PRIOR TO SUBMITTING BID OR COMMENCING WORK.
4. OFFSET ALL PIPING AS REQUIRED TO AVOID STRUCTURAL MEMBERS, CANTS, FLASHING, MECHANICAL, OR ELECTRICAL EQUIPMENT.
5. PROTECT ALL EXISTING EQUIPMENT INDICATED AS REMAINING IN PLACE OR BEING RELOCATED. REPLACE DAMAGED EQUIPMENT IMMEDIATELY WITH EXACT DUPLICATE AT NO ADDITIONAL COST TO THE OWNER.
6. PLUMBING CONTRACTOR SHALL BE RESPONSIBLE FOR PROPERLY LOCATING AND PROTECTING ALL EXISTING PIPING AND UTILITIES FOR THE DURATION OF THE WORK. ANY DAMAGE CAUSED TO EXISTING PIPING OR UTILITIES SHALL BE REPAIRED IMMEDIATELY AT NO ADDITIONAL COST TO THE OWNER.
7. SUBMIT TO THE ARCHITECT/ENGINEER ELECTRONIC PDF FILES OF MECHANICAL SUBMITTALS FOR REVIEW OF ALL MAJOR EQUIPMENT AS LISTED ON DRAWING EQUIPMENT SCHEDULES, AS WELL AS PRODUCTS SHOWN IN SPECIFICATIONS. ENGINEER ASSUMED NO RESPONSIBILITY FOR EQUIPMENT OR INSTALLATION COORDINATION THAT HAS NOT BEEN SUBMITTED FOR REVIEW.
8. CONTRACTOR SHALL WARRANTY WORK, MATERIALS, AND PROPER OPERATION FOR A PERIOD OF ONE YEAR FROM THE DATE OF ACCEPTANCE OF BUILDING BY OWNER. THIS GUARANTEE SHALL NOT INCLUDE NORMAL MAINTENANCE REQUIRED BY THE OWNER AS DESCRIBED IN THE OPERATION AND MAINTENANCE MANUALS.
9. PROVIDE TWO SETS OF OPERATION AND MAINTENANCE (O&M) MANUALS FOR OWNER AT COMPLETION OF PROJECT TO THE ARCHITECT/ENGINEER FOR REVIEW. MANUALS TO INCLUDE INSTALLATION INSTRUCTIONS, REPLACEMENT PART LISTS, AND MAINTENANCE INFORMATION ON ALL MECHANICAL EQUIPMENT, FIXTURES, ETC. SUBMITTED.
10. CONTRACTOR SHALL MAINTAIN A COMPLETE AND ACCURATE SET OF RECORD DRAWINGS SHOWING ACTUAL INSTALLED LOCATIONS OF WORK. SUBMIT THESE DRAWINGS AS PART OF THE OPERATION AND MAINTENANCE MANUALS AT COMPLETION OF PROJECT.

SPECIFICATION (PLUMBING)

PIPING:
A. FOUNDATION DRAIN PIPING BELOW GRADE SHALL BE PERFORATED PVC (SDR 35) WITH SOLVENT WELDED FITTINGS. ASTM D-3034.

2
EQUIPMENT:
A. GRADE CLEANOUT (GCO): CAST IRON BODY & FRAME, CLEANOUT PLUG, ADJUSTABLE, ROUND, NO-SLIP OR ABRASIVE, CAST IRON TOP: ZURN ZZ1140 OR EQUAL.

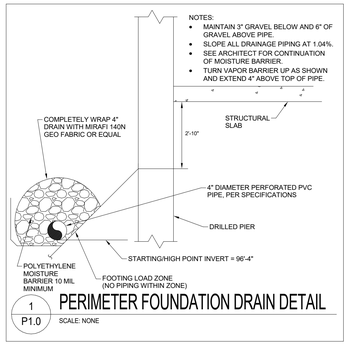

1 P1.0 PERIMETER FOUNDATION DRAIN DETAIL
SCALE: NONE

PLUMBING KEYNOTES:
1 4" PERFORATED SCHEDULE 40 PVC FOUNDATION DRAIN SLOPED AT 1.04%.

DAO ARCHITECTURE
7230 Meade St.
Westminster, CO 80030
Phone: 720.273.0431
Email: dan@daoarch.com
Web: www.daoarch.com

The Ballard Group, Inc.
Mechanical Consulting Engineers
2525 S. Wadsworth Blvd, Suite 200
Lakewood, CO 80227
(303) 988-4514

Rev. #	Description	Rev. Date
2	Addendum 01	11/12/2026

Revision Schedule

Westminster Public Schools

E.C.C. Gym Infiltration Reno.

8030 Irving St.
Westminster, CO
80031

DAO No.:2019-001

September 25, 2026

First Floor Plumbing Plan, Details & General Notes

P1.0

Autodesk Docs://WPS 2026 Bond Projects - ECC Renovations/25094 ECC 2026 Bond Projects-PLBG-R26.rvt
11/12/2026 9:47:32 AM