DAO ARCHITECTURE
7230 Meade Street
Westminster, CO 80030
Phone: 720-273-0431
Email: dan@daoarch.com

Date: 11/12/2026
Project: Westminster Public Schools – 2026 Bond Projects – Fairview Renovations
DAO Project No.: 2025-033

Addendum 001

The following revisions are to be incorporated into the Construction Documents, dated September 25, 2026

I. SPECIFICATIONS

None at this time

II. DRAWINGS

Sheet G0.1 – Sheet revisions – AHJ review clarifications.

Sheet AD1.0 – Sheet revision – Classroom 24 floor finish removal.

Sheet A1.0 – Sheet revisions – General Plan Notes update.

Sheet A1.1 – Sheet revisions – Equipment Schedule clarification.

Sheet A2.0 – Sheet revisions – Scope clarification, AHJ review clarifications.

Sheet A2.1 – Sheet revisions – Scope clarification, AHJ review clarifications.

Sheet A4.0 – Sheet revisions – Updated detail 3 to clarify scope.

Sheet A6.0 – Sheet revisions – Scope clarification, AHJ review clarifications.

Sheet A6.1 – Sheet revisions – Scope clarification.

Sheet A6.2 – Sheet revisions – Scope clarification regarding whiteboard types.

Sheet A6.3 – Sheet revisions – Scope clarification regarding whiteboard types.

Sheet A6.4 – Sheet revisions – Scope clarification regarding whiteboard types.

Sheet A6.5 – Sheet reissued in its entirety – Scope clarification regarding exterior windows.

Sheet A9.0 – Sheet revisions – Addition of classroom 24 to the finish scope.

Sheet E2.0 – Sheet revisions – Added I/O ports adjacent to the teacher's desks.

III. OTHER

None issued at this time.

APPLICABLE BUILDING CODES

All new work shall comply with the requirements of the codes and standards adopted by the State of Colorado.
The primary Applicable Codes and Standards are:

The 2021 International Code Series:
- The 2021 International Existing Building Code (IEBC)
- The 2021 International Building Code (IBC)
- The 2021 International Fire Code (IFC)
- The 2021 International Mechanical Code (IMC)
- The 2021 International Energy Conservation Code (IECC)

The 2021 Colorado Plumbing Code (CPC)
The 2021 Colorado Fuel Gas Code (CFGC) 1
The 2023 National Electrical Code
The 2017 ICC A117.1, Accessible and Usable Buildings and Facilities
The 2023 Colorado Model Electric Ready and Solar Ready Code (CMERSRC) 1
The 2025 Colorado Wildlife Resiliency Code (CWRC)

CODE REVIEW

This project entails a renovation at the existing Fairview Elementary School (Original Building, Outbuilding, and Modular) in Denver, CO (unincorporated Adams County).
This building is an existing E Occupancy building and will remain an E occupancy.

2021 IEBC

Chapter 3 – Provisions for All Compliance Methods
302 - General Provisions
- 302.3 Existing materials - Materials already in use in a building in compliance with requirements or approvals in effect at the time of their erection or installation shall be permitted to remain in use unless determined by the code official to be unsafe.
- 302.4 New and replacement materials - Except as otherwise required or permitted by this code, materials permitted by the applicable code for new construction shall be used.

306 - Accessibility For Existing Buildings
- 306.6 Additions - Provisions for new construction shall apply to *additions*. An *addition* that affects the accessibility to, or contains an area of, a *primary function* shall comply with the requirements in Section 306.7.1.
- 306.7 Alterations - A facility that is altered shall comply with the applicable provisions in Chapter 11 of the International Building Code, ICC A117.1 and the provisions of Sections 06.7.1 through 306.7.16, unless technically infeasible. Where compliance with this section is technically infeasible, the alteration shall provide access to the maximum extent technically feasible.
  - 306.7.1 Alterations affecting an area of primary function - Where an *alteration* affects the accessibility to, or contains an area of *primary function*, the route to the *primary function* area shall be accessible. The accessible route to the *primary function* area shall include toilet *facilities* and drinking fountains serving the area of *primary function*.
  - 306.7.2 - Accessible means of egress. Accessible means of egress required by Chapter 10 of the International Building Code are not required to be added in existing facilities.

Chapter 5 - Prescriptive Compliance Method
503 - Alterations
- 503.1 General - *Alterations* to any building or structure shall comply with the requirements of the *International Building Code* for new construction. *Alterations* shall be such that the *existing building* or structure is not less complying with the provisions of the *International Building Code* than the *existing building* or structure was prior to the *alteration*.
- 503.17 Locking arrangements in educational occupancies - In Group E occupancies...egress doors with locking arrangements designed to keep intruders from entering the room shall comply with Section 1010.2.8 of the *International Building Code*.

505 - Windows and Emergency Escape Openings
- 505.1 Replacement Windows - The installation or replacement of windows shall be as required for new installations.

2021 IBC

Chapter 3 – Use and Occupancy Classification
305 - Educational: Group E - Educational Group E occupancy includes, among others, the use of a building or structure, or a portion thereof, by six or more persons at any one time for educational purposes through the 12th grade.

Chapter 5 – General Building Heights and Areas
Building height and area are existing conditions that will not be altered by this project's scope

Chapter 6 - Types of Construction
602 - Construction Classification
- 602.3 - Type IIIB and Type VB- The existing original building is assumed to be type IIIB, as the exterior walls are of noncombustible materials, and the interior building elements are of any material permitted by the IBC.

Chapter 9 - Fire Protection Systems
903 - Automatic Fire Sprinklers
- 903.2 - Where Required - Automatic sprinklers will no be required as the building is an existing structure. [The existing building is un-sprinklered]

Chapter 10 – Means of Egress
1001 - Administration
- 1001.2 Minimum Requirements - It shall be unlawful to alter a building or structure in a manner that will reduce the number of exits or the capacity of the means of egress to less that required by this code.

1004 - Occupant Load - See Occupant Load Table
1005 - Means of Egress Sizing - See Occupant Load Table
1006 - Number of Exists and Exist Access Doorways
- 1006.2.1 - 49 occupants and 75' travel distance (E Occupancy, non sprinklered)

1010 - Doors Gates and Turnstiles
- 1010.1.1 Size of Doors - The required capacity of each door opening shall be sufficient for the *occupant load* thereof and shall provide a minimum clear opening width of 32 inches (813 mm).
- 1010.2.8 Locking Arrangement in Educational Occupancies - In Group E occupancies, Group B educational occupancies and Group I-4 occupancies, egress doors from classrooms, offices and other occupied rooms with locking arrangements designed to keep intruders from entering the room shall comply with all of the following conditions:
  1. The door shall be capable of being unlocked from outside the room with a key or other *approved* means.
  2. The door shall be openable from within the room in accordance with Section 1010.2.
  3. Modifications shall not be made to listed *panic hardware*, *fire door* hardware or door closers.
  4. Modifications to *fire door assemblies* shall be in accordance with NFPA 80.

  Remote locking or unlocking of doors from an approved location shall be permitted in addition to the unlocking operation in Item1.
- 1010.2.9 Panic and Fire Exit Hardware - Swinging doors serving rooms or spaces with an *occupant load* of 50 or more in a Group A or E occupancy shall not be provided with a latch or lock other than *panic hardware* or *fire exit hardware*.

Chapter 11 – Accessibility
1110 - Other Features and Facilities
- 1110.0 Sinks - Where sinks are provided, at least 5 percent but not less than one provided in accessible spaces shall be accessible.
- 1110.10 Storage - Where fixed or built-in storage elements such as cabinets, coat hooks, shelves, medicine cabinets, lockers, closets and drawers are provided in required accessible spaces, at least 5 percent, but not less than one of each type shall be accessible.

Chapter 13 – Energy Efficiency
Exterior work consists of the installation of new aluminum framed windows in existing openings.
IECC Table C301.1 - Adams County, Colorado - Climate Zone 5B
Table C402.4
Climate Zone 5B - Maximum U-Factor, Fixed Fenestration - .36
KAWNEER 451UT Series (Replacement Fenestration) - COG U-Value .28 - Overall U-Value .36 1

Chapter 29 - Plumbing Systems
See table 2902.1.

Colorado Model Electric Ready and Solar Ready Code
CMERSRC is not applicable to the scope of this project as it is not a major renovation, addition, or first tenant finish to the building.

SPECIAL INSPECTIONS:
The following Special Inspections will be required:
1. Fire-Resistant Penetrations and Joints (1705.18) 1

Deferred Submittals:
The following items require deferred submittals
1. Firestop systems for each penetration type 3

Occupant Load Table							
tg	Name	Occupancy Classification	Area	Area Function	SF Per Occupant	Occupant Load	Required Exiting Width
Core Building							
000	Vestibule	(none)	91 SF	(none)		0	0
1	Library	(none)	951 SF	IBC_Educational: Classroom area	20 SF	48	9.5
2	Classroom	(IBC) E	744 SF	IBC_Educational: Classroom area	20 SF	38	7.4
3	Classroom	(IBC) E	745 SF	IBC_Educational: Classroom area	20 SF	38	7.4
4	Classroom	(IBC) E	868 SF	IBC_Educational: Classroom area	20 SF	44	8.7
5	Classroom	(IBC) E	869 SF	IBC_Educational: Classroom area	20 SF	44	8.7
6	Classroom	(IBC) E	745 SF	IBC_Educational: Classroom area	20 SF	38	7.4
7	Classroom	(IBC) E	743 SF	IBC_Educational: Classroom area	20 SF	38	7.4
8	Classroom	(IBC) E	742 SF	IBC_Educational: Classroom area	20 SF	38	7.4
10	Platform	(IBC) E	798 SF	IBC_Educational: Classroom area	20 SF	40	8
11	Classroom	(IBC) E	744 SF	IBC_Educational: Classroom area	20 SF	38	7.4
12	Classroom	(IBC) E	743 SF	IBC_Educational: Classroom area	20 SF	38	7.4
13	Classroom	(IBC) E	757 SF	IBC_Educational: Classroom area	20 SF	38	7.6
14	Classroom	(IBC) E	752 SF	IBC_Educational: Classroom area	20 SF	38	7.5
15	Classroom	(IBC) E	736 SF	IBC_Educational: Classroom area	20 SF	37	7.4
16	Classroom	(IBC) E	735 SF	IBC_Educational: Classroom area	20 SF	37	7.3
26	Vestibule	(none)	89 SF	(none)		0	0
27	Corridor	(none)	357 SF	IBC_Educational: Classroom area	20 SF	18	3.6
28	Storage	(IBC) S-1	259 SF	IBC_Accessory storage areas, mechanical equipment room	300 SF	1	0.2
29	Storage	(IBC) S-1	259 SF	IBC_Accessory storage areas, mechanical equipment room	300 SF	1	0.2
30	Corridor	(none)	285 SF	(none)		0	0
32	Kitchen	(IBC) B	91 SF	IBC_Kitchens, commercial	200 SF	1	0.1
33	Kitchen	(IBC) B	361 SF	IBC_Kitchens, commercial	200 SF	2	0.4
34	Boys	(none)	178 SF	(none)		0	0
35	Jan.	(none)	34 SF	(none)		0	0
36	Girls	(none)	155 SF	(none)		0	0
37	Elec.	(none)	33 SF	(none)		0	0
38	Corridor	(none)	2182 SF	(none)		0	0
40	Custodial	(none)	615 SF	(none)		0	0
41	Office	(IBC) B	248 SF	IBC_Business areas	100 SF	3	0.5
42	Classroom	(IBC) E	713 SF	IBC_Educational: Classroom area	20 SF	36	7.1
43	Boys	(none)	181 SF	(none)		0	0
44	Girls	(none)	163 SF	(none)		0	0
45	Office	(IBC) B	117 SF	IBC_Business areas	100 SF	2	0.2
46	Vestibule	(none)	107 SF	(none)		0	0
100a	Reception / Waiting	(IBC) B	332 SF	IBC_Business areas	100 SF	4	0.7
100b	Registration	(IBC) B	53 SF	IBC_Business areas	100 SF	1	0.1
100c	Workarea	(IBC) B	87 SF	IBC_Business areas	100 SF	1	0.2
100d	Infirmary	(IBC) B	92 SF	IBC_Business areas	100 SF	1	0.2
100e	Sec.	(IBC) B	127 SF	IBC_Business areas	100 SF	2	0.3
100f	Principal	(IBC) B	194 SF	IBC_Business areas	100 SF	2	0.4
101	Toilet	(none)	61 SF	(none)		0	0
102a	Lounge / Workroom	(IBC) B	389 SF	IBC_Business areas	100 SF	4	0.8
102b	Storage	(IBC) S-1	20 SF	IBC_Accessory storage areas, mechanical equipment room	300 SF	1	0
103	MDF	(none)	102 SF	(none)		0	0
104	Flex	(IBC) B	109 SF	IBC_Business areas	100 SF	2	0.2
			19753 SF			674	131.7
Core Building - Gym							
39	Gymnasium	(IBC) E	3929 SF	IBC_Assembly: without fixed seats - Concentrated (chairs only - not fixed)	7 SF	562	112.3
			3929 SF			562	112.3
Modular							
24	Classroom	(IBC) E	770 SF	IBC_Educational: Classroom area	20 SF	39	7.7
25	Classroom	(IBC) E	982 SF	IBC_Educational: Classroom area	20 SF	50	9.8
55	Toilet	(none)	57 SF	(none)		0	0
56	Toilet	(none)	56 SF	(none)		0	0
57	Passage	(none)	98 SF	IBC_Educational: Classroom area	20 SF	5	1
58	Multi-Purpose	(IBC) E	0 SF	IBC_Educational: Classroom area	20 SF	0	0
			1963 SF			94	18.5
Outbuilding							
17	Classroom	(IBC) E	833 SF	IBC_Educational: Classroom area	20 SF	42	8.3
18	Classroom	(IBC) E	835 SF	IBC_Educational: Classroom area	20 SF	42	8.3
19	Classroom	(IBC) E	859 SF	IBC_Educational: Classroom area	20 SF	43	8.6
20	Classroom	(IBC) E	763 SF	IBC_Educational: Classroom area	20 SF	39	7.6
21	Classroom	(IBC) E	860 SF	IBC_Educational: Classroom area	20 SF	44	8.6
47	Restroom	(none)	110 SF	(none)		0	0
48	Restroom	(none)	90 SF	(none)		0	0
49	Corridor	(none)	619 SF	(none)		0	0
50	Office	(IBC) B	127 SF	IBC_Business areas	100 SF	2	0.3
51	Restroom	(none)	28 SF	(none)		0	0
52	Elec.	(none)	98 SF	(none)		0	0
53	Office	(IBC) B	153 SF	(none)		0	0
54	Mech.	(none)	111 SF	(none)		0	0
			5487 SF			212	41.8
			31131 SF			1542	304.2



Life Safety Plan
SCALE: 1/16" = 1'-0"

LIFE SAFETY SYMBOLS

- (e)FEC — FIRE EXTINGUISHER CABINET (EXISTING)
- FEC — FIRE EXTINGUISHER CABINET
- 1 HOUR FIRE (EXISTING)
- XX — PATH OF TRAVEL (FOR CUMULATIVE DISTANCES REFER TO SCHEDULE)
- EXIT DISCHARGE
- P: XX" / R: XX" — WIDTH PROVIDED / WIDTH REQUIRED

EGRESS TRAVEL DISTANCES	
PATH NAME	DISTANCE
1A	159' - 0"
1B	185' - 0"
1C	103' - 0"
1D	48' - 0"
1F	48' - 0"

DAO ARCHITECTURE
7230 Meade St.
Westminster, CO 80030
Phone: 720.273.0431
Email: dan@daoarch.com
Web: www.daoarch.com

Rev. #	Description	Rev. Date
3	ACFR Review Comments	11/--/2026
1	DFPC Review Comments	11/--/2026

Revision Schedule

Westminster Public Schools

2026 Bond Projects
Fairview PK-8 Renovations
7826 Fairview Ave.
Denver, CO 80221


DAO No.: 2025-033

September 25, 2026

Building Code Data

G0.1

C:\Users\Anson\AppData\Local\Autodesk\Revit\Autodesk Revit 2026\CollaborationCache\YSFJ5STGNLYKNSM\R5ewa3ofc-8Sd1-48a6-88c2-7860681584f12\d7e66a95-3da2-4d0f-8a37-59a791d1584.rvt
11/12/2026 8:54:37 AM

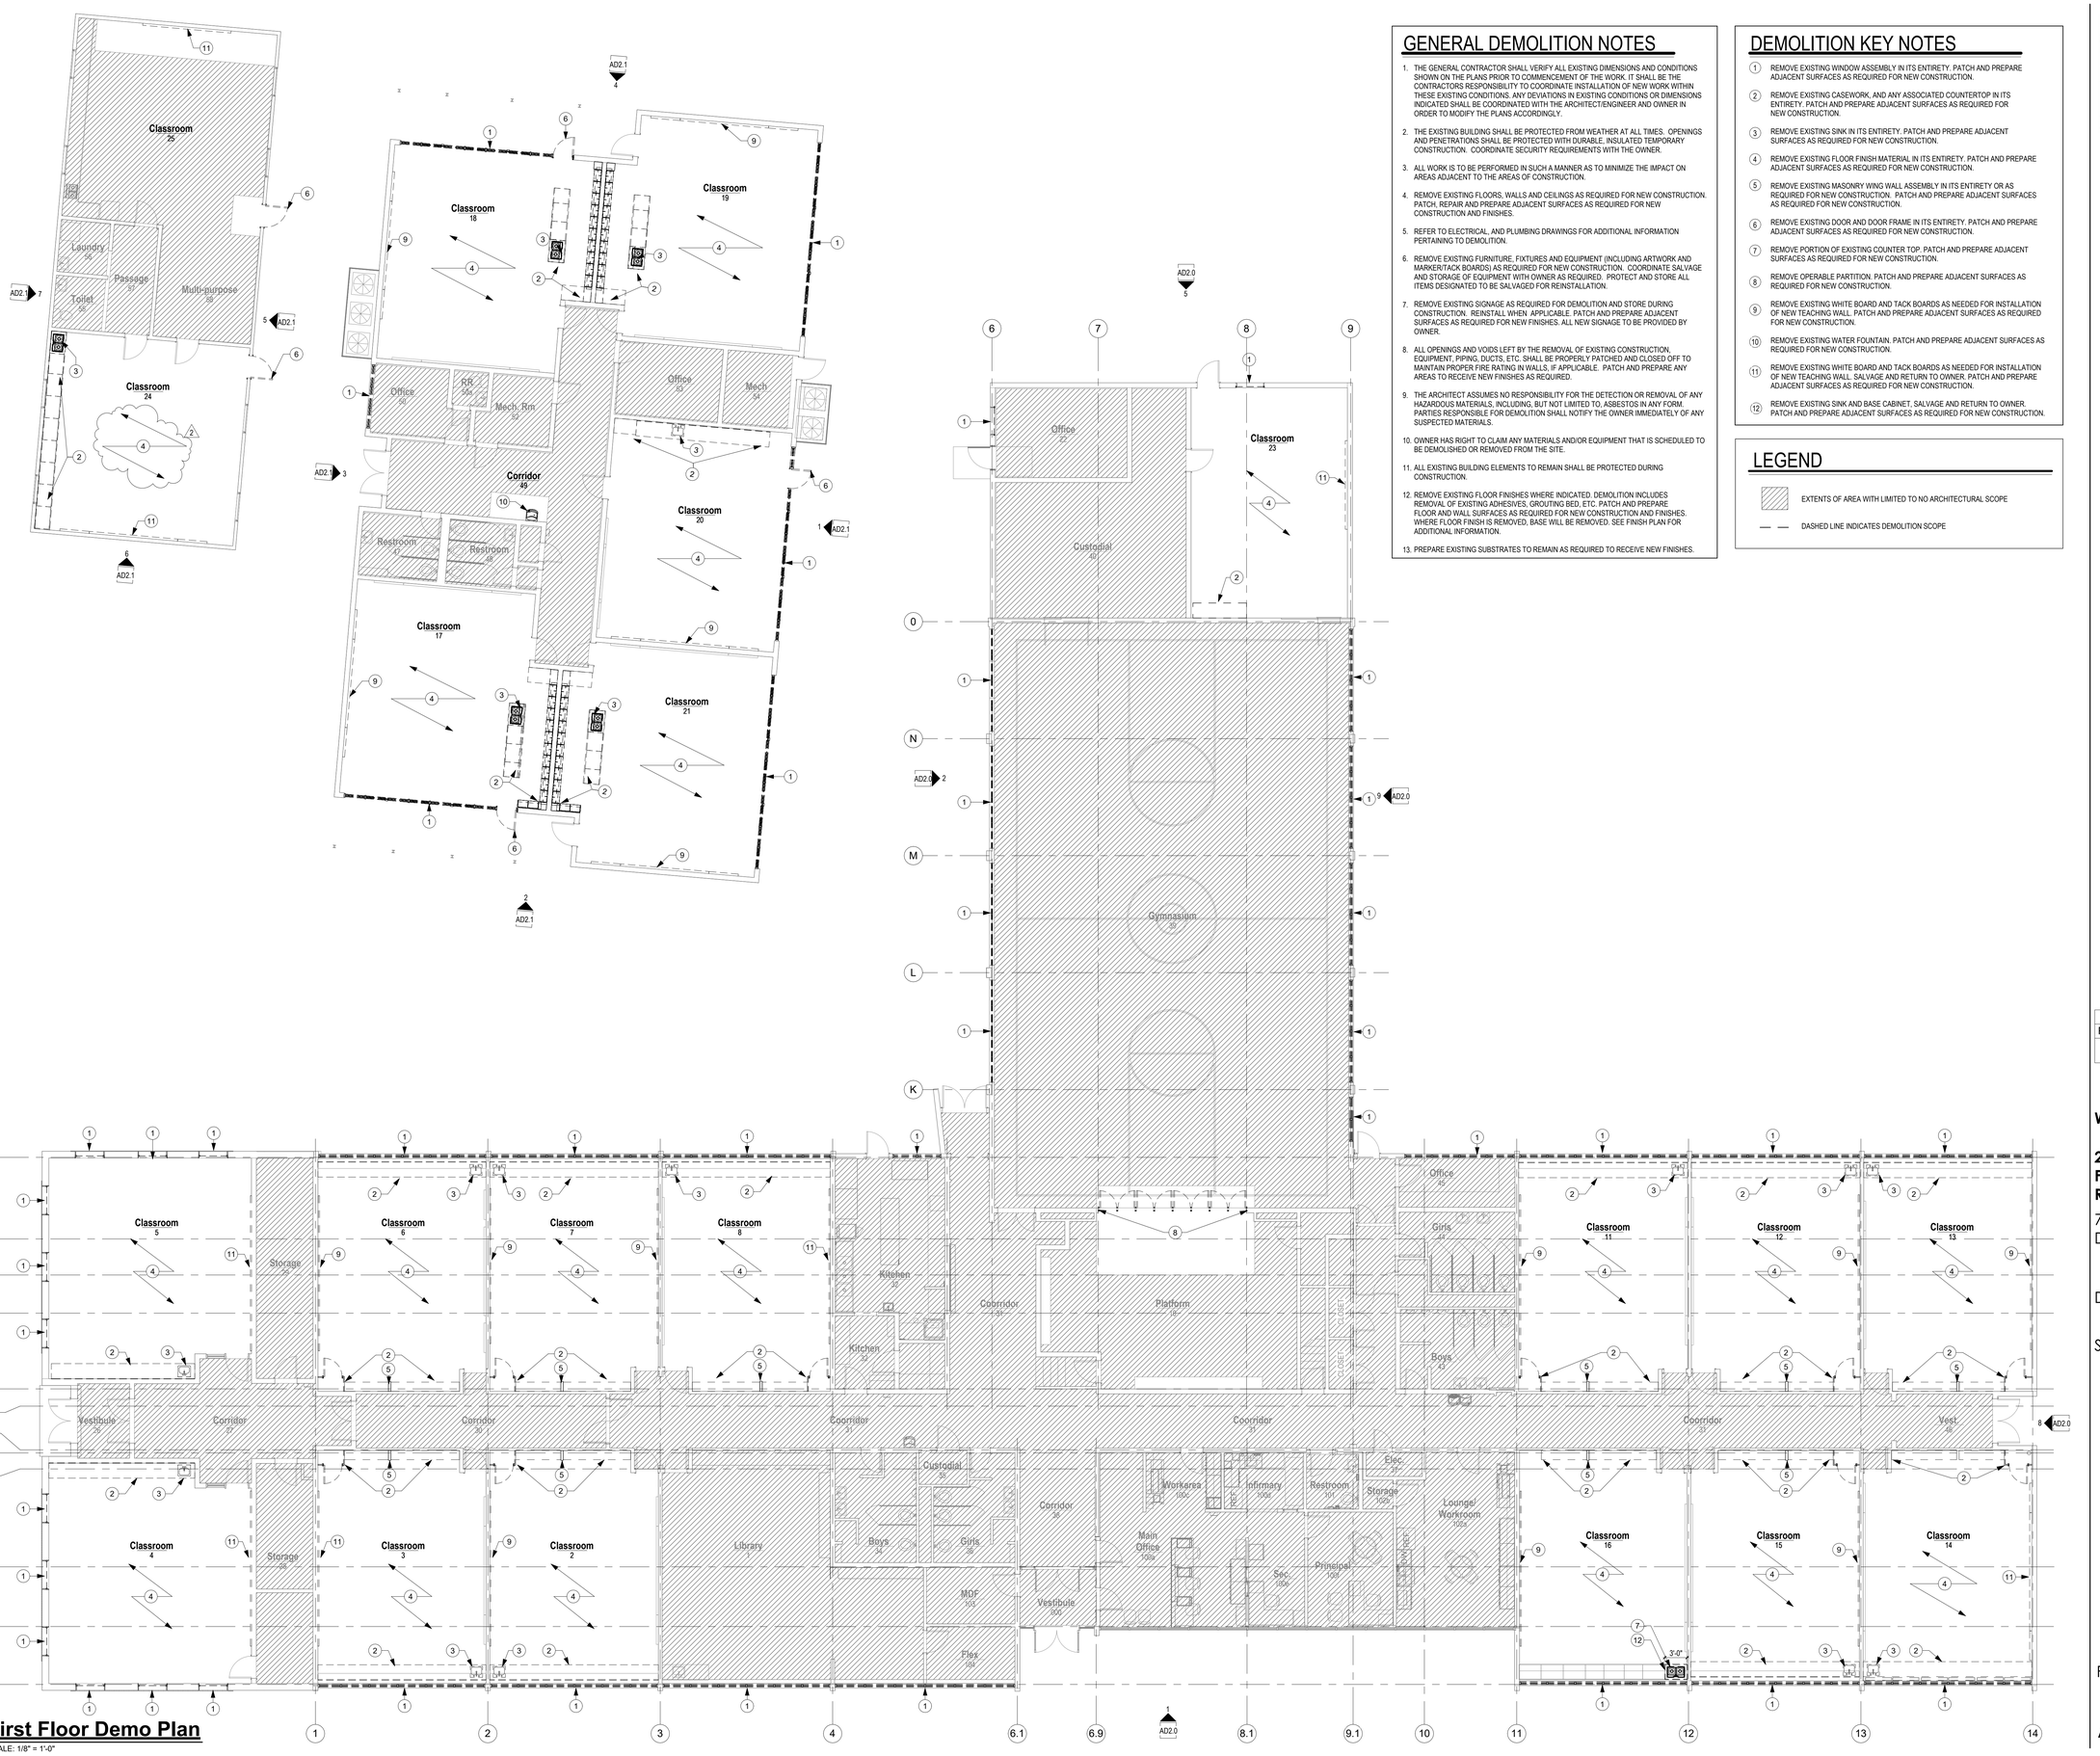

First Floor Demo Plan

SCALE: 1/8" = 1'-0"

GENERAL DEMOLITION NOTES

1. THE GENERAL CONTRACTOR SHALL VERIFY ALL EXISTING DIMENSIONS AND CONDITIONS SHOWN ON THE PLANS PRIOR TO COMMENCEMENT OF THE WORK. IT SHALL BE THE CONTRACTORS RESPONSIBILITY TO COORDINATE INSTALLATION OF NEW WORK WITHIN THESE EXISTING CONDITIONS. ANY DEVIATIONS IN EXISTING CONDITIONS OR DIMENSIONS INDICATED SHALL BE COORDINATED WITH THE ARCHITECT/ENGINEER AND OWNER IN ORDER TO MODIFY THE PLANS ACCORDINGLY.
2. THE EXISTING BUILDING SHALL BE PROTECTED FROM WEATHER AT ALL TIMES. OPENINGS AND PENETRATIONS SHALL BE PROTECTED WITH DURABLE, INSULATED TEMPORARY CONSTRUCTION. COORDINATE SECURITY REQUIREMENTS WITH THE OWNER.
3. ALL WORK IS TO BE PERFORMED IN SUCH A MANNER AS TO MINIMIZE THE IMPACT ON AREAS ADJACENT TO THE AREAS OF CONSTRUCTION.
4. REMOVE EXISTING FLOORS, WALLS AND CEILINGS AS REQUIRED FOR NEW CONSTRUCTION. PATCH, REPAIR AND PREPARE ADJACENT SURFACES AS REQUIRED FOR NEW CONSTRUCTION AND FINISHES.
5. REFER TO ELECTRICAL, AND PLUMBING DRAWINGS FOR ADDITIONAL INFORMATION PERTAINING TO DEMOLITION.
6. REMOVE EXISTING FURNITURE, FIXTURES AND EQUIPMENT (INCLUDING ARTWORK AND MARKER/TACK BOARDS) AS REQUIRED FOR NEW CONSTRUCTION. COORDINATE SALVAGE AND STORAGE OF EQUIPMENT WITH OWNER AS REQUIRED. PROTECT AND STORE ALL ITEMS DESIGNATED TO BE SALVAGED FOR REINSTALLATION.
7. REMOVE EXISTING SIGNAGE AS REQUIRED FOR DEMOLITION AND STORE DURING CONSTRUCTION. REINSTALL WHEN APPLICABLE. PATCH AND PREPARE ADJACENT SURFACES AS REQUIRED FOR NEW FINISHES. ALL NEW SIGNAGE TO BE PROVIDED BY OWNER.
8. ALL OPENINGS AND VOIDS LEFT BY THE REMOVAL OF EXISTING CONSTRUCTION, EQUIPMENT, PIPING, DUCTS, ETC. SHALL BE PROPERLY PATCHED AND CLOSED OFF TO MAINTAIN PROPER FIRE RATING IN WALLS, IF APPLICABLE. PATCH AND PREPARE ANY AREAS TO RECEIVE NEW FINISHES AS REQUIRED.
9. THE *ARCHITECT* ASSUMES NO RESPONSIBILITY FOR THE DETECTION OR REMOVAL OF ANY HAZARDOUS MATERIALS, INCLUDING, BUT NOT LIMITED TO, ASBESTOS IN ANY FORM. PARTIES RESPONSIBLE FOR DEMOLITION SHALL NOTIFY THE OWNER IMMEDIATELY OF ANY SUSPECTED MATERIALS.
10. OWNER HAS RIGHT TO CLAIM ANY MATERIALS AND/OR EQUIPMENT THAT IS SCHEDULED TO BE DEMOLISHED OR REMOVED FROM THE SITE.
11. ALL EXISTING BUILDING ELEMENTS TO REMAIN SHALL BE PROTECTED DURING CONSTRUCTION.
12. REMOVE EXISTING FLOOR FINISHES WHERE INDICATED. DEMOLITION INCLUDES REMOVAL OF EXISTING ADHESIVES, GROUTING BED, ETC. PATCH AND PREPARE FLOOR AND WALL SURFACES AS REQUIRED FOR NEW CONSTRUCTION AND FINISHES. WHERE FLOOR FINISH IS REMOVED, BASE WILL BE REMOVED. SEE FINISH PLAN FOR ADDITIONAL INFORMATION.
13. PREPARE EXISTING SUBSTRATES TO REMAIN AS REQUIRED TO RECEIVE NEW FINISHES.

DEMOLITION KEY NOTES

1. REMOVE EXISTING WINDOW ASSEMBLY IN ITS ENTIRETY. PATCH AND PREPARE ADJACENT SURFACES AS REQUIRED FOR NEW CONSTRUCTION.
2. REMOVE EXISTING CASEWORK, AND ANY ASSOCIATED COUNTERTOP IN ITS ENTIRETY. PATCH AND PREPARE ADJACENT SURFACES AS REQUIRED FOR NEW CONSTRUCTION.
3. REMOVE EXISTING SINK IN ITS ENTIRETY. PATCH AND PREPARE ADJACENT SURFACES AS REQUIRED FOR NEW CONSTRUCTION.
4. REMOVE EXISTING FLOOR FINISH MATERIAL IN ITS ENTIRETY. PATCH AND PREPARE ADJACENT SURFACES AS REQUIRED FOR NEW CONSTRUCTION.
5. REMOVE EXISTING MASONRY WING WALL ASSEMBLY IN ITS ENTIRETY OR AS REQUIRED FOR NEW CONSTRUCTION. PATCH AND PREPARE ADJACENT SURFACES AS REQUIRED FOR NEW CONSTRUCTION.
6. REMOVE EXISTING DOOR AND DOOR FRAME IN ITS ENTIRETY. PATCH AND PREPARE ADJACENT SURFACES AS REQUIRED FOR NEW CONSTRUCTION.
7. REMOVE PORTION OF EXISTING COUNTER TOP. PATCH AND PREPARE ADJACENT SURFACES AS REQUIRED FOR NEW CONSTRUCTION.
8. REMOVE OPERABLE PARTITION. PATCH AND PREPARE ADJACENT SURFACES AS REQUIRED FOR NEW CONSTRUCTION.
9. REMOVE EXISTING WHITE BOARD AND TACK BOARDS AS NEEDED FOR INSTALLATION OF NEW TEACHING WALL. PATCH AND PREPARE ADJACENT SURFACES AS REQUIRED FOR NEW CONSTRUCTION.
10. REMOVE EXISTING WATER FOUNTAIN. PATCH AND PREPARE ADJACENT SURFACES AS REQUIRED FOR NEW CONSTRUCTION.
11. REMOVE EXISTING WHITE BOARD AND TACK BOARDS AS NEEDED FOR INSTALLATION OF NEW TEACHING WALL. SALVAGE AND RETURN TO OWNER. PATCH AND PREPARE ADJACENT SURFACES AS REQUIRED FOR NEW CONSTRUCTION.
12. REMOVE EXISTING SINK AND BASE CABINET, SALVAGE AND RETURN TO OWNER. PATCH AND PREPARE ADJACENT SURFACES AS REQUIRED FOR NEW CONSTRUCTION.

LEGEND

EXTENTS OF AREA WITH LIMITED TO NO ARCHITECTURAL SCOPE

DASHED LINE INDICATES DEMOLITION SCOPE

DAO ARCHITECTURE

7230 Meade St.
Westminster, CO 80030

Phone: 720.273.0431
Email: dan@daoarch.com
Web: www.daoarch.com

Rev. #	Description	Rev. Date
2	Addendum #1	11/12/2026

Revision Schedule

Westminster Public Schools

2026 Bond Projects
Fairview PK-8
Renovations

7826 Fairview Ave.
Denver, CO 80221


DAO No.: 2025-033

September 25, 2026

First Floor Demolition Plan

AD1.0

C:\Users\Aroon\AppData\Local\Autodesk\Revit\Autodesk Revit 2025\Collaboration\Cache\YSPJ9ST1GNLYKNSMR\5ec3dcc-d0c1-45ab-58b2-7f60d81941f2-d7e6bf5-bba2-4d0f-8a37-a8e73f1d1954-v1
11/12/2026 8:54:41 AM

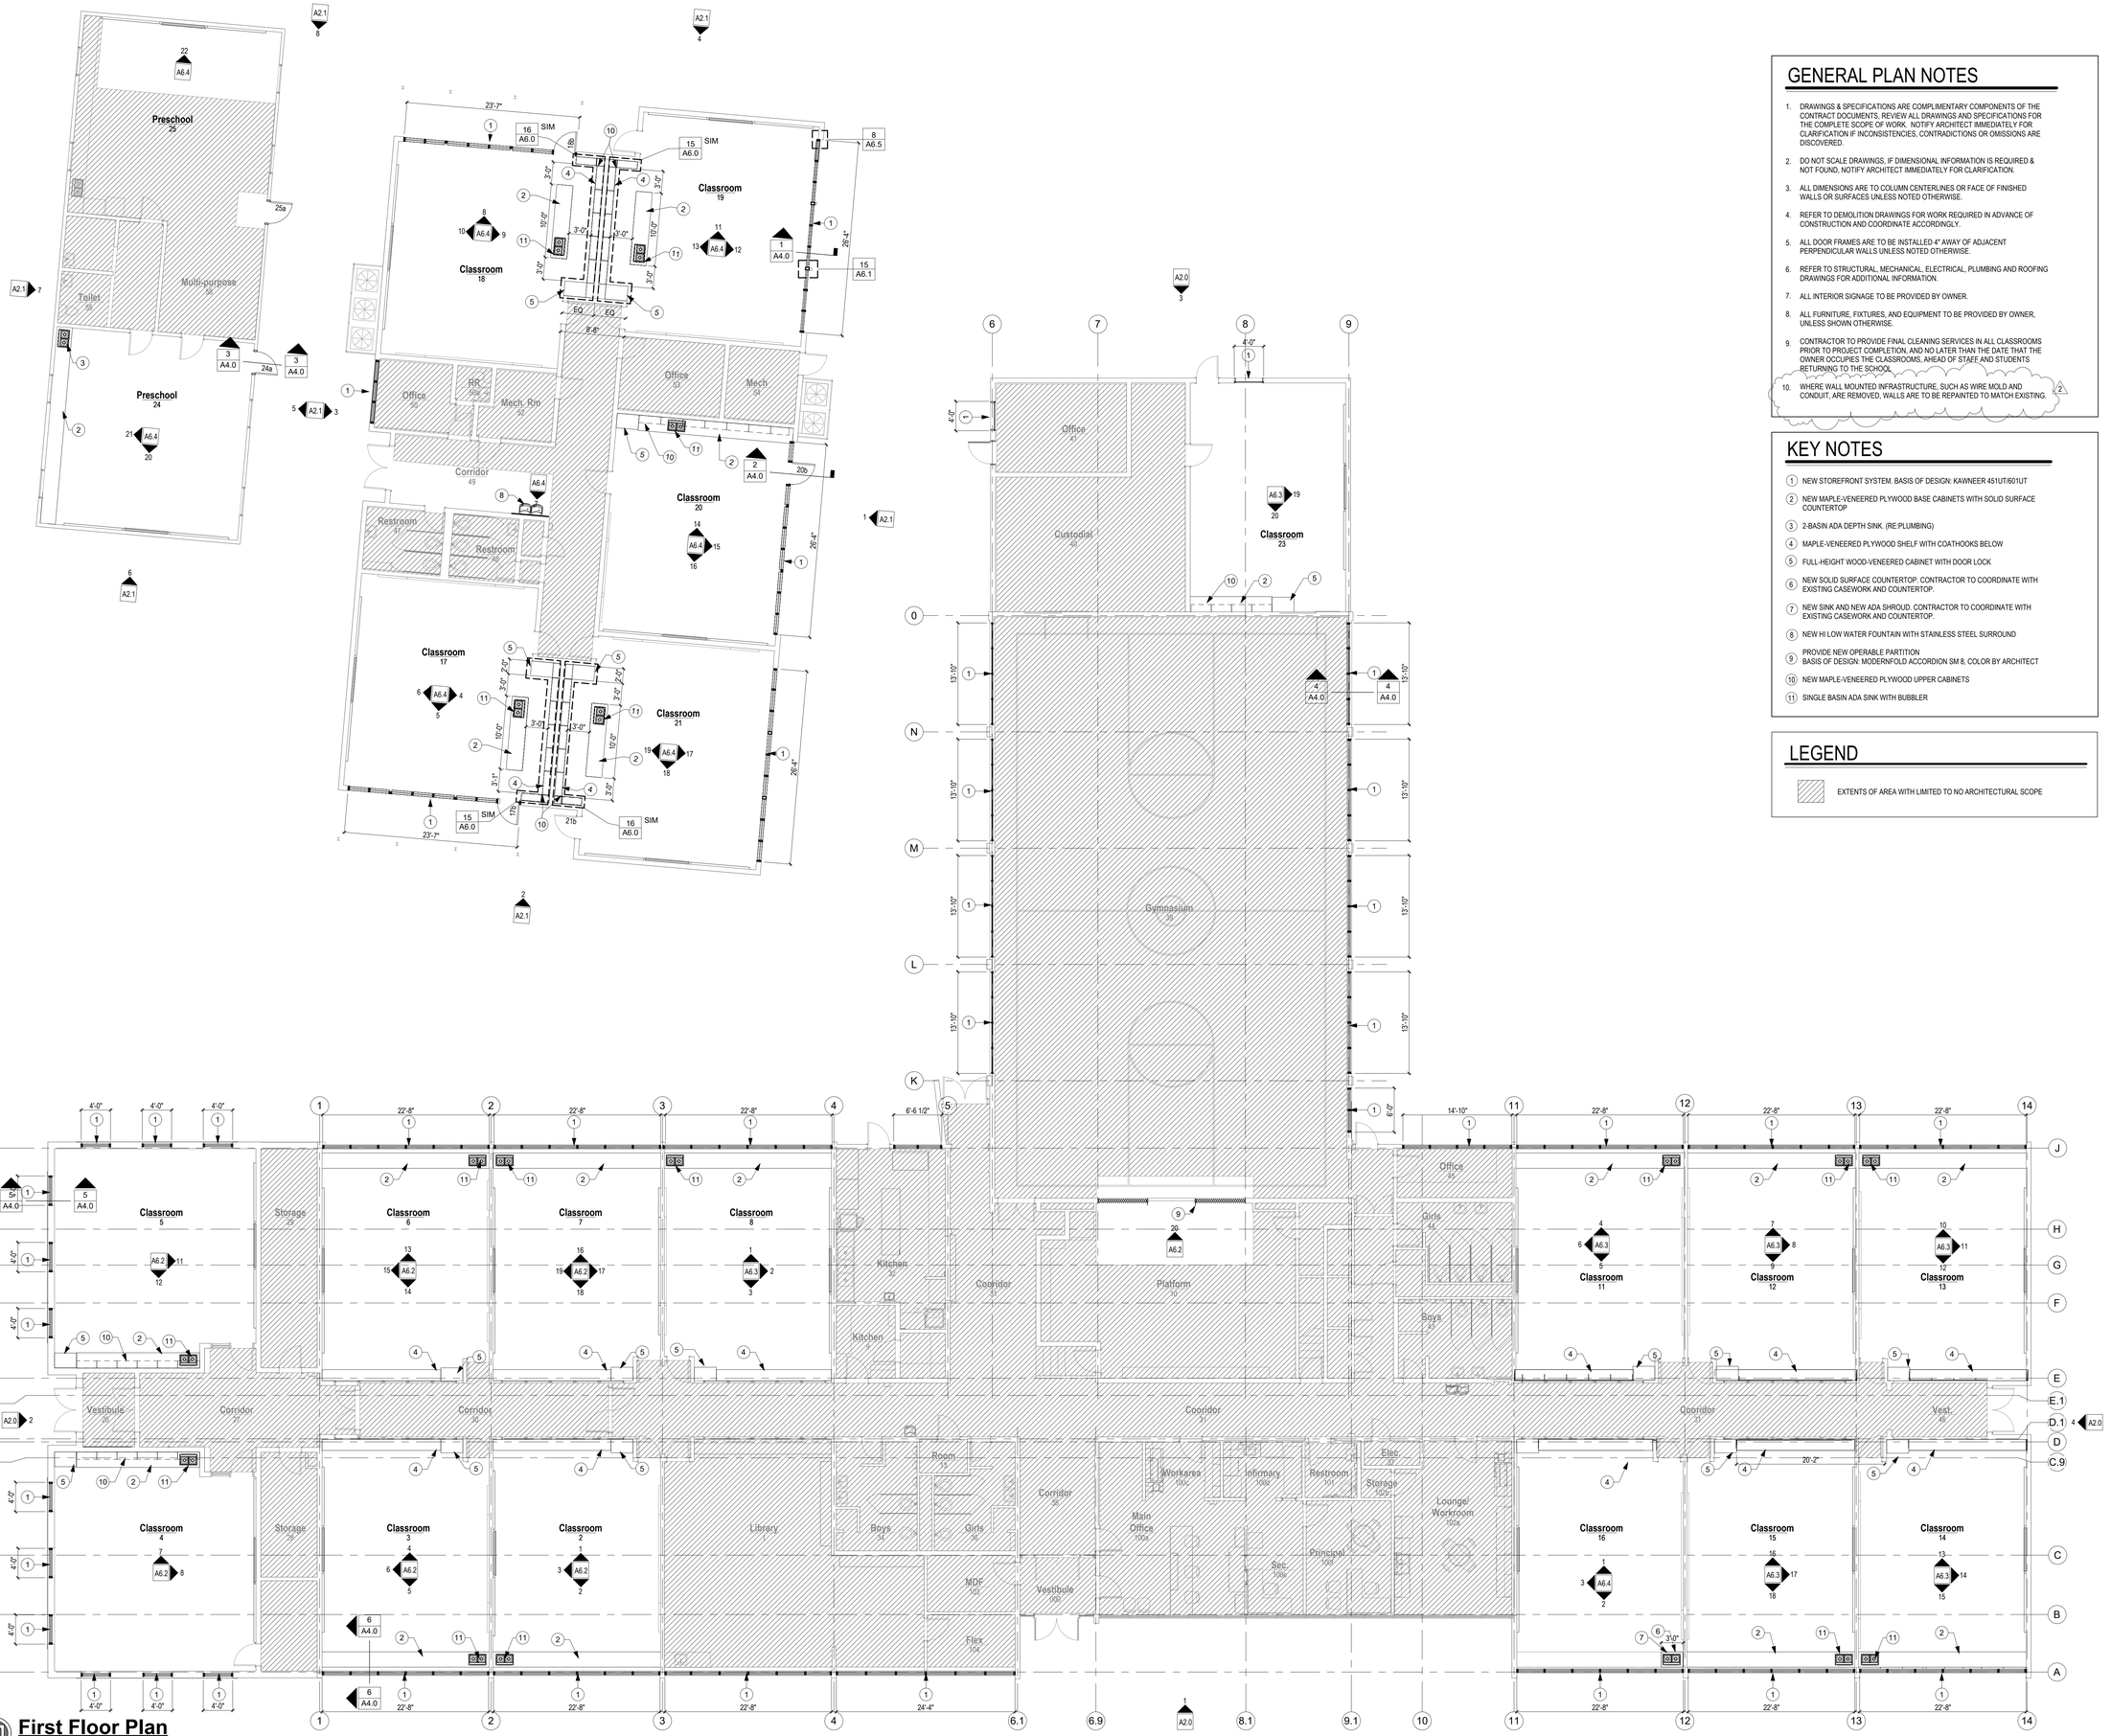

First Floor Plan

SCALE: 1/8" = 1'-0"

GENERAL PLAN NOTES

1. DRAWINGS & SPECIFICATIONS ARE COMPLIMENTARY COMPONENTS OF THE CONTRACT DOCUMENTS, REVIEW ALL DRAWINGS AND SPECIFICATIONS FOR THE COMPLETE SCOPE OF WORK. NOTIFY ARCHITECT IMMEDIATELY FOR CLARIFICATION IF INCONSISTENCIES, CONTRADICTIONS OR OMISSIONS ARE DISCOVERED.
2. DO NOT SCALE DRAWINGS, IF DIMENSIONAL INFORMATION IS REQUIRED & NOT FOUND, NOTIFY ARCHITECT IMMEDIATELY FOR CLARIFICATION.
3. ALL DIMENSIONS ARE TO COLUMN CENTERLINES OR FACE OF FINISHED WALLS OR SURFACES UNLESS NOTED OTHERWISE.
4. REFER TO DEMOLITION DRAWINGS FOR WORK REQUIRED IN ADVANCE OF CONSTRUCTION AND COORDINATE ACCORDINGLY.
5. ALL DOOR FRAMES ARE TO BE INSTALLED 4" AWAY OF ADJACENT PERPENDICULAR WALLS UNLESS NOTED OTHERWISE.
6. REFER TO STRUCTURAL, MECHANICAL, ELECTRICAL, PLUMBING AND ROOFING DRAWINGS FOR ADDITIONAL INFORMATION.
7. ALL INTERIOR SIGNAGE TO BE PROVIDED BY OWNER.
8. ALL FURNITURE, FIXTURES, AND EQUIPMENT TO BE PROVIDED BY OWNER, UNLESS SHOWN OTHERWISE.
9. CONTRACTOR TO PROVIDE FINAL CLEANING SERVICES IN ALL CLASSROOMS PRIOR TO PROJECT COMPLETION, AND NO LATER THAN THE DATE THAT THE OWNER OCCUPIES THE CLASSROOMS, AHEAD OF STAFF AND STUDENTS RETURNING TO THE SCHOOL.
10. WHERE WALL MOUNTED INFRASTRUCTURE, SUCH AS WIRE MOLD AND CONDUIT, ARE REMOVED, WALLS ARE TO BE REPAINTED TO MATCH EXISTING. 2

KEY NOTES

1. NEW STOREFRONT SYSTEM. BASIS OF DESIGN: KAWNEER 451UT/601UT
2. NEW MAPLE-VENEERED PLYWOOD BASE CABINETS WITH SOLID SURFACE COUNTERTOP
3. 2-BASIN ADA DEPTH SINK. (RE:PLUMBING)
4. MAPLE-VENEERED PLYWOOD SHELF WITH COATHOOKS BELOW
5. FULL-HEIGHT WOOD-VENEERED CABINET WITH DOOR LOCK
6. NEW SOLID SURFACE COUNTERTOP. CONTRACTOR TO COORDINATE WITH EXISTING CASEWORK AND COUNTERTOP.
7. NEW SINK AND NEW ADA SHROUD. CONTRACTOR TO COORDINATE WITH EXISTING CASEWORK AND COUNTERTOP.
8. NEW HI LOW WATER FOUNTAIN WITH STAINLESS STEEL SURROUND
9. PROVIDE NEW OPERABLE PARTITION
   BASIS OF DESIGN: MODERNFOLD ACCORDION SM 8, COLOR BY ARCHITECT
10. NEW MAPLE-VENEERED PLYWOOD UPPER CABINETS
11. SINGLE BASIN ADA SINK WITH BUBBLER

LEGEND

EXTENTS OF AREA WITH LIMITED TO NO ARCHITECTURAL SCOPE

DAO ARCHITECTURE

7230 Meade St.
Westminster, CO 80030

Phone: 720.273.0431
Email: dan@daoarch.com
Web: www.daoarch.com

Rev. #	Description	Rev. Date
2	Addendum #1	11/12/2026
Revision Schedule		

Westminster Public Schools

2026 Bond Projects
Fairview PK-8
Renovations

7826 Fairview Ave.
Denver, CO 80221

DAO No.: 2025-033

September 25, 2026

First Floor Plan

A1.0

C:\Users\Anton\AppData\Local\Autodesk\Revit\Autodesk Revit 2026\CollaborationCache\eYSFJ6STGNLYKNSMRIEwle3ocic-dSd1-48ad-58c2-7850481941f2-d7e69a95-bbc2-4d0f-8a37-b9e731d1d564.rvt
11/12/2026 8:54:45 AM



First Floor Equipment Plan

SCALE: 1/8" = 1'-0"

EQUIPMENT SCHEDULE_Area A

ITEM NO.	ITEM DESCRIPTION (MANUFACTURER & MODEL)	QUANTITY	FURNISHED/INSTALLED BY
001	4' X 8' MARKER BOARD, CLARIDGE SERIES 4	42	CONTRACTOR/CONTRACTOR
002	85" MONITOR AND MOUNTING BRACKET	21	CONTRACTOR/CONTRACTOR
003	4' X 12' MARKER BOARD, CLARIDGE SERIES 4	1	CONTRACTOR/CONTRACTOR
005	4' X 4' TACK BOARD, FORBO BULLETIN BOARD	2	CONTRACTOR/CONTRACTOR

Note

TV MONITOR BASIS OF DESIGN : SAMSUNG BE85FX-H BEFX-H SERIES - 85" LED-BACKLIT LCD TV-4K - MFG # BE85FX-H - OR EQUIVALENT

TV BRACKET BASIS OF DESIGN : EATON TRIPP LITE SERIES DISPLAY TV WALL MONITOR MOUNT SWIVEL/TILT 60" TO 100" TVS / EA / FLAT-SCREENS BRACKET - FOR LCD - MFG # DWM60100XX - OR EQUIVALENT

2

DAO ARCHITECTURE

7230 Meade St.
Westminster, CO 80030

Phone: 720.273.0431
Email: dan@daoarch.com
Web: www.daoarch.com

Rev. #	Description	Rev. Date
2	Addendum #1	11/12/2026

Revision Schedule

Westminster Public Schools

2026 Bond Projects
Fairview PK-8
Renovations

7826 Fairview Ave.
Denver, CO 80221


DAO No.: 2025-033

September 25, 2026

Equipment Plan


A1.1

C:\Users\Anson\AppData\Local\Autodesk\Revit\Autodesk Revit 2026\CollaborationCache\YSFJ5STGNLYKNSM0R5ea3o0c-8bz1-46a4-88c2-7860f4819df1\2d7e56d95-3da2-450f-8a37-39e791d1d564.rvt
11/12/2026 8:54:47 AM

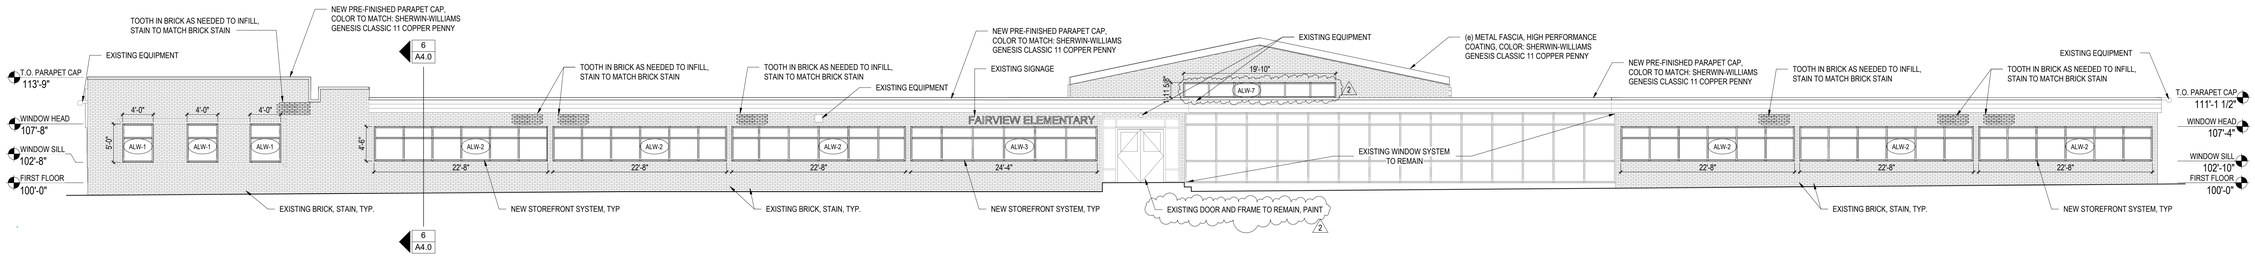

1 Exterior Elevation - Southeast

1 A1.0 SCALE: 1/8" = 1'-0"

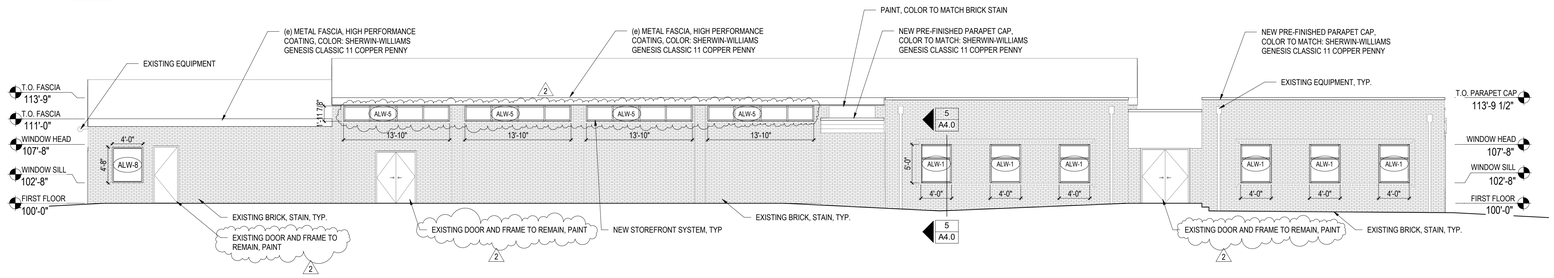

BASIS OF DESIGN LEGEND

EXISTING BRICK

NEW BRICK

ALL BRICK TO BE STAINED, BASIS OF DESIGN: BRICK IMAGING (COLOR BY ARCHITECT)

PAINT ALL NEW AND EXISTING PARAPET CAP, BASIS OF DESIGN: SHERWIN-WILLIAMS FLUROPON CLASSIC 11 COPPER PENNY

Brick Repair Scope General Notes:

1. CONTRACTOR TO FEILD VERIFY EXTENTS OF ALL CRACKED AND/OR DAMAGED BRICK. CONFIRM WITH OWNER FOR DIRECTION ON REPAIR AND REPLACEMENT.
2. CONTRACTOR TO PROVIDE NOT-TO-EXCEED PRICING FOR BRICK RE-POINTING AND REPAIR IN AREAS INDICATED ON THE DRAWINGS, ESTIMATED AT 2,200 SF. PERIMETER X2'. CONTRACTOR TO PROVIDE UNIT PRICING FOR ADDITIONAL AREAS OF REPAIR, AND/OR TO CREDIT AREAS INDICATED THAT ARE FOUND TO NOT NEED REPAIR.

Note

1. ALL SIGNAGE AND EQUIPMENT TO BE REMOVED AS NEEDED FOR STAINING OF BRICK. RE-INSTALL AS REQUIRED.

3 EXISTING KNOX BOXES AND PREMISES IDENTIFICATION REMOVED FOR STAINING SHALL BE REINSTALLED IN THEIR ORIGINAL OR APPROVED LOCATION, AND SHALL REMAIN ACCESSIBLE TO THE FIRE DEPARTMENT THROUGHOUT CONSTRUCTION.


SCAFFOLDING, LIFTS, AND STAGING FOR STAINING AND WINDOW/STOREFRONT WORK SHALL NOT OBSTRUCT FIRE APPARATUS ACCESS ROADS, FIRE HYDRANTS, OR EXIT DISCHARGE.

2. ALL BRICK TO BE STAINED, BASIS OF DESIGN: BRICK IMAGING (COLOR BY ARCHITECT)
3. ALL EXTERIOR DOORS AND FRAMES TO BE PAINTED. COLOR TO BE SELECTED ONCE STAIN COLOR IS SELECTED.

2


2 Exterior Elevation - Southwest

1 A1.0 SCALE: 1/8" = 1'-0"

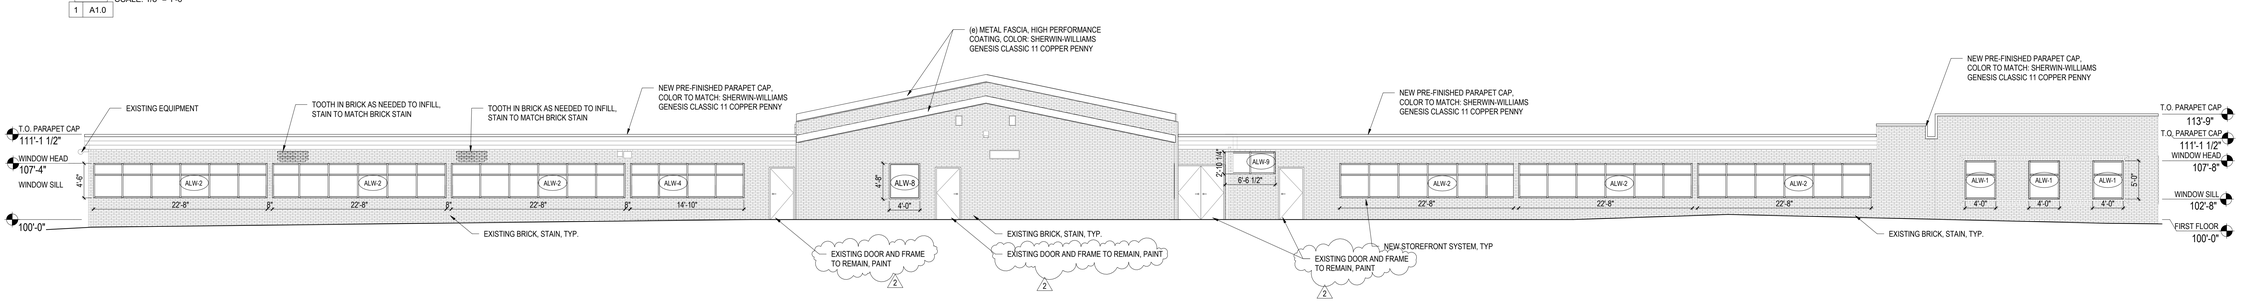

3 Exterior Elevation - Northwest

1 A1.0 SCALE: 1/8" = 1'-0"

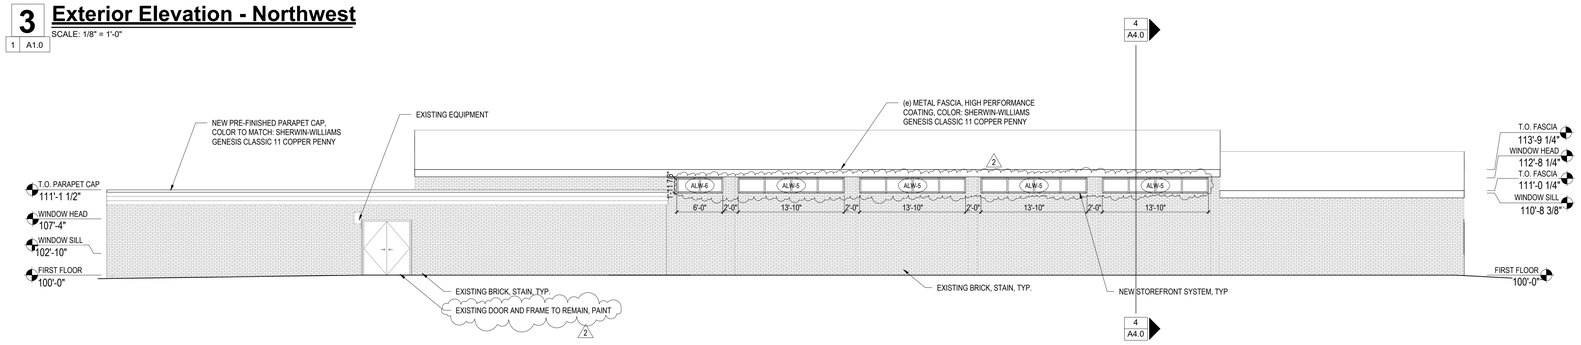

4 Exterior Elevation - Northeast

1 A1.0 SCALE: 1/8" = 1'-0"

DAO ARCHITECTURE
7230 Meade St.
Westminster, CO 80030
Phone: 720.273.0431
Email: dan@daoarch.com
Web: www.daoarch.com

Rev. #	Description	Rev. Date
3	ACFR Review Comments	11/--/2026
2	Addendum #1	11/12/2026

Revision Schedule

Westminster Public Schools

2026 Bond Projects
Fairview PK-8
Renovations

7826 Fairview Ave.
Denver, CO 80221


DAO No.: 2025-033

September 25, 2026

Exterior Elevations

A2.0


C:\Users\Anson\AppData\Local\Autodesk\Revit\Autodesk Revit 2025\Collaboration\Cache\YSPJISTGNLYKNSMRR5ee3ddc-d8c1-4fce-88c2-7f8f04f51941\2cf7bf6fe95-1ba2-4d0f-9a37-4fe473f1d1564.rvt
11/12/2026 8:54:53 AM

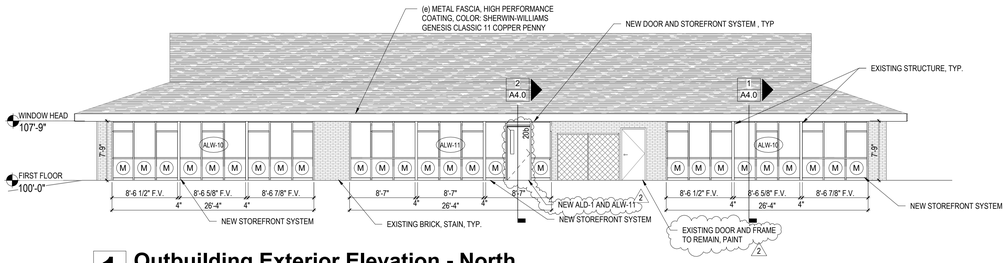

1 Outbuilding Exterior Elevation - North

SCALE: 1/8" = 1'-0"


1 A1.0

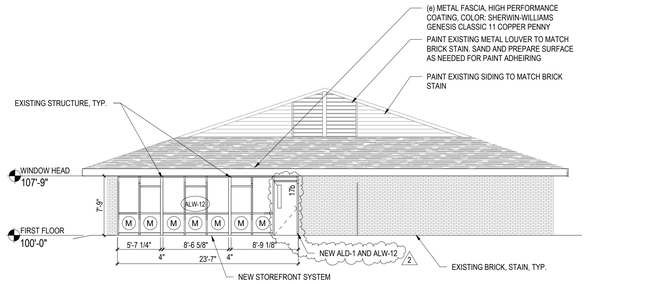

2 Outbuilding Exterior Elevation - East

SCALE: 1/8" = 1'-0"


1 A1.0

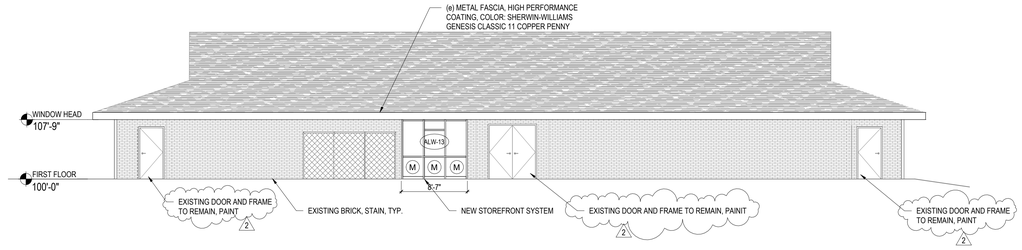

3 Outbuilding Exterior Elevation - South

SCALE: 1/8" = 1'-0"


1 A1.0

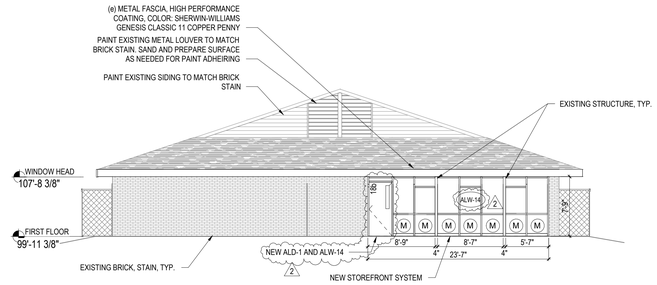

4 Outbuilding Exterior Elevation - West

SCALE: 1/8" = 1'-0"


1 A1.0

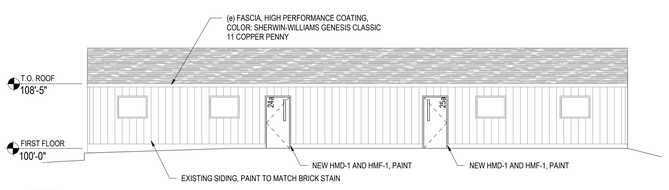

5 Modular Exterior Elevation - North

SCALE: 1/8" = 1'-0"


1 A1.0

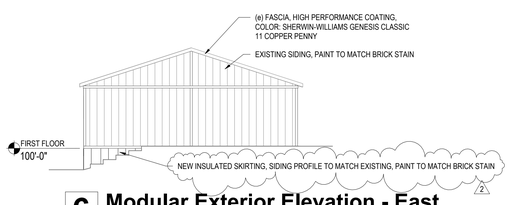

6 Modular Exterior Elevation - East

SCALE: 1/8" = 1'-0"


1 A1.0

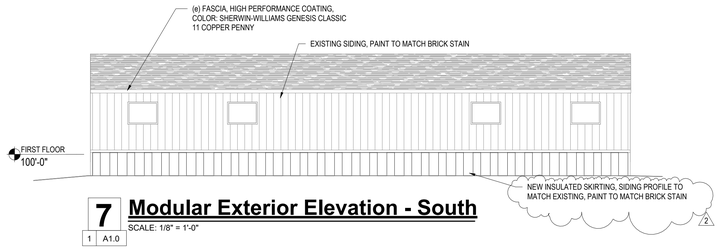

7 Modular Exterior Elevation - South

SCALE: 1/8" = 1'-0"

1 A1.0

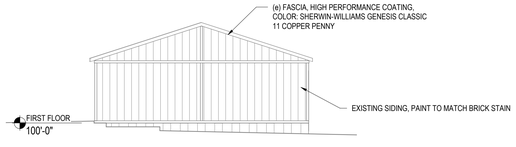

8 Modular Exterior Elevation - West

SCALE: 1/8" = 1'-0"

1 A1.0

Note

1. ALL SIGNAGE AND EQUIPMENT TO BE REMOVED AS NEEDED FOR STAINING OF BRICK. RE-INSTALL AS REQUIRED.
2. EXISTING KNOX BOXES AND PREMISES IDENTIFICATION REMOVED FOR STAINING SHALL BE REINSTALLED IN THEIR ORIGINAL OR APPROVED LOCATION, AND SHALL REMAIN ACCESSIBLE TO THE FIRE DEPARTMENT THROUGHOUT CONSTRUCTION.
3. SCAFFOLDING, LIFTS, AND STAGING FOR STAINING AND WINDOW/STOREFRONT WORK SHALL NOT OBSTRUCT FIRE APPARATUS ACCESS ROADS, FIRE HYDRANTS, OR EXIT DISCHARGE.
4. ALL BRICK TO BE STAINED, BASIS OF DESIGN: BRICK IMAGING (COLOR BY ARCHITECT)
5. ALL EXTERIOR DOORS AND FRAMES TO BE PAINTED. COLOR TO BE SELECTED ONCE STAIN COLOR IS SELECTED.

2

LEGEND

M — INSULATED PANELS IN PLACE OF GLAZING, BASIS OF DESIGN: MAPES, MAPES-R INFILL PANEL

GLAZING WITH 3M S800 SECURITY FILM

Brick Repair Scope General Notes:

1. CONTRACTOR TO FEILD VERIFY EXTENTS OF ALL CRACKED AND/OR DAMAGED BRICK. CONFIRM WITH OWNER FOR DIRECTION ON REPAIR AND REPLACEMENT.
2. CONTRACTOR TO PROVIDE NOT-TO-EXCEED PRICING FOR BRICK RE-POINTING AND REPAIR IN AREAS INDICATED ON THE DRAWINGS, ESTIMATED AT 2,200 SF. PERIMETER X2'. CONTRACTOR TO PROVIDE UNIT PRICING FOR ADDITIONAL AREAS OF REPAIR, AND/OR TO CREDIT AREAS INDICATED THAT ARE FOUND TO NOT NEED REPAIR.

BASIS OF DESIGN LEGEND

EXISTING BRICK

NEW BRICK

ALL BRICK TO BE STAINED, BASIS OF DESIGN: BRICK IMAGING (COLOR BY ARCHITECT)

PAINT ALL NEW AND EXISTING PARAPET CAP, BASIS OF DESIGN: SHERWIN-WILLIAMS FLUROPON CLASSIC 11 COPPER PENNY

DAO ARCHITECTURE

7230 Meade St.
Westminster, CO 80030

Phone: 720.273.0431
Email: dan@daoarch.com
Web: www.daoarch.com

Rev. #	Description	Rev. Date
3	ACFR Review Comments	11/--/2026
2	Addendum #1	11/12/2026

Revision Schedule

Westminster Public Schools

2026 Bond Projects
Fairview PK-8
Renovations

7826 Fairview Ave,
Denver, CO 80221


DAO No.: 2025-033

September 25, 2026

Exterior Elevations

A2.1


C:\Users\Anoor\AppData\Local\Autodesk\Revit\Autodesk Revit 2025\Collaboration\Cache\YSPJSST1ONLYKNSMRI\Se83dbc-d8c1-4fad-88c2-7892481941f12\d7de6d95-bba2-4d0f-8a37-d6ef73f1d1564.rvt
11/12/2026 8:54:55 AM

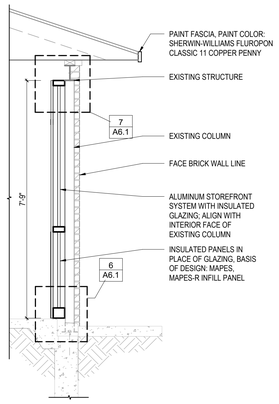

1 Wall Section

SCALE: 1/2" = 1'-0"


1 | A1.0

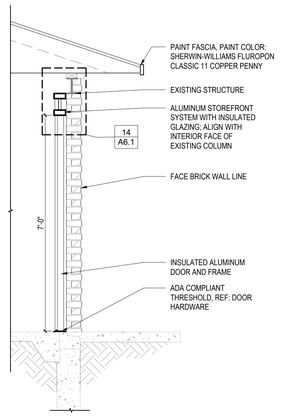

2 Wall Section

SCALE: 1/2" = 1'-0"


1 | A1.0

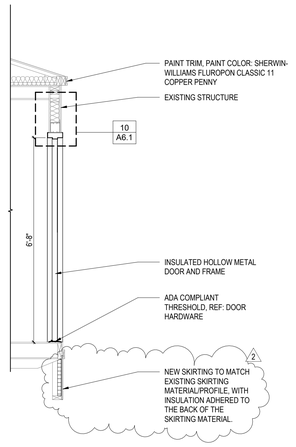

3 Wall Section

SCALE: 1/2" = 1'-0"


1 | A1.0

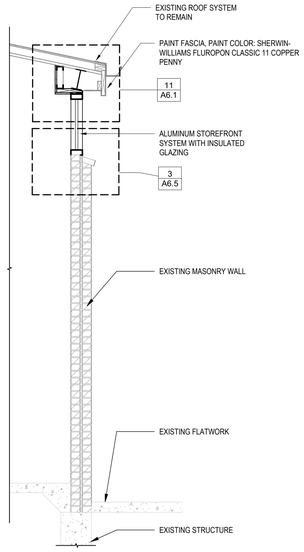

4 Wall Section

SCALE: 1/2" = 1'-0"


1 | A1.0

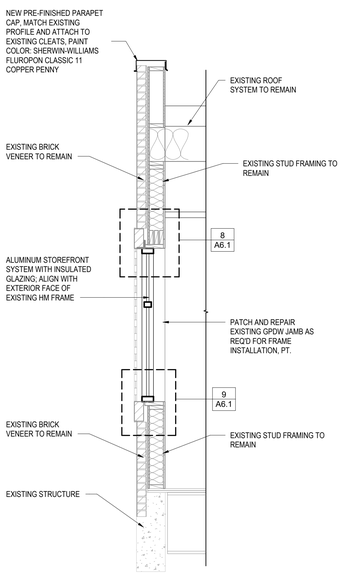

5 Wall Section

SCALE: 1/2" = 1'-0"

1 | A1.0

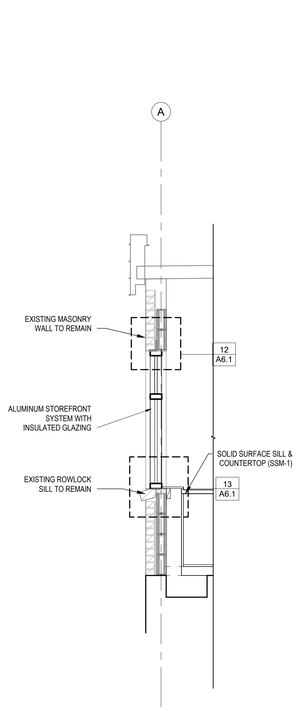

6 Wall Section

SCALE: 1/2" = 1'-0"

1 | A1.0

DAO ARCHITECTURE

7230 Meade St.
Westminster, CO 80030

Phone: 720.273.0431
Email: dan@daoarch.com
Web: www.daoarch.com

Rev. #	Description	Rev. Date
2	Addendum #1	11/12/2026

Revision Schedule

Westminster Public Schools

2026 Bond Projects
Fairview PK-8
Renovations

7826 Fairview Ave.
Denver, CO 80221


DAO No.: 2025-033

September 25, 2026

Wall Section


A4.0

C:\Users\Anoon\AppData\Local\Autodesk\Revit\Autodesk Revit 2026\Collaboration\Cache\Y3P-RSTGNLYKNSNRF6ea3ddc-d8c1-4fa4-88c2-7860481941f2-07a95a895-bba2-4a0f-9a37-a8e73f1ef1564.rvt
11/12/2026 8:54:56 AM

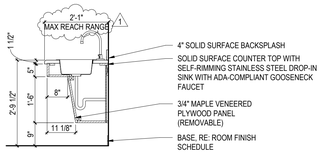


1 Sink Base Cabinet Only

SCALE: 1/2" = 1'-0"

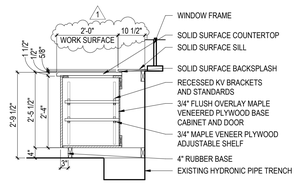


2 Base Cabinet Only - Trench

SCALE: 1/2" = 1'-0"

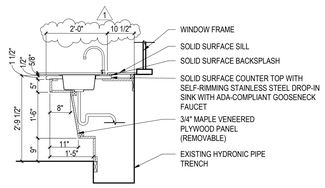

3 Sink Base Cabinet Only - Trench

SCALE: 1/2" = 1'-0"

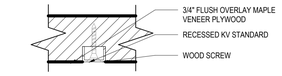


4 Typ. Recessed KV Standard

SCALE: 12" = 1'-0"


CASEWORK GENERAL NOTES

1. ALL CASEWORK SHALL BE CONSTRUCTED TO MEET THE FOLLOWING AWI CONSTRUCTION GRADES:
   WOOD VENEERED PLYWOOD CASEWORK (MAPLE)
   -AWI GRADE = CUSTOM
2. TYPICAL MATERIALS:
   -HEAVY DUTY DRAWER SLIDES
   -FIVE KNUCKLE HINGES
   -WIRE PULLS
   -METAL SHELF CLIPS IN K.V. STANDARS
   -SOLID SURFACE COUNTERTOPS AND BACKSPLASH
3. ALL CASEWORK SHALL BE FLUSH OVERLAY STYLE, CONSTRUCTED USING WOOD VENEERED PLYWOOD IN THE THICKNESSES INDICATED ON DRAWINGS.
4. SEE SHEET A9.0 FOR FINISH SELECTIONS
5. RECESS ALL KV STANDARDS PER DETAIL 7 ON SHEET A6.2
6. BOTH SIDES OF TEACHERS CABINET SHALL BE LOCKABLE. LOCKS SHOULD BE COMPATIBLE WITH DISTRICT STANDARD (BEST 1CP7WC1626 CORES)

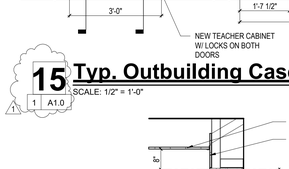

5 Base Cabinet Only


SCALE: 1/2" = 1'-0"

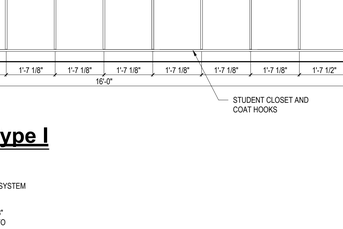

6 Teacher Cabinet - Left

1 A6.2


SCALE: 1/2" = 1'-0"

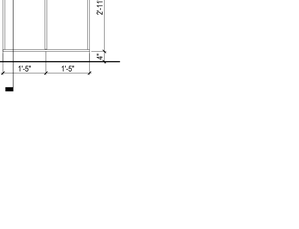

7 Teacher Cabinet - Right

1 A6.2


SCALE: 1/2" = 1'-0"

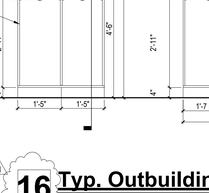

8 Casework Section

1 A6.2

SCALE: 1/2" = 1'-0"

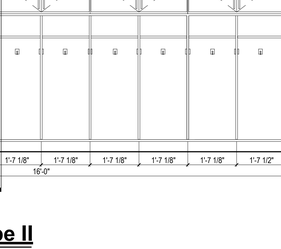

9 Sink Base Cabinet w/ 24" Uppers

7 A6.2

SCALE: 1/2" = 1'-0"

10 Base Open Cabinet w/ 30" Uppers

7 A6.2

SCALE: 1/2" = 1'-0"

11 Teacher Cabinet - Left

15 A6.0

SCALE: 1/2" = 1'-0"

12 Teacher Cabinet - Right

15 A6.0

SCALE: 1/2" = 1'-0"

13 Sink Base Cabinet Only


4 A6.4

SCALE: 1/2" = 1'-0"

14 Base Cabinet Only

4 A6.4


SCALE: 1/2" = 1'-0"

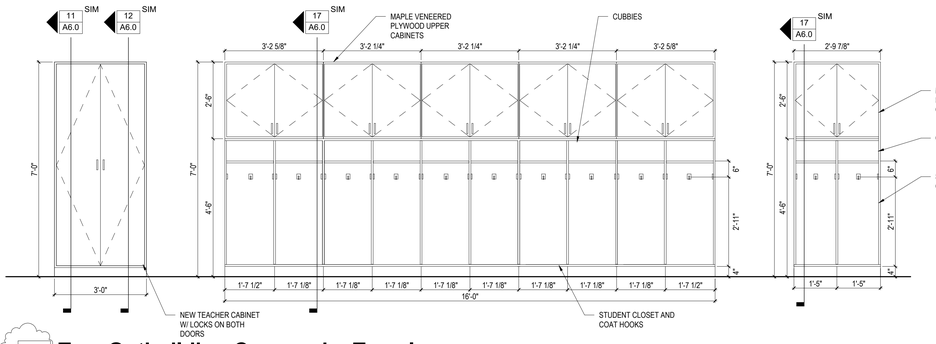

15 Typ. Outbuilding Casework - Type I

1 A1.0

SCALE: 1/2" = 1'-0"

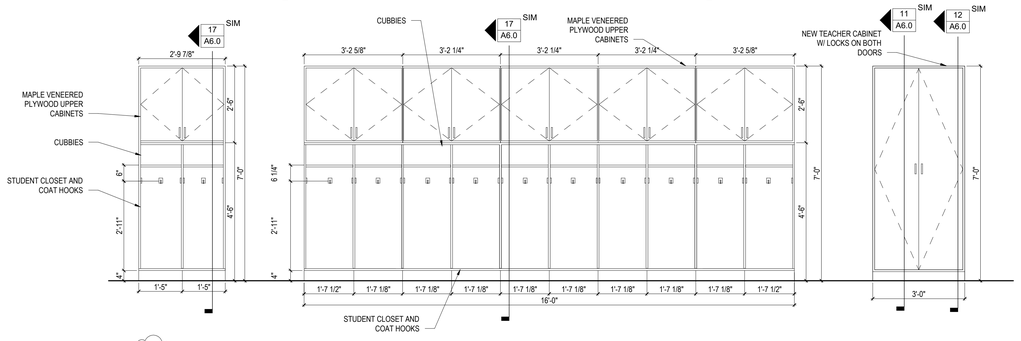

16 Typ. Outbuilding Casework - Type II

1 A1.0

SCALE: 1/2" = 1'-0"

17 Casework Section

15 A6.0

SCALE: 1/2" = 1'-0"

DAO ARCHITECTURE
7230 Meade St.
Westminster, CO 80030
Phone: 720.273.0431
Email: dan@daoarch.com
Web: www.daoarch.com

Rev. #	Description	Rev. Date
2	Addendum #1	11/12/2026
1	DFPC Review Comments	11/--/2026

Revision Schedule

Westminster Public Schools

2026 Bond Projects
Fairview PK-8
Renovations

7826 Fairview Ave.
Denver, CO 80221


DAO No.: 2025-033


September 25, 2026

Casework Sections

A6.0

C:\Users\Arvon\AppData\Local\Autodesk\Revit\Autodesk Revit 2026\Collaboration\Cache\YSFr9ST1GNLYKNSMRI5ee3dcc-d8c1-4fad-88b2-7860481fa812\2d7d66d95-bba2-40df-8a37-68e73f1d1954.rvt
11/12/2026 8:54:58 AM

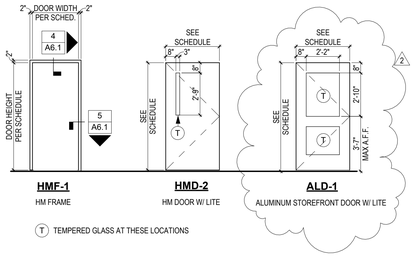

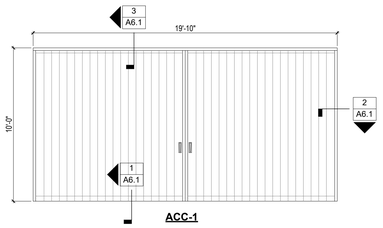

2

DOOR AND FRAME SCHEDULE

IDENTIFICATION			DIMENSIONS			FRAME		
DOOR NO.	ROOM NO.	ROOM NAME	WIDTH	HEIGHT	DOOR TYPE	TYPE	HARDWARE	REMARKS
17b	17	Classroom	3' - 0"	7' - 0"	ALD-1	ALW-12	01	Storeroom, Small Lite, Paint Door and Frame
18b	18	Classroom	3' - 0"	7' - 0"	ALD-1	ALW-14	01	Storeroom, Small Lite, Paint Door and Frame
20b	20	Classroom	3' - 0"	7' - 0"	ALD-1	ALW-11	01	Storeroom, Small Lite, Paint Door and Frame
24a	24	Preschool	3' - 0"	6' - 8"	HMD-1	HMF-1	02	Panic Bar, Small Lite, Paint Door and Frame
25a	25	Preschool	3' - 0"	6' - 8"	HMD-1	HMF-1	02	Panic Bar, Small Lite, Paint Door and Frame


NOTE:
(E) = EXISTING DOOR AND FRAME

1. GENERAL CONTRACTOR TO VERIFY EXISTING DOORS AND/OR FRAMES AND COORDINATE REQUIRED PREPARATION.
2. DO NOT PAINT ANY EXISTING PRE-FINISHED MULLIONS WHICH ARE TO REMAIN.


BASIS-OF-DESIGN:
1. EXTERIOR HOLLOW METAL DOORS: CURRIES 707 Q-MAX OR EQUAL. MAX U-FACTOR 037
2. ALL LITES WITHIN HOLLOW METAL OR WOOD DOORS ARE TO BE ANEMOSTAT LOPRO LITE KITS

2


Door and Frame Types

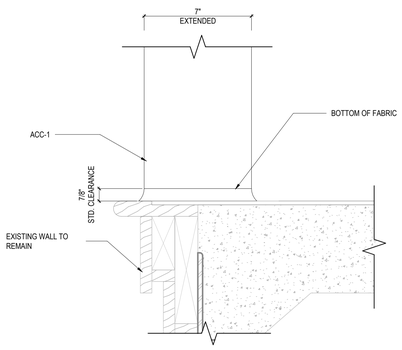


1 ACC - 1 Frame Sill Detail
1.0 A6.1
SCALE: 3" = 1'-0"

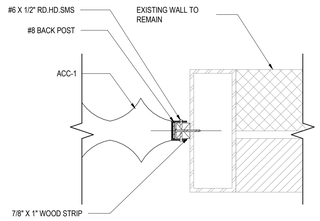


2 ACC - 1 Frame Jambl Detail
1.0 A6.1
SCALE: 3" = 1'-0"

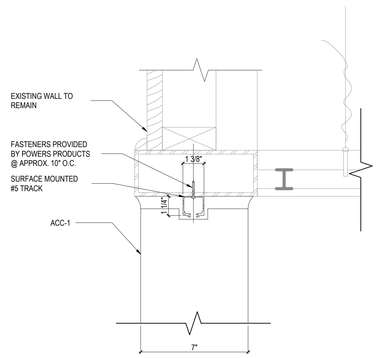


3 ACC - 1 Frame Head Detail
1.0 A6.1
SCALE: 3" = 1'-0"

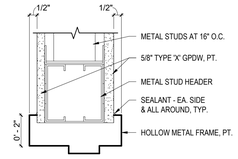


4 HM Frame Head Detail
1.0 A6.1
SCALE: 3" = 1'-0"

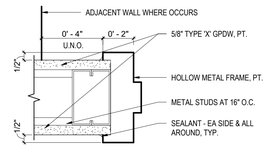


5 HM Frame Jamb Detail
1.0 A6.1
SCALE: 3" = 1'-0"

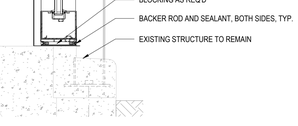


6 Section Detail
1 A4.0
SCALE: 1 1/2" = 1'-0"

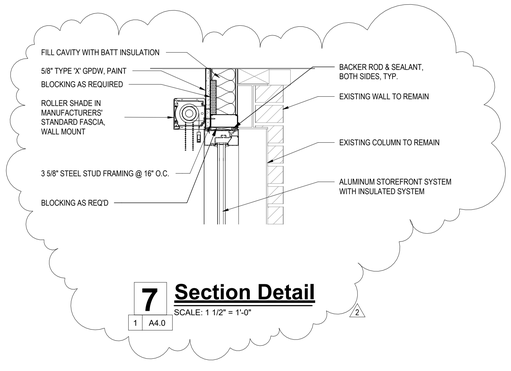


7 Section Detail
1 A4.0
SCALE: 1 1/2" = 1'-0"

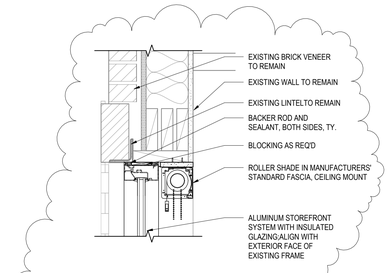


8 Section Detail
5 A4.0
SCALE: 1 1/2" = 1'-0"

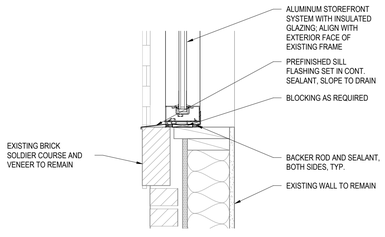


9 Section Detail
5 A4.0
SCALE: 1 1/2" = 1'-0"

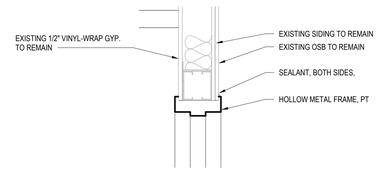


10 Section Detail
3 A4.0
SCALE: 1 1/2" = 1'-0"

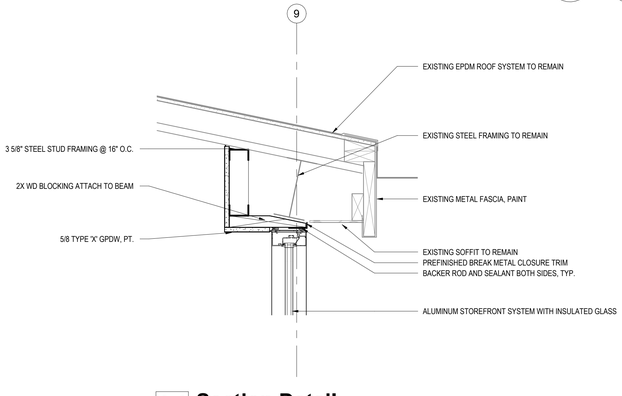


11 Section Detail
4 A4.0
SCALE: 1 1/2" = 1'-0"

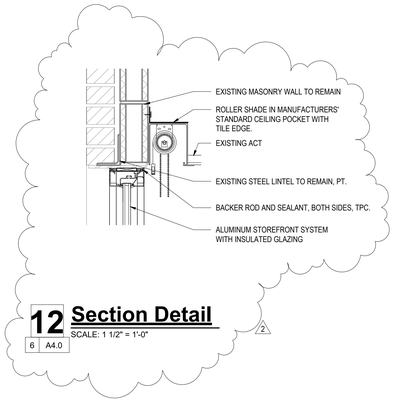


12 Section Detail
6 A4.0
SCALE: 1 1/2" = 1'-0"

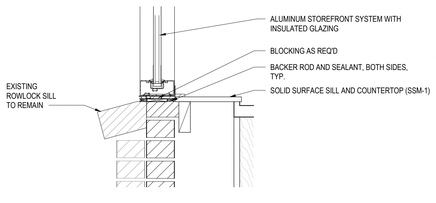

13 Section Detail
6 A4.0
SCALE: 1 1/2" = 1'-0"

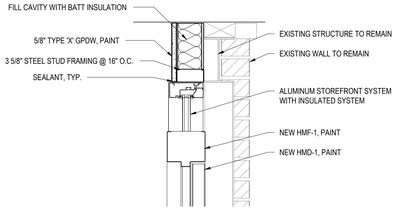

14 Section Detail
2 A4.0
SCALE: 1 1/2" = 1'-0"

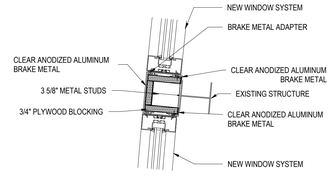

15 Detail
1 A1.0
SCALE: 1 1/2" = 1'-0"

DAO ARCHITECTURE
7230 Meade St.
Westminster, CO 80030
Phone: 720.273.0431
Email: dan@daoarch.com
Web: www.daoarch.com

Rev. #	Description	Rev. Date
2	Addendum #1	11/12/2026

Revision Schedule

Westminster Public Schools

2026 Bond Projects
Fairview PK-8
Renovations

7826 Fairview Ave,
Denver, CO 80221

DAO No.: 2025-033


September 25, 2026

Details/Door Schedule/Door & Window Details

A6.1


C:\Users\Arpor\AppData\Local\Autodesk\Revit\Autodesk Revit 2026\Collaboration\Cache\YSPJDSTONLYKNSMRRe4.3ddc-d8c1-4fad-88c2-7892481941f7.rvt 11/12/2026 8:54:59 AM

EQUIPMENT SCHEDULE_Area A			
ITEM NO.	ITEM DESCRIPTION (MANUFACTURER & MODEL)	QUANTITY	FURNISHED/INSTALLED BY
001	4' X 8' MARKER BOARD, CLARIDGE SERIES 4	42	CONTRACTOR/CONTRACTOR
002	85" MONITOR AND MOUNTING BRACKET	21	CONTRACTOR/CONTRACTOR
003	4' X 12' MARKER BOARD, CLARIDGE SERIES 4	1	CONTRACTOR/CONTRACTOR
005	4' X 4' TACK BOARD, FORBO BULLETIN BOARD	2	CONTRACTOR/CONTRACTOR

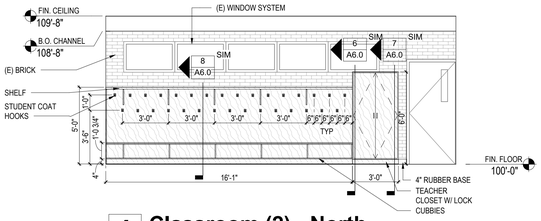


1 Classroom (2) - North

1 | A1.0 SCALE: 1/4" = 1'-0"

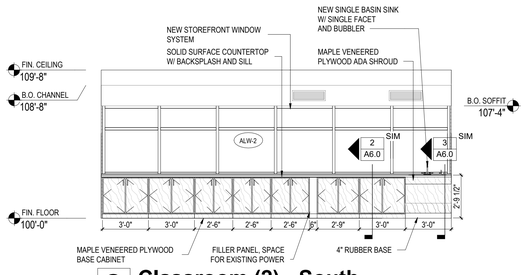


2 Classroom (2) - South

1 | A1.0 SCALE: 1/4" = 1'-0"

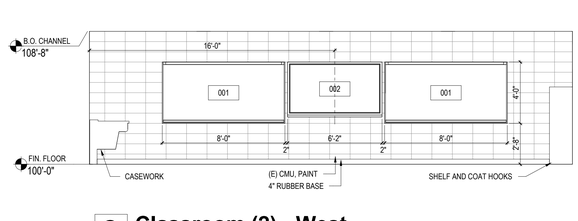


3 Classroom (2) - West

1 | A1.0 SCALE: 1/4" = 1'-0"

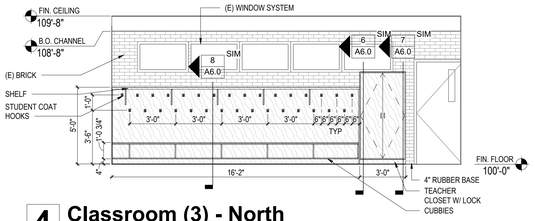


4 Classroom (3) - North

1 | A1.0 SCALE: 1/4" = 1'-0"

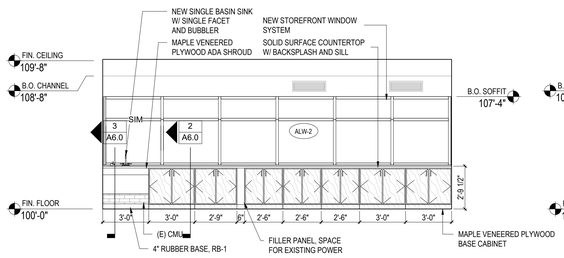


5 Classroom (3) - South

1 | A1.0 SCALE: 1/4" = 1'-0"

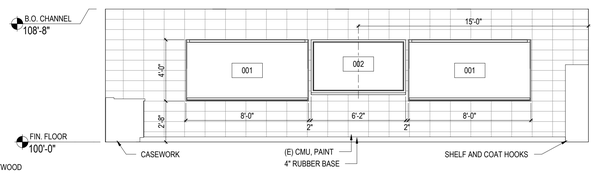


6 Classroom (3) - West

1 | A1.0 SCALE: 1/4" = 1'-0"

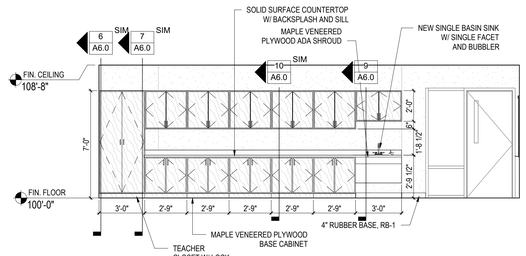


7 Classroom (4) - North

1 | A1.0 SCALE: 1/4" = 1'-0"

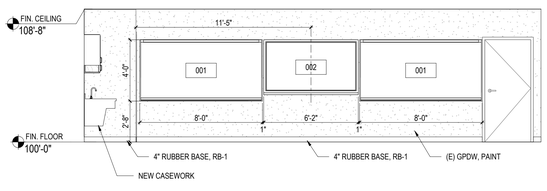


8 Classroom (4) - East

1 | A1.0 SCALE: 1/4" = 1'-0"

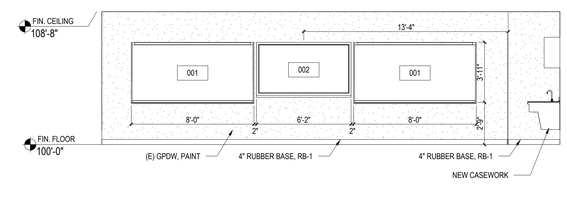


11 Classroom (5) - East

1 | A1.0 SCALE: 1/4" = 1'-0"

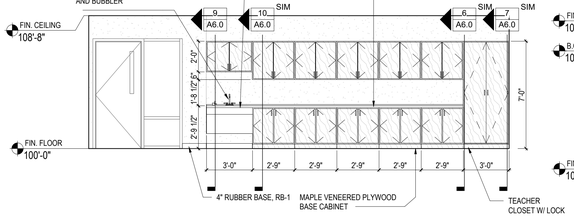


12 Classroom (5) - South

1 | A1.0 SCALE: 1/4" = 1'-0"

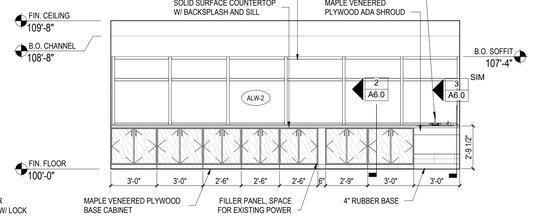


13 Classroom (6) - North

1 | A1.0 SCALE: 1/4" = 1'-0"

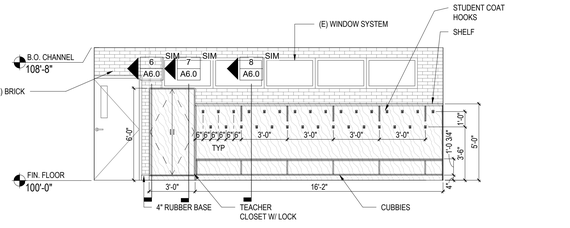


14 Classroom (6) - South

1 | A1.0 SCALE: 1/4" = 1'-0"

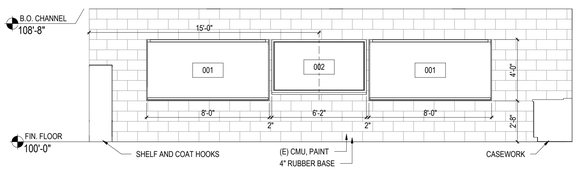


15 Classroom (6) - West

1 | A1.0 SCALE: 1/4" = 1'-0"

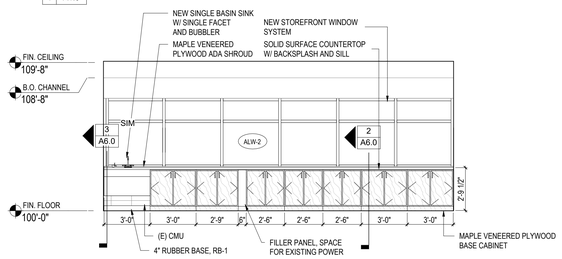


16 Classroom (7) - North

1 | A1.0 SCALE: 1/4" = 1'-0"

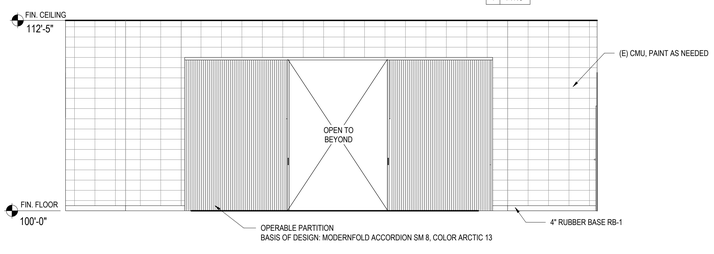


20 Platform (10) - North

1 | A1.0 SCALE: 1/4" = 1'-0"

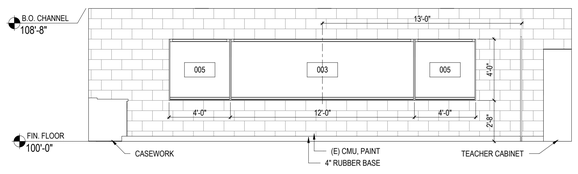


17 Classroom (7) - East

1 | A1.0 SCALE: 1/4" = 1'-0"

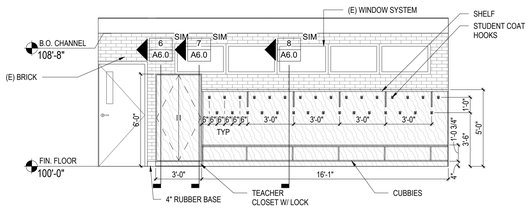

18 Classroom (7) - South

1 | A1.0 SCALE: 1/4" = 1'-0"

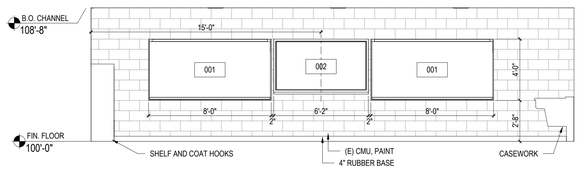

19 Classroom (7) - West

1 | A1.0 SCALE: 1/4" = 1'-0"

DAO ARCHITECTURE

7230 Meade St.
Westminster, CO 80030

Phone: 720.273.0431
Email: dan@daoarch.com
Web: www.daoarch.com

Rev. #	Description	Rev. Date
2	Addendum #1	11/12/2026

Revision Schedule

Westminster Public Schools

2026 Bond Projects
Fairview PK-8
Renovations

7826 Fairview Ave.
Denver, CO 80221

DAO No.: 2025-033


September 25, 2026

Interior Elevations

A6.2


C:\Users\Anon\AppData\Local\Autodesk\Revit\Autodesk Revit 2025\Collaboration\Cache\WPSPJISTONLYKNSMRRe5ssbc-db1-4fce-88cc-7864f4194f12\d7de6d95-bba2-440f-9a37-d6e73f1d1564.rvt
11/17/2026 8:55:55 AM

EQUIPMENT SCHEDULE, Area A			
ITEM NO.	ITEM DESCRIPTION (MANUFACTURER & MODEL)	QUANTITY	FURNISHED/INSTALLED BY
001	4' X 8' MARKER BOARD, CLARIDGE SERIES 4	42	CONTRACTOR/CONTRACTOR
002	85" MONITOR AND MOUNTING BRACKET	21	CONTRACTOR/CONTRACTOR
003	4' X 12' MARKER BOARD, CLARIDGE SERIES 4	1	CONTRACTOR/CONTRACTOR
005	4' X 4' TACK BOARD, FORBO BULLETIN BOARD	2	CONTRACTOR/CONTRACTOR

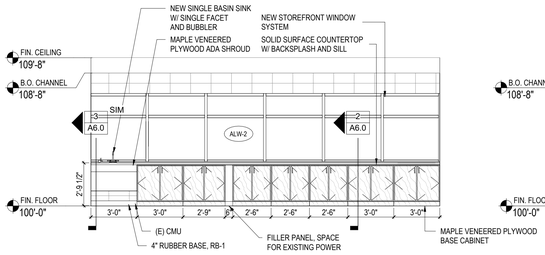


1 Classroom (8) - North

1 | A1.0 SCALE: 1/4" = 1'-0"

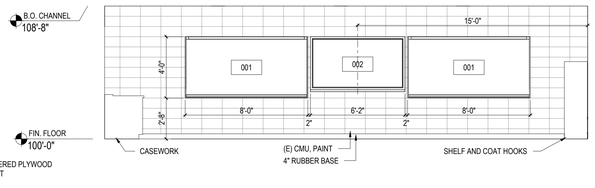


2 Classroom (8) - East

1 | A1.0 SCALE: 1/4" = 1'-0"

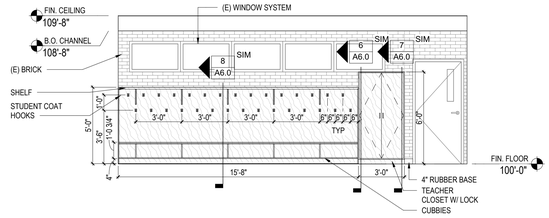


3 Classroom (8) - South

1 | A1.0 SCALE: 1/4" = 1'-0"

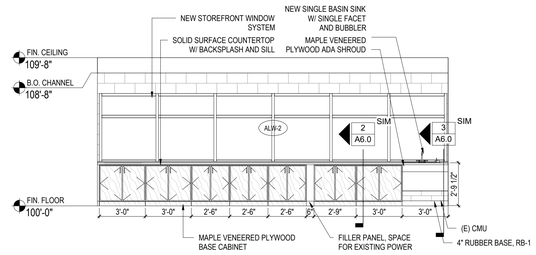


4 Classroom (11) - North

1 | A1.0 SCALE: 1/4" = 1'-0"

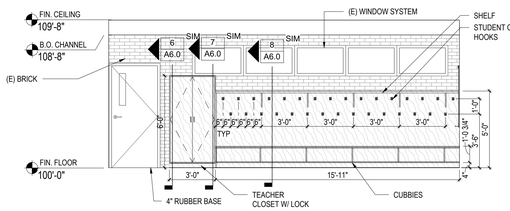


5 Classroom (11) - South

1 | A1.0 SCALE: 1/4" = 1'-0"

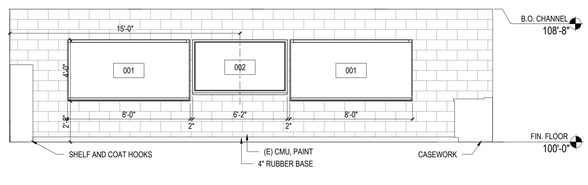


6 Classroom (11) - West

1 | A1.0 SCALE: 1/4" = 1'-0"

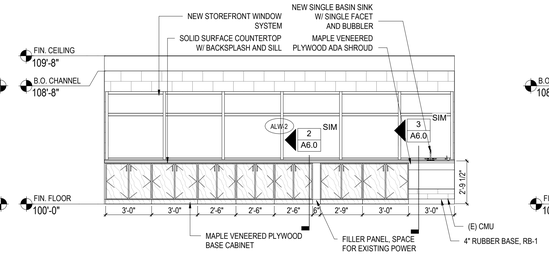


7 Classroom (12) - North

1 | A1.0 SCALE: 1/4" = 1'-0"

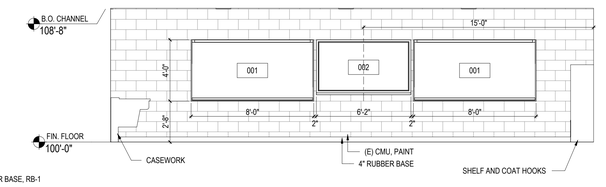


8 Classroom (12) - East

1 | A1.0 SCALE: 1/4" = 1'-0"

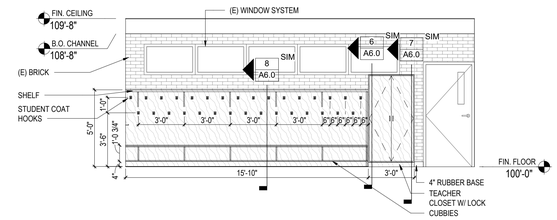


9 Classroom (12) - South

1 | A1.0 SCALE: 1/4" = 1'-0"

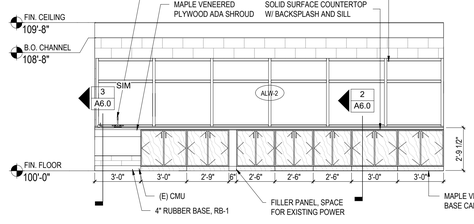


10 Classroom (13) - North

1 | A1.0 SCALE: 1/4" = 1'-0"

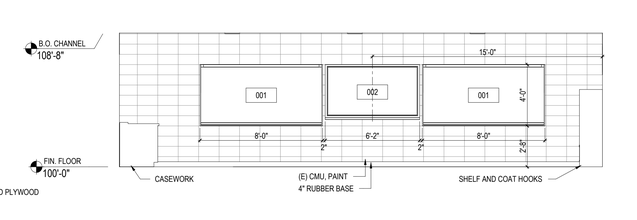


11 Classroom (13) - East

1 | A1.0 SCALE: 1/4" = 1'-0"

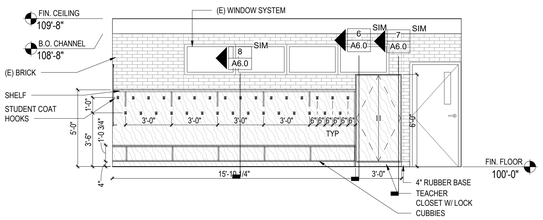


12 Classroom (13) - South

1 | A1.0 SCALE: 1/4" = 1'-0"

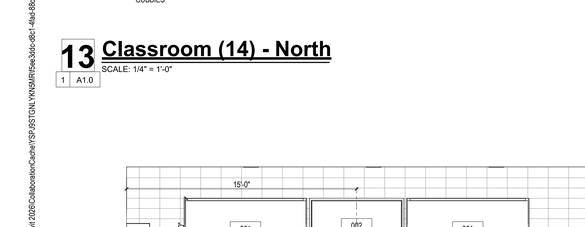


13 Classroom (14) - North

1 | A1.0 SCALE: 1/4" = 1'-0"

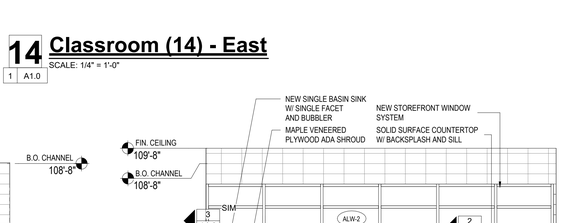


14 Classroom (14) - East

1 | A1.0 SCALE: 1/4" = 1'-0"

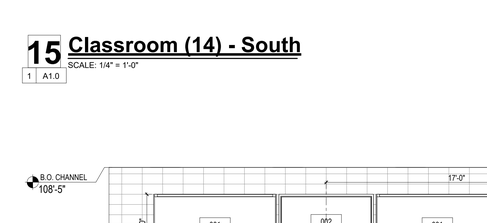


15 Classroom (14) - South

1 | A1.0 SCALE: 1/4" = 1'-0"

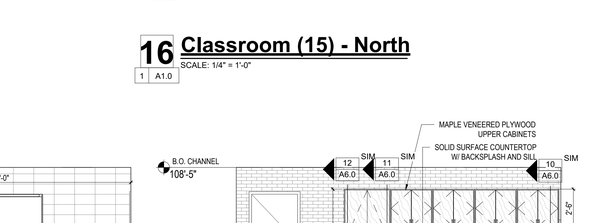


16 Classroom (15) - North

1 | A1.0 SCALE: 1/4" = 1'-0"

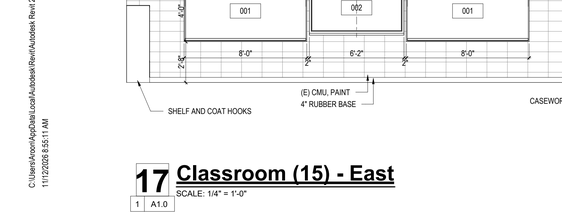


17 Classroom (15) - East

1 | A1.0 SCALE: 1/4" = 1'-0"

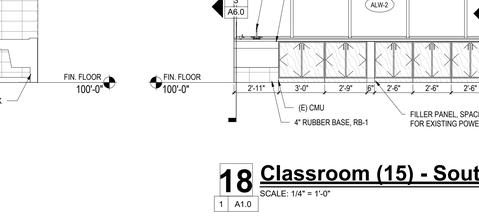

18 Classroom (15) - South

1 | A1.0 SCALE: 1/4" = 1'-0"

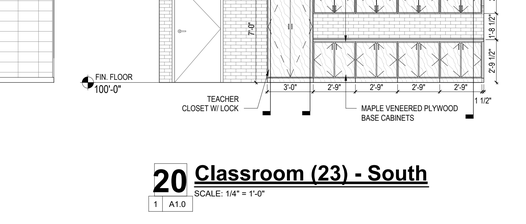

19 Classroom (23) - East

1 | A1.0 SCALE: 1/4" = 1'-0"

20 Classroom (23) - South

1 | A1.0 SCALE: 1/4" = 1'-0"

C:\Users\Anonn\AppData\Local\Autodesk\Revit\Autodesk Revit 2026\Collaboration\Cache\YSPJ5STGNLYKNSM9f5ewk3dcc-d5c1-49a4-88c2-7850491941f2\Fairview PK-8 Renovations_2026 Bond Projects_Central_anonn.rvt
11/12/2026 5:55:11 AM

DAO ARCHITECTURE
7230 Meade St.
Westminster, CO 80030
Phone: 720.273.0431
Email: dan@daoarch.com
Web: www.daoarch.com

Rev. #	Description	Rev. Date
2	Addendum #1	11/12/2026
Revision Schedule		


Westminster Public Schools

2026 Bond Projects
Fairview PK-8
Renovations
7826 Fairview Ave.
Denver, CO 80221

DAO No.: 2025-033

September 25, 2026


Interior Elevations
A6.3
2

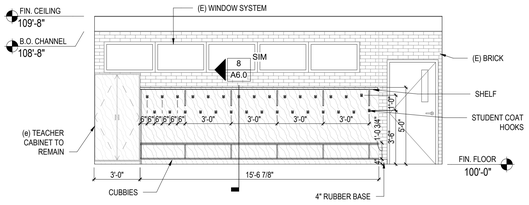

1 Classroom (16) - North

SCALE: 1/4" = 1'-0"


1 A1.0

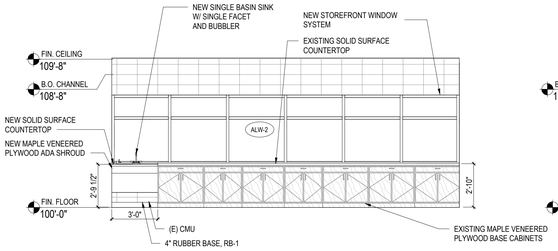

2 Classroom (16) - South

SCALE: 1/4" = 1'-0"


1 A1.0

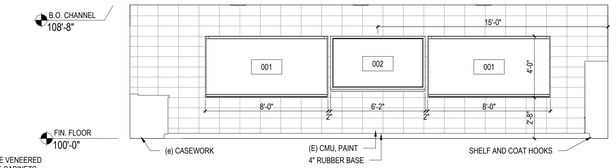

3 Classroom (16) - West

SCALE: 1/4" = 1'-0"


1 A1.0

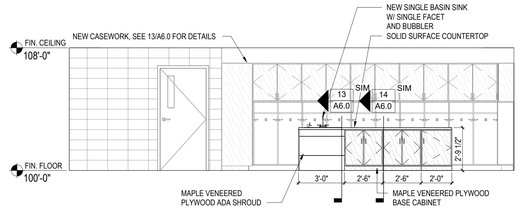

4 Outbuilding Clasroom (17) -East

SCALE: 1/4" = 1'-0"


1 A1.0

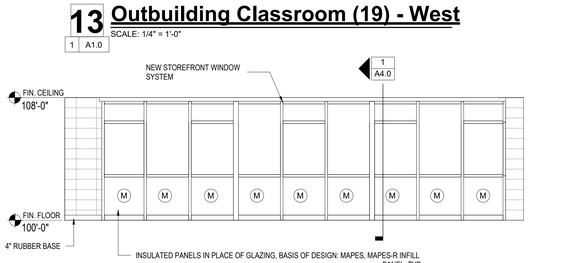

5 Outbuilding Clasroom (17) -South

SCALE: 1/4" = 1'-0"


1 A1.0

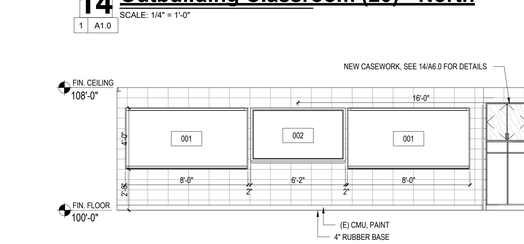

6 Outbuilding Clasroom (17) -West

SCALE: 1/4" = 1'-0"


1 A1.0

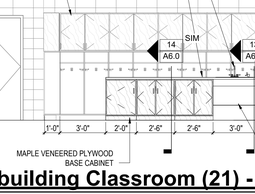

7 Outbuilding Water Fountain Elevation

SCALE: 1/4" = 1'-0"


1 A1.0

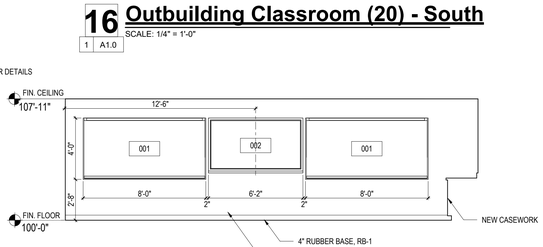

8 Outbuilding Classroom (18) - North

SCALE: 1/4" = 1'-0"


1 A1.0

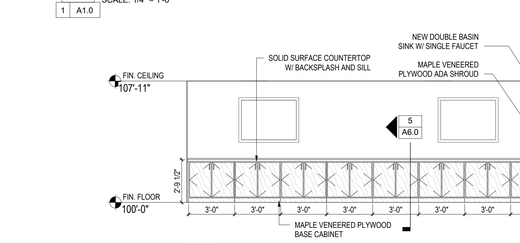

9 Outbuilding Classroom (18) - East

SCALE: 1/4" = 1'-0"


1 A1.0

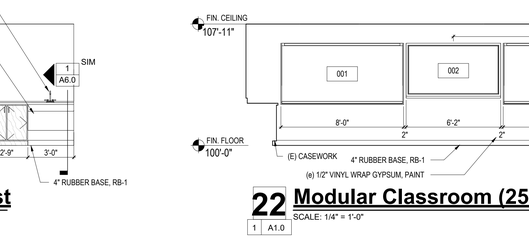

10 Outbuilding Classroom (18) - West

SCALE: 1/4" = 1'-0"

1 A1.0

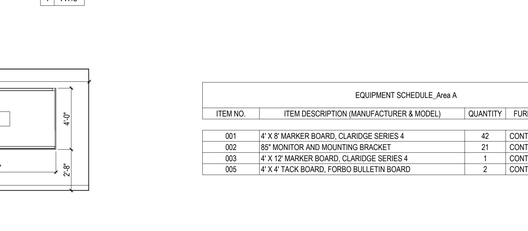

11 Outbuilding Classroom (19) - North

SCALE: 1/4" = 1'-0"


1 A1.0



12 Outbuilding Classroom (19) - East

SCALE: 1/4" = 1'-0"


1 A1.0

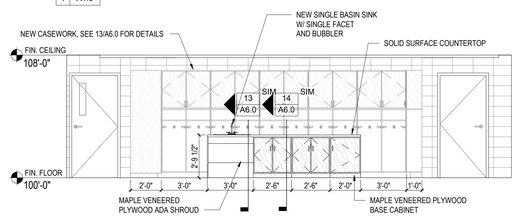

9 Outbuilding Classroom (18) - East

SCALE: 1/4" = 1'-0"


1 A1.0

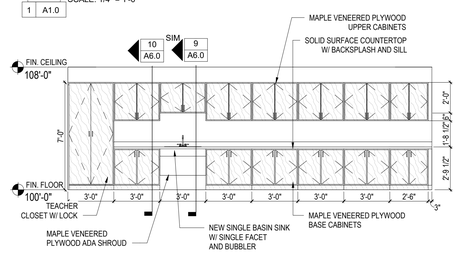

10 Outbuilding Classroom (18) - West

SCALE: 1/4" = 1'-0"


1 A1.0

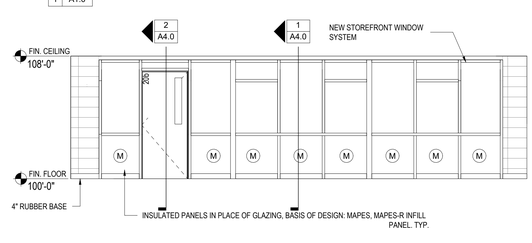

11 Outbuilding Classroom (19) - North

SCALE: 1/4" = 1'-0"

1 A1.0

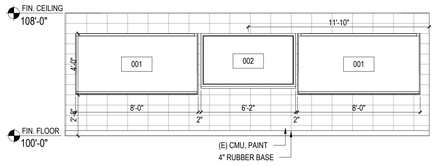

12 Outbuilding Classroom (19) - East

SCALE: 1/4" = 1'-0"

1 A1.0

13 Outbuilding Classroom (19) - West

SCALE: 1/4" = 1'-0"

1 A1.0

14 Outbuilding Classroom (20) - North

SCALE: 1/4" = 1'-0"

1 A1.0

15 Outbuilding Classroom (20) - East

SCALE: 1/4" = 1'-0"

1 A1.0

16 Outbuilding Classroom (20) - South

SCALE: 1/4" = 1'-0"

1 A1.0

17 Outbuilding Classroom (21) - East

SCALE: 1/4" = 1'-0"

1 A1.0

18 Outbuilding Classroom (21) - South

SCALE: 1/4" = 1'-0"

1 A1.0

19 Outbuilding Classroom (21) - West

SCALE: 1/4" = 1'-0"

1 A1.0

20 Modular Classroom (24) - South

SCALE: 1/4" = 1'-0"

1 A1.0

21 Modular Classroom (24) - West

SCALE: 1/4" = 1'-0"

1 A1.0

22 Modular Classroom (25) - North

SCALE: 1/4" = 1'-0"

1 A1.0

EQUIPMENT SCHEDULE_Area A

ITEM NO.	ITEM DESCRIPTION (MANUFACTURER & MODEL)	QUANTITY	FURNISHED/INSTALLED BY
001	4' X 8' MARKER BOARD, CLARIDGE SERIES 4	42	CONTRACTOR/CONTRACTOR
002	85" MONITOR AND MOUNTING BRACKET	21	CONTRACTOR/CONTRACTOR
003	4' X 12' MARKER BOARD, CLARIDGE SERIES 4	1	CONTRACTOR/CONTRACTOR
005	4' X 4' TACK BOARD, FORBO BULLETIN BOARD	2	CONTRACTOR/CONTRACTOR

DAO ARCHITECTURE

7230 Meade St.
Westminster, CO 80030

Phone: 720.273.0431
Email: dan@daoarch.com
Web: www.daoarch.com

Rev. #	Description	Rev. Date
2	Addendum #1	11/12/2026
Revision Schedule		

Westminster Public Schools

2026 Bond Projects
Fairview PK-8
Renovations

7826 Fairview Ave.
Denver, CO 80221


DAO No.: 2025-033

September 25, 2026


Interior Elevations

A6.4


C:\Users\Anon\AppData\Local\Autodesk\Revit\Autodesk Revit 2026\Collaborator\Cache\YSPJ5ST1GNLYKNSMR5ewb3dm-dbc1-46a4-8fe2-7860d819412d\7e6fa95-bba2-4d0f-8a37-b8e73f1d1664.rvt
11/12/2026 8:55:16 AM

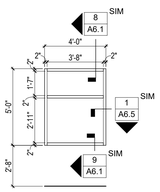


ALW-1

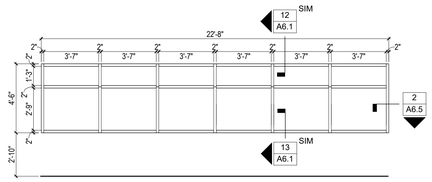


ALW-2

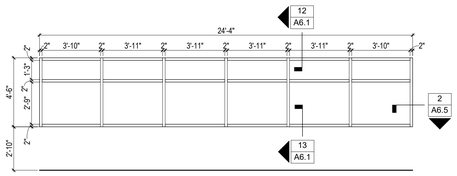


ALW-3

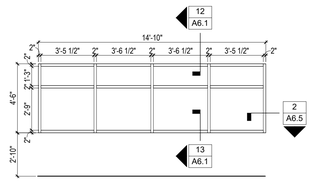


ALW-4

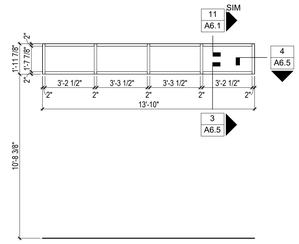


ALW-5

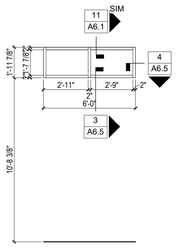


ALW-6

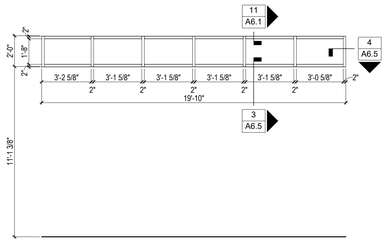


ALW-7

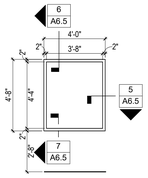

ALW-8

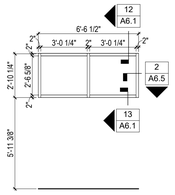

ALW-9

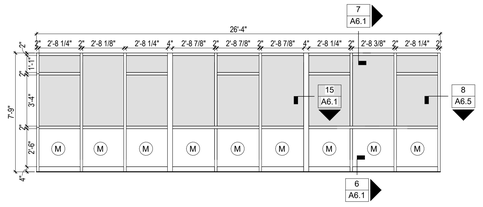

ALW-10

LEGEND


(M) INSULATED PANELS IN PLACE OF GLAZING, BASIS OF DESIGN: MAPES, MAPES-R INFILL PANEL

GLAZING WITH 3M S800 SECURITY FILM


MAXIMUM ASSEMBLY U-FACTOR FOR:
EXTERIOR STOREFRONT: U-0.36

BASIS OF DESIGN:
1. EXTERIOR STOREFRONT: KAWNEER 451 UT WITH INSULATED GLAZING, COLOR: CLEAR ANNODIZED


PROVIDE AND INSTALL 3M S800 SECURITY FILM AT ALL EXTERIOR DOOR GLAZING

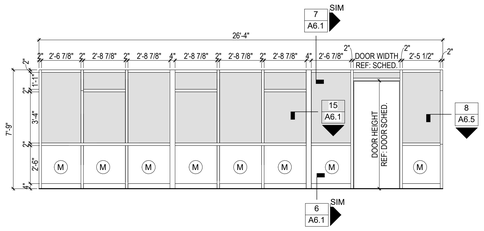


ALW-11

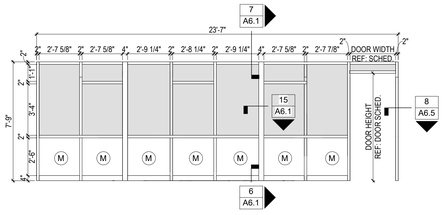


ALW-12

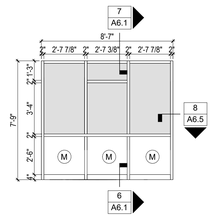


ALW-13

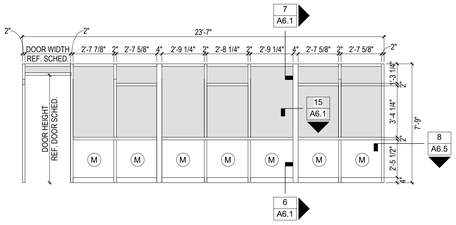


ALW-14

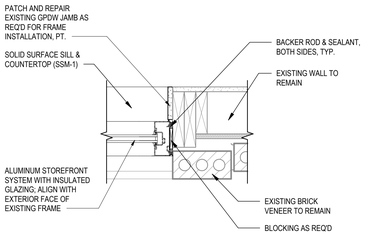


1 ALW - Jamb
SCALE: 1 1/2" = 1'-0"

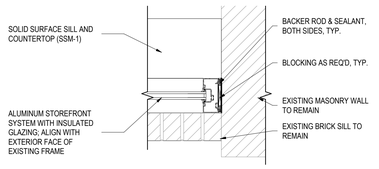


2 ALW-Jamb
SCALE: 1 1/2" = 1'-0"

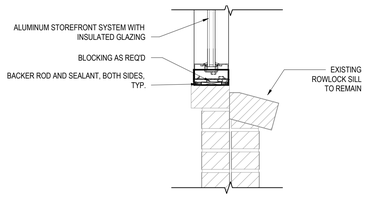


3 ALW - Sill
SCALE: 1 1/2" = 1'-0"

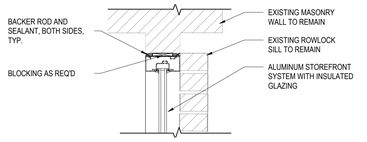


4 ALW - Jamb
SCALE: 1 1/2" = 1'-0"

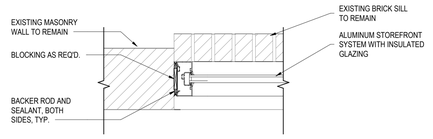


5 ALW - Jamb
SCALE: 1 1/2" = 1'-0"

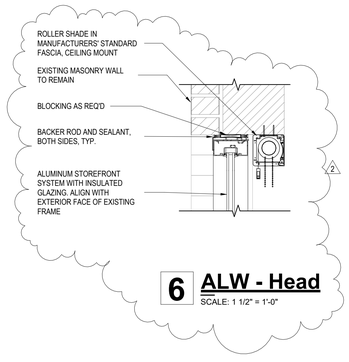

6 ALW - Head
SCALE: 1 1/2" = 1'-0"

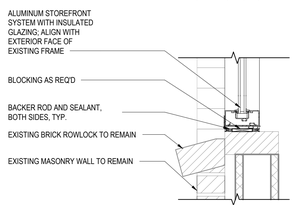

7 ALW - Sill
SCALE: 1 1/2" = 1'-0"

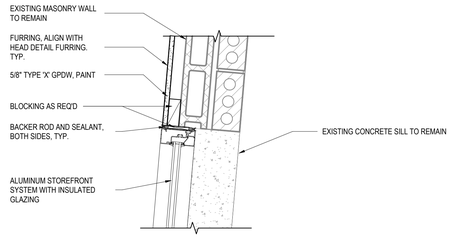

8 ALW - Jamb
SCALE: 1 1/2" = 1'-0"
1 A1.0

DAO ARCHITECTURE
7230 Meade St.
Westminster, CO 80030
Phone: 720.273.0431
Email: dan@daoarch.com
Web: www.daoarch.com

Rev. #	Description	Rev. Date
2	Addendum #1	11/12/2026

Revision Schedule

Westminster Public Schools

2026 Bond Projects
Fairview PK-8 Renovations
7826 Fairview Ave.
Denver, CO 80221


DAO No.: 2025-033

September 25, 2026

Exterior Frame Types

A6.5

C:\Users\Arvon\AppData\Local\Autodesk\Revit\Autodesk Revit 2026\Collaboration\Cache\YSP-9SSTGNLYKN5MRf5ee3ddcc-d8c1-4fad-880c-2786048194f1\2ld7d66b95-bba2-490f-8a37-86a73fd1564.rvt
11/12/2026 8:55:20 AM

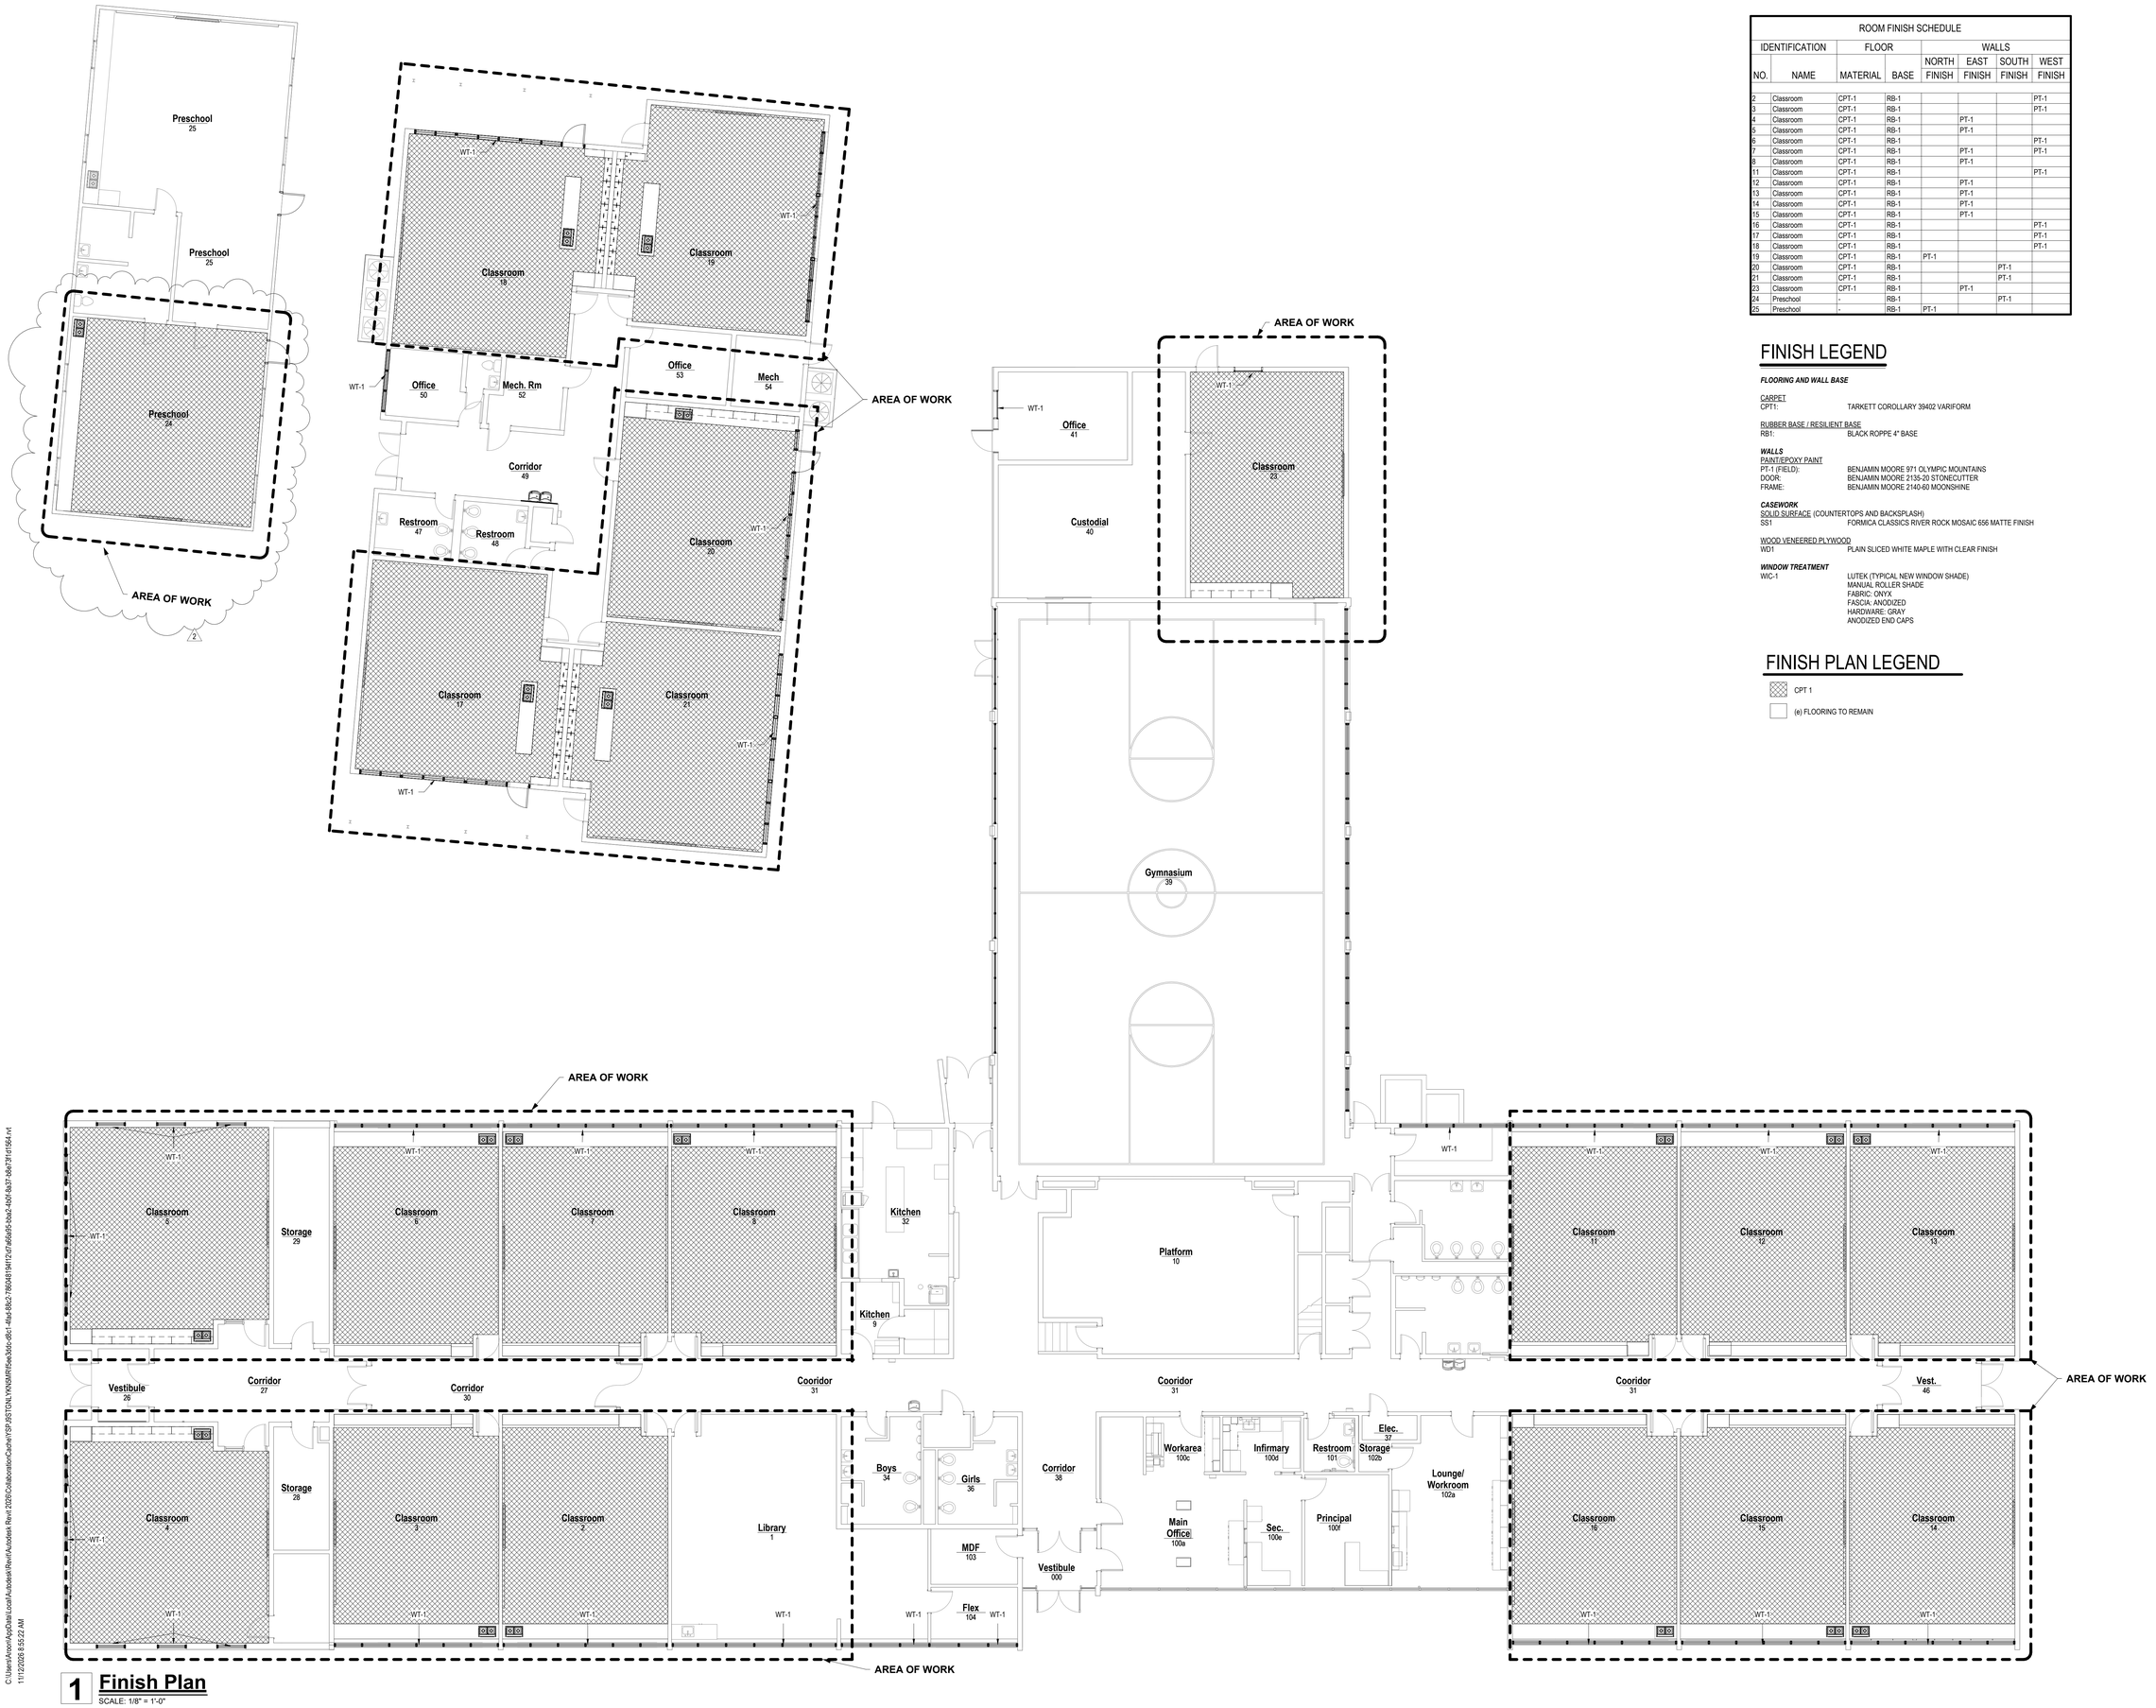

1 **Finish Plan**
SCALE: 1/8" = 1'-0"

C:\Users\Anon\AppData\Local\Autodesk\Revit\Autodesk Revit 2025\CollaborationCache\YSPJ9ST1GNLYKNSMR\f5ee3dcc-d0c1-49ad-88a2-7f6048f194f1\27d60bf5-bba2-40cf-8a37-8de79f1d1954.rvt
11/12/2026 8:55:22 AM

ROOM FINISH SCHEDULE							
IDENTIFICATION		FLOOR		WALLS			
				NORTH	EAST	SOUTH	WEST
NO.	NAME	MATERIAL	BASE	FINISH	FINISH	FINISH	FINISH
2	Classroom	CPT-1	RB-1				PT-1
3	Classroom	CPT-1	RB-1				PT-1
4	Classroom	CPT-1	RB-1		PT-1		
5	Classroom	CPT-1	RB-1		PT-1		
6	Classroom	CPT-1	RB-1				PT-1
7	Classroom	CPT-1	RB-1		PT-1		PT-1
8	Classroom	CPT-1	RB-1		PT-1		
11	Classroom	CPT-1	RB-1				PT-1
12	Classroom	CPT-1	RB-1		PT-1		
13	Classroom	CPT-1	RB-1		PT-1		
14	Classroom	CPT-1	RB-1		PT-1		
15	Classroom	CPT-1	RB-1		PT-1		
16	Classroom	CPT-1	RB-1				PT-1
17	Classroom	CPT-1	RB-1				PT-1
18	Classroom	CPT-1	RB-1				PT-1
19	Classroom	CPT-1	RB-1	PT-1			
20	Classroom	CPT-1	RB-1			PT-1	
21	Classroom	CPT-1	RB-1			PT-1	
23	Classroom	CPT-1	RB-1		PT-1		
24	Preschool	-	RB-1			PT-1	
25	Preschool	-	RB-1	PT-1			

FINISH LEGEND

FLOORING AND WALL BASE

CARPET
CPT1: TARKETT COROLLARY 39402 VARIFORM

RUBBER BASE / RESILIENT BASE
RB1: BLACK ROPPE 4" BASE

WALLS
PAINT/EPOXY PAINT
PT-1 (FIELD): BENJAMIN MOORE 971 OLYMPIC MOUNTAINS
DOOR: BENJAMIN MOORE 2135-20 STONECUTTER
FRAME: BENJAMIN MOORE 2140-60 MOONSHINE

CASEWORK
SOLID SURFACE (COUNTERTOPS AND BACKSPLASH)
SS1 FORMICA CLASSICS RIVER ROCK MOSAIC 656 MATTE FINISH

WOOD VENEERED PLYWOOD
WD1 PLAIN SLICED WHITE MAPLE WITH CLEAR FINISH

WINDOW TREATMENT
WIC-1 LUTEK (TYPICAL NEW WINDOW SHADE)
MANUAL ROLLER SHADE
FABRIC: ONYX
FASCIA: ANODIZED
HARDWARE: GRAY
ANODIZED END CAPS

FINISH PLAN LEGEND

CPT 1

(e) FLOORING TO REMAIN

DAO ARCHITECTURE
7230 Meade St.
Westminster, CO 80030
Phone: 720.273.0431
Email: dan@daoarch.com
Web: www.daoarch.com

Rev. #	Description	Rev. Date
2	Addendum #1	11/12/2026
Revision Schedule		

Westminster Public Schools

2026 Bond Projects
Fairview PK-8
Renovations
7826 Fairview Ave.
Denver, CO 80221

DAO No.: 2025-033

September 25, 2026

Finish Plan

A9.0

KEYNOTES



FIRST FLOOR TECHNOLOGY PLAN
SCALE: 1/8" = 1'-0"

P:\WPS\2025-423 Fairview Elementary Micro Panel Replacement\Cad
11/10/2026 8:48:39 AM

DAO ARCHITECTURE
7230 Meade St.
Westminster, CO 80030
Phone: 720.273.0431
Email: dan@daoarch.com
Web: www.daoarch.com

CATOR | RUMA & ASSOCIATES, CO.
896 Tabor Street, Lakewood, CO 80401
(303) 232-6200 ▪ www.catorruma.com

Rev. #	Description	Rev. Date
1	Addendum 01	11/12/2026

Revision Schedule

Westminster Public Schools

2025 Bond Projects
Fairview PK-8
Renovations

7826 Fairview Ave.
Denver, CO 80221

DAO No.: 2025-028

September 25, 2026

FIRST FLOOR TECHNOLOGY PLAN

E2.0