DAO ARCHITECTURE
7230 Meade Street
Westminster, CO 80030
Phone: 720-273-0431
Email: dan@daoarch.com

Date: 11/12/2026
Project: Westminster Public Schools – 2026 Bond Projects – Harris Park Renovations
DAO Project No.: 2025-033

Addendum 001

The following revisions are to be incorporated into the Construction Documents, dated September 25, 2026

I. SPECIFICATIONS

None at this time

II. DRAWINGS

Sheet C001 – Incorporating Civil Scope

Sheet C100 -- Incorporating Civil Scope

Sheet C300 – Incorporating Civil Scope

Sheet CD301 – Incorporating Civil Scope

Sheet C500 – Incorporating Civil Scope

Sheet CD501 – Incorporating Civil Scope

Cover – Sheet reissued in its entirety – Incorporating Civil Scope.

Sheet G0.0 – Sheet reissued in its entirety – Clarifying Project Scope.

Sheet G0.1 – Sheet reissued in its entirety – Clarifying Project Scope.

Sheet AD1.0 – Sheet reissued in its entirety – Clarifying Project Scope, Incorporating Civil Scope, and Incorporating Additional Items to Scope

Sheet AD2.0 – Sheet reissued in its entirety – Clarifying Project Scope

Sheet A1.0 -- Sheet reissued in its entirety -- Clarifying Project Scope, Incorporating Civil Scope, and Adding Additional Items to Scope.

Sheet A1.2 – Sheet reissued in its entirety – Clarifying Project Scope and Adding Additional Items to Scope

Sheet A2.0 -- Sheet reissued in its entirety -- Clarifying Project Scope and Adding Additional Scope.

Sheet A6.0 -- Sheet reissued in its entirety -- Clarifying Project Scope and Adding Additional Scope.

Sheet A6.1 -- Sheet reissued in its entirety -- Clarifying Project Scope

Sheet A6.2 -- Sheet reissued in its entirety -- Clarifying Project Scope

Sheet A6.3 -- Sheet reissued in its entirety -- Clarifying Project Scope

Sheet A9.0 -- Sheet reissued in its entirety -- Clarifying Project Scope and Adding Additional Items to Scope.

Sheet P0.0 -- Sheet reissued in its entirety – Clarifying Project Scope

Sheet PD1.0 -- Sheet reissued in its entirety – Clarifying Project Scope


Sheet E1.12 – Sheet reissued in its entirety – Added I/O ports adjacent to the teacher's desks in all classrooms.

III. OTHER

None issued at this time.

Westminster Public Schools

Harris Park Elementary Renovations
4300 W. 75th Avenue
Westminster, CO 80030
DAO No.: 2025-033
Construction Documents Submittal
September 25, 2026

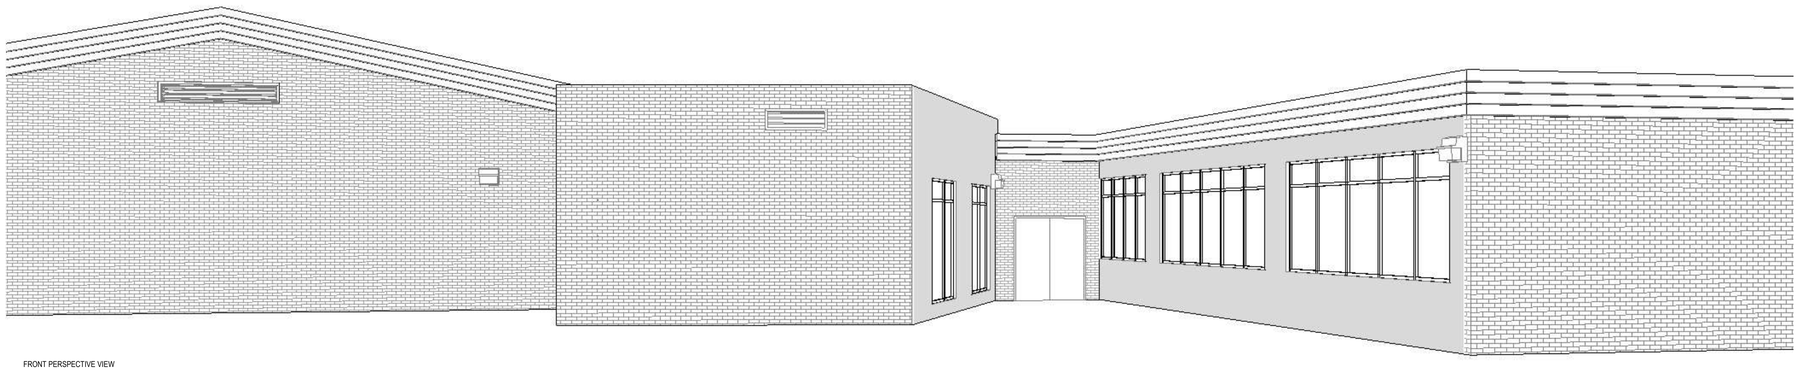

FRONT PERSPECTIVE VIEW

DRAWING INDEX

GENERAL

Cover	Cover Sheet
G0.0	Standard Symbols, Abbreviations & General Notes
G0.1	Building Code Data

CIVIL

C001	General Notes
C100	Demolition Plan
C300	Grading and Drainage Plan
CD301	Drainage Details
C500	Horizontal Control Plan
CD501	Horizontal Control Plan Details

ARCHITECTURE

AD1.0	Demolition First Floor Plan
AD2.0	Demo Exterior Elevations
A1.0	First Floor Plan
A1.2	Equipment Plan
A2.0	Exterior Elevations
A4.0	Wall Sections
A6.0	Casework Sections and Exterior Frame Types and Door Schedule
A6.1	Door and Window Details
A6.2	Interior Elevations
A6.3	Interior Elevations
A9.0	Finish Plan

PLUMBING

P0.00	Plumbing Cover Sheet - General Notes, Schedules & Legend
PD1.0	First Floor - Demolition Plumbing Plan
P1.0	First Floor Plumbing Plan

ELECTRICAL

E0.01	Electrical Legends, Schedules, & Notes
E0.11	Electrical One Line Diagram
ED1.11	First Floor Power Demo Plan
ED1.12	First Floor Technology Demo Plan
E1.11	First Floor Power Plan
E1.12	First Floor Technology Plan
E2.01	Electrical Details
E3.01	Electrical Panel Schedules

DAO ARCHITECTURE

7230 Meade Street
Westminster, CO 80030

Phone: 720.273.0431
Email: dan@daoarch.com
Web: www.daoarch.com

OWNER:
WESTMINSTER PUBLIC SCHOOLS
7002 RALEIGH STREET
WESTMINSTER, CO 80030
CONTACT: DON CIANCIO
PHONE #: 720-542-5100

ARCHITECT:
DAO ARCHITECTURE
7230 MEADE STREET
WESTMINSTER, CO 80030
CONTACT: DAN ORECCHIO
PHONE #: 720.273.0431

ELECTRICAL ENGINEERS:
CATOR RUMA & ASSOCIATES, CO.
896 TABOR STREET
LAKEWOOD, CO 80401
CONTACT: KEVIN MILLER / BRITTANY LAZZERI
PHONE: 303-232-6200

PLUMBING AND MECHANICAL ENGINEERS:
THE BALLARD GROUP
2525 S WADSWORTH BLVD SUITE 200
LAKEWOOD, CO 80227
CONTACT: NATE RUST
PHONE: 303-867-6847

Westminster Public Schools

2026 Bond Projects Harris Park Elementary
4300 W. 75th Avenue
Westminster, CO 80030

DAO No.: 2025-033

September 25, 2026

Construction Documents

Cover

Autodesk Docs://WPS 2026 Bond Projects - Harris Park Renovations/Harris Park school - 2019 Kitchen (Revit 2026).rvt
11/12/2026 10:31:25 AM

MATERIALS SYMBOLS

EARTHWORKS



CONCRETE




METAL



MASONRY



STONE

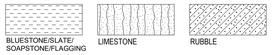


WOOD



GLASS



INSULATION

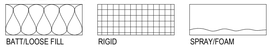

FINISHES






PARTITION INDICATIONS



ELEVATION INDICATIONS


REFERENCE SYMBOLS

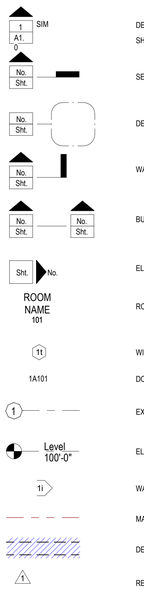

STANDARD ABBREVIATIONS

A/E	ARCHITECT/ENGINEER
AB	ANCHOR BOLT
ABBR	ABBREVIATE
ABV	ABOVE
AC	AIR CONDITIONING
ACID RES	ACID RESISTANT
ACOUS	ACOUSTICAL
ACOUS INSUL	ACOUSTICAL INSULATION
ACOUS PNL	ACOUSTICAL PANEL
ACOUS PLAS	ACOUSTICAL PLASTER
ACOUS TILE	ACOUSTICAL TILE
ACT	ACTUAL
AD	AREA DRAIN
ADC	AUTOMATIC DOOR CLOSER
ADDL	ADDITIONAL
ADDM	ADDENDUM
ADJ	ADJUSTABLE
ADJC	ADJACENT
AF	ACCESS FLOOR
AFF	ABOVE FINISHED FLOOR
AFG	ABOVE FINISHED GRADE
AFS	ABOVE FINISHED SLAB
AGGR	AGGREGATE
AHR	ANCHOR
AHU	AIR HANDLING UNIT
ALD	ALUMINUM DOOR
ALM	ALARM
ALT	ALTERNATE
ALUM	ALUMINUM
AMB	AMBIENT
AMPL	AMPLIFIER
AMT	AMOUNT
ANN	ANNUNCIATOR
ANOD	ANODIZED
ANT	ANTENNA
AP	ACCESS PANEL
APPX	APPENDIX
ARCH	ARCHITECT(URAL)
ASB	ASBESTOS
ASC	ABOVE SUSPENDED CEILING
ASPH	ASPHALT
ASYM	ASYMMETRICAL
AV	AUDIO VISUAL
AVE	AVENUE
AWC	ACOUSTICAL WALL COVERING
AWP	ACOUSTICAL WALL PANEL
B&B	BALLED AND BURLAPPED
BAF	BAFFLE
BAL	BALANCE
BB	BULLETIN BOARD
BC	BOTTOM OF CURB
BD	BOARD
BEV	BEVEL
BF	BOTH FACES
BFF	BELOW FINISH FLOOR
BFP	BACKFLOW PREVENTER
BITUM	BITUMINOUS
BJT	BED JOINT
BL	BASE LINE
BLDG	BUILDING
BLK	BLOCK
BLKG	BLOCKING
BLKHD	BULKHEAD
BLST	BALLAST
BM	BEAM
BO	BOTTOM OF
BOC	BACK OF CURB
BOW	BOTTOM OF WALL
BP	BASE PLATE
BRCG	BRACING
BRDG JST	BRIDGING JOIST
BRG	BEARING
BRG PL	BEARING PLATE
BRK	BRICK
BRKT	BRACKET
BRS	BRASS
BRZ	BRONZE
BS	BOTH SIDES
BSMT	BASEMENT
BTM	BOTTOM
BUR	BUILT-UP ROOF
BW	BOTH WAYS
BOW	BOTTOM OF WALL
C/C	CENTER TO CENTER
C&G	CURB AND GUTTER
CAB	CABINET
CARP	CARPET
CAV	CAVITY
CB	CATCH BASIN
CCTV	CLOSED CIRCUIT TELEVISION
CEM	CEMENT
CEM PLAS	CEMENT PLASTER
CER	CERAMIC
CER TILE	CERAMIC TILE
C FLG	COUNTER FLASHING
CH BD	CHALKBOARD
CG	CORNER GUARD
CHAN	CHANNEL
CHFR	CHAMFER
CHK	CHECK
CI	CAST IRON
CIP	CAST IN PLACE
CIR	CIRCLE
CJ	CONTROL JOINT
CL	CENTER LINE
CLG	CEILING
CLG DIFF	CEILING DIFFUSER
CLG HT	CEILING HEIGHT
CLL	CONTRACT LIMIT LINE
CLOS	CLOSET
CLR	CLEAR
CLSR	CLOSURE
CMPST	COMPOSITE
CMU	CONCRETE MASONRY UNIT
CNR	CORNER
CNTR	COUNTER
CO	CLEANOUT
COL	COLUMN
COMM	COMMERCIAL
COMPL	COMPLETE
CONC	CONCRETE
CONC FL	CONCRETE FLOOR
CONF	CONFERENCE
CONN	CONNECTION
CONSTR	CONSTRUCTION
CONT	CONTINUOUS
CONTR	CONTRACTOR
COORD	COORDINATE
CORR	CORRIDOR
COV PL	COVER PLATE
CPRS	COMPRESSIBLE
CPT	CARPET
CRCMF	CIRCUMFERENCE
CRS	COLD ROLLED STEEL
CSG	CASING
CSK	COUNTERSUNK
CSMT	CASEMENT
CSWK	CASEWORK
CT	CERAMIC TILE
C TV	CABLE TELEVISION
CUB	CUBICLE
CUR	CURRENT
CW	COLD WATER
DBL GLZ	DOUBLE GLAZING
DEPT	DEPARTMENT
DET	DETAIL
DF	DRINKING FOUNTAIN
DF	DRAPERY FABRIC
DFR	DOOR FRAME
DH	DOUBLE HUNG
DIA	DIAMETER
DIM	DIMENSION
DIST	DISTANCE
DIV	DIVIDER
DIW	DEIONIZED WATER
DJ	DOUBLE JOIST
DL	DRAPERY LINER
DMPF	DAMPPROOFING
DN	DOWN
DO	DITTO
DR	DOOR
DR CLSR	DOOR CLOSURE
DS	DOWNSPOUT
DST	DOOR STOP
DT	DRAIN TILE
DUPL	DUPLICATE
DVTL	DOVETAIL
DW	DISHWASHER
DWG	DRAWING
DWL	DOWEL
DWR	DRAWER
DWTR	DUMBWAITER
E	EAST
EA	EACH
EF	EACH FACE
EJ	EXPANSION JOINT
EL	ELEVATION
ELEC	ELECTRICAL
ELEV	ELEVATOR
EMER	EMERGENCY
EMER SHR	EMERGENCY SHOWER
ENAM	ENAMEL
ENCL	ENCLOSURE
ENGR	ENGINEER
ENTR	ENTRANCE
EO	ELECTRICAL OUTLET
EP	ELECTRICAL PANEL
EPS	EXPANDED POLYSTYRENE
EPX	EPOXY FLOOR
EQL SP	EQUALLY SPACED
EQ	EQUAL
EQUIP	EQUIPMENT
EQUIV	EQUIVALENT
ERECT	ERECTION
ESCAL	ESCALATOR
ESMT	EASEMENT
EST	ESTIMATE
EW	EACH WAY
EXC	EXCAVATE
EXG	EXISTING
EXH HD	EXHAUST HOOD
EXH FN	EXHAUST FAN
EXP	EXPANSION
EXSP	EXPOSED
EXST	EXISTING
EXST GR	EXISTING GRADE
EXT	EXTERIOR
EXTN	EXTENSION
EIFS	EXTERIOR INSULATION & FINISH SYSTEM
F BRK	FIRE BRICK
F/F	FACE TO FACE
FBD	FIBERBOARD
FC	FIRE COATED
FD	FLOOR DRAIN
FDN	FOUNDATION
FEC	FIRE EXTINGUISHER CABINET
FF	FACTORY FINISH
FFE	FINISH FLOOR ELEVATION
FGL	FIBERGLASS
FIN GR	FINISH GRADE
FIN FL	FINISH FLOOR
FIN	FINISH
FL	FLOWLINE
FLDG	FOLDING
FLG	FLANGE
FLR	FLOOR
FLR SK	FLOOR SINK
FLR PL	FLOOR PLATE
FLR FIN	FLOOR FINISH
FLT GL	FLOAT GLASS
FLOUR	FLUORESCENT
FOC	FACE OF CONCRETE
FOM	FACE OF MASONRY
FOS	FACE OF STUD
FPL	FIREPLACE
FPRF	FIREPROOFING
FRM	FRAME
FRNT	FRONT
FS	FULL SIZE
FSP	FIRE STANDPIPE
FSTNR	FASTENER
FTG	FOOTING
FURR	FURRING
FUT	FUTURE
FXTR	FIXTURE
GA	GYPSUM ASSOCIATION
GALV	GALVANIZED
GB	GRAB BAR
GDRL	GUARD RAIL
GENL	GENERAL
GENL CONTR	GENERAL CONTRACTOR
GFI	GROUND FAULT INTERRUPTER
GL	GLASS
GL BLK	GLASS BLOCK
GLU LAM	GLUE LAMINATED
GLZ	GLAZING
GLZ CMU	GLAZED CONCRETE MASONRY UNIT
GND	GROUND
GPDW	GYPSUM DRY WALL
GR BM	GRADE BEAM
GR	GRADE
GRTG	GRATING
GUT	GUTTER
GYP	GYPSUM
GYP PLAS	GYPSUM PLASTER
H	HIGH
H&CW	HOT & COLD WATER
HB	HOSE BIBB
HC	HOLLOW CORE
HC	HANDICAP
HCMU	HOLLOW CONCRETE MASONRY UNIT
HD	HEAVY DUTY
HDJT	HEAD JOINT
HDBD	HARDBOARD
HDR	HEADER
HDWD	HARDWOOD
HGT	HEIGHT
HLB	HORIZONTAL LOUVER BLINDS
HM	HOLLOW METAL
HMD	HOLLOW METAL DOOR
HMF	HOLLOW METAL FRAME
HNDRL	HAND RAIL
HO	HOLD-OPEN
HORIZ	HORIZONTAL
HR	HOUR
HS	HIGH STRENGTH
HSB	HIGH STRENGTH BOLT
HTG	HEATING
HVAC	HEATING, VENTILATION, AIR CONDITIONING
HW	HOT WATER
HYD	HYDRANT
ID	INSIDE DIAMETER
IF	INSIDE FACE
INCAND	INCANDESCENT
INL	INLET
INSTL	INSTALLATION
INSUL	INSULATION
INTR	INTERIOR
INV	INVERT
INV EL	INVERT ELEVATION
JAN	JANITOR
JC	JANITOR'S CLOSET
JST	JOIST
JT	JOINT
KB	KNEE BRACE
KO	KNOCKOUT
KOP	KNOCKOUT PANEL
KPL	KICK PLATE
KWY	KEYWAY
L	LEFT
LAB	LABORATORY
LAT	LAY-IN ACOUSTICAL TILE
LAV	LAVATORY
LB	POUND
LBR	LUMBER
LCMU	LIGHTWEIGHT CONCRETE MASONRY UNIT
LD BRG	LOAD BEARING
LDG	LANDING
LF	LINEAR FOOT
LG	LENGTH
LH	LEFT HAND
LHR	LEFT HAND REVERSE
LIN	LINOLEUM
LIQ	LIQUID
LKR	LOCKER
LKR RM	LOCKER ROOM
LL	LIVE LOAD
LNTL	LINTEL
LOC	LOCATION
LONG	LONGITUDINAL
LRG	LARGE
LS	LUMP SUM
LT	LIGHT
LT WT	LIGHTWEIGHT
LTG	LIGHTING
LVL	LEVEL
LVR	LOUVER
LW PLAS	LIGHTWEIGHT PLASTER
LWC	LIGHTWEIGHT CONCRETE
M	METER
MAINT	MAINTENANCE
MARB	MARBLE
MAS	MASONRY
MATL	MATERIAL
MAX	MAXIMUM
MB	MARKERBOARD
MBR	MEMBER
MC	METAL CLAD
MDF	MEDIUM DENSITY FIBERBOARD
MDO	MEDIUM DENSITY OVERLOAD
ME	MATCH EXISTING
ME	MISCELLANEOUS EQUIPMENT
MECH	MECHANICAL
MED	MEDIUM
MEMB	MEMBRANE
MEZZ	MEZZANINE
MFG	MANUFACTURING
MFR	MANUFACTURER
MH	MANHOLE
MIL	MILLIMETER
MIN	MINIMUM
MIR	MIRROR
MISC	MISCELLANEOUS
MK	MARK
MKRBD	MARKERBOARD
ML	MATCH LINE
MLC	METAL LABORATORY CASEWORK
MLDG	MOLDING
MLWK	MILLWORK
MO	MASONRY OPENING
MOD	MODULE
MTD	MOUNTED
MTG	MEETING
MTL	METAL
MTR	MORTAR
MULL	MULLION
MULT	MULTIPLE
MVBL	MOVABLE
N	NORTH
N/A	NOT APPLICABLE
NEG	NEGATIVE
NF	NEAR FACE
NIC	NOT IN CONTRACT
NO	NUMBER
NOM	NOMINAL
NS	NEAR SIDE
NTS	NOT TO SCALE
O/O	OUT TO OUT
OA	OVERALL
OC	ON CENTER
OD	OUTSIDE DIAMETER
OD	OVERFLOW DRAIN
OF	OUTSIDE FACE
OFCI	OWNER FURNISHED CONTRACTOR INSTALL
OFF	OFFICE
OFOI	OWNER FURNISHED OWNER INSTALLED
OH	OVERHEAD
OHD	OVERHEAD DOOR
OPER	OPERABLE
OPNG	OPENING
OPP	OPPOSITE
OPT	OPTIONAL
ORIG	ORIGINAL
OVHD	OVERHEAD
OXY	OXYGEN
OZ	OUNCE
P/C	PRECAST
PAR	PARALLEL
PARG	PARGING
PB	PANIC BAR
PBD	PARTICLE BOARD
PC	PORTLAND CEMENT
PCPLAS	PORTLAND CEMENT PLASTER
PED	PEDESTAL
PERF	PERFORATED
PERIM	PERIMETER
PERM	PERMANENT
PERP	PERPENDICULAR
PF	PANEL FABRIC
PFP	PRE-FINISHED PANELS
PGBD	PEGBOARD
PH	PHASE
PL	PLASTIC LAMINATE
PLAM	PLASTIC LAMINATE
PLAS	PLASTER
PLAT	PLATFORM
PLBG	PLUMBING
PLYWD	PLYWOOD
POL	POLISHED
POLY	POLYSTYRENE
POLYISO	POLYISOCYANURATE
POS	POSITIVE
PR	PAIR
PREFAB	PREFABRICATED
PRELIM	PRELIMINARY
PRKG	PARKING
PROJ	PROJECT
PS	PROJECTION SCREEN
PT	PAINT
PT	PORCELAIN TILE
PTN	PARTITION
PVC	POLYVINYL CHLORIDE
PVG	PAVING
PVMT	PAVEMENT
PWR	POWER
QT	QUARRY TILE
QTY	QUANTITY
QUAL	QUALITY
R	RISER
RAD	RADIUS
RB	RUBBER BASE
RBR	RUBBER
RC	REINFORCED CONCRETE
RCP	REINFORCED CONCRETE PIPE
RD	ROOF DRAIN
REC	RECESSED
RECD	RECEIVED
RECPT	RECEPTACLE
RECT	RECTANGULAR
REF	REFERENCE
REINF	REINFORCEMENT
REM	REMOVABLE
REQD	REQUIRED
RESIL	RESILIENT
RFM	RECESSED FLOOR MAT
RFG	ROOFING
RH	RIGHT HAND
RHR	RIGHT HAND REVERSE
RND	ROUND
RO	ROUGH OPENING
RST	RUBBER STAIR TREAD
RT	RUBBER TILE
RV	ROOF VENT
RVS	REVERSE
S	SOUTH
S	SEATING
SALV	SALVAGE
SB	SPLASH BLOCK
SC	SOLID CORE
SCH	SCHEDULE
SCMU	SOLID CONCRETE MASONRY UNIT
SCRN	SCREEN
SD	STORM DRAIN
SECT	SECTION
SF	SYSTEMS FURNITURE
SGL	SINGLE
SHR	SHOWER
SHTHG	SHEATHING
SHVL	SHELVES
SIM	SIMILAR
SJ	SLIP JOINT
SK	SINK
SLA	SLATE
SLP	SLOPE
SLS	SUB-FLOOR LEVELING SYSTEM
SLV	SLEEVE
SM	SHEET METAL
SMLS	SEAMLESS
SP	SPACING
SPCL	SPECIAL
SPEC	SPECIFICATION
SPKLR	SPRINKLER
SPKR	SPEAKER
SPRT	SUPPORT
SQFT	SQUARE FOOT
SQ	SQUARE
SQIN	SQUARE INCH
SQYD	SQUARE YARD
SSK	SERVICE SINK
SS	STAINLESS STEEL
SSM	SOLID SURFACING MATERIAL
ST	STAIN
ST	STREET
STAG	STAGGERED
STC	SOUND TRANSMISSION CLASS
STD	STANDARD
STIR	STIRRUP
STL JST	STEEL JOIST
STL PL	STEEL PLATE
STL	STEEL
STN	STONE
STOR	STORAGE
STRUCT	STRUCTURAL
STRUCT STL	STRUCTURAL STEEL
SUPPL	SUPPLEMENT
SURF	SURFACE
SUSP	SUSPENDED
SUSP CLG	SUSPENDED CEILING
SVB	SHEET VINYL BASE
SVF	SHEET VINYL FLOOR
SYM	SYMBOL
SYMM	SYMMETRICAL
SYST	SYSTEM
T&B	TOP & BOTTOM
T&G	TONGUE & GROOVE
T	TABLE
TB	TACKBOARD
TB-xx	TEST BORING-xx (E.G. TB-1)
TC	TOP OF CURB
TD	TRENCH DRAIN
TE	TRANSITION EDGE
TECH	TECHNICAL
TEMP	TEMPORARY
TER	TERRAZZO
THK	THICK
THRES	THRESHOLD
THRU	THROUGH
TKBD	TACKBOARD
TLT	TOILET
TMPD	TEMPERED
TMPD GL	TEMPERED GLASS
TNL	TUNNEL
TO	TOP OF
TOF	TOP OF FLANGE
TOFF	TOP OF FINISH FLOOR
TOJ	TOP OF JOIST
TOL	TOLERANCE
TOS	TOP OF STEEL
TOT	TOTAL
TOW	TOP OF WALL
TRNBKL	TURNBUCKLE
TS	TUBE STEEL
TV	TELEVISION
TYP	TYPICAL
UF	UPHOLSTERY FABRIC
UFD	UNDER FLOOR DUCT
UG	UNDERGROUND
UL	UNDERWRITERS LABORATORY
ULT	ULTIMATE
UNEX	UNEXCAVATED
UNFIN	UNFINISHED
UNO	UNLESS NOTED OTHERWISE
UPS	UNINTERRUPTIBLE POWER SUPPLY
UR	URINAL
UTIL	UTILITY
V	VOLT
VAC	VACUUM
VAV	VARIABLE AIR VOLUME
VB	VAPOR BARRIER
VR	VAPOR RETARDER
VT	VINYL TILE
VWC	VINYL WALL COVERING
W	WITH
W/O	WITHOUT
W	WEST
WC	WATER CLOSET
WC	WALL COVERING
WCPT	WALL CARPET
WD	WOOD
WDD	WOOD DOOR
WDW	WINDOW
WF	WOOD FLOORING
WF	WIDE FLANGE
WGL	WIRE GLASS
WH	WALL HUNG
WHSE	WAREHOUSE
WL	WIND LOAD
WLD	WELDED
WR	WATER RESISTANT
WS	WEATHERSTRIPPING
WSCT	WAINSCOT
WT	WEIGHT
WTR	WATER
WTRPRF	WATERPROOFING
WWM	WELDED WIRE MESH
X SECT	CROSS SECTION

VICINITY MAP

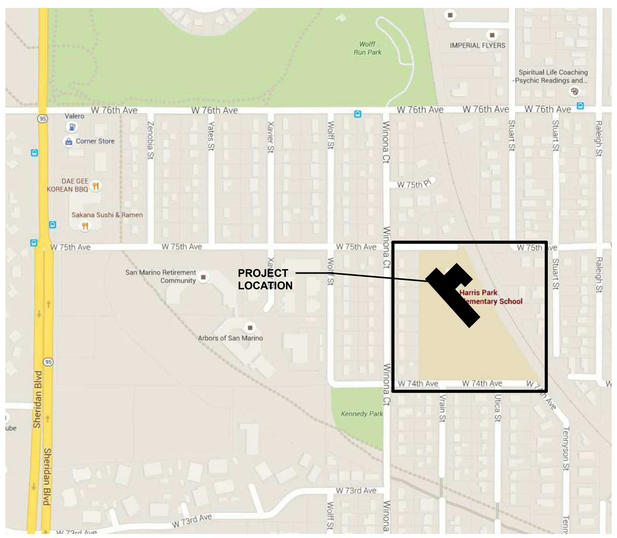

GENERAL NOTES

1. THE GENERAL CONTRACTOR SHALL VERIFY ALL EXISTING DIMENSIONS AND CONDITIONS SHOWN ON PLANS PRIOR TO COMMENCEMENT OF THE WORK . IT SHALL BE THE CONTRACTORS RESPONSIBILITY TO COORDINATE INSTALLATION OF NEW WORK WITHIN THESE EXISTING CONDITIONS. ANY DEVIATIONS IN EXISTING CONDITIONS OR DIMENSIONS INDICATED SHALL BE COORDINATED WITH THE ARCHITECT AND OWNER IN ORDER TO MODIFY PLANS ACCORDINGLY .
2. ALL DISCIPLINES SHALL BE RESPONSIBLE FOR THEIR SCOPE OF WORK . THIS WORK IS TO BE SCHEDULED AND COMPLETED WITH THE GENERAL CONTRACTOR'S FULL KNOWLEDGE.
3. ALL HOT WORK ACTIVITIES (I.E. USING HEAT GUNS, SOLDERING, BRAZING, WELDING, GRINDING, METAL CUTTING, ETC.) OR OTHER ACTIVITIES INVOLVING FLAMES OR SPARKS SHALL BE PRECEDED BY OBTAINING AN APPROVED HOT WORK PERMIT. (IF HOT WORK REQUIRED)
4. THE PROJECT STAGING AREA / CONSTRUCTION ACTIVITIES SHALL NOT CAUSE THE OBSTRUCTION OF PATHS OF EGRESS INSIDE THE BUILDING, BLOCK EXIT DISCHARGE FROM THE BUILDING, OR IMPEDE EMERGENCY VEHICLE ACCESS TO THE BUILDING. CORRIDORS MAY NOT BE USED AS STAGING AREAS OR AS AREAS FOR DEBRIS COLLECTION.
5. ALL NECESSARY MEASURES SHALL BE TAKEN TO PREVENT THE NUISANCE ACTUATION OF ANY NEARBY SMOKE OR DUCT DETECTORS BY CONSTRUCTION ACTIVITIES THAT CREATE DUST OR FUMES INSIDE THE BUILDING.
6. THE CONTRACTOR SHALL NOT HANDLE OR DISABLE ANY FIRE SYSTEMS DEVICES. ONLY BUILDING FIRE SYSTEMS PERSONNEL MAY HANDLE OR DISABLE EXISTING FIRE SYSTEMS. ANY OUTAGES REQUIRED FOR THE EXISTING FIRE SYSTEMS SHALL BE PERFORMED ACCORDING TO THE BUILDING PROCEDURES.
7. THE ARCHITECT ASSUMES NO RESPONSIBILITY FOR THE DETECTION OR REMOVAL OF ANY HAZARDOUS MATERIALS, INCLUDING, BUT NOT LIMITED TO, ASBESTOS IN ANY FORM. PARTIES RESPONSIBLE FOR DEMOLITION SHALL NOTIFY THE OWNER IMMEDIATELY OF ANY SUSPECTED MATERIALS.
8. ALL WORK IS TO BE PERFORMED ACCORDING TO WESTMINSTER PUBLIC SCHOOLS BUILDING & CONSTRUCTION STANDARDS.
9. CONTRACTOR TO PROVIDE FINAL CLEANING SERVICES IN ALL CLASSROOMS PRIOR TO PROJECT COMPLETION, AND NO LATER THAN THE DATE THAT THE OWNER OCCUPIES THE CLASSROOMS, AHEAD OF STAFF AND STUDENTS RETURNING TO THE SCHOOL."

PROJECT DESCRIPTION

THIS PROJECT ENTAILS RENOVATIONS AT THE EXISTING WESTMINSTER PUBLIC SCHOOLS BUILDING AT THE HARRIS PARK ELEMENTARY WHICH IS LOCATED AT 4300 W. 75TH AVENUE IN WESTMINSTER, CO.

THIS PROJECT ENTAILS THE REPLACEMENT OF WATERPROOFING AND INSTALLATION OF FOUNDATION DRAINAGE SYSTEMS IN ORDER TO MITIGATE WATER INTRUSION INTO A PORTION OF THE EXISTING SCHOOL. EXTERIOR GRADE AND FLATWORK WILL BE REMOVED AND RE-INSTALLED AS REQUIRED TO REPLACE THE FAILING EXISTING DAMPPROOFING.

ARCHITECTURALLY, THE WORK WILL INCLUDE THE REPLACEMENT OF FINISHES, FIXTURES, AND CASEWORK THROUGHOUT THE MAJORITY OF THE BUILDING. ALL OF THE EXTERIOR WINDOWS OF THE BUILDING WILL BE REPLACED. THE EXTERIOR DOORS OF THE MODULAR BUILDINGS WILL BE REPLACED. THE EXTERIOR BRICK OF THE BUILDING WILL BE STAINED AND THE METAL SIDING ON THE MODULARS WILL BE PAINTED TO MATCH.

PLUMBING IN THE BUILDING EXISTING BUILDING IS ANTICIPATED TO BE UPGRADED WITH REPLACEMENT OF CLASSROOM SINKS, THE REPLACEMENT OF A SINGLE DRINKING FOUNTAIN, AND INSTALLING A NEW FOUNDATION DRAIN AROUND THE GYM.

ELECTRICALLY, EXISTING ELECTRICAL INFRASTRUCTURE WILL BE UPGRADED IN THE CLASSROOMS, WHICH INCLUDES THE REMOVAL OF THE EXISTING "MICRO-PANELS.", MAG-HOLDS ON THE CLASSROOM DOORS, UPDATED POWER AND DATA FOR TEACHING WALLS, AND THE ADDITION OF VOICE-LIFT IN ALL THE CLASSROOMS.

NO LANDSCAPE, MECHANICAL, OR STRUCTURAL ARE ANTICIPATED AS PART OF THIS PROJECT.

2

DAO ARCHITECTURE

7230 Meade St.
Westminster, CO 80030

Phone: 720.273.0431
Email: dan@daoarch.com
Web: www.daoarch.com

Rev. #	Description	Rev. Date
2	Addendum 01	11/12/2026

Revision Schedule

Westminster Public Schools

2026 Bond Projects
Harris Park Elementary

4300 W. 75th Avenue
Westminster, CO 80030

DAO No.: 2025-033

September 25, 2026

Standard Symbols, Abbreviations & General Notes

G0.0

Autodesk Docs://WPS 2026 Bond Projects - Harris Park Renovations/Harris Park school - 2019 Kitchen (Revit 2026).rvt
11/12/2026 10:31:26 AM

CODE ANALYSIS

This project entails the alteration of Harris Park Elementary School located at 4500 W. 75th Ave. Westminster, CO 80030.
This building is an existing E Occupancy building, and the building occupancy, area, and height are not being modified as a result of this project.
This project is an alteration per section 503 of the 2021 International Existing Building Code. Alterations shall comply with the requirements of the International Building Code for new construction. Alterations shall be such that the building is no less conforming to the provisions of the International Building Code than the existing building was prior to the alteration.

2021 IEBC

Chapter 3 - Provisions For All Compliance Methods
302 - General Provisions
302.3 Existing materials - Materials already in use in a building in compliance with requirements or approvals in effect at the time of their erection or installation shall be permitted to remain in use unless determined by the code official to be unsafe.
302.4 New and replacement materials - Except as otherwise required or permitted by this code, materials permitted by the applicable code for new construction shall be used.
306 - Accessibility For Existing Buildings
306.7 Alterations - A facility that is altered shall comply with the applicable provisions in Chapter 11 of the International Building Code, ICC A117.1 and the provisions of Sections 06.7.1 through 306.7.16, unless technically infeasible. Where compliance with this section is technically infeasible, the alteration shall provide access to the maximum extent technically feasible.
306.7.1 Alterations affecting an area of primary function - Where an *alteration* affects the accessibility to, or contains an area of *primary function*, the route to the *primary function* area shall be accessible. The accessible route to the *primary function* area shall include toilet *facilities* and drinking fountains serving the area of *primary function*.
306.7.2 - Accessible means of egress. Accessible means of egress required by Chapter 10 of the International Building Code are not required to be added in existing facilities.

Chapter 4 - Repairs
Not Applicable.

Chapter 5 - Prescriptive Compliance Method
503 - Alterations
503.1 General - *Alterations* to any building or structure shall comply with the requirements of the *International Building Code* for new construction. *Alterations* shall be such that the *existing building or structure* is not less complying with the provisions of the *International Building Code* than the *existing building* or structure was prior to the *alteration*.
503.17 Locking arrangements in educational occupancies - In Group E occupancies...egress doors with locking arrangements designed to keep intruders from entering the room shall comply with Section 1010.2.8 of the *International Building Code*.
505 - Windows and Emergency Escape Openings
505.1 Replacement Windows - The installation or replacement of windows shall be as required for new installations.

2021 IBC

Chapter 3 - Use and Occupancy Classification
305 - Educational: Group E
305.1 The use of a building or structure, or a portion thereof, by six or more persons at any one time for educational purposes through the 12th grade.

Chapter 4 - Special Detailed Requirements Based on Use and Occupancy
Not Applicable

Chapter 5 - General Building Heights and Areas
Existing building height and area are to remain as-is and are not being modified by this project.

Chapter 6 - Types of Construction
602 - Construction Classification
Type IIIB - Primary Structural Frame - 0 hours
Bearing Walls - Exterior - 2 hours; Interior - 0 hours
Nonbearing walls and partitions - Exterior - (E Occupancy, Type IIIB, between 10' and 30' separation) - 1 hours
Nonbearing walls and partitions - Interior - 0 hours
Floor construction and secondary members - 0 hours
Roof construction and secondary members - 0 hours

Chapter 7 - Fire and Smoke Protection Features
708 - Fire Partitions
708.1 General - The following wall assemblies shall comply with this section: Corridor walls as required by Section 1020.3.
708.6 Openings - Openings in a fire partition shall be protected in accordance with Section 716.
716 - Opening Protectives
716.1(2) - Doors in corridor walls which are required to be 1-hour fire resistance rated fire partitions shall be 20 minute rated.
716.1(3) - Windows in corridor walls which are required to be 1-hour fire resistance rated fire partitions shall be 45 minute rated.

Chapter 8 - Interior Finishes
803 - Wall and Ceiling Finishes
803.1 - Interior wall and ceiling finish materials shall be classified for fire performance and smoke development in accordance with section 803.1.1.
803.13 - Interior finish requirements based on group. - Per Table 803.13
E (non-sprinklered) - Exit enclosures and exit passageways - Class A; Corridors - Class B; Rooms and Enclosed Spaces - Class C.
804 - Interior Floor Finish
804.4.2 Minimum Critical Radiant Flux - In all occupancies, *interior floor finish* and floor covering materials in enclosures for *stairways* and *ramps*, exit passageways, *corridors* and rooms or spaces not separated from corridors by partitions extending from the floor to the underside of the ceiling shall withstand a minimum critical radiant flux. The minimum critical radiant flux shall be not less than Class II in Groups E.

Chapter 9 - Fire Protection Systems
901 - General
901.2 - Fire Protection Systems - Fire protection systems shall installed, repaired, operated and maintained in accordance with this code and the International Fire Code.
Fire alarm and detection systems shall be installed as required by this code and the International Fire Code.
Fire Protection System design information will be a deferred submittal by the respective sub-contractors if required.
Fire Protection Systems are existing and will not be affected and the only impact from this project is the addition of magnetic hold opens at corridor doors. (2)
906 - Portable Fire Extinguishers
906.1 - Portable fire extinguishers shall be installed in the following locations:
1. In new E Occupancies.
2. Within 30 feet distance of travel from commercial cooking equipment.
906.3 - Size and Distribution
Light (Low) Hazard Occupancy (E) - Minimum 2-A Rating, Max 3000 square feet per unit A (6000 square feet), 11,250 square feet max. floor area.
75 feet max. travel distance.

Chapter 10 - Means of Egress
1003.2 - Ceiling Height - The means of egress shall have a ceiling height of not less than 7'-6".
1004.1 - The design occupant load for the space is not being modified by this project.
1005.1 - Means of Egress Sizing - See occupant load table
1010.1 - Doors. Means of egress doors shall meet the requirements of this section.
1010.1.1 - Size of Doors - Doors shall have a minimum clear opening width of 32".
1013.1 - Exit Signs - Where Required - Exits and exit access doors shall be marked by an approved exit sign readily visible from any direction of egress travel.
1017 - Exit Access Travel Distance - Per table 1017.2
E (Non-sprinklered) - 200'

Chapter 11 - Accessibility
1104 - Accessible Route
1104.1 - Site Arrival Points. Accessible routes within the site shall be provided from public transportation stops; accessible parking; accessible passenger loading zones; and public streets or sidewalks to the accessible building entrance served.
1105 - Accessible Entrances
1105.1 - Public Entrances. In addition to accessible entrances required by sections 1105.1.1 through 1105.1.6, at least 60 percent of all public entrances shall be accessible.
1106 - Parking and Passenger Loading Facilities
1106.1 - Required per table 1106.1 - 1-25 spaces require a minimum of 1 accessible spaces - 2 accessible spaces have been provided.

Chapter 29 -Plumbing Systems
Section 2902 - Minimum Plumbing Facilities
The existing square footage of the school is not being modified by this project, as such, the building is being made no less conforming than the existing conditions.

2021 IECC

C402 - Building Envelope Requirements
C402.4 - Building Envelope Fenestration Maximum U-Factor and SHGC Requirements
IECC Table C402.4 - Adams County, Colorado - Climate Zone 5B
Table C402.4
Climate Zone 5B - Maximum U-Factor, Fixed Fenestration - .36
KAWNEER 451UT Series (Replacement Fenestration) - COG U-Value .28 - Overall U-Value .36
Climate Zone 5B - Maximum U-Factor, Entrance Doors - .83
CURRIES 707 Q-MAX (Replacement Entry Door) - COG U-Value .11 Overall U-Value .37

(1)

SPECIAL INSPECTIONS:
The following Special Inspections will be required:
1. Fire-Resistant Penetrations and Joints
(1705.18)

(1)

APPLICABLE DESIGN CODES


(1)
The 2021 International Existing Building Code (IEBC)
The 2021 International Energy Conservation Code (IECC)
The 2021 International Building Code (IBC)
The 2021 Colorado Plumbing Code (CPC)
The 2026 National Electrical Code (NEC)
The 2021 International Fire Code (IFC)
The 2021 NFPA 170 Standard for Fire Safety and Emergency Symbols
2017 ICC A117.1 Accessible and Usable Buildings and Facilities

GENERAL NOTES

1. Items which are not included in the scope of this project are not required to be brought up to code.
2. Items which are included in the scope of this project must meet the requirements of the currently adopted codes.
3. The existing egress configuration is compliant based on the IEBC code requirements, and there are no dead-end corridors.
4. This project scope entails no change to the building occupancy.

LIFE SAFETY LEGEND

PROJECT BOUNDARY
FEC — FIRE EXTINGUISHER CABINET
1 HOUR FIRE (EXISTING)
2 HOUR FIRE PARTITION (EXISTING)
2 HOUR FIRE BARRIER
3 HOUR FIRE
SMOKE BARRIER
XX — PATH OF TRAVEL (FOR CUMULATIVE DISTANCES REFER TO SCHEDULE)
EXIT DISCHARGE
P: XX" / R: XX" — WIDTH PROVIDED / WIDTH REQUIRED
ACCESSIBLE ROUTE

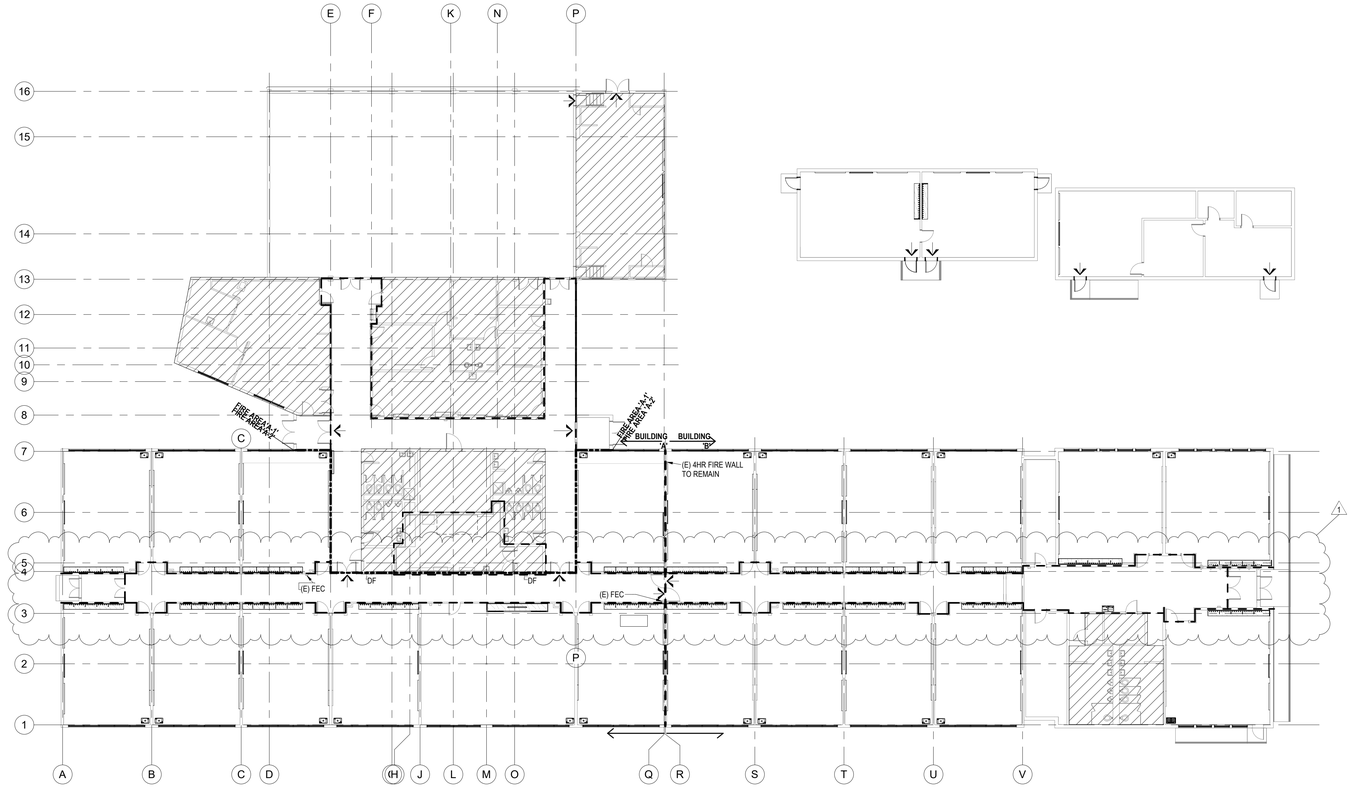

WORKING NORTH
TRUE NORTH

First Floor Life Safety Plan

SCALE: 1/16" = 1'-0"

DAO ARCHITECTURE
7230 Meade St.
Westminster, CO 80030
Phone: 720.273.0431
Email: dan@daoarch.com
Web: www.daoarch.com

Rev. #	Description	Rev. Date
2	Addendum 01	11/12/2026
1	DFPC REVIEW 1	11/5/2026

Revision Schedule

Westminster Public Schools

2026 Bond Projects
Harris Park Elementary

4300 W. 75th Avenue
Westminster, CO 80030

DAO No.: 2025-033

September 25, 2026

Building Code Data

G0.1

Autodesk Docs://WPS 2026 Bond Projects - Harris Park Renovations/Harris Park school - 2019 Kitchen (Revit 2026).rvt
11/12/2026 10:31:29 AM

1. COMPLIANCE AND DOCUMENTATION:

- ENSURE ALL MATERIALS AND WORKMANSHIP ADHERE TO THE LATEST STANDARDS AND SPECIFICATIONS OF THE RELEVANT AUTHORITY HAVING JURISDICTION, UTILITY DISTRICTS, STATE DEPARTMENT OF TRANSPORTATION, JURISDICTIONAL FIRE PROTECTION REQUIREMENTS, AND ALL APPLICABLE STATE AND LOCAL STANDARDS.
- CIVIL SPECIFICATION PROVIDED FOR THIS PROJECT SHALL SUPERSEDE ANY CONFLICTS ON THIS PLAN SET.
- CONTRACTOR SHALL KEEP A SIGNED COPY OF THE APPROVED PLANS, REPORTS, STANDARDS, AND SPECIFICATIONS AT THE JOB SITE AT ALL TIMES. THE CONTRACTOR SHALL MAINTAIN AN ASBUILT REDLINE SET OF PLANS ON THE SITE AT ALL TIMES.
- CONTRACTOR SHALL MAINTAIN EMERGENCY ACCESS ROUTES AS REQUIRED BY THE JURISDICTIONAL FIRE PROTECTION DISTRICT.
- OBTAIN WRITTEN APPROVAL FOR ANY VARIANCES FROM THESE DOCUMENTS.
- NOTIFY THE ENGINEER OF ANY CONFLICTING STANDARDS OR SPECIFICATIONS. IN CASE OF CONFLICTS, THE STRICTER OR HIGHER QUALITY STANDARD WILL APPLY.

2. PERMITS AND APPROVALS:

- THE CONTRACTOR IS RESPONSIBLE FOR ACQUIRING AND ADHERING TO ALL NECESSARY CODES, LICENSES, PERMITS, BONDS, AND STANDARD SPECIFICATIONS REQUIRED FOR THE WORK. THIS INCLUDES LOCAL AND STATE GROUNDWATER DISCHARGE PERMITS.

3. NOTIFICATIONS:

- NOTIFY THE REQUIRED PARTIES (OWNER, OWNER'S REPRESENTATIVE, MUNICIPAL/DISTRICT INSPECTOR, GEOTECHNICAL ENGINEER, ENGINEER, AND/OR UTILITY OWNER) AT LEAST 48 HOURS BEFORE STARTING CONSTRUCTION, PRIOR TO BACKFILLING, AND AS REQUIRED BY JURISDICTIONAL AUTHORITY OR PROJECT SPECIFICATIONS.

4. UTILITIES:

- THE TYPE, SIZE, LOCATION, AND NUMBER OF ALL KNOWN UNDERGROUND UTILITIES IN THE AREA OF CONSTRUCTION HAVE BEEN SHOWN PER FIELD INVESTIGATION BY OTHERS AND AVAILABLE UTILITY RECORDS AND ARE APPROXIMATE ONLY. THE CONTRACTOR SHALL CONTACT THE UTILITY NOTIFICATION CENTER A MINIMUM OF 24 HOURS BEFORE PUTTING A TOOL TO EARTH, IT SHALL BE THE RESPONSIBILITY OF THE CONTRACTOR TO VERIFY THE EXISTENCE AND LOCATION OF ALL UNDERGROUND UTILITIES, SHOWN OR NOT SHOWN ON THESE PLANS, ALONG THE ROUTE OF WORK AND TO COORDINATE CONSTRUCTION SCHEDULES WITH THE UTILITY OWNERS AND TO SCHEDULE UTILITY ADJUSTMENTS TO ELIMINATE CONFLICT WITH PROGRESS OF THE WORK. THE CONTRACTOR SHALL NOTE ALL UTILITIES MAY NOT APPEAR ON THESE PLANS AND THAT THE POTENTIAL CONFLICT WITH UTILITIES SHALL BE CONSIDERED IN THE PREPARATION OF ANY BIDS. THE CONTRACTOR SHALL BE RESPONSIBLE FOR THE PROTECTION OF ALL UTILITIES WHETHER SHOWN ON THE PLANS OR NOT AND SHALL HOLD THE OWNERS AND THE ENGINEER HARMLESS FOR DAMAGE ARISING FROM FAILURE TO ADEQUATELY PROTECT UTILITIES.
- VERIFY THE EXACT SIZE, LOCATION, AND TYPE OF ALL EXISTING UTILITIES BEFORE STARTING WORK.
- THE CONTRACTOR IS SOLELY RESPONSIBLE FOR ANY DAMAGE AND COSTS DUE TO FAILURE TO LOCATE AND PRESERVE UTILITIES.
- NOTIFY PUBLIC AND PRIVATE UTILITY COMPANIES TO DETERMINE THE LOCATION OF ALL EXISTING UTILITIES BEFORE GRADING AND CONSTRUCTION.
- PERFORM AND INSPECT ALL WORK IN UTILITY AREAS ACCORDING TO THE UTILITY OWNER'S REQUIREMENTS.
- OBTAIN APPROVAL FROM THE MUNICIPALITY/UTILITY OWNER AND ENGINEER BEFORE RELOCATING ANY ENCOUNTERED UTILITIES.
- ENSURE ALL SERVICE CONNECTIONS AND RELOCATIONS ARE COORDINATED WITH THE UTILITY OWNER AND ENGINEER.
- IMMEDIATELY NOTIFY THE ENGINEER OF ANY UTILITY DISCREPANCIES OR CONFLICTS.

5. SITE CONDITIONS AND SAFETY:

- THE CONTRACTOR IS SOLELY RESPONSIBLE FOR THE JOB SITE CONDITIONS, INCLUDING SAFETY DURING THE WORK. CONTRACTOR AGREES THAT HE SHALL ASSUME SOLE AND COMPLETE RESPONSIBILITY FOR JOB SITE CONDITIONS DURING THE COURSE OF PROJECT CONSTRUCTION, INCLUDING SAFETY OF ALL PERSONS AND PROPERTY. THIS REQUIREMENT SHALL APPLY CONTINUOUSLY AND NOT BE LIMITED TO NORMAL WORKING HOURS AND THAT THE CONTRACTOR SHALL DEFEND, INDEMNIFY AND HOLD HARMLESS FROM ALL LIABILITY, REAL OR ALLEGED, IN CONNECTION WITH THE PERFORMANCE OF WORK.
- CONTRACTOR TO PREPARE A TRAFFIC CONTROL PLAN FOR APPROVAL AND PROVIDE ALL NECESSARY DEVICES FOR PUBLIC SAFETY..
- COMPLY WITH THE TRAFFIC CONTROL PLAN AND THE "MANUAL ON UNIFORM TRAFFIC CONTROL DEVICES" (MUTCD) FOR CONSTRUCTION SIGNAGE AND TRAFFIC CONTROL..
- CONTRACTOR SHALL VERIFY THAT ALL CONSTRUCTION VEHICLES, HEAVY HAUL EQUIPMENT, CRANES, AND DELIVERY VEHICLES CAN SAFELY ACCESS THE PROJECT SITE. VERIFICATION SHALL INCLUDE ALL HAUL ROUTES, HORIZONTAL AND VERTICAL CLEARANCES, TURNING MOVEMENTS, BRIDGE AND PAVEMENT LOAD LIMITATIONS, PAVEMENT STRUCTURAL CAPACITY, ROADWAY GEOMETRY, TRAFFIC RESTRICTIONS, AND ANY OTHER CONSTRAINTS AFFECTING CONSTRUCTION ACCESS. ANY TEMPORARY IMPROVEMENTS, PERMITS, TRAFFIC CONTROL, OR ALTERNATE ROUTING REQUIRED FOR CONSTRUCTION OPERATIONS SHALL BE THE RESPONSIBILITY OF THE CONTRACTOR.

6. GROUNDWATER MANAGEMENT:

- THE CONTRACTOR SHALL BE RESPONSIBLE TO REMOVE ANY ENCOUNTERED GROUNDWATER DURING CONSTRUCTION IN A MANNER THAT PREVENTS FLOODING OR EROSION AND APPLIES TO ALL STATE AND LOCAL GROUNDWATER DISCHARGE PERMIT REQUIREMENTS.

7. ELEVATION CALLOUTS AND ADJUSTMENTS:

- ADJUST RIMS, COVERS AND GRATE ELEVATIONS TO MATCH THE FINAL PAVEMENT AND FINISHED GRADE ELEVATIONS, REGARDLESS OF ELEVATIONS SHOWN ON PLANS.
- THE EXISTING AND PROPOSED ELEVATIONS SHOWN ON THE PLANS ARE BASED ON EXTRAPOLATED FIELD SURVEY INFORMATION PROVIDED BY OTHERS. CONTRACTOR SHALL CONFIRM ALL ELEVATIONS AT JOINS TO EXISTING FEATURES INCLUDING PAVING, PIPING, FLATWORK, EARTHWORK GRADING, ETC. PRIOR TO CONSTRUCTION. ANY DISCREPANCIES IN ELEVATIONS FROM THOSE SHOWN ON THE PLANS SHALL BE BROUGHT TO THE ENGINEERS ATTENTION PRIOR TO CONSTRUCTION. ALL FLATWORK MUST PREVENT PONDING AND PROVIDE POSITIVE DRAINAGE AWAY FROM STRUCTURES, EQUIPMENT, ETC. TOWARDS THE INTENDED DRAINAGE FEATURE.
- FLOW LINE ELEVATION NOTES: ELEVATIONS AT INLETS CALLED OUT AS FLOW LINE (FL) ARE THE PROJECTION OF THE CURB FLOW LINE AND DO NOT TAKE INTO ACCOUNT THE LOCALIZED DEPRESSION OF THE INLET. CONTRACTOR IS RESPONSIBLE TO STAKE THE INLET CORRECTLY BASED OFF THE ADJUSTMENT NEEDED BETWEEN THE "FL" ELEVATION AND THE ACTUAL FLOW LINE AT THE LOCAL DEPRESSION FOR THE SPECIFIC INLET CALLED OUT.
- RETAINING WALL ELEVATION NOTES: UNLESS OTHERWISE NOTED, ALL ELEVATIONS CALLED OUT ALONG RETAINING WALLS ARE THE FINISHED GROUND ELEVATION AT THE FACE OF WALL, FRONT AND BACK, AND NOT THE WALL ELEVATION ITSELF.

8. FLATWORK AND DRAINAGE:

- OBTAIN APPROVAL FOR FORMWORK AT CRITICAL AREAS BEFORE PLACING CONCRETE.

9. ASPHALT WORK:

- PROVIDE SAWCUTTING AND PATCHING TO ACHIEVE POSITIVE DRAINAGE AND SMOOTH TRANSITIONS TO EXISTING ASPHALT WITHIN ACCEPTABLE SLOPES.
- ADDITIONAL SAWCUTTING AND PATCHING MAY BE REQUIRED AT UTILITY WORK AND CONNECTION POINTS.

10.PROTECTION OF EXISTING FEATURES:

- PROTECT AND MAINTAIN EXISTING MONITORING WELLS, CLEANOUTS, VALVE BOXES, ETC. EXTEND OR LOWER FEATURES TO FINAL SURFACE LEVEL WITH APPROPRIATE CAPS AND LIDS.
- PROVIDE A CONCRETE COLLAR FOR ALL EXISTING AND PROPOSED MONITORING WELLS, CLEANOUTS, VALVE BOXES, ETC., IN LANDSCAPED AREAS.

11.CONCRETE WORK:

- OBTAIN OWNER APPROVAL FOR PRIVATE CONCRETE FINISHING, JOINT PATTERNS, AND COLORING BEFORE CONSTRUCTION. SUBMIT A JOINT LAYOUT PLAN FOR APPROVAL.

12.PIPE LENGTHS AND CONTROL POINTS:

- ADJUST PIPE LENGTHS TO ACCOUNT FOR STRUCTURES AND FLARED END SECTIONS BASED ON THE STRUCTURE DETAILS.
- PIPE LENGTHS SHOWN ON PLANS ARE TO THE CENTER OF STRUCTURE. PIPE LENGTHS SHOWN ON PLANS CONNECTED TO FLARED END SECTIONS (FES) AND HEADWALLS INCLUDE THE FULL LENGTH OF FES AND HEADWALLS AND SHOULD BE ADJUSTED ACCORDINGLY.

13.SITE CLEANUP:

- REMOVE ALL SURPLUS MATERIALS, TOOLS, TEMPORARY STRUCTURES, DEBRIS, AND RUBBISH CAUSED BY CONSTRUCTION. RESTORE THE AREA TO ITS ORIGINAL CONDITION WITHIN 48 HOURS OF PROJECT COMPLETION UNLESS DIRECTED OTHERWISE.

14.EROSION AND SEDIMENT CONTROL:

- IMPLEMENT AND MAINTAIN EROSION AND SEDIMENT CONTROL MEASURES IN ACCORDANCE WITH LOCAL AND STATE GUIDELINES.
- PROHIBIT SILT AND DEBRIS-LADEN RUNOFF FROM LEAVING THE SITE AND KEEP PUBLIC AREAS FREE OF MUD AND DEBRIS.
- RE-ESTABLISH FINAL GRADES AND REMOVE ACCUMULATED SEDIMENTATION FROM ALL AREAS, INCLUDING SWALES, PIPES, INLETS, CURBS AND DETENTION/WATER QUALITY AREAS.
- REMOVE TEMPORARY EROSION CONTROL MEASURES AND REPAIR AREAS AFTER VEGETATION IS ESTABLISHED AND ACCEPTED BY THE OWNER AND MUNICIPALITY.

15.TREE AND VEGETATION PROTECTION:

- PROTECT ALL TREES AND VEGETATION BY PLACING CONSTRUCTION FENCING AT THE DRIP LINE OF TREES AND PLANTS NEAR THE WORK ZONE. HAND EXCAVATION IS REQUIRED AT ROOT ZONES WHERE PROPOSED PAVING OR UTILITY WORK IS WITHIN THE DRIPLINE OF TREES.

16.ASBUILTS

- THE CONTRACTOR, AT THE CONTRACTOR'S EXPENSE, SHALL PROVIDE THE OWNER AND ENGINEER OF RECORD A COMPLETE SET OF CONSTRUCTION RECORD DRAWINGS (ASBUILTS) FOR ALL CONSTRUCTED IMPROVEMENTS, IF REQUIRED BY THE OWNER OR AHJ, THE ASBUILT SET SHALL SHOW SUFFICIENT DIMENSION TIES TO PERMANENT SURFACE FEATURES OR NORTHING/EASTING POINTS FOR ALL BURIED FACILITIES TO ALLOW FOR FUTURE LOCATING. THE ASBUILT SET SHALL SHOW ALL APPLICABLE ASBUILT IMPROVEMENTS INCLUDING BUT NOT LIMITED TO: CONTOURS, ELEVATIONS OF ALL FLATWORK, FLOWLINES, GRADE BREAKS, CROSS SLOPES AND ANY OTHER ELEVATIONS TO DEMONSTRATE COMPLIANCE WITH THE PLANS. ALL POND FEATURES INCLUDING TOP, BOTTOM AND GRADE BREAKS, OUTLET FEATURES INCLUDING TOP AND BOTTOM OF OUTLET STRUCTURE, PERFORATION SIZES AND ELEVATIONS ABOVE INVERT, PIPE INVERTS, ETC. ASBUILTS SHALL BE PREPARED BY A PLS.

TOPSOIL NOTE:

- TOPSOIL IS DEFINED AS FERTILE, FRIABLE, NATURAL LOAM, SURFACE SOIL, REASONABLY FREE OF SUBSOIL, CLAY LUMPS, BRUSH, WEEDS, AND OTHER LITTER, AND FREE OF ROCKS, STUMPS, STONES LARGER THAN 2 INCHES IN ANY DIMENSION, AND OTHER EXTRANEOUS OR TOXIC MATTER HARMFUL TO PLANT GROWTH FOR AREAS TO BE SEEDED OR PLANTED. COORDINATE TESTING REQUIREMENTS WITH ENGINEER AND OWNER.
- ALL TOPSOIL SCRAPED FROM THE SITE IS TO BE STOCKPILED AND REDISTRIBUTED AFTER FINAL GRADING IS COMPLETE.
- CLEAN TOPSOIL FREE OF PLANTS AND SEEDS WILL BE SPREAD TO 4-INCH MINIMUM DEPTH OR AS SPECIFIED BY DRAWINGS, WHICHEVER IS GREATER, PRIOR TO SEEDING. ALL DISTURBED AREAS THAT WILL NOT BE PAVED OR OTHERWISE HAVE PERMANENT EROSION MEASURES ESTABLISHED SHALL HAVE CLEAN TOPSOIL SPREAD TO AN EVEN 4-INCH MINIMUM DEPTH UNLESS SPECIFIED OTHERWISE. IN NO CASE SHALL BARE EARTH REMAIN AT THE CONCLUSION OF CONSTRUCTION.

SURVEY INFORMATION:

SURVEY INFORMATION PROVIDED BY ENGINEERING SERVICE COMPANY (ESC), SEE DESIGN TOPOGRAPHIC SURVEY, DATED 10/14/26.

- BENCHMARK INFORMATION:
  - BENCHMARK: WESTMINSTER BENCHMARK #102: REBAR AND 3-1/4" ALUMINUM CAP WITH AN ILLEGIBLE STAMP 0.65' BELOW GRADE IN RANGE BOX LOCATED AT THE SOUTH ¼ CORNER OF SECTION 31, T.2S., R.68W. OF THE 6TH PM.
  - ELEVATION: 5291.29 FEET (NAVD 1988 DATUM)
  - THE COUNTOURS SHOWN HEREON ARE AT ONE (1) FOOT INTERVALS

GENERAL ABBREVIATIONS

AASHTO	AMERICAN ASSOC. OF STATE HIGHWAY AND TRANSPORTATION OFFICIALS	E	EAST	JTS	JOINTS	R	RIGHT
		EA	EACH			RAD	RADIUS
ABAN	ABANDON	ECC	ECCENTRIC	KO	KNOCKOUT	RCP	REINFORCED CONCRETE PIPE
AC	ASPHALTIC CONCRETE PAVING	EJ	EXPANSION JT	KPL	KICK PLATE	RD	ROOF DRAIN
ADDL	ADDITIONAL	EL	ELEVATION	KWY	KEYWAY	RE	REFERENCE
ADDM	ADDENDUM	ELB	ELBOW			RECT	RECTANGULAR
ADJ	ADJUSTABLE	ELEC	ELECTRICAL	L	LEFT OR LITER	REINF	REINFORCE (D) (ING) (MENT)
AL	ALUMINUM	ENGR	ENGINEER	LSCAPE	LANDSCAPE(ING)	REQD	REQUIRED
ALT	ALTERNATE	EOP	EDGE OF PAVEMENT	LF	LINEAR FOOT	ROW	RIGHT OF WAY
AMT	AMOUNT	EQ	EQUAL	LP	LOW POINT OR LIGHT POLE	R&R	REMOVE AND REPLACE
APPROX	APPROXIMATE	EQUIP	EQUIPMENT	LT	LIGHT		
ARCH	ARCHITECT(URAL)	EQUIV	EQUIVALENT	LWL	LOW WATER LEVEL	SAN	SANITARY
ARV	AIR RELIEF VALVE	ESMT	EASEMENT			SC	SAWCUT
ASTM	AMERICAN SOCIETY FOR TESTING AND MATERIALS	EST	ESTIMATE	MAINT	MAINTENANCE	SD	STORM DRAIN
		EVCE	END VERTICAL CURVE ELEVATION	MAN	MANUAL	SECT	SECTION
ASPH	ASPHALT	EVCS	END VERTICAL CURVE STATION	MATL	MATERIAL	SPD	STANDARD PROCTOR DENSITY
ASSY	ASSEMBLY	EW	EACH WAY	MAX	MAXIMUM	SPEC	SPECIFICATION
ASYM	ASYMMETRICAL	EXP	JT EXPANSION JOINT	ME	MATCH EXISTING	SQ	SQUARE
AUTO	AUTOMATIC	EXIST	EXISTING	MECH	MECHANICAL	SQ IN	SQUARE INCH
AVG	AVERAGE			MEP	MECHANICAL, ELECTRICAL, PLUMBING (ARCH)	SQ FT	SQUARE FOOT
AWWA	AMERICAN WATER WORKS ASSOC.	FND	FOUNDATION	MFR	MANUFACTURER	SQ YD	SQUARE YARD
		FES	FLARED END SECTION	MH	MANHOLE	SS	SANITARY SEWER
BC	BACK OF CURB	FF	FINISH FLOOR	MIN	MINIMUM	SST	STAINLESS STEEL
BFV	BUTTERFLY VALVE	FG	FINISH GRADE	MISC	MISCELLANEOUS	STA	STATION
BG	FINISHED GRADE ADJACENT TO BOTTOM OF WALL	FH	FIRE HYDRANT	MJ	MECHANICAL JOINT	STD	STANDARD
		FL	FLOW LINE			STL	STEEL
BLDG	BUILDING	FN	FENCE	N	NORTH	STRUCT	STRUCTURAL
BLK	BLOCK	FOC	FACE OF CONCRETE	NA	NOT APPLICABLE	SVC	SERVICE
BM	BENCH MARK	FPM	FEET PER MINUTE	NIC	NOT IN CONTRACT	SWMP	STORMWATER MANAGEMENT PLAN
BMP	BEST MANAGEMENT PRACTICE	FPS	FEET PER SECOND	NPT	NATIONAL PIPE THREAD	SWPPP	STORMWATER POLLUTION PREVENTION PLAN
BS	BACKSIGHT	FT	FEET	NTS	NOT TO SCALE	SYM	SYMMETRICAL
BOS	BOTTOM OF STEP	FTG	FOOTING OR FITTING				
BOT	BOTTOM			OS	OFFSET	TB	THRUST BLOCK
BSMT	BASEMENT	G	GAS	OC	ON CENTER	TBC	TOP BACK OF CURB
BVCE	BEGIN VERTICAL CURVE ELEVATION	GA	GAUGE	OD	OUTSIDE DIAMETER	TEMP	TEMPORARY
BVCS	BEGIN VERTICAL CURVE STATION	GAL	GALLON	OPP	OPPOSITE	TG	FINISHED GRADE ADJACENT TO TOP OF WALL
BW	FINISHED GRADE AT BOTTOM OF WALL	GALV	GALVANIZED	OPT	OPTIONAL	THK	THICK
		GB	GRADE BREAK			TOB	TOP OF BANK
CB	CATCH BASIN	GIP	GALVANIZED IRON PIPE	PC	POINT OF CURVATURE	TOC	TOP OF CONCRETE OR TOP OF CURB
CDOT	COLORADO DEPARTMENT OF TRANSPORTATION	GND	GROUND	PCO	PRESSURE CLEAN OUT	TOS	TOP OF STEP
		GPD	GALLONS PER DAY	PCR	POINT OF CURVE RETURN	TOT	TOTAL
CIP	CAST IRON PIPE	GPM	GALLONS PER MINUTE	PI	POINT OF INTERSECTION	TW	FINISHED GRADE AT TOP OF WALL
CJ	CONSTRUCTION JOINT	GR	GRATE	PVI	POINT OF VERTICAL INTERSECTION	TYP	TYPICAL
CL	CENTER LINE	GRTG	GRATING	PL	PROPERTY LINE		
CLR	CLEAR	GSP	GALVANIZED STEEL PIPE	PE	POLYETHYLENE	UBC	UNIFORM BUILDING CODE
CMP	CORRUGATED METAL PIPE	GV	GATE VALVE	PREFAB	PREFABRICATED	UGE	UNDERGROUND ELECTRIC
CMU	CONCRETE MASONRY UNIT			PRELIM	PRELIMINARY	UTIL	UTILITY
CO	CLEANOUT	H	HIGH	PREP	PREPARATION	VERT	VERTICAL
CONC	CONCRETE	HDWL	HEADWALL	PROP	PROPOSED	VC	POINT OF VERTICAL CURVATURE
CONST	CONSTRUCTION	HNDRL	HAND RAIL	PRV	PRESSURE REDUCING VALVE OR PRESSURE RELIEF VALVE	VCP	VITRIFIED CLAY PIPE
CONT	CONTINUOUS	HORIZ	HORIZONTAL				
CR	CONCENTRIC REDUCER	HP	HIGH POINT	PSF	POUNDS PER SQUARE FOOT	W	WIDE OR WIDTH
CTR	CENTER	HR	HOUR	PSI	POUNDS PER SQUARE INCH	W/	WITH
CY	CUBIC YARDS	HVAC	HEATING, VENTILATION, AIR CONDITIONING	PT	POINT OF TANGENCY	W/O	WITHOUT
		HWY	HIGHWAY	PV	PLUG VALVE	WQCV	WATER QUALITY CONTROL VOLUME
DEMO	DEMOLITION	HWL	HIGH WATER LINE	PVC	POLYVINYL CHLORIDE OR POINT OF VERTICAL CURVATURE	WSE	WATER SURFACE ELEVATION
DET	DETAIL	HYD	HYDRANT			WW	WASTEWATER
DIA	DIAMETER			PVMT	PAVEMENT		
DIAG	DIAGONAL	INCL	INCLUDED			X	SECT CROSS SECTION
DIP	DUCTILE IRON PIPE	ID	INSIDE DIAMETER	QTY	QUANTITY	XFMR	ELECTRICAL TRANSFORMER
DOM	DOMESTIC	IN	INLET				
DN	DOWN	INV	INVERT				
DWG	DRAWING	IRR	IRRIGATION				

Sheet Index

Sheet Number	Sheet Title
C001	GENERAL NOTES
C100	DEMOLITION PLAN
C300	GRADING & DRAINAGE PLAN
CD301	DRAINAGE DETAILS
C500	HORIZONTAL CONTROL PLAN
CD501	HORIZONTAL CONTROL PLAN DETAILS

DAO ARCHITECTURE

7230 Meade St.
Westminster, CO 80030

Phone: 720.273.0431
Email: dan@daoarch.com
Web: www.daoarch.com

CONTERRA ENGINEERING

242 Linden Street # 5943
Fort Collins, CO 80524

Phone: 720.689.5806
Email: info@conterraeng.com
Web: www.conterraeng.com

Westminster Public Schools

HARRIS PARK ELEMENTARY KITCHEN RENOVATIONS


4300 W. 75th Avenue
Westminster, CO 80030

DAO No.: 2022-022

November 12, 2026

GENERAL NOTES

C001

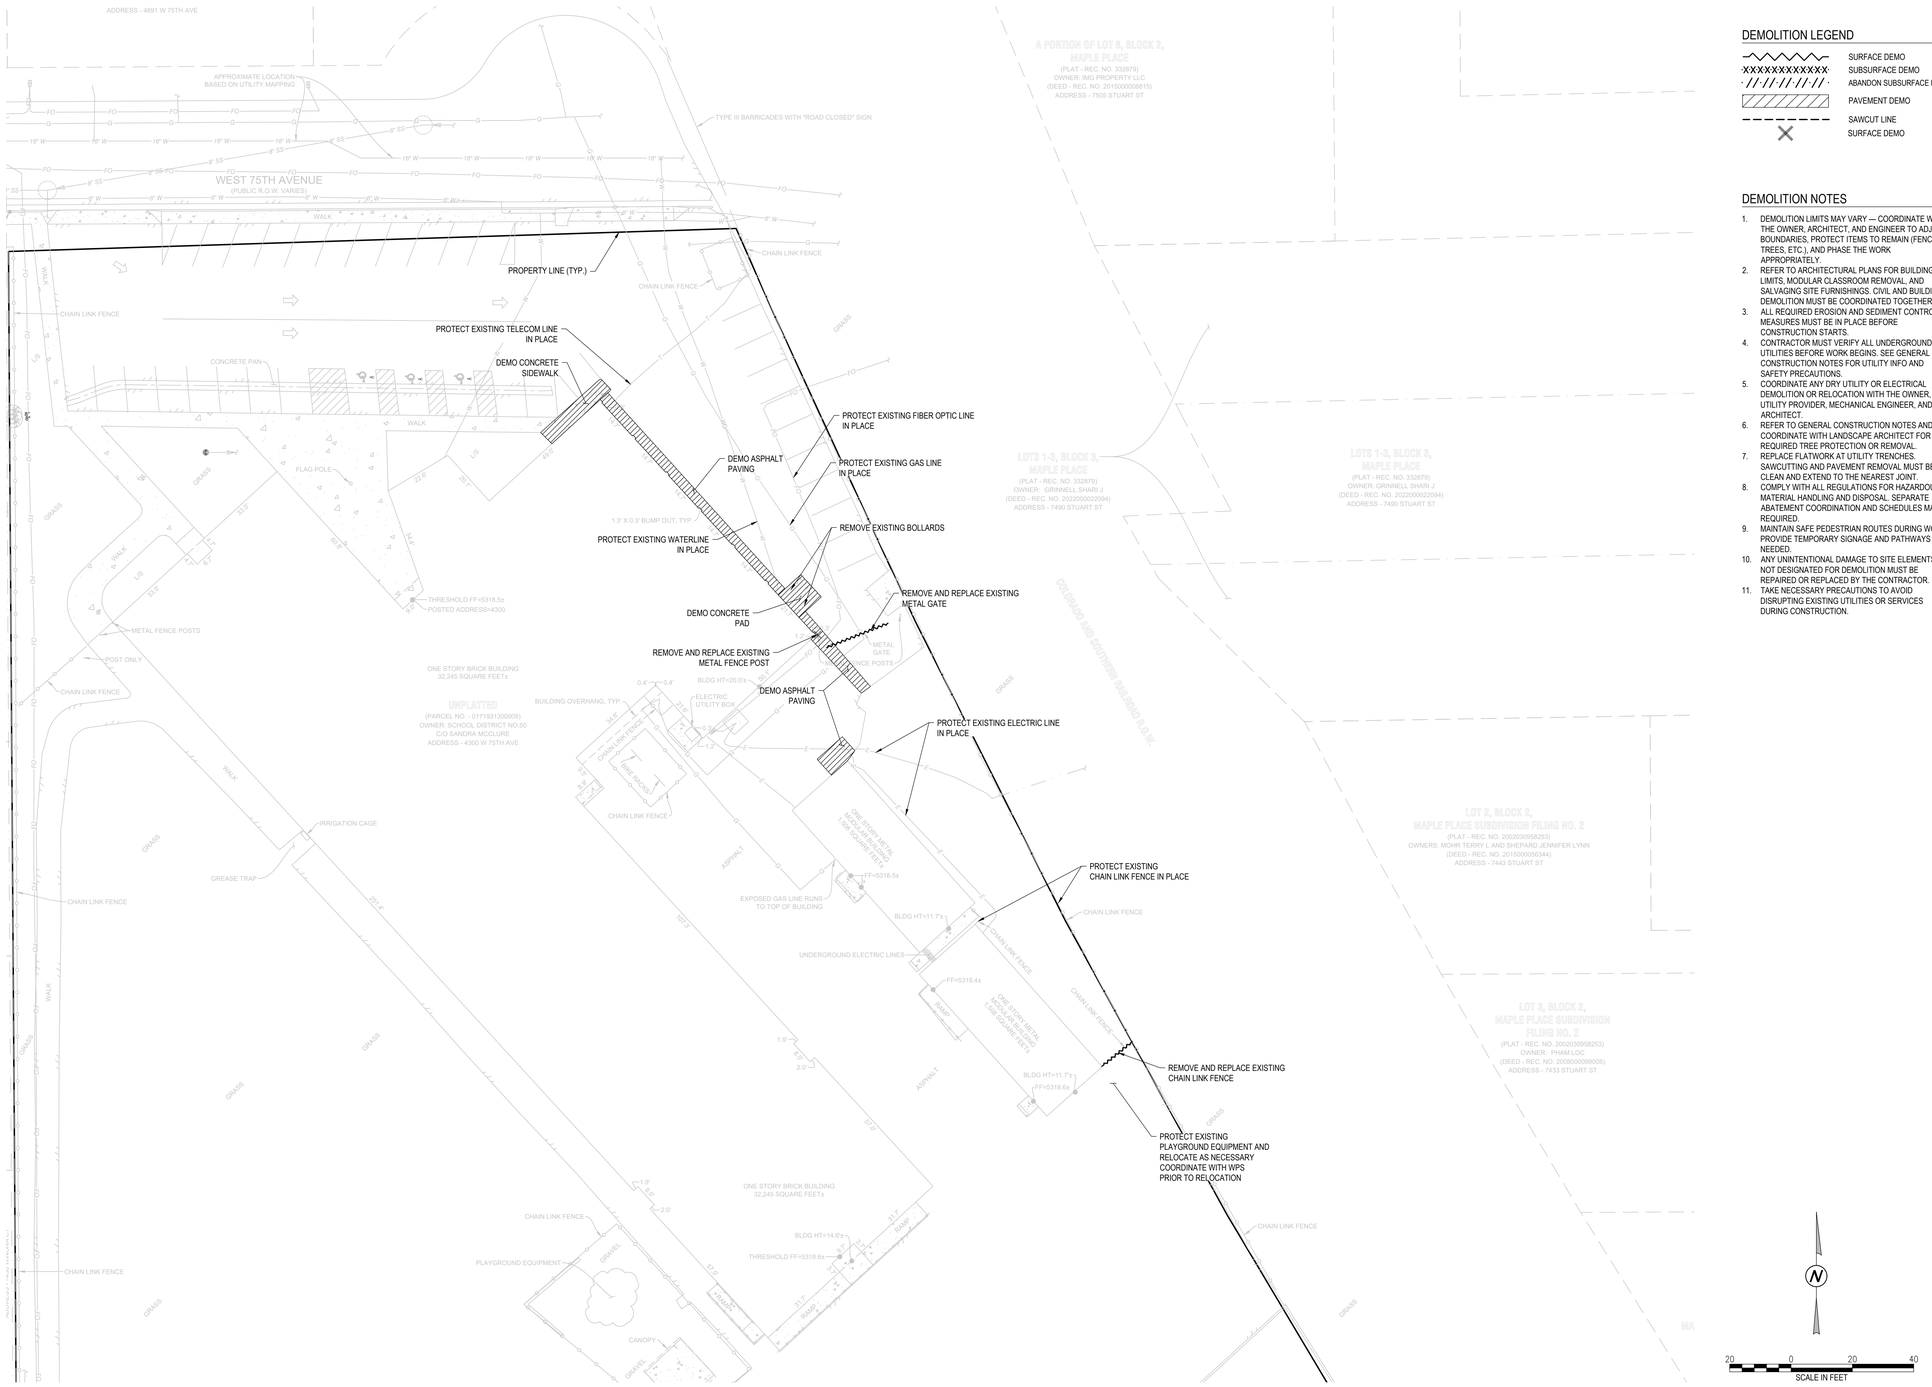

DEMOLITION LEGEND

- SURFACE DEMO
- SUBSURFACE DEMO
- ABANDON SUBSURFACE FEATURE
- PAVEMENT DEMO
- SAWCUT LINE
- SURFACE DEMO

DEMOLITION NOTES

1. DEMOLITION LIMITS MAY VARY — COORDINATE WITH THE OWNER, ARCHITECT, AND ENGINEER TO ADJUST BOUNDARIES, PROTECT ITEMS TO REMAIN (FENCING, TREES, ETC.), AND PHASE THE WORK APPROPRIATELY.
2. REFER TO ARCHITECTURAL PLANS FOR BUILDING LIMITS, MODULAR CLASSROOM REMOVAL, AND SALVAGING SITE FURNISHINGS. CIVIL AND BUILDING DEMOLITION MUST BE COORDINATED TOGETHER.
3. ALL REQUIRED EROSION AND SEDIMENT CONTROL MEASURES MUST BE IN PLACE BEFORE CONSTRUCTION STARTS.
4. CONTRACTOR MUST VERIFY ALL UNDERGROUND UTILITIES BEFORE WORK BEGINS. SEE GENERAL CONSTRUCTION NOTES FOR UTILITY INFO AND SAFETY PRECAUTIONS.
5. COORDINATE ANY DRY UTILITY OR ELECTRICAL DEMOLITION OR RELOCATION WITH THE OWNER, UTILITY PROVIDER, MECHANICAL ENGINEER, AND ARCHITECT.
6. REFER TO GENERAL CONSTRUCTION NOTES AND COORDINATE WITH LANDSCAPE ARCHITECT FOR ANY REQUIRED TREE PROTECTION OR REMOVAL.
7. REPLACE FLATWORK AT UTILITY TRENCHES. SAWCUTTING AND PAVEMENT REMOVAL MUST BE CLEAN AND EXTEND TO THE NEAREST JOINT.
8. COMPLY WITH ALL REGULATIONS FOR HAZARDOUS MATERIAL HANDLING AND DISPOSAL. SEPARATE ABATEMENT COORDINATION AND SCHEDULES MAY BE REQUIRED.
9. MAINTAIN SAFE PEDESTRIAN ROUTES DURING WORK. PROVIDE TEMPORARY SIGNAGE AND PATHWAYS AS NEEDED.
10. ANY UNINTENTIONAL DAMAGE TO SITE ELEMENTS NOT DESIGNATED FOR DEMOLITION MUST BE REPAIRED OR REPLACED BY THE CONTRACTOR.
11. TAKE NECESSARY PRECAUTIONS TO AVOID DISRUPTING EXISTING UTILITIES OR SERVICES DURING CONSTRUCTION.

DAO ARCHITECTURE
7230 Meade St.
Westminster, CO 80030
Phone: 720.273.0431
Email: dan@daoarch.com
Web: www.daoarch.com

CONTERRA ENGINEERING
242 Linden Street # 5943
Fort Collins, CO 80524
Phone: 720.689.5806
Email: info@conterraeng.com
Web: www.conterraeng.com

Westminster Public Schools

HARRIS PARK ELEMENTARY KITCHEN RENOVATIONS


4300 W. 75th Avenue
Westminster, CO 80030

DAO No.: 2022-022

November 12, 2026

DEMOLITION PLAN

C100

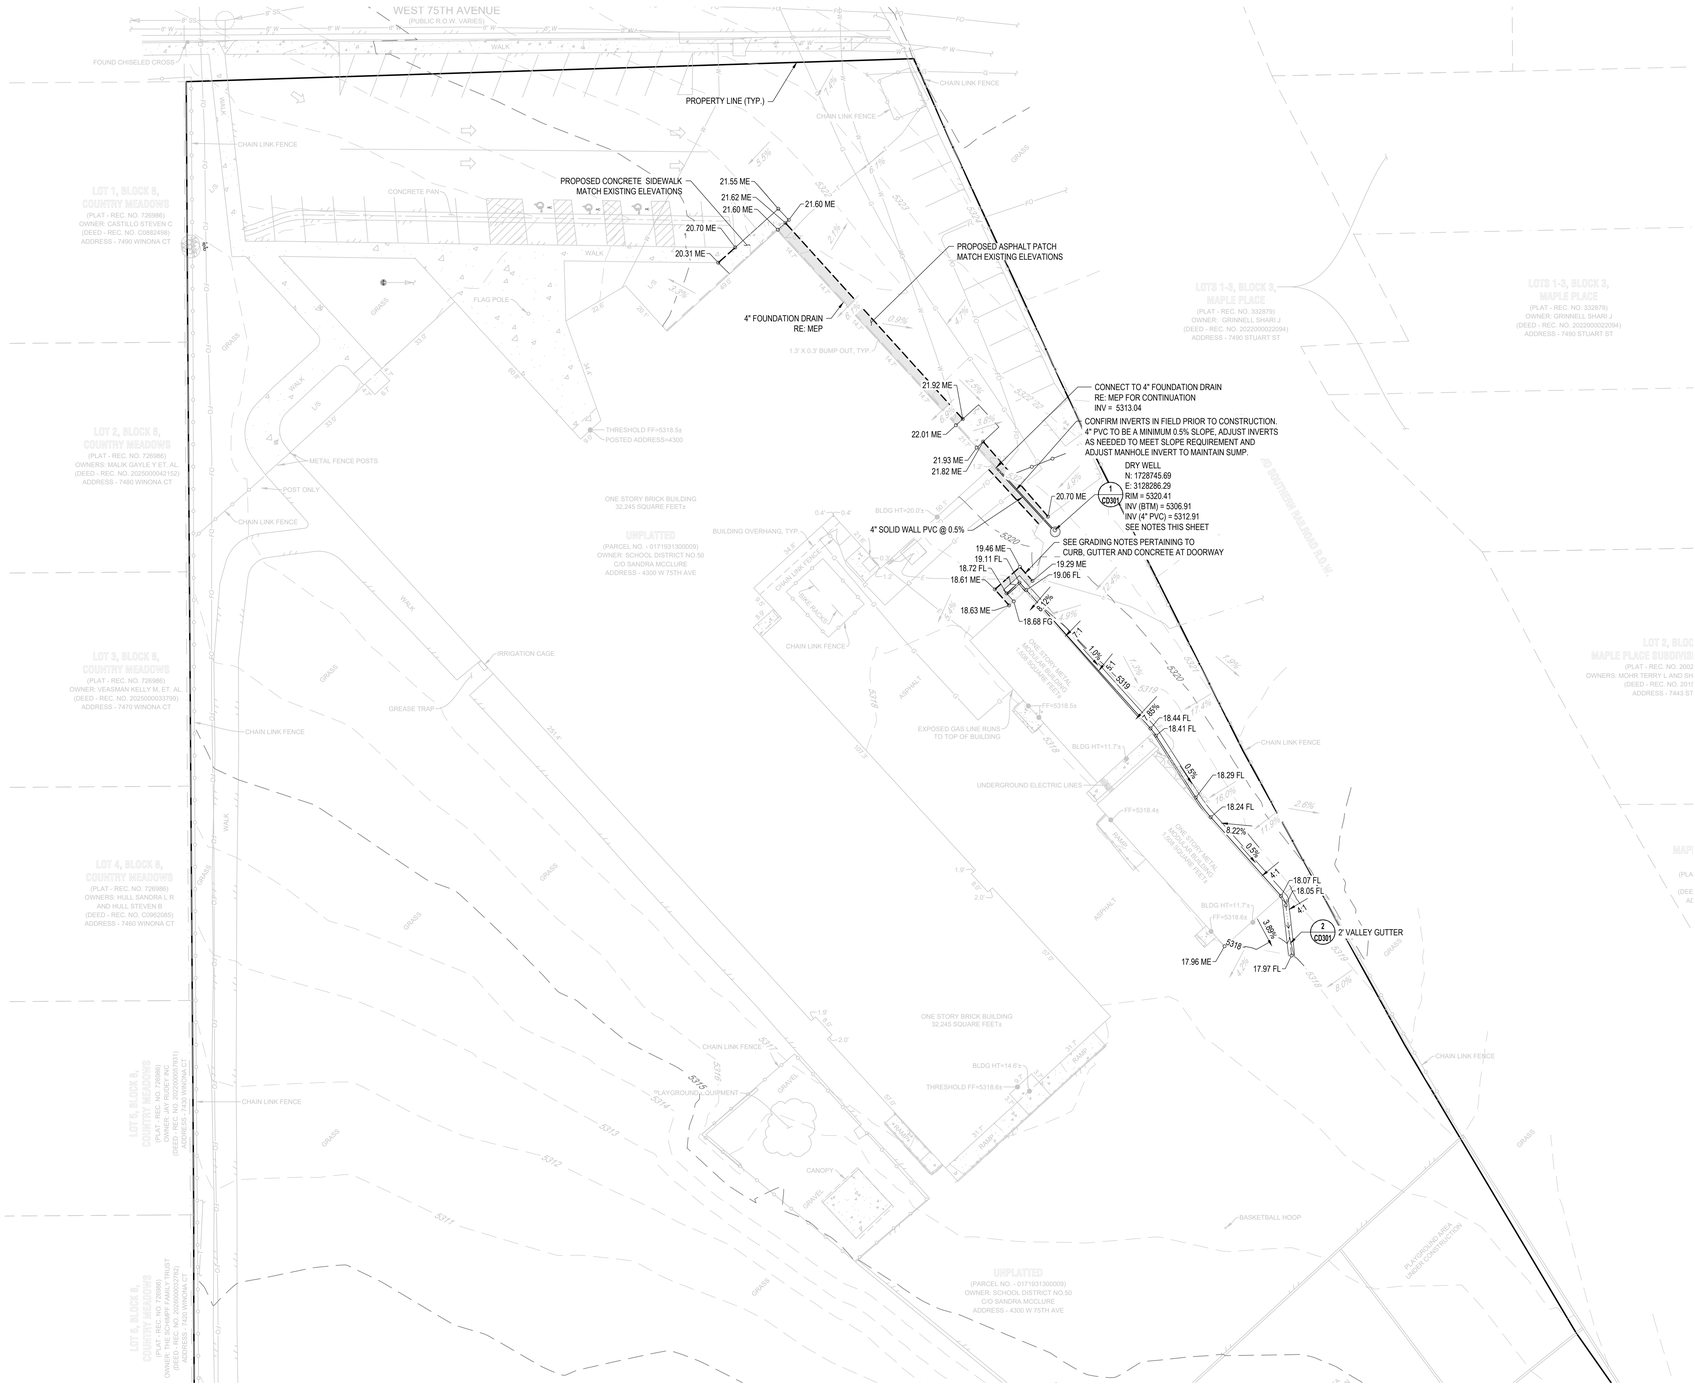

GENERAL LEGEND

- PROPERTY LINE
- EASEMENT
- EX MINOR CONTOUR
- EX MAJOR CONTOUR
- PR MINOR CONTOUR
- PR MAJOR CONTOUR
- EX SPOT ELEVATION
- PR SPOT ELEVATION
- SLOPE ARROW
- SAWCUT LINE
- FENCE
- GRADE BREAK LINE
- FLOW LINE
- CURB AND GUTTER
- ASPHALT PAVING
- CONCRETE PAVING
- GRAVEL
- BUILDING
- SIGN POST
- STORM DRAIN
- STORM INLET
- FLARED END SECTION (FES)
- SANITARY SEWER
- CLEAN OUT
- MANHOLE
- ELECTRIC LINE
- GAS LINE
- WATERLINE
- HYDRANT
- BENDS
- GATE VALVE

DRY WELL NOTES

1. THE DRY WELL IS TO BE SURROUNDED BY CLEAN, WASHED 3/4" TO 2" CRUSHED ROCK, COMPACTED PER SPECIFICATIONS AND A MINIMUM WIDTH OF 24" THE ENTIRE HEIGHT OF THE RING. EXTEND 18" BELOW BOTTOM RING.
2. THE CRUSHED ROCK AND DRY WELL IS TO BE SURROUNDED BY A NONWOVEN GEOTEXILE FABRIC, MIRAFI 140N OR EQUIVALENT.
3. PROVIDE EXTRA ADJUSTING RINGS TO ALLOW FOR FINAL ADJUSTMENT OF RIM ELEVATION TO FINAL FINISHED GRADE.
4. FINAL DEPTH OF DRY WELL IS DEPENDANT ON GEOTECHNICAL INVESTIGATION OF DRAINAGE LAYER IN THE SOIL. ASSUME DEPTH SHOWN AS MINIMUM.

GRADING NOTES

1. MAINTAIN ELEVATIONS AT ENTRANCE TO MODULAR CLASSROOM. INTENT OF THE CURB IS TO SURROUND THE EXISTING CONCRETE PAD AT THE ENTRANCE TO THE CLASSROOM.
2. REINSTALL CONCRETE PAD AT ENTRANCE TO EXISTING ELEVATIONS AND/OR MATCH THE DOOR THRESHOLD AS NEEDED IF DIFFERENTIAL SETTLEMENT HAS OCCURRED.
3. CURB ELEVATIONS ARE INTENDED TO TIE INTO THE EXISTING SURROUNDING ELEVATIONS AND PROVIDE POSITIVE SLOPES AROUND THE ENTRANCE.
4. NOTIFY ENGINEER OF ANY DISCREPANCIES PRIOR TO PLACEMENT OF CONCRETE. INSTALL FORMWORK AND CONFIRM POSITIVE DRAINAGE AWAY FROM DOORWAY.

DAO ARCHITECTURE
7230 Meade St.
Westminster, CO 80030
Phone: 720.273.0431
Email: dan@daoarch.com
Web: www.daoarch.com

CONTERRA ENGINEERING
242 Linden Street # 5943
Fort Collins, CO 80524
Phone: 720.689.5806
Email: info@conterraeng.com
Web: www.conterraeng.com

Westminster Public Schools

HARRIS PARK ELEMENTARY KITCHEN RENOVATIONS


4300 W. 75th Avenue
Westminster, CO 80030

DAO No.: 2022-022

November 12, 2026

GRADING & DRAINAGE PLAN


C300

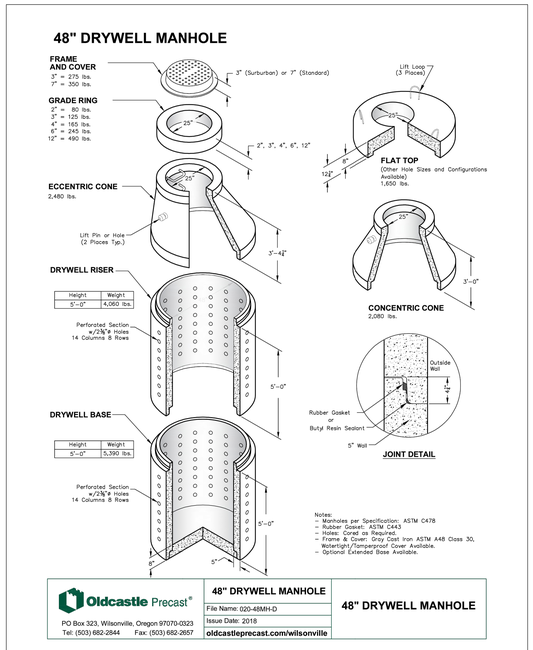

NOTES:

1. DRY WELL TO BE OLD CASTLE OR APPROVED EQUIVALENT


1 / C300 DRY WELL DETAIL
NOT TO SCALE

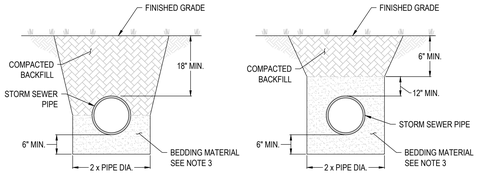

NOTES:

1. BACKFILL TO BE COMPACTED IN 8" LIFTS MAX.
2. SEE PLANS FOR PIPE DETAILS (SIZE, SLOPE, MATERIAL, LENGTH, ETC.)
3. SEE SPECIFICATION FOR BEDDING MATERIAL. BEDDING MATERIAL TO BE COMPACTED TO 95% OF THE STANDARD PROCTOR MAX DRY DENSITY.
4. REMOVE UNSUITABLE SOILS AND BACKFILL WITH MATERIALS APPROVED BY ENGINEER.

3 / C300 STORM SEWER TRENCH DETAIL
NOT TO SCALE

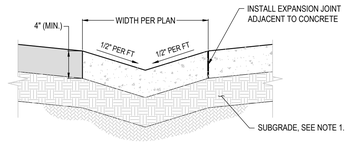

NOTES:

1. SUBGRADE TO BE OVER-EXCAVATED, MOISTURE TREATED, AND RECOMPACTED PER SPECIFICATIONS.
2. EXPANSION JOINTS AND CONTRACTION JOINTS SHOWN PER SEPARATE DETAIL.
3. FIBERMESH REINFORCEMENT SHALL BE IN ALL CONCRETE, PER SPECIFICATIONS.
4. CONCRETE JOINT LAYOUT PLAN SHALL BE PROVIDED BY THE CONTRACTOR TO THE OWNER FOR THEIR APPROVAL.

2 / C300 CONCRETE PAN DETAIL
NOT TO SCALE

DAO ARCHITECTURE

7230 Meade St.
Westminster, CO 80030

Phone: 720.273.0431
Email: dan@daoarch.com
Web: www.daoarch.com

CONTERRA ENGINEERING

242 Linden Street # 5943
Fort Collins, CO 80524

Phone: 720.689.5806
Email: info@conterraeng.com
Web: www.conterraeng.com

Westminster Public Schools

HARRIS PARK ELEMENTARY KITCHEN RENOVATIONS


4300 W. 75th Avenue
Westminster, CO 80030

DAO No.: 2022-022

November 12, 2026

DRAINAGE DETAILS

CD301

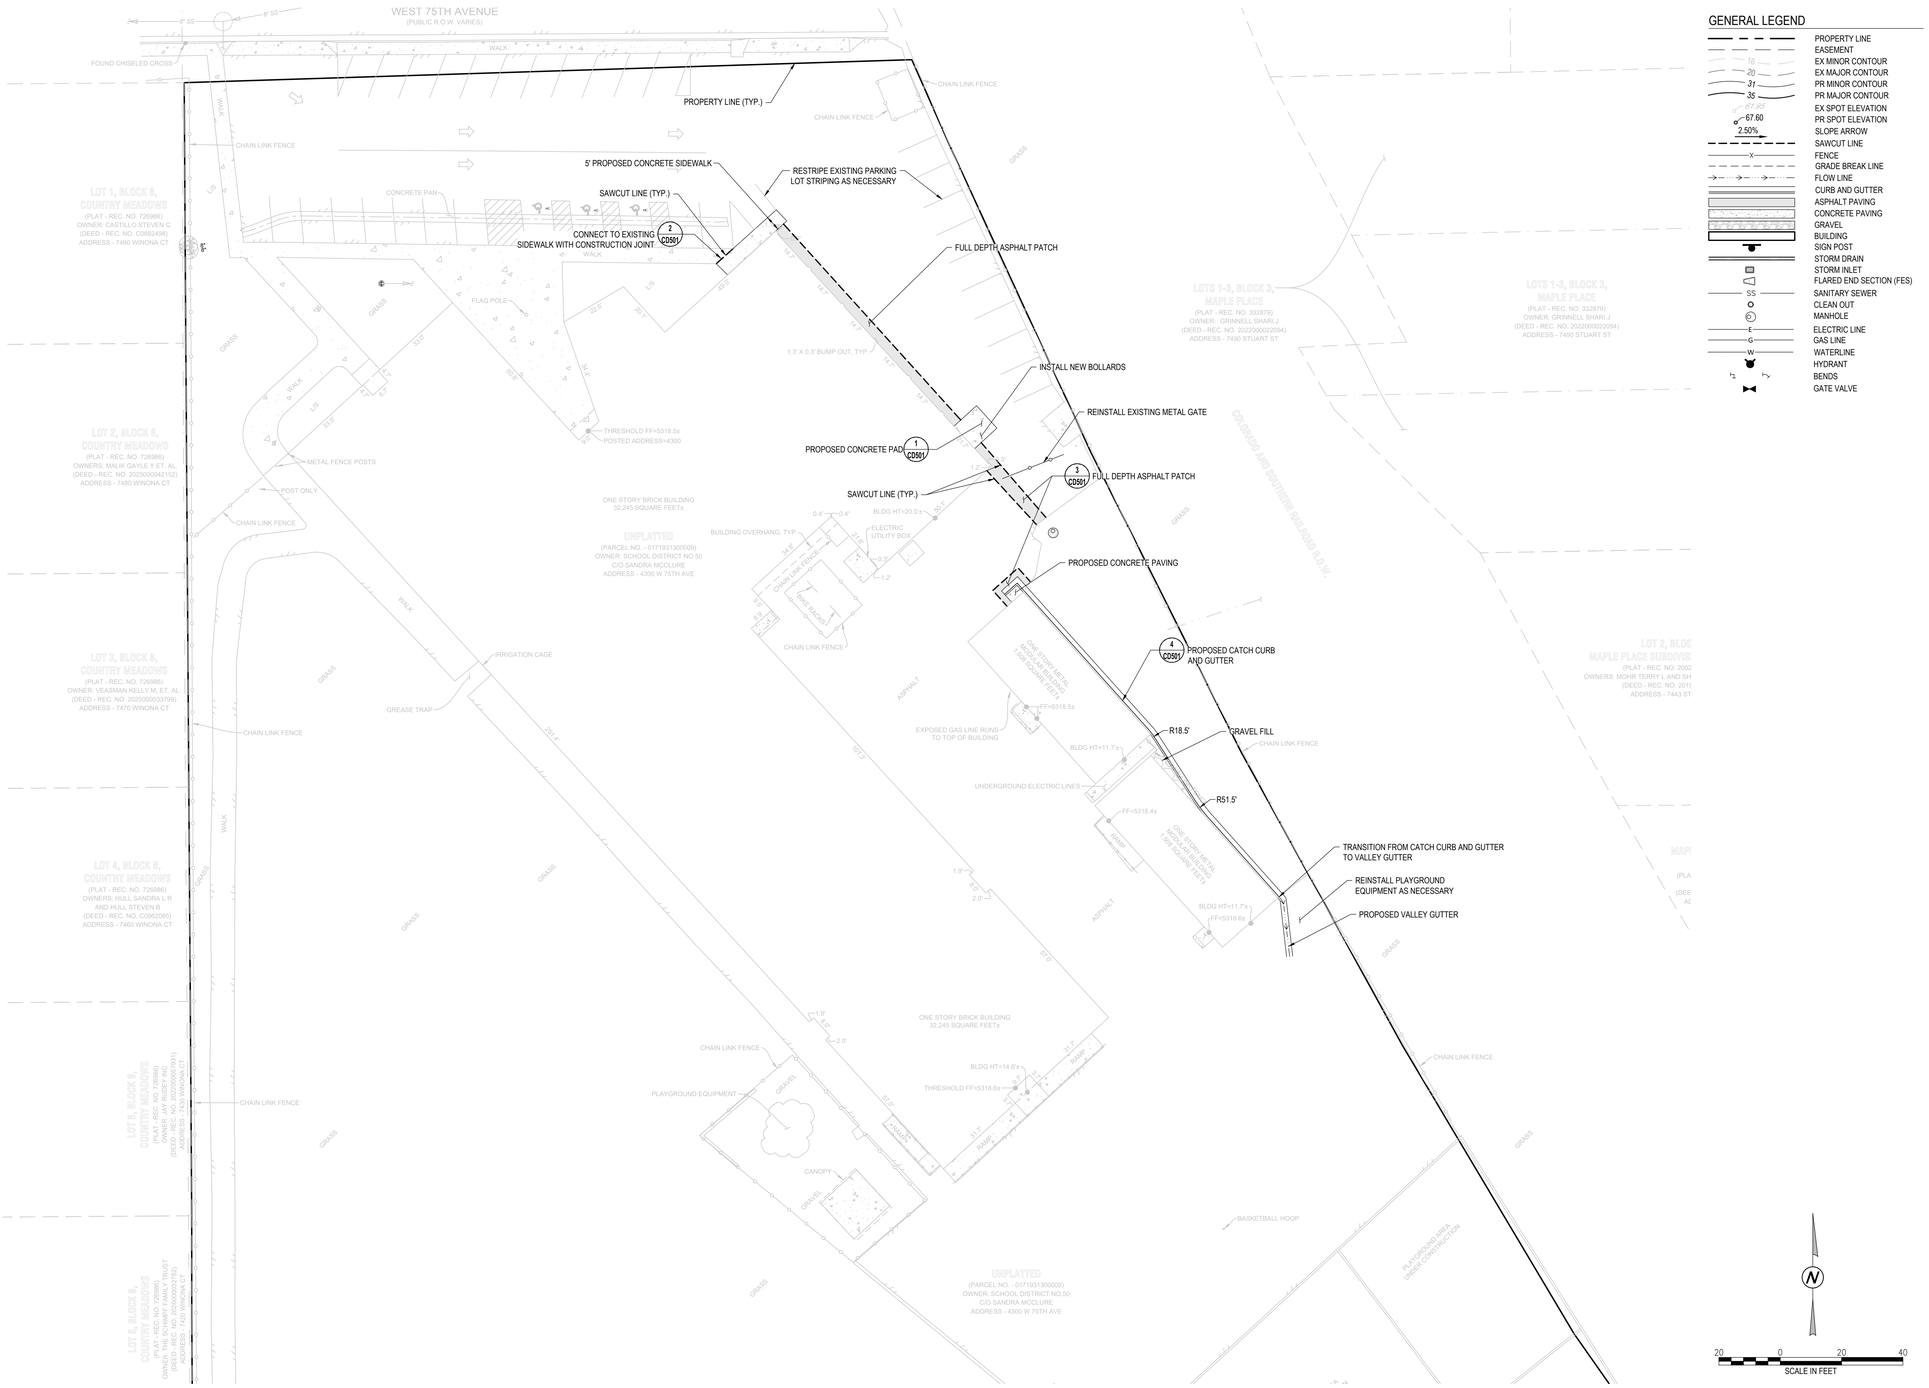

GENERAL LEGEND

- PROPERTY LINE
- EASEMENT
- EX MINOR CONTOUR
- EX MAJOR CONTOUR
- PR MINOR CONTOUR
- PR MAJOR CONTOUR
- EX SPOT ELEVATION
- PR SPOT ELEVATION
- SLOPE ARROW
- SAWCUT LINE
- FENCE
- GRADE BREAK LINE
- FLOW LINE
- CURB AND GUTTER
- ASPHALT PAVING
- CONCRETE PAVING
- GRAVEL
- BUILDING
- SIGN POST
- STORM DRAIN
- STORM INLET
- FLARED END SECTION (FES)
- SANITARY SEWER
- CLEAN OUT
- MANHOLE
- ELECTRIC LINE
- GAS LINE
- WATERLINE
- HYDRANT
- BENDS
- GATE VALVE

20 0 20 40
SCALE IN FEET

DAO ARCHITECTURE
7230 Meade St.
Westminster, CO 80030
Phone: 720.273.0431
Email: dan@daoarch.com
Web: www.daoarch.com

CONTERRA ENGINEERING
242 Linden Street # 5943
Fort Collins, CO 80524
Phone: 720.689.5806
Email: info@conterraeng.com
Web: www.conterraeng.com

Westminster Public Schools

HARRIS PARK ELEMENTARY KITCHEN RENOVATIONS


4300 W. 75th Avenue
Westminster, CO 80030

DAO No.: 2022-022

November 12, 2026

HORIZONTAL CONTROL PLAN


C500

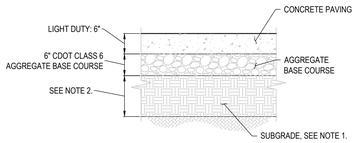


NOTES:

1. SUBGRADE TO BE OVER-EXCAVATED, MOISTURE TREATED, AND RECOMPACTED PER SPECIFICATIONS.
2. SUBGRADE TO BE CONDITIONED AND COMPACTED TO A DEPTH OF AT LEAST 24 INCHES OR A DEPTH THAT REMOVES AND REPLACES ALL UNDOCUMENTED FILL SOILS, WHICHEVER IS GREATER.
3. EXPANSION JOINTS AND CONTRACTION JOINTS SHOWN PER SEPARATE DETAIL.
4. FIBERMESH REINFORCEMENT SHALL BE IN ALL CONCRETE, PER SPECIFICATIONS
5. HEAVY DUTY CONCRETE TO HAVE REINFORCEMENT: #4 REBAR, 12-INCHES ON CENTER EACH WAY, 3-INCHES CLEAR ON ALL SIDES, REFERENCE SPECIFICATIONS.

1 / C500 CONCRETE PAVEMENT SECTION DETAIL
NOT TO SCALE

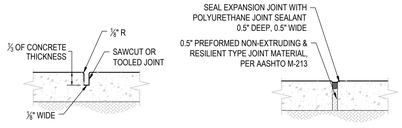


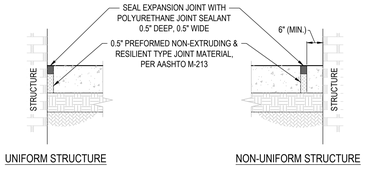

NOTES:

1. CONTROL/CONTRACTION JOINTS SHALL BE AT INTERVAL TO MATCH WIDTH OF SIDEWALK (6' MAX).
2. PROVIDE EXPANSION JOINTS IN THE CURB AT INTERVALS NOT EXCEEDING 100 FEET AND AT ALL LOCATIONS WHERE NEW SIDEWALK CONNECTS TO EXISTING OR PROPOSED CONCRETE STRUCTURES, UNLESS OTHERWISE NOTED. REFER TO PLAN FOR SPECIFIC LOCATIONS.
3. REMOVE ANY PLASTIC FORMING MATERIAL (E.G., "ZIP STRIPS") FROM THE PREFORMED JOINT FILLER BEFORE APPLYING JOINT SEALANT.


2 / C500 CONCRETE JOINT DETAIL
NOT TO SCALE

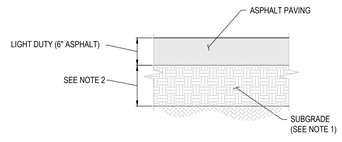

NOTES:

1. SUBGRADE TO BE OVER-EXCAVATED, MOISTURE TREATED, AND RECOMPACTED PER SPECIFICATIONS.
2. SUBGRADE TO BE CONDITIONED AND COMPACTED TO A DEPTH OF AT LEAST 24 INCHES OR A DEPTH THAT REMOVES AND REPLACES ALL UNDOCUMENTED FILL SOILS, WHICHEVER IS GREATER.
3. LIGHT DUTY ASPHALT TO BE INSTALLED FOR CAR PARKING STALLS.
4. HEAVY DUTY ASPHALT TO BE INSTALLED FOR DRIVE LANES, SERVICE DRIVES, AND BUS LOOPS.
5. REFER TO SPECIFICATIONS FOR SURFACE (TOP) COURSE TYPES AND MINIMUM THICKNESS.

3 / C500 FULL DEPTH ASPHALT PAVEMENT SECTION DETAIL
NOT TO SCALE

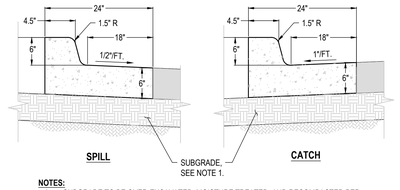

NOTES:

1. SUBGRADE TO BE OVER-EXCAVATED, MOISTURE TREATED, AND RECOMPACTED PER SPECIFICATIONS.
2. EXPANSION JOINTS AND CONTRACTION JOINTS SHOWN PER SEPARATE DETAIL.
3. FIBERMESH REINFORCEMENT SHALL BE IN ALL CONCRETE, PER SPECIFICATIONS.
4. INSTALL EXPANSION JOINTS BETWEEN CONCRETE CURB AND GUTTER ADJACENT TO CONCRETE PAVEMENT.
5. CONTRACTION/EXPANSION JOINTS SHALL BE SPACE 5'-10' APART.
6. TRANSITION BETWEEN SPILL AND CATCH CURB OVER 4'-10'.

4 / C500 CURB & GUTTER DETAIL
NOT TO SCALE

DAO ARCHITECTURE

7230 Meade St.
Westminster, CO 80030

Phone: 720.273.0431
Email: dan@daoarch.com
Web: www.daoarch.com

CONTERRA ENGINEERING

242 Linden Street # 5943
Fort Collins, CO 80524

Phone: 720.689.5806
Email: info@conterraeng.com
Web: www.conterraeng.com

Westminster Public Schools

HARRIS PARK ELEMENTARY KITCHEN RENOVATIONS


4300 W. 75th Avenue
Westminster, CO 80030

DAO No.: 2022-022

November 12, 2026

HORIZONTAL CONTROL PLAN DETAILS

CD501

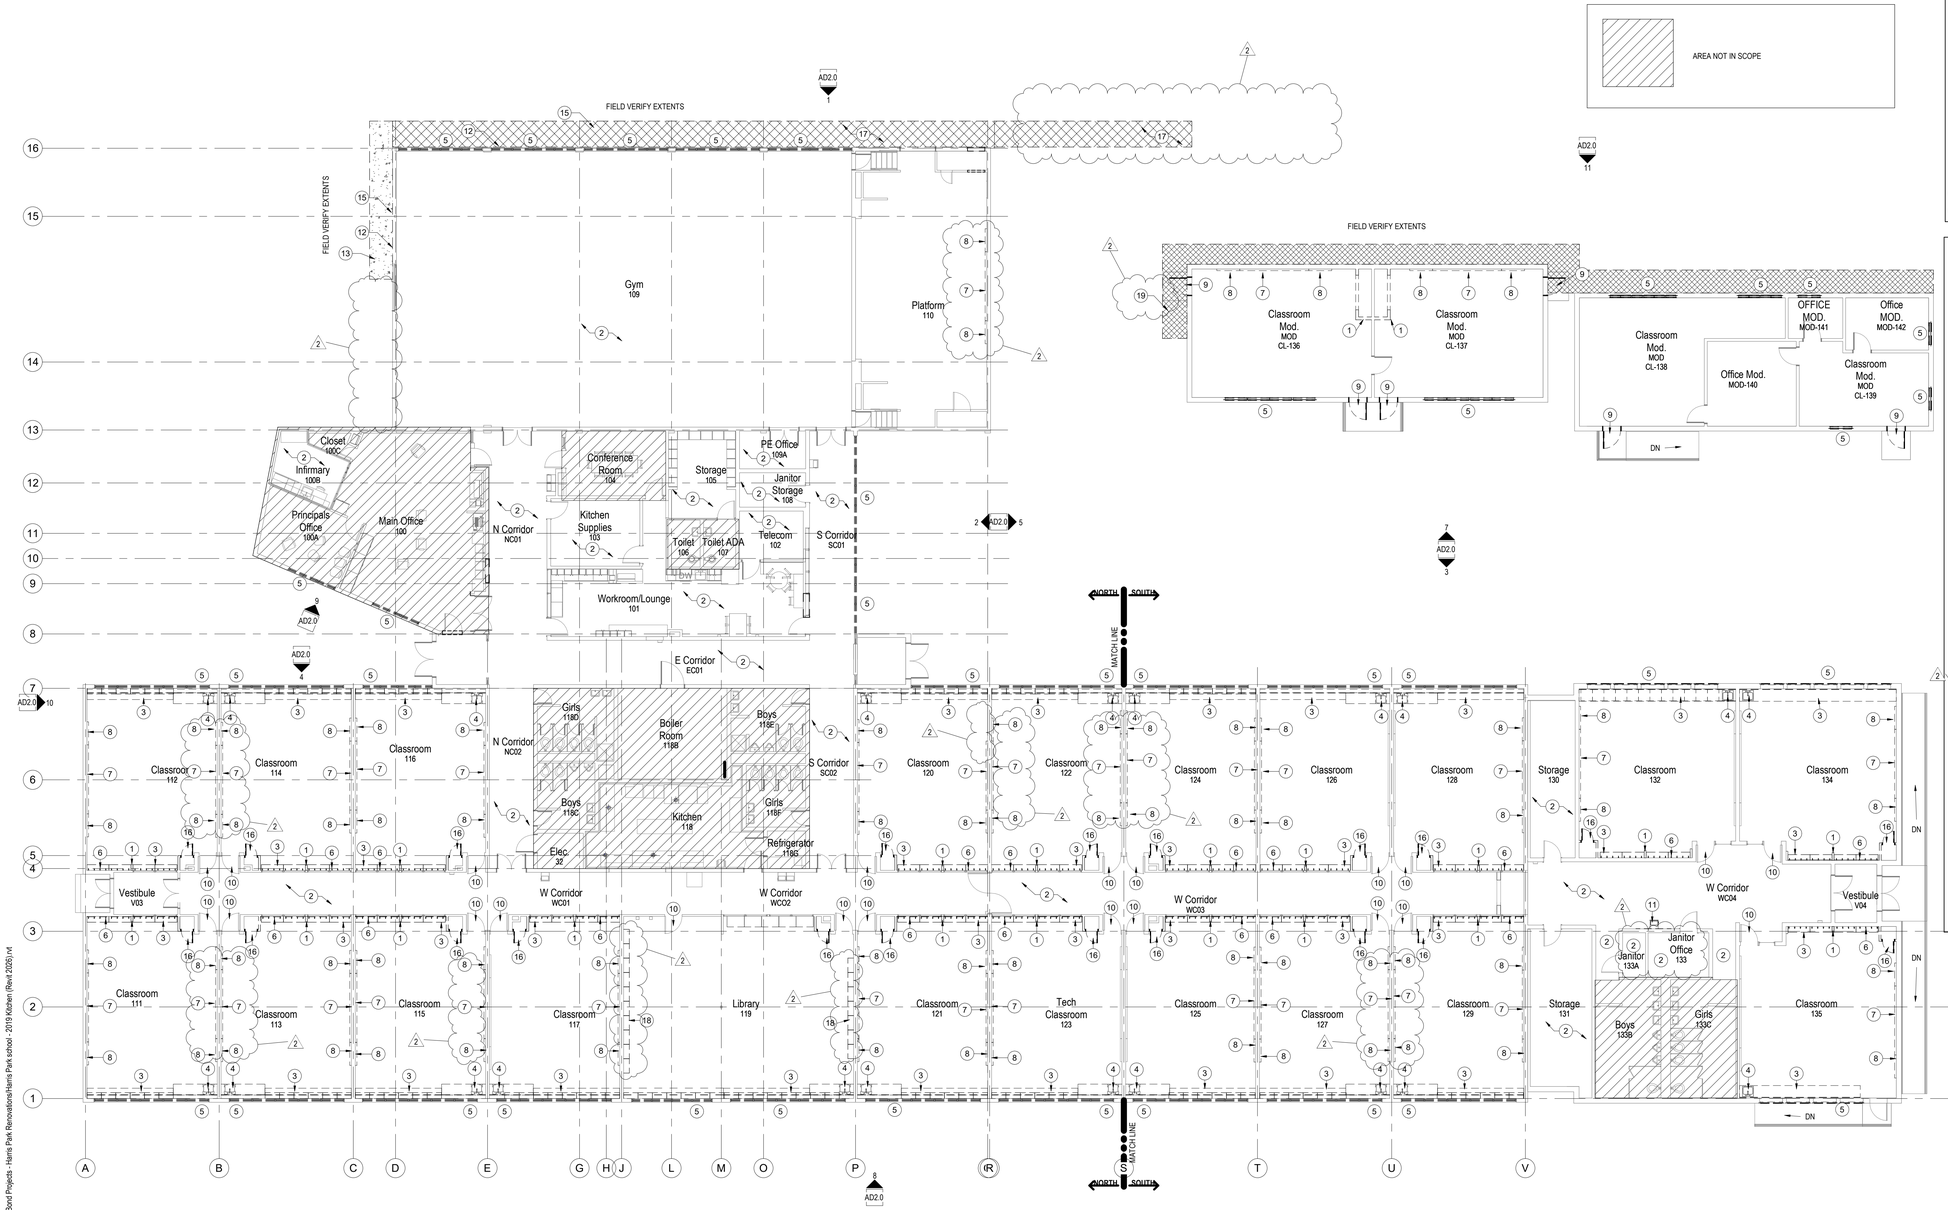

First Floor Demolition Plan North

SCALE: 3/32" = 1'-0"

WORKING NORTH

TRUE NORTH

GENERAL DEMOLITION NOTES

1. THE GENERAL CONTRACTOR SHALL VERIFY ALL EXISTING DIMENSIONS AND CONDITIONS SHOWN ON THE PLANS PRIOR TO COMMENCEMENT OF THE WORK. IT SHALL BE THE CONTRACTORS RESPONSIBILITY TO COORDINATE INSTALLATION OF NEW WORK WITHIN THESE EXISTING CONDITIONS. ANY DEVIATIONS IN EXISTING CONDITIONS OR DIMENSIONS INDICATED SHALL BE COORDINATED WITH THE ARCHITECT/ENGINEER AND OWNER IN ORDER TO MODIFY THE PLANS ACCORDINGLY.
2. THE EXISTING BUILDING SHALL BE PROTECTED FROM WEATHER AT ALL TIMES. OPENINGS AND PENETRATIONS SHALL BE PROTECTED WITH DURABLE, INSULATED TEMPORARY CONSTRUCTION. COORDINATE SECURITY REQUIREMENTS WITH THE OWNER.
3. ALL WORK IS TO BE PERFORMED IN SUCH A MANNER AS TO MINIMIZE THE IMPACT ON AREAS ADJACENT TO THE AREAS OF CONSTRUCTION.
4. REMOVE EXISTING FLOORS, WALLS AND CEILINGS AS REQUIRED FOR NEW CONSTRUCTION. PATCH, REPAIR AND PREPARE ADJACENT SURFACES AS REQUIRED FOR NEW CONSTRUCTION AND FINISHES.
5. REFER TO MECHANICAL, ELECTRICAL, AND PLUMBING DRAWINGS FOR ADDITIONAL INFORMATION PERTAINING TO DEMOLITION.
6. REMOVE EXISTING FURNITURE, FIXTURES AND EQUIPMENT (INCLUDING ARTWORK AND MARKER/TACK BOARDS) AS REQUIRED FOR NEW CONSTRUCTION. COORDINATE SALVAGE AND STORAGE OF EQUIPMENT WITH OWNER AS REQUIRED. PROTECT AND STORE ALL ITEMS DESIGNATED TO BE SALVAGED FOR REINSTALLATION.
7. REMOVE EXISTING SIGNAGE AS REQUIRED FOR DEMOLITION AND STORE DURING CONSTRUCTION. REINSTALL WHEN APPLICABLE. PATCH AND PREPARE ADJACENT SURFACES AS REQUIRED FOR NEW FINISHES. ALL NEW SIGNAGE TO BE PROVIDED BY OWNER.
8. ALL OPENINGS AND VOIDS LEFT BY THE REMOVAL OF EXISTING CONSTRUCTION, EQUIPMENT, PIPING, DUCTS, ETC. SHALL BE PROPERLY PATCHED AND CLOSED OFF TO MAINTAIN PROPER FIRE RATING IN WALLS, IF APPLICABLE. PATCH AND PREPARE ANY AREAS TO RECEIVE NEW FINISHES AS REQUIRED.
9. THE ARCHITECT ASSUMES NO RESPONSIBILITY FOR THE DETECTION OR REMOVAL OF ANY HAZARDOUS MATERIALS, INCLUDING, BUT NOT LIMITED TO, ASBESTOS IN ANY FORM. PARTIES RESPONSIBLE FOR DEMOLITION SHALL NOTIFY THE OWNER IMMEDIATELY OF ANY SUSPECTED MATERIALS.
10. OWNER HAS RIGHT TO CLAIM ANY MATERIALS AND/OR EQUIPMENT THAT IS SCHEDULED TO BE DEMOLISHED OR REMOVED FROM THE SITE.
11. ALL EXISTING BUILDING ELEMENTS TO REMAIN SHALL BE PROTECTED DURING CONSTRUCTION.
12. REMOVE EXISTING FLOOR FINISHES WHERE INDICATED. DEMOLITION INCLUDES REMOVAL OF EXISTING ADHESIVES, GROUTING BED, ETC. PATCH AND PREPARE FLOOR AND WALL SURFACES AS REQUIRED FOR NEW CONSTRUCTION AND FINISHES. WHERE FLOOR FINISH IS REMOVED, BASE WILL BE REMOVED. SEE FINISH PLAN FOR ADDITIONAL INFORMATION.
13. PREPARE EXISTING SUBSTRATES TO REMAIN AS REQUIRED TO RECEIVE NEW FINISHES.
14. EXISTING FLOOR SLABS ARE CONCRETE. ANY DEMOLITION OF EXISTING FLOOR SLABS WILL REQUIRE GPR X-RAY PRIOR TO DEMOLITION.
15. REFER TO THE NATIONAL ROOFING CONTRACTOR'S ASSOCIATION ROOFING MANUAL FOR ADDITIONAL INFORMATION PERTAINING TO THE REMOVAL, REPLACEMENT, AND DETAIL RECOMMENDATIONS FOR ALL WORK PERTAINING TO THE EXISTING ROOF SYSTEM.
16. THE EXISTING INTERCOM DISPLAYS WILL NEED TO BE REMOVED AND SALVAGED FOR REPLACEMENT FOR THE NEW TEACHING WALLS. THEY ARE ROOM SPECIFIC SO THEY NEED TO GO BACK IN THE ROOM THEY ARE TAKEN DOWN FROM.

DEMOLITION KEY NOTES

1. REMOVE EXISTING WALL ASSEMBLY IN ITS ENTIRETY OR AS REQUIRED FOR NEW CONSTRUCTION. PATCH AND PREPARE ADJACENT SURFACES AS REQUIRED FOR NEW CONSTRUCTION.
2. REMOVE EXISTING FLOOR FINISH MATERIAL IN ITS ENTIRETY. PATCH AND PREPARE ADJACENT SURFACES AS REQUIRED FOR NEW CONSTRUCTION.
3. REMOVE EXISTING CASEWORK IN ITS ENTIRETY, AND ANY ASSOCIATED COUNTERTOP. PATCH AND PREPARE ADJACENT SURFACES AS REQUIRED FOR NEW CONSTRUCTION.
4. REMOVE EXISTING SINK IN ITS ENTIRETY. PATCH AND PREPARE ADJACENT SURFACES AS REQUIRED FOR NEW CONSTRUCTION. SEE PLUMBING DRAWINGS FOR ADDITIONAL INFORMATION.
5. REMOVE EXISTING WINDOW ASSEMBLY IN ITS ENTIRETY. PATCH AND PREPARE ADJACENT SURFACES AS REQUIRED FOR NEW CONSTRUCTION
6. REMOVE EXISTING COAT HOOKS
7. REMOVE EXISTING MARKER BOARD. PATCH AND PREPARE ADJACENT SURFACES AS REQUIRED FOR NEW CONSTRUCTION.
8. REMOVE EXISTING TACK BOARD. PATCH AND PREPARE ADJACENT SURFACES AS REQUIRED FOR NEW CONSTRUCTION.
9. REMOVE EXISTING DOOR AND FRAME ASSEMBLY IN ITS ENTIRETY. PATCH AND PREPARE ADJACENT SURFACES AS REQUIRED FOR NEW CONSTRUCTION.
10. REMOVE EXISTING DOOR STOP FROM DOOR
11. REMOVE EXISTING DRINKING FOUNTAIN AND ASSOCIATED TILE SURROUND
12. REMOVE EXISTING DAMPPROOFING SYSTEM IN ITS ENTIRETY, TO THE EXTENT POSSIBLE WITHOUT DAMAGING EXISTING BRICK. PREPARE REMAINING SUBSTRATE AS REQUIRED FOR INSTALLATION OF NEW DAMPPROOFING SYSTEM. PATCH AND PREPARE ADJACENT SURFACES AS REQUIRED FOR NEW CONSTRUCTION.
13. REMOVE EXISTING CONCRETE SIDEWALK AS REQUIRED FOR INSTALLATION OF NEW DAMPPROOFING SYSTEM. PROTECT ADJACENT EXISTING CONCRETE, PAVEMENT, AND BUILDING ELEMENTS TO REMAIN. PATCH AND PREPARE ADJACENT SURFACES AS REQUIRED FOR NEW CONSTRUCTION. RE:CIVIL
14. NOT USED
15. REMOVE EXISTING BACKFILL AS REQUIRED FOR INSTALLATION OF NEW DAMPPROOFING SYSTEM AND STORE FOR REINSTALLATION. PATCH AND PREPARE ADJACENT SURFACES AS REQUIRED FOR NEW CONSTRUCTION. RE: CIVIL

    REMOVE EXISTING TEACHERS CABINET. PATCH AND PREPARE ADJACENT SURFACES AS REQUIRED FOR NEW CONSTRUCTION
16. REMOVE ASPHALT AS REQUIRED FOR INSTALLATION OF NEW FOUNDATION DRAIN LINE AND NEW DRYWELL. PATCH AND PREPARE ADJACENT SURFACES AS REQUIRED FOR NEW CONSTRUCTION. SEE CIVIL FOR ADDITIONAL INFORMATION.
17. REMOVE EXISTING BOOK CASES. PATCH AND PREPARE ADJACENT SURFACES FOR NEW CONSTRUCTION AS REQUIRED.
18. REMOVE ASPHALT AS REQUIRED FOR NEW CONSTRUCTION. PATCH AND PREPARE ADJACENT SURFACES AS REQUIRED FOR NEW CONSTRUCTION. SEE CIVIL FOR ADDITIONAL INFORMATION.
19.

DAO ARCHITECTURE
7230 Meade St.
Westminster, CO 80030
Phone: 720.273.0431
Email: dan@daoarch.com
Web: www.daoarch.com

Rev. #	Description	Rev. Date
2	Addendum 01	11/12/2026

Revision Schedule

Westminster Public Schools

2026 Bond Projects
Harris Park Elementary

4300 W. 75th Avenue
Westminster, CO 80030


DAO No.: 2025-033

September 25, 2026


Demolition First Floor Plan

AD1.0

Autodesk Docs://WPS 2026 Bond Projects - Harris Park Renovations/Harris Park school - 2019 Kitchen (Revit 2026).rvt
11/12/2026 10:31:30 AM

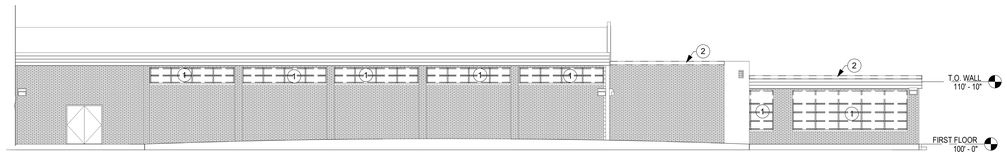

1 East. Elevation - Demolition
SCALE: 3/32" = 1'-0"

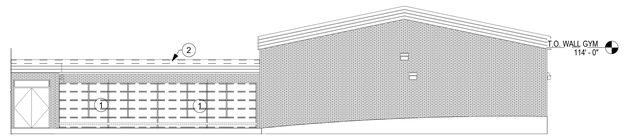


2 South Elevation 2 - Demolition
SCALE: 3/32" = 1'-0"

GENERAL ELEV. DEMO. NOTES


1. THE GENERAL CONTRACTOR SHALL VERIFY ALL EXISTING DIMENSIONS AND CONDITIONS SHOWN ON THE PLANS PRIOR TO COMMENCEMENT OF THE WORK. IT SHALL BE THE CONTRACTORS RESPONSIBILITY TO COORDINATE INSTALLATION OF NEW WORK WITHIN THESE EXISTING CONDITIONS. ANY DEVIATION IN EXISTING CONDITIONS OR DIMENSIONS INDICATED SHALL BE COORDINATED WITH THE ARCHITECT/ENGINEER AND OWNER IN ORDER TO MODIFY THE PLANS ACCORDINGLY.
2. THE EXISTING BUILDING SHALL BE PROTECTED FROM WEATHER AT ALL TIMES. OPENINGS AND PENETRATIONS SHALL BE PROTECTED WITH DURABLE, INSULATED TEMPORARY CONSTRUCTION. COORDINATE SECURITY REQUIREMENTS WITH THE OWNER.
3. ALL WORK IS TO BE PERFORMED IN SUCH A MANNER AS TO MINIMIZE THE IMPACT ON AREAS ADJACENT TO THE AREAS OF CONSTRUCTION.
4. REMOVE EXISTING FLOORS, WALLS AND CEILINGS AS REQUIRED FOR NEW CONSTRUCTION. PATCH, REPAIR AND PREPARE ADJACENT SURFACES AS REQUIRED FOR NEW CONSTRUCTION AND FINISHES.
5. REFER TO ELECTRICAL AND PLUMBING DRAWINGS FOR ADDITIONAL INFORMATION PERTAINING TO DEMOLITION.
6. THE OWNER HAS THE RIGHT TO CLAIM ANY MATERIALS AND/OR EQUIPMENT THAT ARE SCHEDULED TO BE DEMOLISHED OR REMOVED FROM THE SITE.
7. PREPARE EXISTING SUBSTRATES TO REMAIN AS REQUIRED TO RECEIVE NEW FINISHES.
8. REPAIR DAMAGED AND WEATHERED BRICK AND MORTAR AS REQUIRED TO RECEIVE NEW FINISHES.

DEMO ELEVATION KEY NOTES


1. REMOVE EXISTING WINDOW SYSTEM IN ITS ENTIRETY. PATCH AND PREPARE ADJACENT SURFACES AS REQUIRED FOR NEW CONSTRUCTION.
2. REMOVE EXISTING PARAPET CAP IN ITS ENTIRETY. PATCH AND PREPARE ADJACENT SURFACES AS REQUIRED FOR NEW CONSTRUCTION.
3. REMOVE EXISTING DOOR AND FRAME IN ITS ENTIRETY. PATCH AND PREPARE ADJACENT SURFACES AS REQUIRED FOR NEW CONSTRUCTION.
4. REMOVE EXISTING LOUVER. PATCH AND PREPARE ADJACENT SURFACES AS REQUIRED FOR NEW CONSTRUCTION

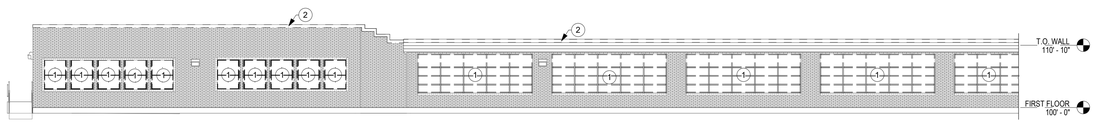


3 East Elevation 2- Demolition
SCALE: 3/32" = 1'-0"

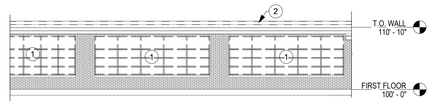


4 North West Elevation - Demolition
SCALE: 3/32" = 1'-0"

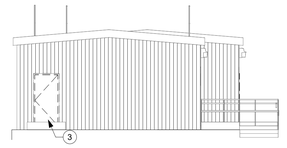


5 North Elevation - Modulars Demolition
SCALE: 1/8" = 1'-0"

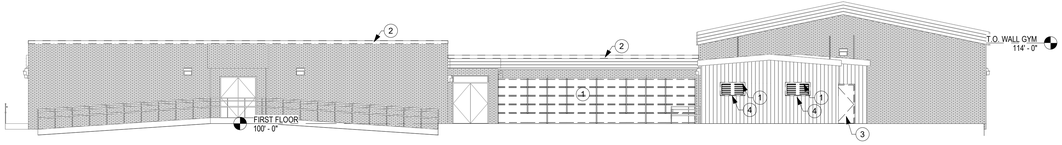

6 South Elevation - Demolition
SCALE: 3/32" = 1'-0"

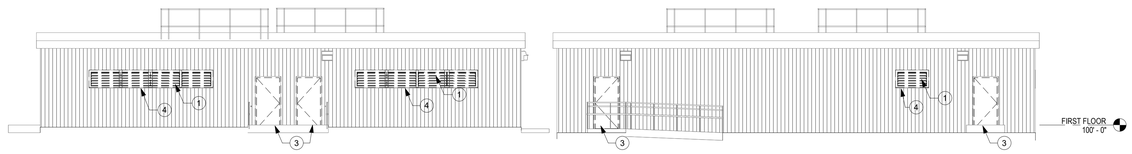


7 West Elevation - Modulars Demolition
SCALE: 1/8" = 1'-0"

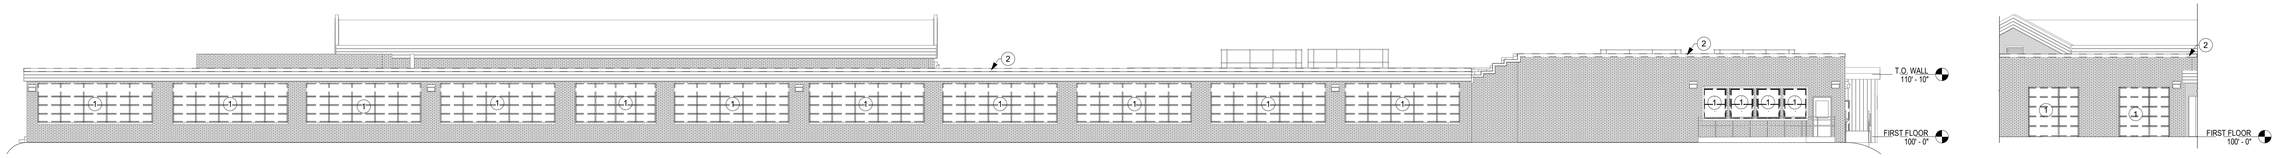


8 West Elevation - Demolition
SCALE: 3/32" = 1'-0"

9 North East Elevation - Demolition
SCALE: 3/32" = 1'-0"

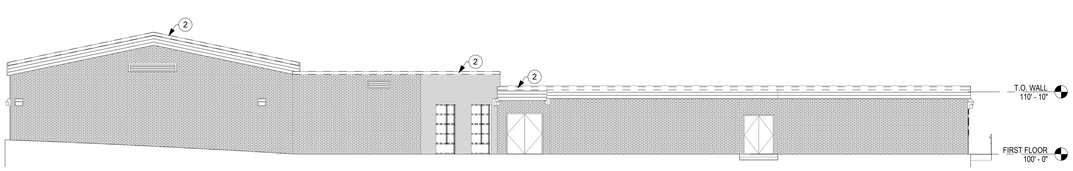

10 North Elevation - Demolition
SCALE: 3/32" = 1'-0"

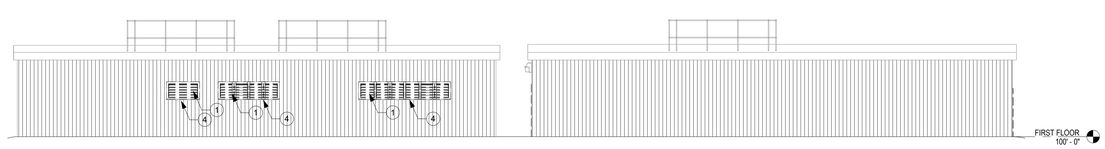

11 East Elevation - Modulars Demolition
SCALE: 1/8" = 1'-0"

DAO ARCHITECTURE
7230 Meade St.
Westminster, CO 80030
Phone: 720.273.0431
Email: dan@daoarch.com
Web: www.daoarch.com

Rev. #	Description	Rev. Date
2	Addendum 01	11/12/2026

Revision Schedule

Westminster Public Schools

2026 Bond Projects
Harris Park Elementary

4300 W. 75th Avenue
Westminster, CO 80030

DAO No.: 2025-033

September 25, 2026

Demo Exterior Elevations

AD2.0

Autodesk Docs://WPS 2026 Bond Projects - Harris Park Renovations/Harris Park school - 2019 Kitchen (Revit 2025).rvt
11/12/2026 10:31:36 AM

GENERAL PLAN NOTES

1. DRAWINGS & SPECIFICATIONS ARE COMPLIMENTARY COMPONENTS OF THE CONTRACT DOCUMENTS. REVIEW ALL DRAWINGS AND SPECIFICATIONS FOR THE COMPLETE SCOPE OF WORK. NOTIFY ARCHITECT IMMEDIATELY FOR CLARIFICATION IF INCONSISTENCIES, CONTRADICTIONS OR OMISSIONS ARE DISCOVERED.
2. DO NOT SCALE DRAWINGS, IF DIMENSIONAL INFORMATION IS REQUIRED & NOT FOUND, NOTIFY ARCHITECT IMMEDIATELY FOR CLARIFICATION.
3. ALL DIMENSIONS ARE TO COLUMN CENTERLINES OR FACE OF FINISHED WALLS OR SURFACES UNLESS NOTED OTHERWISE.
4. REFER TO DEMOLITION DRAWINGS FOR WORK REQUIRED IN ADVANCE OF CONSTRUCTION AND COORDINATE ACCORDINGLY.
5. REFER TO ELECTRICAL, AND PLUMBING DRAWINGS FOR ADDITIONAL INFORMATION.
6. INTERIOR SIGNAGE TO BE PROVIDED BY OWNER.
7. FURNITURE AND EQUIPMENT PROVIDED BY OWNER.
8. WHERE ALL WALL MOUNTED INFRASTRUCTURE, SUCH AS WIRE-MOLD AND CONDUIT, ARE REMOVED, WALLS ARE TO BE REPAINTED TO MATCH EXISTING.

WALL TYPES


1 5/8" TYPE 'X' GPDW ON 6" 20 GAUGE METAL STUDS AT 16" O.C.

NOTE: PROVIDE BACKING IN WALLS FOR ALL NEW EQUIPMENT AND SHELVING AS REQUIRED.

AREA NOT IN SCOPE

KEY NOTES

1. MAPLE-VENEERED PLYWOOD BASE CABINETS WITH SOLID SURFACE COUNTERTOP
2. SINGLE BASIN ADA SINK WITH BUBBLER. RE: PLUMBING
3. MAPLE-VENEERED PLYWOOD SHELF WITH COAT HOOKS BELOW
4. NOT USED
5. POLISHED CONCRETE FLOOR
6. NEW STOREFRONT SYSTEM
7. FULL-HEIGHT WOOD-VENEERED CABINET WITH DOOR LOCK
8. NOT USED
9. NEW HIGH-LOW DRINKING FOUNTAINS WITH BOTTLE FILLER. INSTALL STAINLESS STEEL PLATE ON WALL BEHIND.
10. NEW MAGHOLD ON EXISTING DOOR
11. REPLACE BACKFILL REMOVED FOR INSTALLATION OF NEW DAMPPROOFING. COMPACT IN 8" LIFTS TO MINIMUM COMPACTION OF 95% OR MORE AS DETERMINED BY APPLICABLE ASTM TESTING.
12. NEW CONCRETE SIDEWALK. PROVIDE 6" CONCRETE PAVING OVER 6" CDOT CLASS 6 AGGREGATE BASE COURSE. SEE 8/A8.0.
13. DOUBLE BASIN ADA SINK. RE: PLUMBING
14. NEW LEARNING WALL. CFCI COORDINATE REQUIREMENTS WITH OWNER
15. MODIFY BACK OF CABINET AS REQUIRED FOR EXISTING ROOF DRAIN
16. INSTALL COVER PLATE ON EACH SIDE OF EXISTING MICRO PANEL AND PAINT TO MATCH WALL
17. STAIN BASKETBALL COURT STRIPING. COLOR TO BE SELECTED BY ARCHITECT
18. BELOW GRADE DRYWELL AND DRAIN LINE CONNECTED FROM THE NEW FOUNDATION DRAIN. RE: CIVIL
19. NEW BOOKCASES. CFCI. OWNER TO SELECT MODEL FROM MANUFACTURER METEOR EDUCATION
20. NEW CATCH CURB AND GUTTER. RE: CIVIL

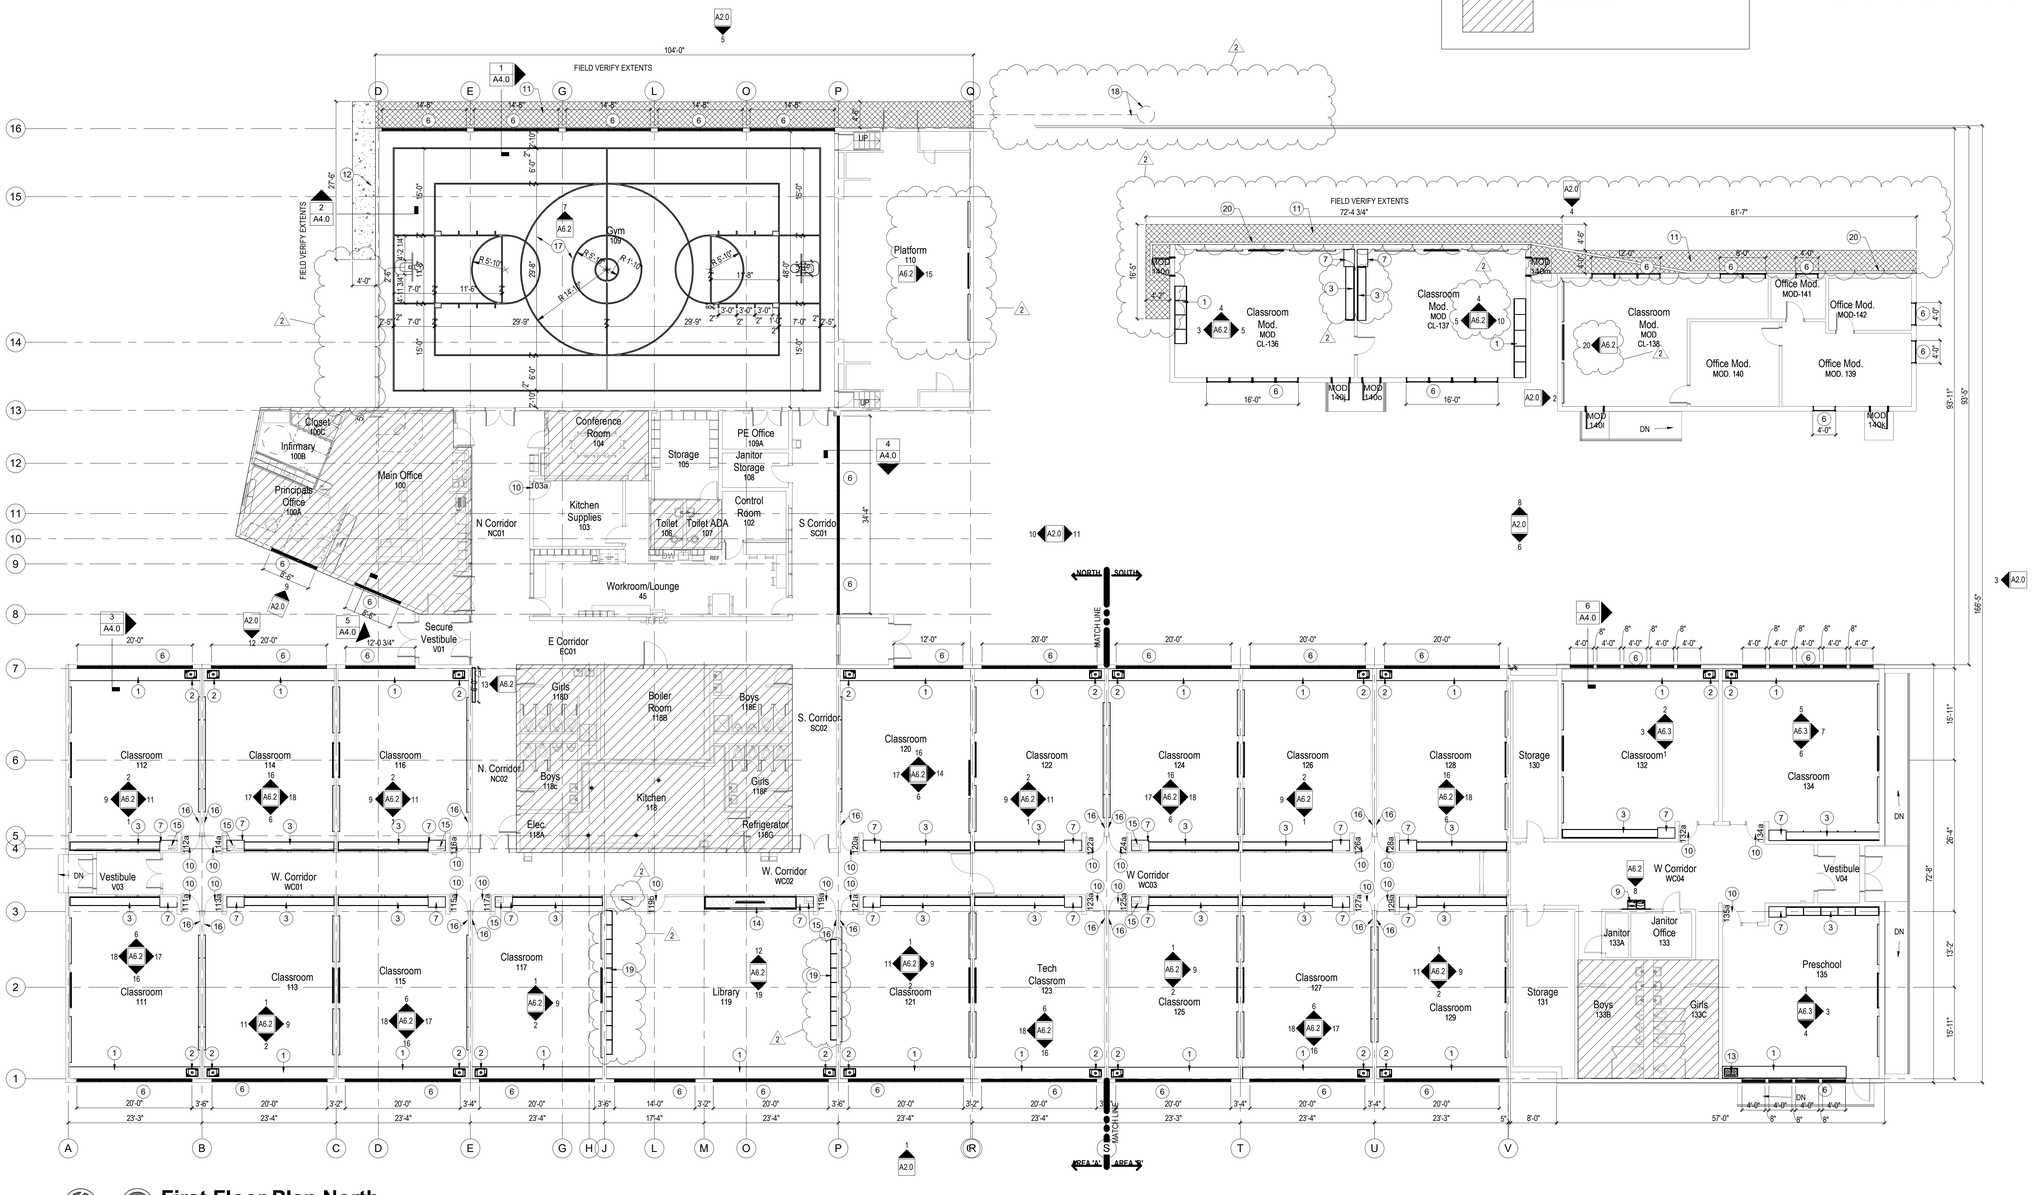

First Floor Plan North

SCALE: 3/32" = 1'-0"

WORKING NORTH

TRUE NORTH

DAO ARCHITECTURE

7230 Meade St.
Westminster, CO 80030

Phone: 720.273.0431
Email: dan@daoarch.com
Web: www.daoarch.com

Rev. #	Description	Rev. Date
2	Addendum 01	11/12/2026

Revision Schedule

Westminster Public Schools

2026 Bond Projects
Harris Park Elementary

4300 W. 75th Avenue
Westminster, CO 80030

DAO No.: 2025-033

September 25, 2026

First Floor Plan


A1.0

Autodesk Docs://WPS 2026 Bond Projects - Harris Park Renovations/Harris Park school - 2019 Kitchen (Revit 2025).rvt
11/12/2026 10:31:37 AM

EQUIPMENT SCHEDULE				
ITEM DESCRIPTION (MANUFACTURER & MODEL)	QUANTITY	FURNISHED/INSTALLED BY	COMMENTS	Type Mark
4' X 7' MARKER BOARD, CLARIDGE SERIES 4	6	CONTRACTOR/CONTRACTOR		001
85" MONITOR AND MOUNTING BRACKET	23	CONTRACTOR/CONTRACTOR		002
4' X 12' MARKER BOARD, CLARIDGE SERIES 4	12	CONTRACTOR/CONTRACTOR		003
4' X 4' TACK BOARD, FORBO BULLETIN BOARD	24	CONTRACTOR/CONTRACTOR		004
METEOR EDUCATION LEARNING WALL	1	CONTRACTOR/CONTRACTOR		006
70" MONITOR AND MOUNTING BRACKET	1	CONTRACTOR/CONTRACTOR		007
4' X 8' MARKER BOARD, CLARIDGE SERIES 4	38	CONTRACTOR/CONTRACTOR		008
4' X 6' MARKER BOARD, CLARIDGE SERIES 4	1	CONTRACTOR/CONTRACTOR		009

Note:
Monitor Basis of Design: Samsung BE85FX-H BEFX-H Series - 85" LED-backlit LCD TV - 4K - for digital signage - Mfg # BE85FX-H – Or Equivalent
Mounting Bracket Basis of Design: Eaton Tripp Lite Series Display TV Wall Monitor Mount Swivel/Tilt 60" to 100" TVs / EA / Flat-Screens bracket - for LCD - Mfg #DWM60100XX – Or Equivalent
Learning Wall Basis of Design: Repositionable iXchange Learning Wall by Meteor Education. Coordinate Design with Owner.

2

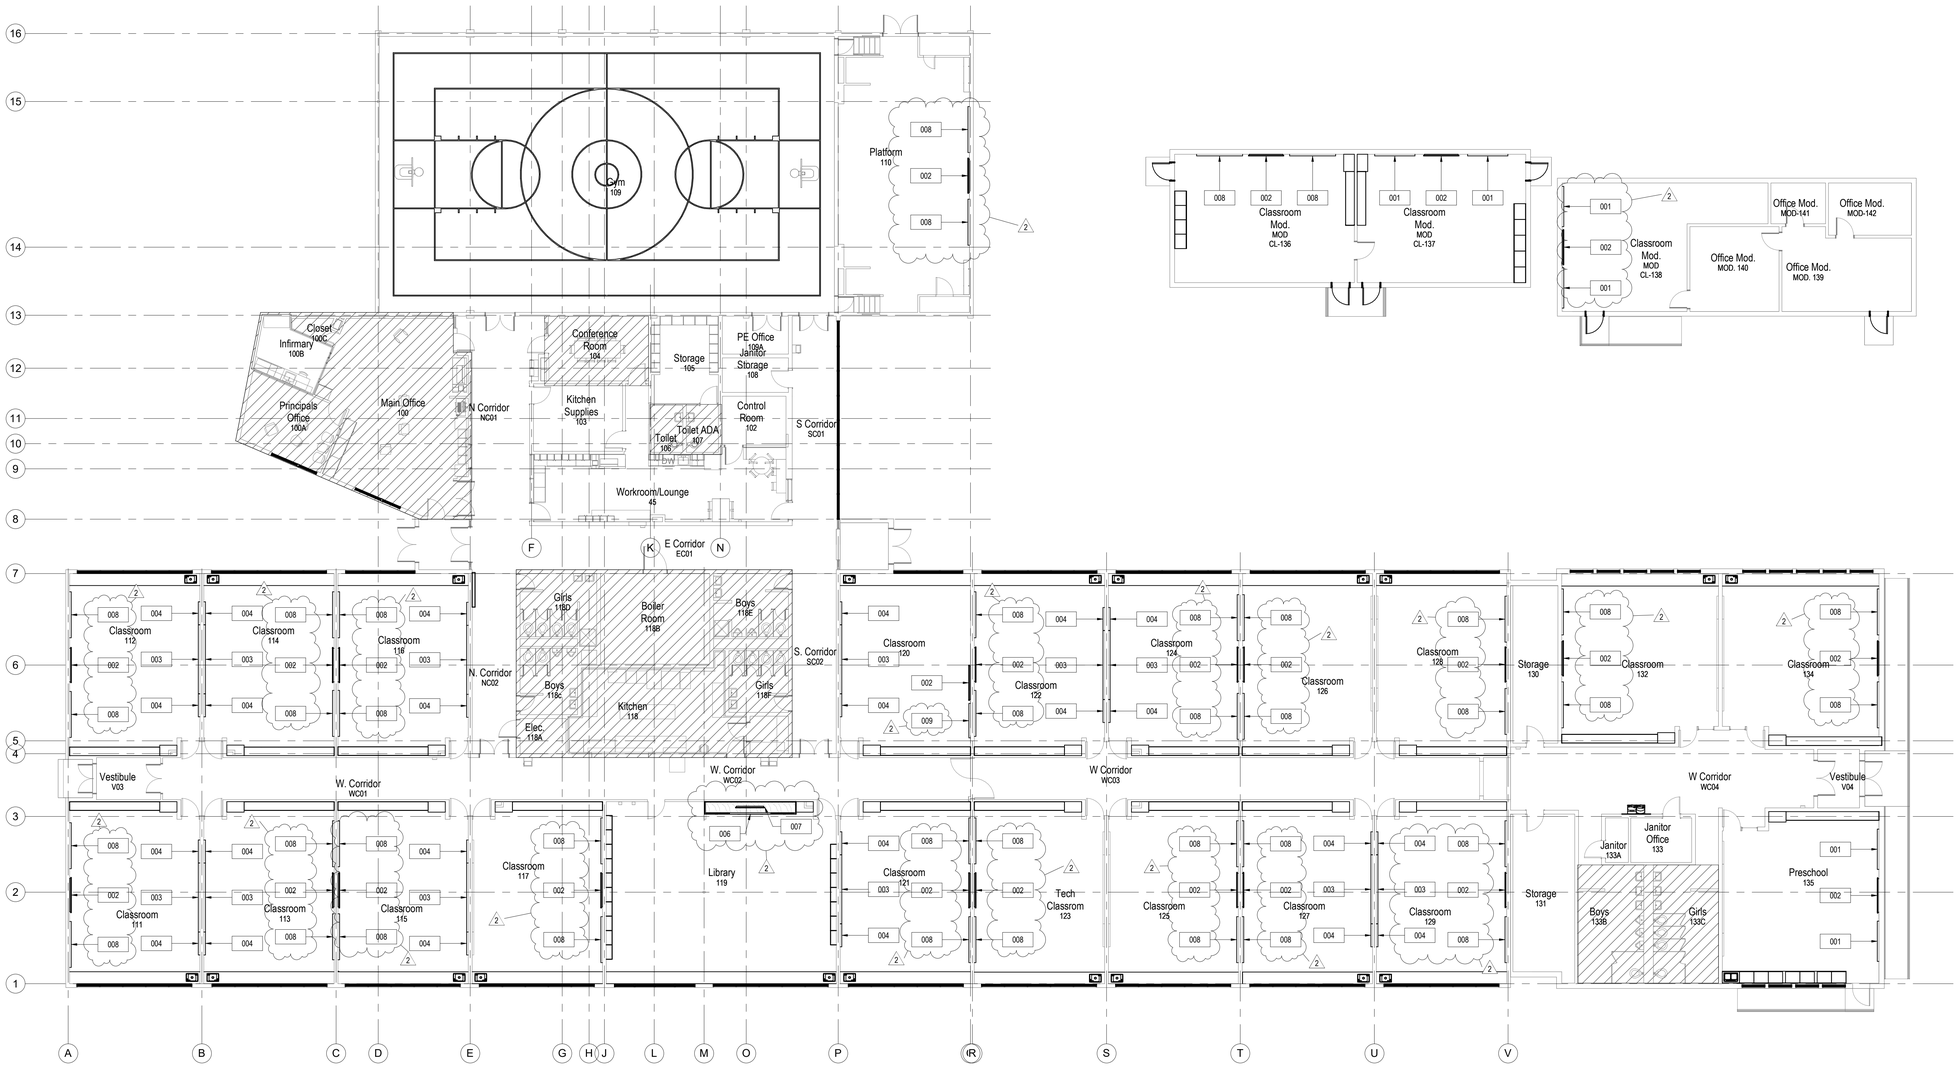

1 **FIRST FLOOR**
SCALE: 3/32" = 1'-0"

DAO ARCHITECTURE
7230 Meade St.
Westminster, CO 80030
Phone: 720.273.0431
Email: dan@daoarch.com
Web: www.daoarch.com

Rev. #	Description	Rev. Date
2	Addendum 01	11/12/2026
Revision Schedule		

Westminster Public Schools

2026 Bond Projects
Harris Park Elementary

4300 W. 75th Avenue
Westminster, CO 80030


DAO No.: 2025-033

September 25, 2026

Equipment Plan

A1.2

Autodesk Docs://WPS 2026 Bond Projects - Harris Park Renovations/Harris Park school - 2019 Kitchen (Revit 2026).rvt
11/12/2026 10:31:49 AM

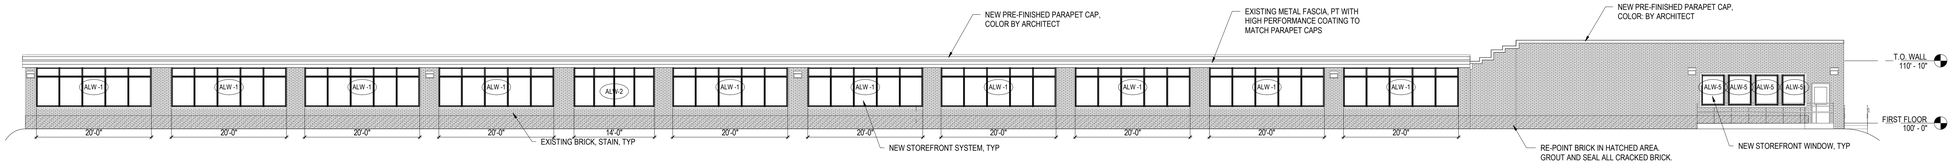

1 West Elevation
SCALE: 3/32" = 1'-0"

BASIS OF DESIGN LEGEND

EXISTING BRICK

ALL BRICK TO BE STAINED, BASIS OF DESIGN: BRICK IMAGING, COLOR SELECTED BY ARCHITECT


NEW PRE-FINISHED PARAPET CAPS AND FLASHING, BASIS OF DESIGN: SHERWIN-WILLIAMS GENESIS. COLOR: COPPER PENNY

BRICK REPAIR SCOPE GENERAL NOTES:


1. CONTRACTOR TO FIELD VERIFY EXTENTS OF ALL CRACKED AND/OR DAMAGED BRICK. CONFIRM WITH OWNER FOR DIRECTION ON REPAIR AND REPLACEMENT
2. CONTRACTOR TO PROVIDE NOT-TO-EXCEED PRICING FOR BRICK RE-POINTING AND REPAIR IN AREAS INDICATED ON THE DRAWINGS, ESTIMATED AT 2,300 SF. CONTRACTOR TO PROVIDE UNIT PRICING FOR ADDITIONAL AREAS OF REPAIR, AND/OR TO CREDIT AREAS INDICATED THAT ARE FOUND TO NOT NEED REPAIR.

GENERAL NOTE


1. ALL EXTERIOR DOORS AND FRAMES TO BE PAINTED. COLOR TO BE SELECTED ONCE STAIN COLOR IS SELECTED.

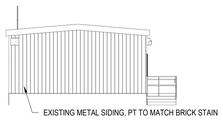


2 North Elevation Modular 2
SCALE: 3/32" = 1'-0"

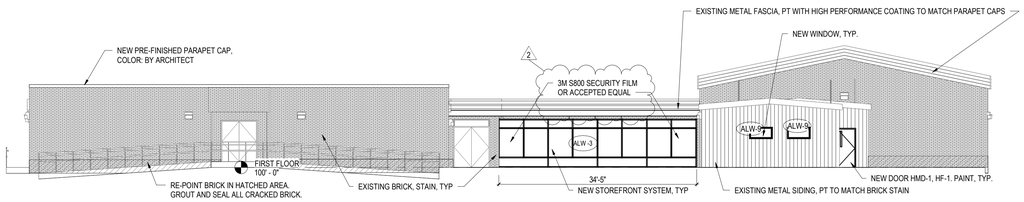


3 South Elevation
SCALE: 3/32" = 1'-0"

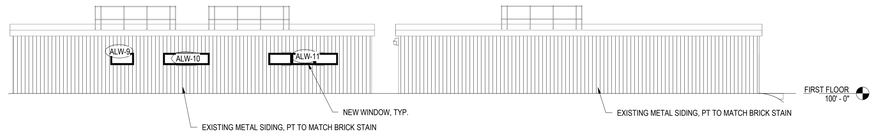


4 East Elevation - Modulars
SCALE: 3/32" = 1'-0"

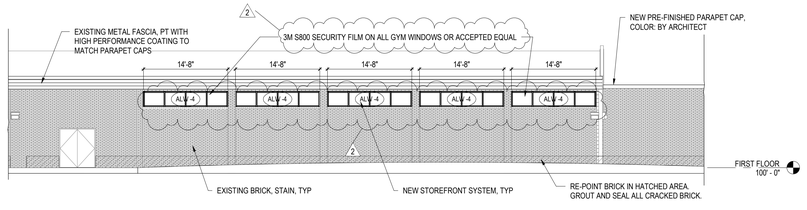


5 East Elevation
SCALE: 3/32" = 1'-0"

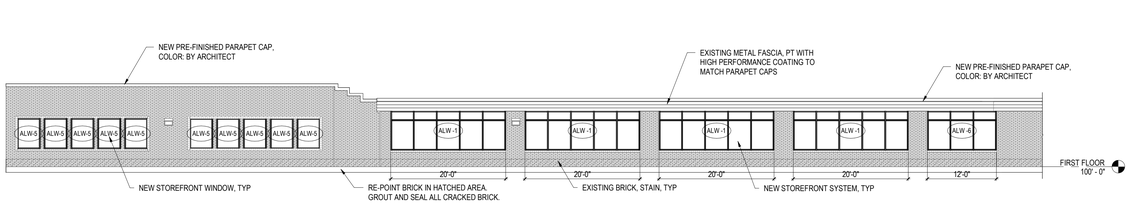


6 East Elevation 2
SCALE: 3/32" = 1'-0"

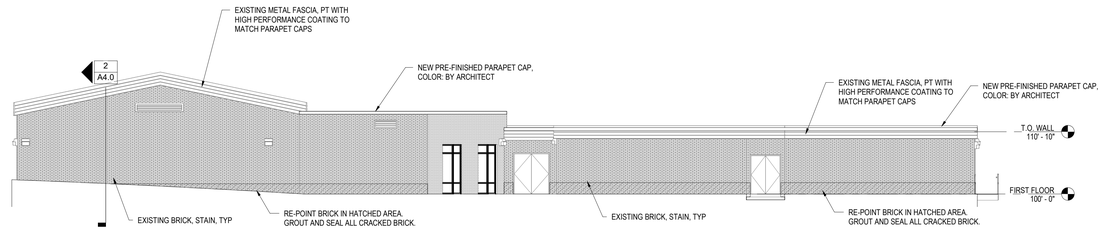


7 North Elevation
SCALE: 3/32" = 1'-0"

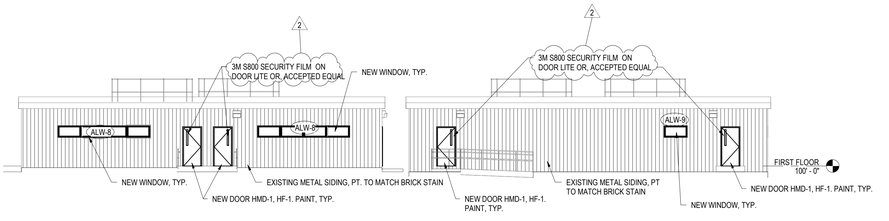


8 West Elevation - Modulars
SCALE: 3/32" = 1'-0"

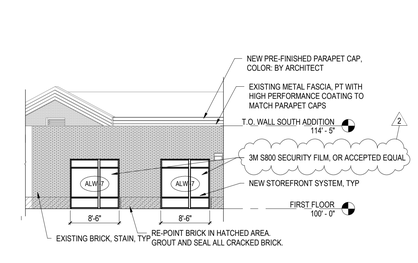


9 Northeast Elevation
SCALE: 3/32" = 1'-0"

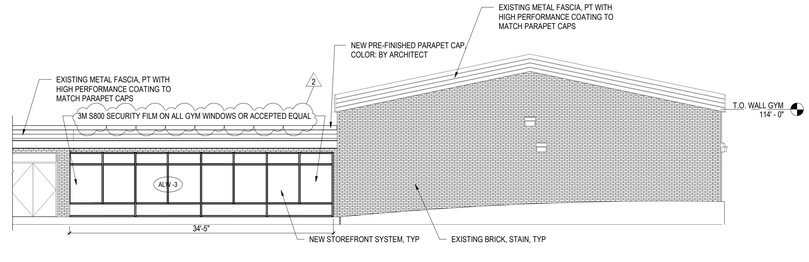

10 South Elevation 2
SCALE: 1/8" = 1'-0"

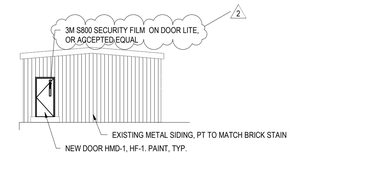

11 North Elevation - Modular 1
SCALE: 3/32" = 1'-0"

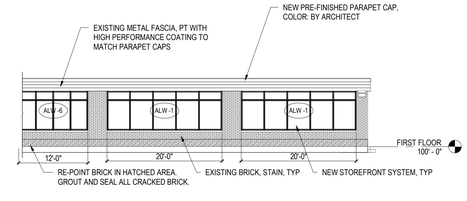

12 Northwest Elevation
SCALE: 3/32" = 1'-0"

DAO ARCHITECTURE

7230 Meade St.
Westminster, CO 80030

Phone: 720.273.0431
Email: dan@daoarch.com
Web: www.daoarch.com

Rev. #	Description	Rev. Date
2	Addendum 01	11/12/2026

Revision Schedule

Westminster Public Schools

2026 Bond Projects
Harris Park Elementary

4300 W. 75th Avenue
Westminster, CO 80030


DAO No.: 2025-033

September 25, 2026


Exterior Elevations

A2.0


Autodesk Docs://WPS 2026 Bond Projects - Harris Park Renovations/Harris Park school - 2019 Kitchen (Revit 2025).rvt
11/12/2026 10:31:43 AM

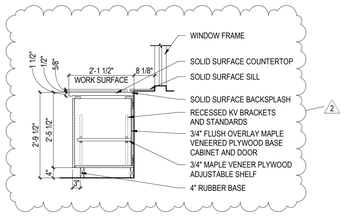


1 Base Cabinet
SCALE: 1/2" = 1'-0"

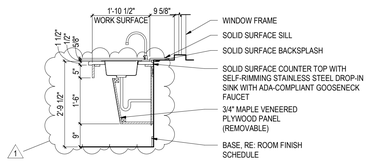

2 Sink Base Cabinet - ADA
SCALE: 1/2" = 1'-0"

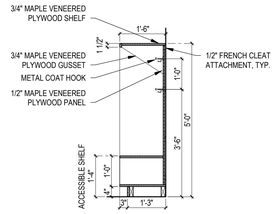

3 Classroom Shelf
SCALE: 1/2" = 1'-0"

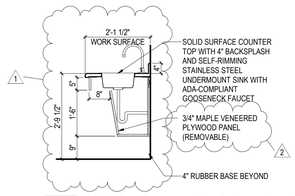


4 Sink Base Cabinet - ADA
SCALE: 1/2" = 1'-0"

CASEWORK GENERAL NOTES


1. ALL CASEWORK SHALL BE CONSTRUCTED TO MEET THE FOLLOWING AWI CONSTRUCTION GRADES:
   WOOD VENEERED PLYWOOD CASEWORK
   -GRADE = CUSTOM
   -SOLID SURFACE COUNTERTOPS AND BACKSPLASH, SEE COLOR ON FINISH PLAN.
2. TYPICAL MATERIALS:
   -FIVE KNUCKLE HINGES
   -WIRE PULLS
   -METAL SHELF CLIPS ON RECESSED K.V. STANDARDS

3. SEE SHEET A9.0 FOR FINISHES.


4. RECESS ALL KV STANDARDS PER DETAIL 8 ON SHEET A6.0 (2)

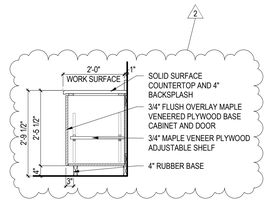


5 Base Cabinet Only
SCALE: 1/2" = 1'-0"

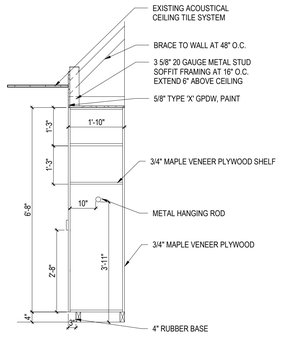


6 Teachers Cabinet
SCALE: 1/2" = 1'-0"

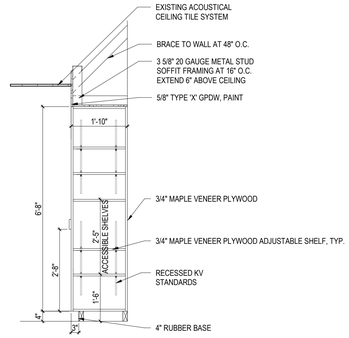


7 Teacher's Cabinet
SCALE: 1/2" = 1'-0"

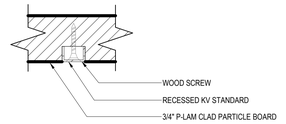


8 Typ. Recessed KV Standard
SCALE: 12" = 1'-0"

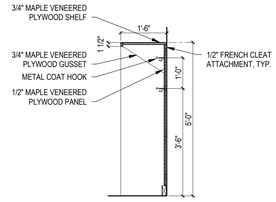

9 Coat Hook Shelf
SCALE: 1/2" = 1'-0"

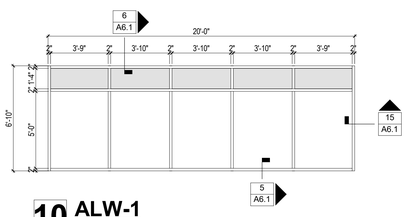


10 ALW-1
SCALE: 1/4" = 1'-0"

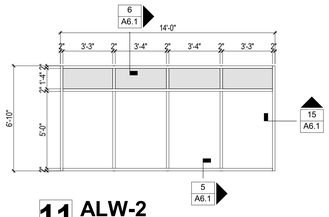


11 ALW-2
SCALE: 1/4" = 1'-0"




12 ALW-11
SCALE: 1/4" = 1'-0"

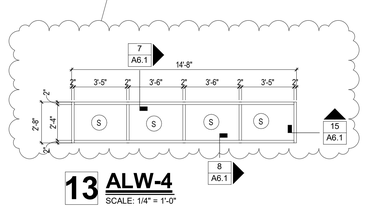


13 ALW-4
SCALE: 1/4" = 1'-0"

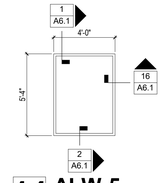


14 ALW-5
SCALE: 1/4" = 1'-0"

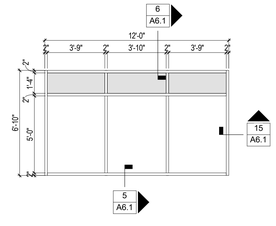


15 ALW-6
SCALE: 1/4" = 1'-0"

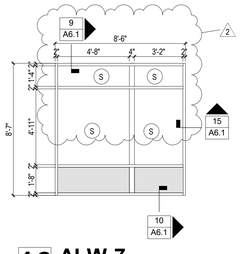


16 ALW-7
SCALE: 1/4" = 1'-0"

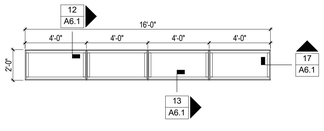


17 ALW-8
SCALE: 1/4" = 1'-0"

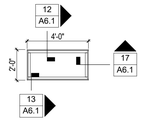

18 ALW-9
SCALE: 1/4" = 1'-0"

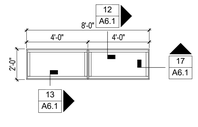


19 ALW-10
SCALE: 1/4" = 1'-0"

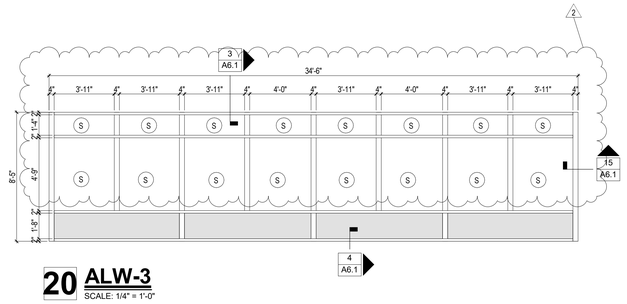

20 ALW-3
SCALE: 1/4" = 1'-0"

DOOR AND FRAME SCHEDULE

DOOR NO.	ROOM NO.	ROOM NAME	DOOR DIMENSIONS W	DOOR DIMENSIONS H	TYPE	FRAME TYPE	DOOR/FRAME FIRE RATING	HARDWARE	REMARKS
103a	103	Kitchen Supplies	3' - 0"	6' - 8"	(E)WD	(E)HMF		EX-01	New Maghold, Existing Hardware to Remian
111a	111	Classroom	3' - 0"	6' - 8"	(E)WD	(E)HMF		EX-01	New Maghold, Existing Hardware to Remian
112a	112	Classroom	3' - 0"	6' - 8"	(E)WD	(E)HMF		EX-01	New Maghold, Existing Hardware to Remian
113a	113	Classroom	3' - 0"	6' - 8"	(E)WD	(E)HMF		EX-01	New Maghold, Existing Hardware to Remian
114a	114	Classroom	3' - 0"	6' - 8"	(E)WD	(E)HMF		EX-01	New Maghold, Existing Hardware to Remian
115a	115	Classroom	3' - 0"	6' - 8"	(E)WD	(E)HMF		EX-01	New Maghold, Existing Hardware to Remian
116a	116	Classroom	3' - 0"	6' - 8"	(E)WD	(E)HMF		EX-01	New Maghold, Existing Hardware to Remian
117a	117	Classroom	3' - 0"	6' - 8"	(E)WD	(E)HMF		EX-01	New Maghold, Existing Hardware to Remian
119a	119	Library	3' - 0"	6' - 8"	(E)WD	(E)HMF		EX-01	New Maghold, Existing Hardware to Remian
119b	119	Library	3' - 0"	6' - 8"	(E)WD	(E)HMF		EX-01	New Maghold, Existing Hardware to Remian
120a	120	Classroom	3' - 0"	6' - 8"	(E)WD	(E)HMF		EX-01	New Maghold, Existing Hardware to Remian
121a	121	Classroom	3' - 0"	6' - 8"	(E)WD	(E)HMF		EX-01	New Maghold, Existing Hardware to Remian
122a	122	Classroom	3' - 0"	6' - 8"	(E)WD	(E)HMF		EX-01	New Maghold, Existing Hardware to Remian
123a	123	Tech Classrom	3' - 0"	6' - 8"	(E)WD	(E)HMF		EX-01	New Maghold, Existing Hardware to Remian
124a	124	Classroom	3' - 0"	6' - 8"	(E)WD	(E)HMF		EX-01	New Maghold, Existing Hardware to Remian
125a	125	Classroom	3' - 0"	6' - 8"	(E)WD	(E)HMF		EX-01	New Maghold, Existing Hardware to Remian
126a	126	Classroom	3' - 0"	6' - 8"	(E)WD	(E)HMF		EX-01	New Maghold, Existing Hardware to Remian
127a	127	Classroom	3' - 0"	6' - 8"	(E)WD	(E)HMF		EX-01	New Maghold, Existing Hardware to Remian
128a	128	Classroom	3' - 0"	6' - 8"	(E)WD	(E)HMF		EX-01	New Maghold, Existing Hardware to Remian
129a	129	Classroom	3' - 0"	6' - 8"	(E)WD	(E)HMF		EX-01	New Maghold, Existing Hardware to Remian
132a	132	Classroom	3' - 0"	6' - 8"	(E)WD	(E)HMF		EX-01	New Maghold, Existing Hardware to Remian
134a	134	Classroom	3' - 0"	6' - 8"	(E)WD	(E)HMF		EX-01	New Maghold, Existing Hardware to Remian
135a	135	Preschool	3' - 0"	6' - 8"	(E)WD	(E)HMF		EX-01	New Maghold, Existing Hardware to Remian
MOD 140j	MOD CL-136	Classroom Mod.	3' - 0"	6' - 8"	HMD-1	HMF-1		01	Storeroom, Small Lite
MOD 140k	MOD. 139	Office Mod.	3' - 0"	6' - 8"	HMD-1	HMF-1		01	Storeroom, Small Lite
MOD 140l	MOD CL-138	Classroom Mod.	3' - 0"	6' - 8"	HMD-1	HMF-1		01	Storeroom, Small Lite
MOD 140m	MOD CL-137	Classroom Mod.	3' - 0"	6' - 8"	HMD-1	HMF-1		01	Storeroom, Small Lite
MOD 140n	MOD CL-136	Classroom Mod.	3' - 0"	6' - 8"	HMD-1	HMF-1		01	Storeroom, Small Lite
MOD 140o	MOD CL-137	Classroom Mod.	3' - 0"	6' - 8"	HMD-1	HMF-1		01	Storeroom, Small Lite

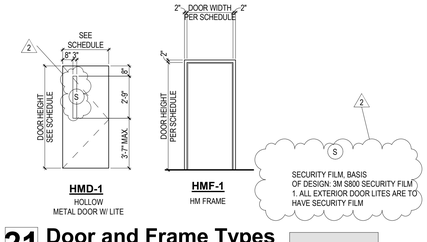

21 Door and Frame Types
SCALE: 1/4" = 1'-0"

BASIS-OF-DESIGN:
1. EXTERIOR HOLLOW METAL DOORS: CURRIES 707 Q-MAX OR EQUAL
2. ALL LITES WITHIN DOORS ARE TO HAVE ANEMOSTAT LOPRO LITE KITS
2. EXTERIOR STOREFRONT: KAWNEER 451 UT WITH INSULATED GLAZING. COLOR:CLEAR ANNODIZE

INSULATED PANELS, BASIS OF DESIGN: MAPES, MAPES-R INFILL PANEL

DAO ARCHITECTURE
7230 Meade St.
Westminster, CO 80030
Phone: 720.273.0431
Email: dan@daoarch.com
Web: www.daoarch.com

Rev. #	Description	Rev. Date
2	Addendum 01	11/12/2026
1	DFPC REVIEW 1	11/5/2026

Revision Schedule

Westminster Public Schools

2026 Bond Projects
Harris Park Elementary

4300 W. 75th Avenue
Westminster, CO 80030


DAO No.: 2025-033

September 25, 2026


Casework Sections and Exterior Frame Types and Door Schedule

A6.0


Autodesk Docs://WPS 2026 Bond Projects - Harris Park Renovations/Harris Park school - 2019 Kitchen (Revit 2026).rvt
11/12/2026 10:31:43 AM

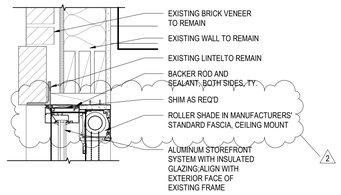


1 Detail 1
SCALE: 1 1/2" = 1'-0"

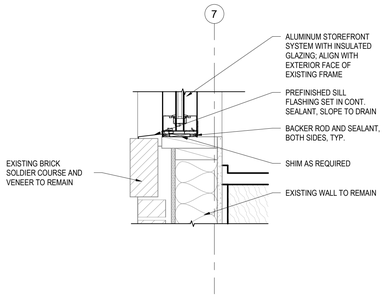


2 Detail 2
SCALE: 1 1/2" = 1'-0"

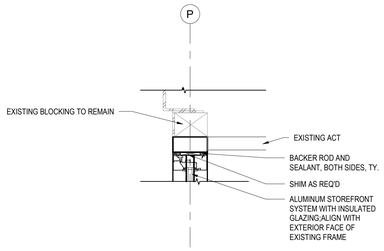


3 Detail 3
SCALE: 1 1/2" = 1'-0"

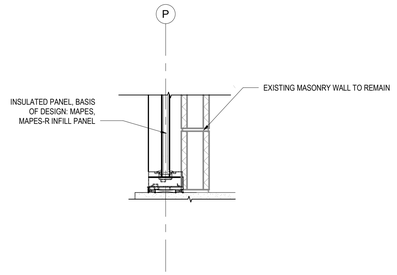


4 Detail 4
SCALE: 1 1/2" = 1'-0"

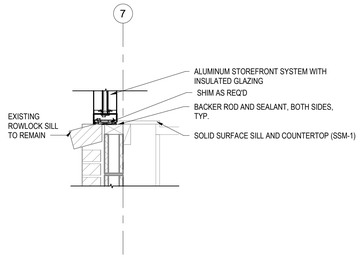


5 Detail 5
SCALE: 1" = 1'-0"

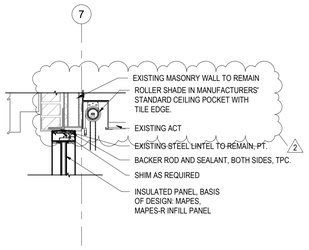


6 Detail 6
SCALE: 1" = 1'-0"

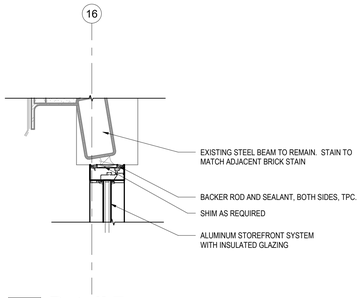


7 Detail 7
SCALE: 1 1/2" = 1'-0"

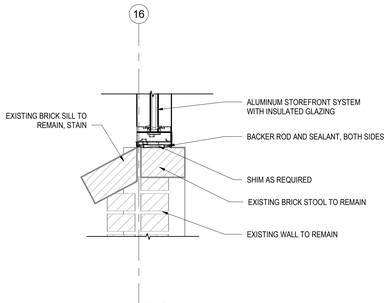


8 Detail 8
SCALE: 1 1/2" = 1'-0"

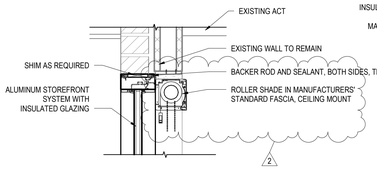


9 Detail 9
SCALE: 1 1/2" = 1'-0"

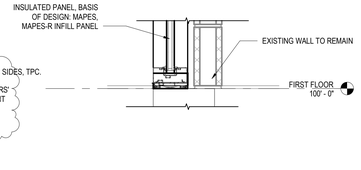


10 Detail 10
SCALE: 1 1/2" = 1'-0"

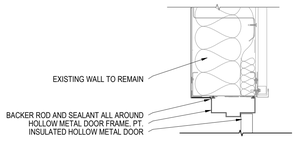


11 HM DOOR HEAD
SCALE: 1 1/2" = 1'-0"

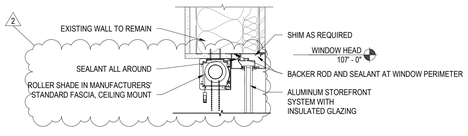


12 DETAIL 11
SCALE: 1 1/2" = 1'-0"

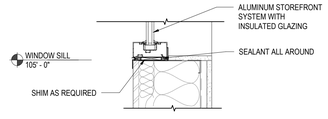


13 Detail 12
SCALE: 1 1/2" = 1'-0"

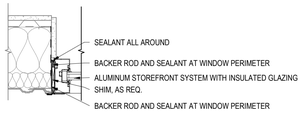


14 Detail 13
SCALE: 1 1/2" = 1'-0"

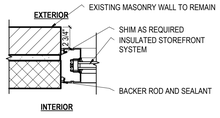

15 Detail 14
SCALE: 1 1/2" = 1'-0"

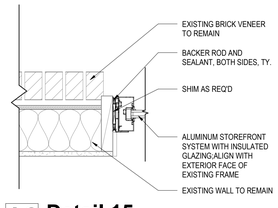

16 Detail 15
SCALE: 1 1/2" = 1'-0"

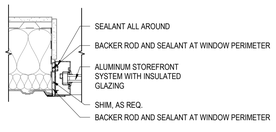

17 Detail 16
SCALE: 1 1/2" = 1'-0"

DAO ARCHITECTURE
7230 Meade St.
Westminster, CO 80030
Phone: 720.273.0431
Email: dan@daoarch.com
Web: www.daoarch.com

Rev. #	Description	Rev. Date
2	Addendum 01	11/12/2026

Revision Schedule

Westminster Public Schools

2026 Bond Projects
Harris Park Elementary

4300 W. 75th Avenue
Westminster, CO 80030


DAO No.: 2025-033

September 25, 2026

Door and Window Details


A6.1

Autodesk Docs://WPS 2026 Bond Projects - Harris Park Renovations/Harris Park school - 2019 Kitchen (Revit 2025).rvt
11/12/2026 10:31:45 AM

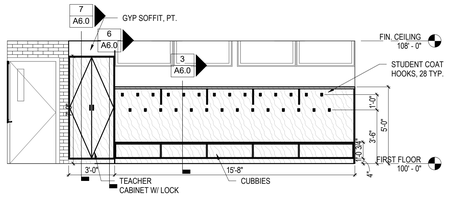


1 Typical Classroom Coat Hook Wall

SCALE: 1/4" = 1'-0"

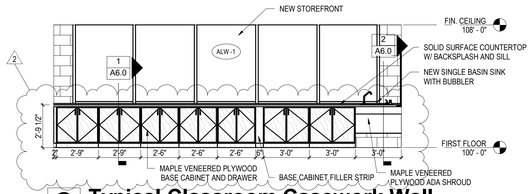


2 Typical Classroom Casework Wall

SCALE: 1/4" = 1'-0"

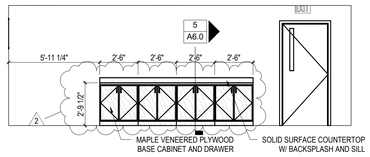


3 North Modular Casework Wall

SCALE: 1/4" = 1'-0"

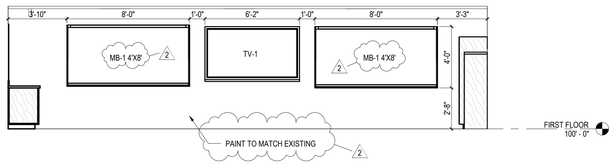


4 Typical North Modular Teaching Wall

SCALE: 1/4" = 1'-0"

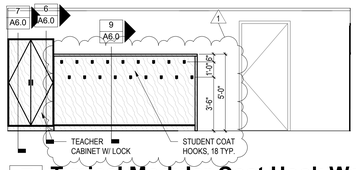


5 Typical Modular Coat Hook Wall

SCALE: 1/4" = 1'-0"

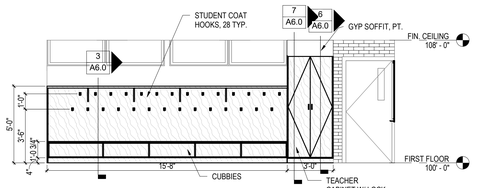


6 Typical Classroom Coat Hook Wall - Opposite Hand

SCALE: 1/4" = 1'-0"

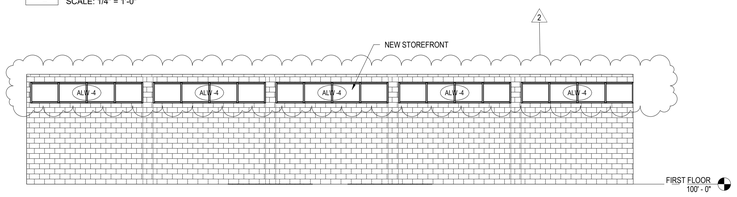


7 North Gym Elevation

SCALE: 1/8" = 1'-0"

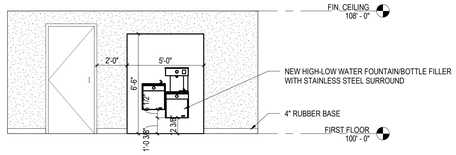


8 Drinking Fountain Elevation

SCALE: 1/4" = 1'-0"

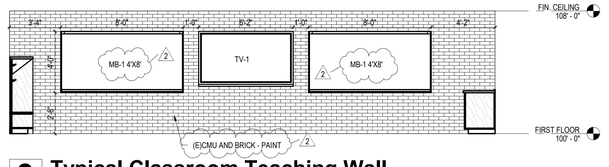


9 Typical Classroom Teaching Wall

SCALE: 1/4" = 1'-0"

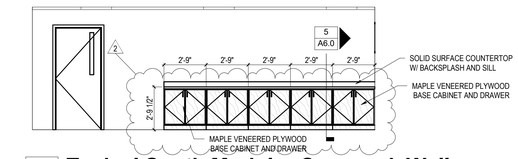


10 Typical South Modular Casework Wall

SCALE: 1/4" = 1'-0"

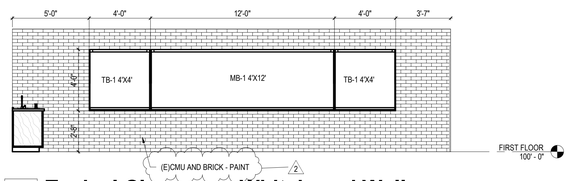


11 Typical Classroom Whiteboard Wall

SCALE: 1/4" = 1'-0"

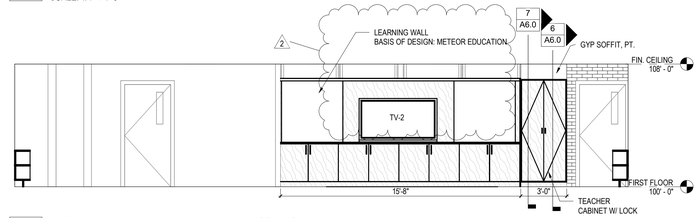


12 Library Teaching Wall Elevation

SCALE: 1/4" = 1'-0"

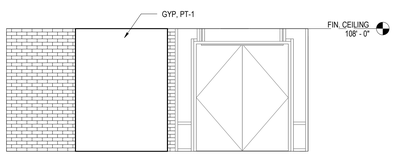


13 Chase Wall Elevation

SCALE: 1/4" = 1'-0"

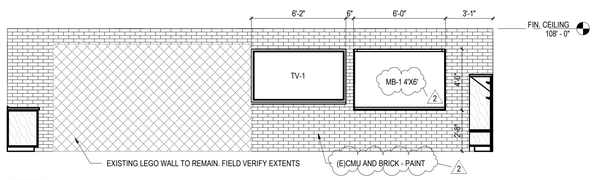


14 Classroom 120 Teaching Wall Elevation

SCALE: 1/4" = 1'-0"

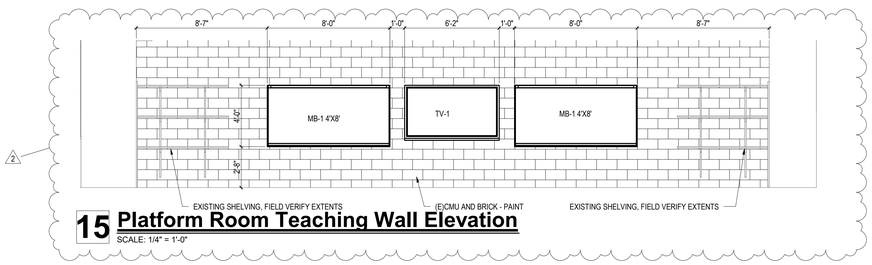


15 Platform Room Teaching Wall Elevation

SCALE: 1/4" = 1'-0"

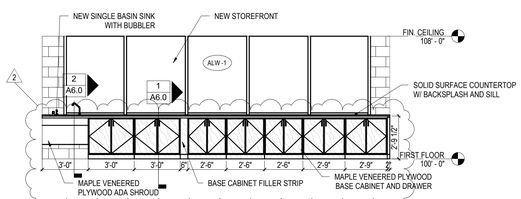


16 Typical Classroom Casework Wall - Opposite Hand

SCALE: 1/4" = 1'-0"

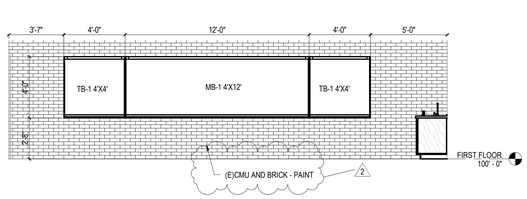


17 Typical Classroom Whiteboard Wall - Opposite Hand

SCALE: 1/4" = 1'-0"

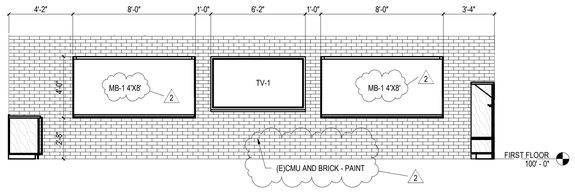


18 Typical Classroom Teaching Wall - Opposite Hand

SCALE: 1/4" = 1'-0"

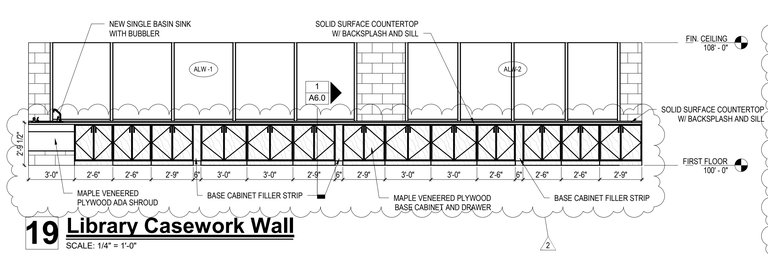

19 Library Casework Wall

SCALE: 1/4" = 1'-0"

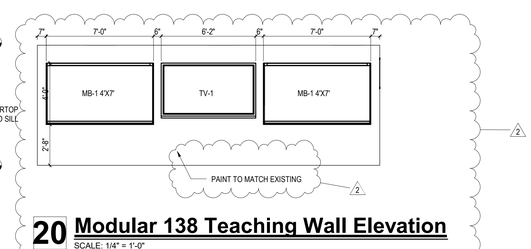

20 Modular 138 Teaching Wall Elevation

SCALE: 1/4" = 1'-0"

DAO ARCHITECTURE

7230 Meade St.
Westminster, CO 80030

Phone: 720.273.0431
Email: dan@daoarch.com
Web: www.daoarch.com

Rev. #	Description	Rev. Date
2	Addendum 01	11/12/2026
1	DFPC REVIEW 1	11/5/2026

Revision Schedule

Westminster Public Schools

2026 Bond Projects
Harris Park Elementary

4300 W. 75th Avenue
Westminster, CO 80030


DAO No.: 2025-033

September 25, 2026

Interior Elevations


A6.2

Autodesk Docs://WPS 2026 Bond Projects - Harris Park Renovations/Harris Park school - 2019 Kitchen (Revit 2025).rvt
11/12/2026 10:31:47 AM

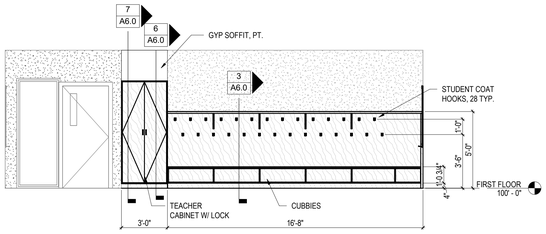


1 Typical 98 Addition Coat Hook Wall

SCALE: 1/4" = 1'-0"

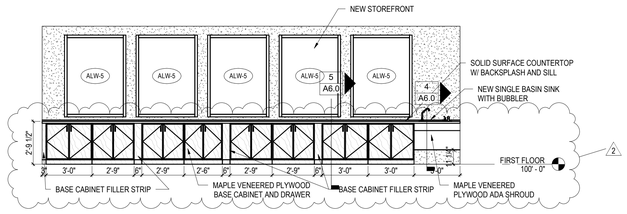


2 98 Classroom Addition Typical Casework Wall

SCALE: 1/4" = 1'-0"

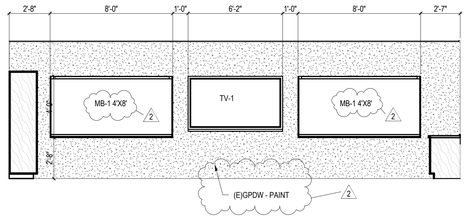


3 98 Classroom Addition Typical Teaching Wall

SCALE: 1/4" = 1'-0"

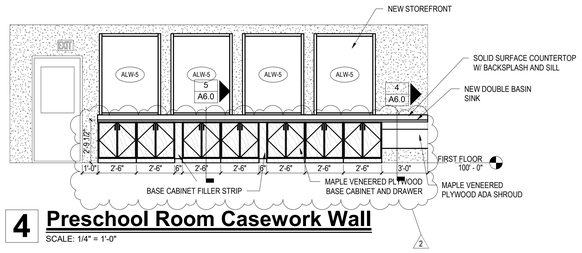


4 Preschool Room Casework Wall

SCALE: 1/4" = 1'-0"

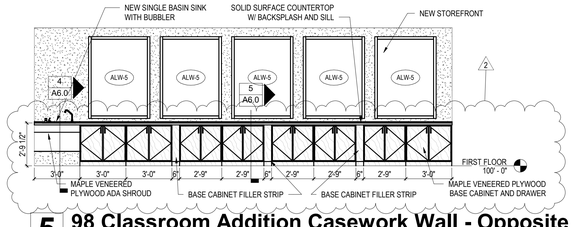


5 98 Classroom Addition Casework Wall - Opposite Hand

SCALE: 1/4" = 1'-0"

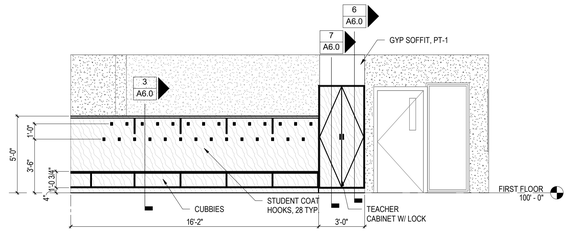

6 98 Classroom Addition Coat Hook Wall - Opposite Hand

SCALE: 1/4" = 1'-0"

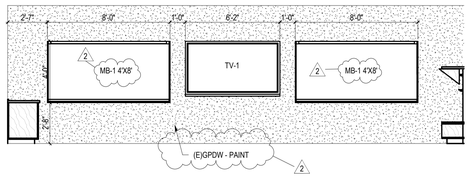

7 98 Classroom Addition Teaching Wall - Opposite Hand

SCALE: 1/4" = 1'-0"

DAO ARCHITECTURE

7230 Meade St.
Westminster, CO 80030

Phone: 720.273.0431
Email: dan@daoarch.com
Web: www.daoarch.com

Rev. #	Description	Rev. Date
2	Addendum 01	11/12/2026

Revision Schedule

Westminster Public Schools

2026 Bond Projects
Harris Park Elementary

4300 W. 75th Avenue
Westminster, CO 80030

DAO No.: 2025-033

September 25, 2026

Interior Elevations

A6.3

Autodesk Docs://WPS 2026 Bond Projects - Harris Park Renovations/Harris Park school - 2019 Kitchen (Revit 2026).rvt
11/12/2026 10:31:49 AM

FINISH LEGEND

CONCRETE
SC-1 SEALED CONCRETE
SPC-1 STAINED AND POLISHED CONCRETE
COLOR: AMERIPOLISH GRAY
SPC-2 STAINED AND POLISHED CONCRETE
COLOR: AMERIPOLISH BLACK

CARPET
CPT-1 TARKETT COROLLARY 39402 VARIFORM

WALK OFF MAT
WOM-1 TANDUS ABRASIVE ACTION II 02578
COLOR: WINTER GRAY 19103

PORCELAIN CERAMIC TILE
PCT-1 CROSSVILLE TILE COLOR BLOX 2.0
COLOR: TREEHOUSE

RUBBER BASE/RESILIENT BASE
RB-1 ROPPE 4" COVE BASE, BLACK

LVT
LVT-1 ARMSTRONG SPETTRO DESIGN 18"X36" NILE NIGHT W/ CUSTOM COLORWAY TO BE SELECTED BY THE ARCHITECT

WOOD VENEERED PLYWOOD
WVP PLAIN SLICED WHITE MAPLE WITH CLEAR FINISH

SOLID SURFACE (COUNTERS AND WINDOW SILLS)
SSM-1 FORMICA CLASSICS RIVER ROCK MOSAIC 656
MATTE FINISH

ROLLER WINDOW COVERING
WIC-1 LUTEK (TYPICAL NEW WINDOW SHADE)
MANUAL ROLLER SHADE
FABRIC: ONYX
FASCIA: ANODIZED
HARDWARE: GRAY
FABRIC WRAPPED END CAPS

PAINT
PT-1 BENJAMIN MOORE ALABASTER OC-129

PT-2 BENJAMIN MOORE 2007-20 SHY CHERRY - CLASSROOM ENTRY ACCENT COLOR 1 RED

PT-3 BENJAMIN MOORE 2020-40 RAINCOAT YELLOW - CLASSROOM ENTRY ACCENT COLOR 2 YELLOW

PT-4 BENJAMIN MOORE 2029-30 ROSEMARY GREEN - CLASSROOM ENTRY ACCENT COLOR 3 GREEN

PT-5 BENJAMIN MOORE 2063-40 SAILOR'S SEA BLUE - CLASSROOM ENTRY ACCENT COLOR 4 BLUE

2

LVT

CERAMIC TILE

WALK OFF MATT


CARPET

POLISHED CONCRETE SPC-1

POLISHED CONCRETE SPC-2


SEALED CONCRETE

CARPET TO CONCRETE
MANUFACTURER:SCHLUTER STYSTEMS
PRODUCT: VINPRO-U
MATERIAL/FINISH: STAINLESS STEEL, 304
VERIFY HEIGHT REQUIRED

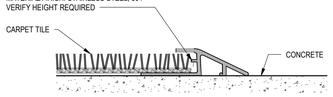


2 CPT TO CONC - VINPRO
SCALE: 12" = 1'-0"

LVT TO CONCRETE
MANUFACTURER:SCHLUTER STYSTEMS
PRODUCT: VINPRO-U
MATERIAL/FINISH: STAINLESS STEEL, 304
VERIFY HEIGHT REQUIRED

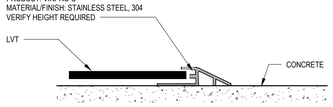

3 LVT TO CONC - VINPRO
SCALE: 12" = 1'-0"

PORCELAIN TILE TO CARPET
MANUFACTURER: SCHLUTER SYSTEMS
PRODUCT: RENO-U, EU100
MATERIAL/FINISH: STAINLESS STEEL, 304
VERIFY HEIGHT REQUIRED

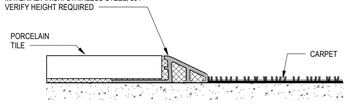

4 PCT TO CPT - RENO-U
SCALE: 12" = 1'-0"


AREA NOT IN SCOPE


ROOM FINISH SCHEDULE


ROOM NUMBER	NAME	FLOOR FINISH	FLOOR BASE	WALLS NORTH FINISH	WALLS EAST FINISH	WALLS SOUTH FINISH	WALLS WEST FINISH
45	Workroom/Lounge	LVT-1	RB-1	(E)	(E)	(E)	(E)
100B	Infirmary	LVT-1	RB-1	(E)	(E)	(E)	(E)
102	Control Room	LVT-1	RB-1	(E)	(E)	(E)	(E)
103	Kitchen Supplies	LVT-1	RB-1	(E)	(E)	(E)	(E)
105	Storage	LVT-1	RB-1	(E)	(E)	(E)	(E)
108	Janitor Storage	SC-1	RB-1	(E)	(E)	(E)	(E)
109	Gym	SPC-1	RB-1	(E)	(E)	(E)	(E)
109A	PE Office	SC-1	RB-1	(E)	(E)	(E)	(E)
110	Platform	(E)	(E)	(E)	(E)	PT-1	(E)
111	Classroom	(E)	(E)	PT-1	(E)	PT-1	(E)
112	Classroom	(E)	(E)	PT-1	(E)	PT-1	(E)
113	Classroom	(E)	(E)	PT-1	(E)	PT-1	(E)
114	Classroom	(E)	(E)	PT-1	(E)	PT-1	(E) 2
115	Classroom	(E)	(E)	PT-1	(E)	PT-1	(E)
116	Classroom	(E)	(E)	PT-1	(E)	PT-1	(E)
117	Classroom	(E)	(E)	PT-1	(E)	PT-1	(E)
119	Library	(E)	(E)	PT-1	(E)	PT-1	(E)
120	Classroom	(E)	(E)	PT-1	(E)	PT-1	(E)
121	Classroom	(E)	(E)	PT-1	(E)	PT-1	(E)
122	Classroom	(E)	(E)	PT-1	(E)	PT-1	(E)
123	Tech Classrom	(E)	(E)	PT-1	(E)	PT-1	(E)
124	Classroom	(E)	(E)	PT-1	(E)	PT-1	(E)
125	Classroom	(E)	(E)	PT-1	(E)	PT-1	(E)
126	Classroom	(E)	(E)	PT-1	(E)	PT-1	(E)
127	Classroom	(E)	(E)	PT-1	(E)	PT-1	(E)
128	Classroom	(E)	(E)	PT-1	(E)	PT-1	(E)
129	Classroom	(E)	(E)	PT-1	(E)	PT-1	(E)
130	Storage	CPT-1	RB-1	(E)	(E)	(E)	(E)
131	Storage	CPT-1	RB-1	(E)	(E)	(E)	(E)
132	Classroom	(E)	(E)	PT-1	(E)	PT-1	(E)
133	Janitor Office	LVT-1	RB-1	(E) 2	(E)	(E) 2	(E)
133A	Janitor	PCT-1	RB-1	(E)	(E) 2	(E) 2	(E)
134	Classroom	(E)	(E)	PT-1	(E)	PT-1	(E)
135	Preschool	(E)	(E)	(E)	(E)	(E)	(E)
EC01	E Corridor	SPC-1	RB-1	(E) 2	(E)	(E)	(E)
MOD CL-136	Classroom Mod.	(E)	(E)	(E)	Paint	(E)	(E)
MOD CL-137	Classroom Mod.	(E)	(E)	(E)	Paint	(E)	(E)
MOD CL-138	Classroom Mod.	(E)	(E)	Paint	(E)	(E)	(E)
MOD-141	Office Mod.	(E)	(E)	(E)	(E)	(E)	(E)
MOD-142	Office Mod.	(E)	(E)	(E) 2	(E) 2	(E)	(E)
MOD. 139	Office Mod.	(E)	(E)	(E)	(E)	(E)	(E)
MOD. 140	Office Mod.	(E)	(E)	(E)	(E)	(E)	(E)
NC01	N Corridor	SPC-1	RB-1	(E)	(E)	(E)	(E)
NC02	N. Corridor	SPC-1	RB-1	(E)	(E)	(E)	(E)
SC01	S Corridor	SPC-1	RB-1	(E)	(E)	(E)	(E)
SC02	S. Corridor	SPC-1	RB-1	(E)	(E)	(E)	(E)
V01	Secure Vestibule	(E)	(E)	(E)	(E)	(E)	(E)
V03	Vestibule	(E)	(E)	(E)	(E)	(E)	(E)
V04	Vestibule	(E)	(E)	(E)	(E)	(E)	(E)
WC01	W. Corridor	SPC-1	RB-1	(E)	(E)	(E)	(E)
WC02	W. Corridor	SPC-1	RB-1	(E)	(E)	(E)	(E)
WC03	W Corridor	SPC-1	RB-1	(E)	(E)	(E)	(E)
WC04	W Corridor	WOM-1	RB-1	(E)	(E)	(E)	(E)

NOTE: PAINTING PT-1 FOR CLASSROOM WALLS WHERE PLUG-MOLD AND WHITEBOARDS REMOVED/REPLACED. REMOVE LACQUER ON BRICK WHERE REQUIRED AND PAINT.
TOUCH-UP PAINTING ON CLASSROOM DOOR ENTRY ALCOVE WALLS WHERE NEW MAG HOLDS REQUIRED. PT2-PT-5

2

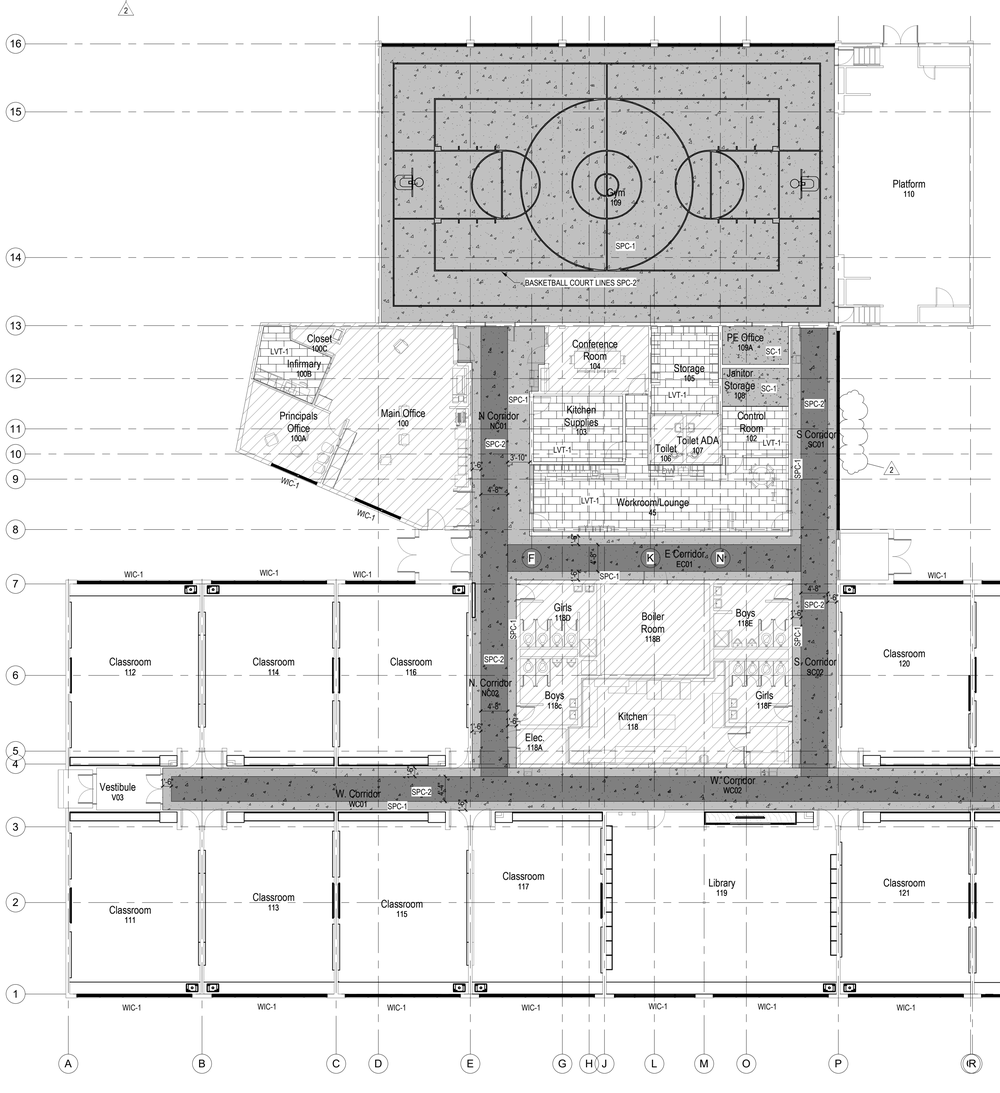

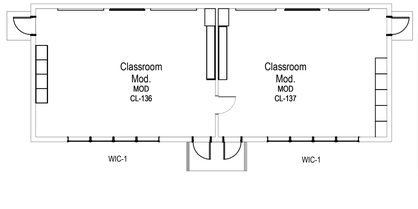

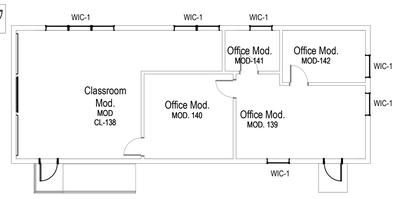

1 Finish Plan
SCALE: 3/32" = 1'-0"

DAO ARCHITECTURE
7230 Meade St.
Westminster, CO 80030
Phone: 720.273.0431
Email: dan@daoarch.com
Web: www.daoarch.com

Rev. #	Description	Rev. Date
2	Addendum 01	11/12/2026

Revision Schedule

Westminster Public Schools

2026 Bond Projects
Harris Park Elementary

4300 W. 75th Avenue
Westminster, CO 80030

DAO No.: 2025-033

September 25, 2026

Finish Plan

A9.0

Autodesk Docs://WPS 2026 Bond Projects - Harris Park Renovations/Harris Park school - 2019 Kitchen (Revit 2025).rvt
11/12/2026 10:31:50 AM

PLUMBING FIXTURE SCHEDULE

PLAN CODE	DESCRIPTION	MANUF.	MODEL	COLOR FINISH	FITTINGS	MANUF.	MODEL	COLOR FINISH	REMARKS
S-1	SINK (ACCESSIBLE) (1.5 GPM)	ELKAY	DRKAD252265L	STAINLESS STEEL	FAUCET BUBBLER	CHICAGO ELKAY	895-GN8AE3ABCP LK1141A	CHROME CHROME	NOTES: 1,2,3,5
S-2	SINK (ACCESSIBLE) (1.5 GPM)	ELKAY	DRKAD252265R	STAINLESS STEEL	FAUCET BUBBLER	CHICAGO ELKAY	895-GN8AE3ABCP LK1141A	CHROME CHROME	NOTES: 1,2,3,4
S-3	SINK (ACCESSIBLE) (1.5 GPM)	ELKAY	LRAD2918-6"	STAINLESS	FAUCET	CHICAGO	895-GN8AE3ABCP	CHROME	NOTES: 1,2,3
EWC-1	ELECTRIC WATER COOLER (ACCESSIBLE) (HIGH/LOW W/ BOTTLE FILL STATION)	ELKAY	EZSTL8WSVRSK	STAINLESS STEEL	CANE APRON	ELKAY	LKAPREZL	-	NOTE: 6 1/5 HP, 120/60/1

NOTES:

1. 17 GA. P-TRAP, ANGLE SUPPLIES WITH 1/4 TURN L.K. STOPS.
2. GRID STRAINER, INSULATION KIT ON SUPPLIES AND DRAIN.
3. 1.5 GPM FLOW RESTRICTOR.
4. BUBBLER TO BE ON RIGHT SIDE OF SINK, FAUCET CENTERED ON SINK.
5. BUBBLER TO BE ON LEFT SIDE OF SINK, FAUCET CENTERED ON SINK.
6. WITH CARRIER, COORDINATE WALL THICKNESS.

PLUMBING FIXTURE CONNECTION SCHEDULE

PLAN CODE	FIXTURE	PIPE SIZE (INCHES, MINIMUM)							REMARKS
		WASTE		VENT	COLD WATER		HOT WATER		
		TRAP & ARM	VERT. DRAIN	(MIN.)	SUPPLY (MIN.)	CONNECTION (ACTUAL)	SUPPLY (MIN.)	CONNECTION (ACTUAL)	
S	SINK	1-1/2"	2"	1-1/2"	1/2"	1/2"	1/2"	1/2"	
EWC	ELEC. WATER COOLER	1-1/2"	2"	1-1/2"	1/2"	3/8"	-	-	

GENERAL LEGEND

ABBV.	SYMBOL	DESCRIPTION
G.C.		GENERAL CONTRACTOR
P.C.		PLUMBING CONTRACTOR
A.F.F.		ABOVE FINISHED FLOOR
B.F.F.		BELOW FINISHED FLOOR
(N)		NEW
(E)		EXISTING
		EXISTING (DEMOLITION OR REMOVED)
		POINT OF CONNECTION - NEW TO EXISTING
		PIPE CAP
		BALL VALVE
		PIPE ELBOW DOWN
		PIPE ELBOW UP
		TEE OFF BOTTOM OF PIPE
		TEE OFF TOP OF PIPE
	X / XXX	X = SECTION/DETAIL NUMBER XXX = SHEET NUMBER WHERE SECTION/DETAIL IS DRAWN

PLUMBING LEGEND

ABBV.	SYMBOL	DESCRIPTION
WC		WATER CLOSET
UR		URINAL
L		LAVATORY
S		SINK
EWC		ELECTRIC WATER COOLER
DF		DRINKING FOUNTAIN
PP		PLUMBING CIRC. PUMP
PET		PLUMBING EXPANSION TANK
GWH		GAS WATER HEATER
GPM		GALLON PER MINUTE
CW		DOMESTIC COLD WATER
SD		STORM DRAIN BELOW FLOOR OR GRADE
G	G	NATURAL GAS
GCO		GRADE CLEANOUT

SHEET INDEX

SHEET NUMBER	PLUMBING SHEET TITLE	SHEET SCALE
P0.0	Plumbing Cover Sheet - General Notes, Schedules & Legend	None
PD1.0	First Floor - Demolition Plumbing Plan	3/32" = 1'-0"
P1.0	First Floor - Plumbing Plan	3/32" = 1'-0"

PLUMBING DEMOLITION GENERAL NOTES

1. COORDINATE DEMOLITION REQUIREMENTS WITH THE GENERAL CONTRACTOR.
2. COORDINATE EXTENT OF DEMOLITION WITH THE NEW CONSTRUCTION AS SHOWN IN THESE DOCUMENTS.
3. EXISTING PLUMBING PIPING, EQUIPMENT ETC IS SHOWN LIGHT.
4. ALL PLUMBING ITEMS INDICATED TO BE DEMOLISHED SHALL BE INSPECTED FOR SALVAGE BY THE OWNER. ALL NON-SALVAGEABLE ITEMS SHALL THEN BE IMMEDIATELY REMOVED FROM THE SITE BY THE PLUMBING CONTRACTOR.
5. ALL UNUSED HANGERS AND SUPPORTS SHALL BE REMOVED.
6. THE REMOVAL OR INSTALLATION OF FIXTURES, PIPES AND EQUIPMENT MAY REQUIRE THE REMOVAL OF EXISTING WALLS AND CEILINGS. THE PLUMBING CONTRACTOR AND GENERAL CONTRACTOR SHALL COORDINATE AND BE RESPONSIBLE FOR REPAIRING AND PAINTING THESE WALLS AND/OR CEILINGS SO THEY MATCH THE EXISTING WHERE NOT REPLACED UNDER THE ARCHITECTURAL DOCUMENTS. THE CONTRACTOR SHALL REVIEW THE PLUMBING DRAWINGS TO IDENTIFY THESE LOCATIONS PRIOR TO BID PRICING.
7. THE GENERAL CONTRACTOR SHALL PATCH AND SEAL UNUSED ROOF PENETRATIONS AT DEMOLISHED PLUMBING TO MATCH EXISTING CONDITIONS.
8. THE GENERAL CONTRACTOR SHALL MAKE REPAIRS TO ALL EXISTING BUILDING COMPONENTS THAT HAVE BEEN AFFECTED BY THE DEMOLITION OF PLUMBING SYSTEMS.

PLUMBING GENERAL NOTES

1. FIELD VERIFY EXACT LOCATION OF ALL CONNECTIONS PRIOR TO CONSTRUCTION.
2. ROUGH-IN AND FINAL CONNECT ALL FIXTURES, EQUIPMENT, ETC.
3. CONTRACTOR SHALL INSPECT SITE TO THOROUGHLY FAMILIARIZE HIMSELF WITH THE AREA OF WORK. ANY DISCREPANCIES BETWEEN THESE DOCUMENTS AND ACTUAL CONDITIONS SHALL BE REPORTED TO THE ARCHITECT/ENGINEER FOR RESOLUTION PRIOR TO BID PRICING. NO EXTRAS WILL BE ALLOWED DUE TO LACK OF KNOWLEDGE OF EXISTING CONDITIONS.
4. COMPLY WITH ALL BUILDING AND HEALTH DEPARTMENT REGULATIONS FOR PLUMBING INSTALLATION. VERIFY ALL REQUIREMENTS PRIOR TO SUBMITTING BID OR COMMENCING WORK.
5. CONTRACTOR SHALL INSTALL PIPING IN ADHERENCE TO 2021 COLORADO PLUMBING CODE, 2021 COLORADO FUEL GAS CODE, 2021 COLORADO ENERGY CODE, AND LOCAL HEALTH CODES. TABLE C404.5.1, FROM THE IECC, IS INCLUDED ON THIS SHEET BELOW FOR EASE OF REFERENCE.
6. PROVIDE BALL VALVES ON ALL BRANCH LINES FOR BUILDING ISOLATION WHETHER SHOWN OR NOT.
7. REFERENCE ARCHITECTURAL DRAWINGS FOR LOCATIONS OF ALL FIRE RATED WALLS. ALL PIPE PENETRATIONS THROUGH FIRE RATED WALLS SHALL BE SEALED IN ACCORDANCE WITH THE BUILDING CODE.
8. OFFSET ALL PIPING AS REQUIRED TO AVOID STRUCTURAL MEMBERS, CANTS, FLASHING, MECHANICAL, OR ELECTRICAL EQUIPMENT.
9. PROTECT ALL EXISTING EQUIPMENT INDICATED AS REMAINING IN PLACE OR BEING RELOCATED. REPLACE DAMAGED EQUIPMENT IMMEDIATELY WITH EXACT DUPLICATE AT NO ADDITIONAL COST TO THE OWNER.
10. PLUMBING CONTRACTOR SHALL BE RESPONSIBLE FOR PROPERLY LOCATING AND PROTECTING ALL EXISTING PIPING AND UTILITIES FOR THE DURATION OF THE WORK. ANY DAMAGE CAUSED TO EXISTING PIPING OR UTILITIES SHALL BE REPAIRED IMMEDIATELY AT NO ADDITIONAL COST TO THE OWNER.
11. SUBMIT TO THE ARCHITECT/ENGINEER ELECTRONIC PDF FILES OF MECHANICAL SUBMITTALS FOR REVIEW OF ALL MAJOR EQUIPMENT AS LISTED ON DRAWING EQUIPMENT SCHEDULES, AS WELL AS PRODUCTS SHOWN IN SPECIFICATIONS. ENGINEER ASSUMED NO RESPONSIBILITY FOR EQUIPMENT OR INSTALLATION COORDINATION THAT HAS NOT BEEN SUBMITTED FOR REVIEW.
12. CONTRACTOR SHALL WARRANTY WORK, EQUIPMENT, FIXTURES, MATERIALS, AND PROPER OPERATION FOR A PERIOD OF ONE YEAR FROM THE DATE OF ACCEPTANCE OF BUILDING BY OWNER. THIS GUARANTEE SHALL NOT INCLUDE NORMAL MAINTENANCE REQUIRED BY THE OWNER AS DESCRIBED IN THE OPERATION AND MAINTENANCE MANUALS.
13. PROVIDE TWO SETS OF OPERATION AND MAINTENANCE (O&M) MANUALS FOR OWNER AT COMPLETION OF PROJECT TO THE ARCHITECT/ENGINEER FOR REVIEW. MANUALS TO INCLUDE INSTALLATION INSTRUCTIONS, REPLACEMENT PART LISTS, AND MAINTENANCE INFORMATION ON ALL MECHANICAL EQUIPMENT, FIXTURES, ETC. SUBMITTED.
14. CONTRACTOR SHALL MAINTAIN A COMPLETE AND ACCURATE SET OF RECORD DRAWINGS SHOWING ACTUAL INSTALLED LOCATIONS OF WORK. SUBMIT THESE DRAWINGS AS PART OF THE OPERATION AND MAINTENANCE MANUALS AT COMPLETION OF PROJECT.
15. NEW WATER PIPING SHALL DISINFECTED AS OUTLINED IN THE CURRENT ADOPTED PLUMBING CODE.

SPECIFICATION (PLUMBING)


PIPING:
A. WASTE & VENT PIPING ABOVE FINISHED FLOOR SHALL BE SERVICE WEIGHT CAST-IRON WITH NO-HUB FITTINGS.
B. WASTE & VENT PIPING BELOW FINISHED FLOOR/GRADE SHALL BE SCHEDULE 40 PVC "SOLID CORE" WITH SOLVENT WELDED FITTINGS.
C. FOUNDATION DRAIN PIPING BELOW GRADE SHALL BE PERFORATED PVC (SDR 35) WITH SOLVENT WELDED FITTINGS, ASTM D-3034.
D. WATER PIPING SHALL BE TYPE "L" COPPER, SOLDERED FITTINGS WITH LEAD FREE SOLDER AND FLUX.

INSULATION:
A. COLD WATER, HOT WATER AND HOT WATER RECIRCULATION INSULATION SHALL BE 1" THICK FIBERGLASS TYPE WITH ALL SERVICE JACKET WITH SELF SEAL LAP (ASJ-SSL).
B. PROVIDE PVC FITTING COVERS FOR ALL OF THE ABOVE MENTIONED SYSTEMS.

EQUIPMENT:
A. WALL CLEANOUT (WCO): CAST IRON BODY ADAPTABLE TO PIPE W/ CAST BRONZE OR CAST BRASS CLEANOUT PLUG. STAINLESS STEEL COVER INCLUDING SCREWS. JOSAM OR EQUAL.
B. GRADE CLEANOUT (GCO): CAST IRON BODY & FRAME, CLEANOUT PLUG, ADJUSTABLE, ROUND, NO-SLIP OR ABRASIVE, CAST IRON TOP. ZURN ZZ1140 OR EQUAL.

VALVES:
A. BALL VALVES SHALL BE NSF 61 RATED AND EQUAL TO APOLLO #77CLF-100/200.

MISCELLANEOUS:
A. SAN-TEES, STOPS, SUPPLIES TO MATCH EXISTING.

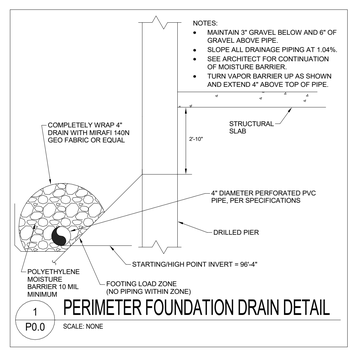

DAO ARCHITECTURE

7230 Meade St.
Westminster, CO 80030

Phone: 720.273.0431
Email: dan@daoarch.com
Web: www.daoarch.com

The Ballard Group, Inc.
Mechanical Consulting Engineers
2525 S. Wadsworth Blvd, Suite 200
Lakewood, CO 80227
(303) 988-4514

Rev. #	Description	Rev. Date
2	Addendum 01	11/12/2026

Revision Schedule

Westminster Public Schools

Harris Park Elementary Kitchen Renovations

4300 W. 75th Avenue
Westminster, CO
80030


DAO No.:2022-022

September 25th, 2026

Plumbing Cover Sheet - General Notes, Schedules & Legend

P0.0

Autodesk Docs://WPS 2026 Bond Projects - Harris Park Renovations/25094 Harris Park 2026 Bond Projects-PLBG-R26.rvt
11/12/2026 9:44:41 AM

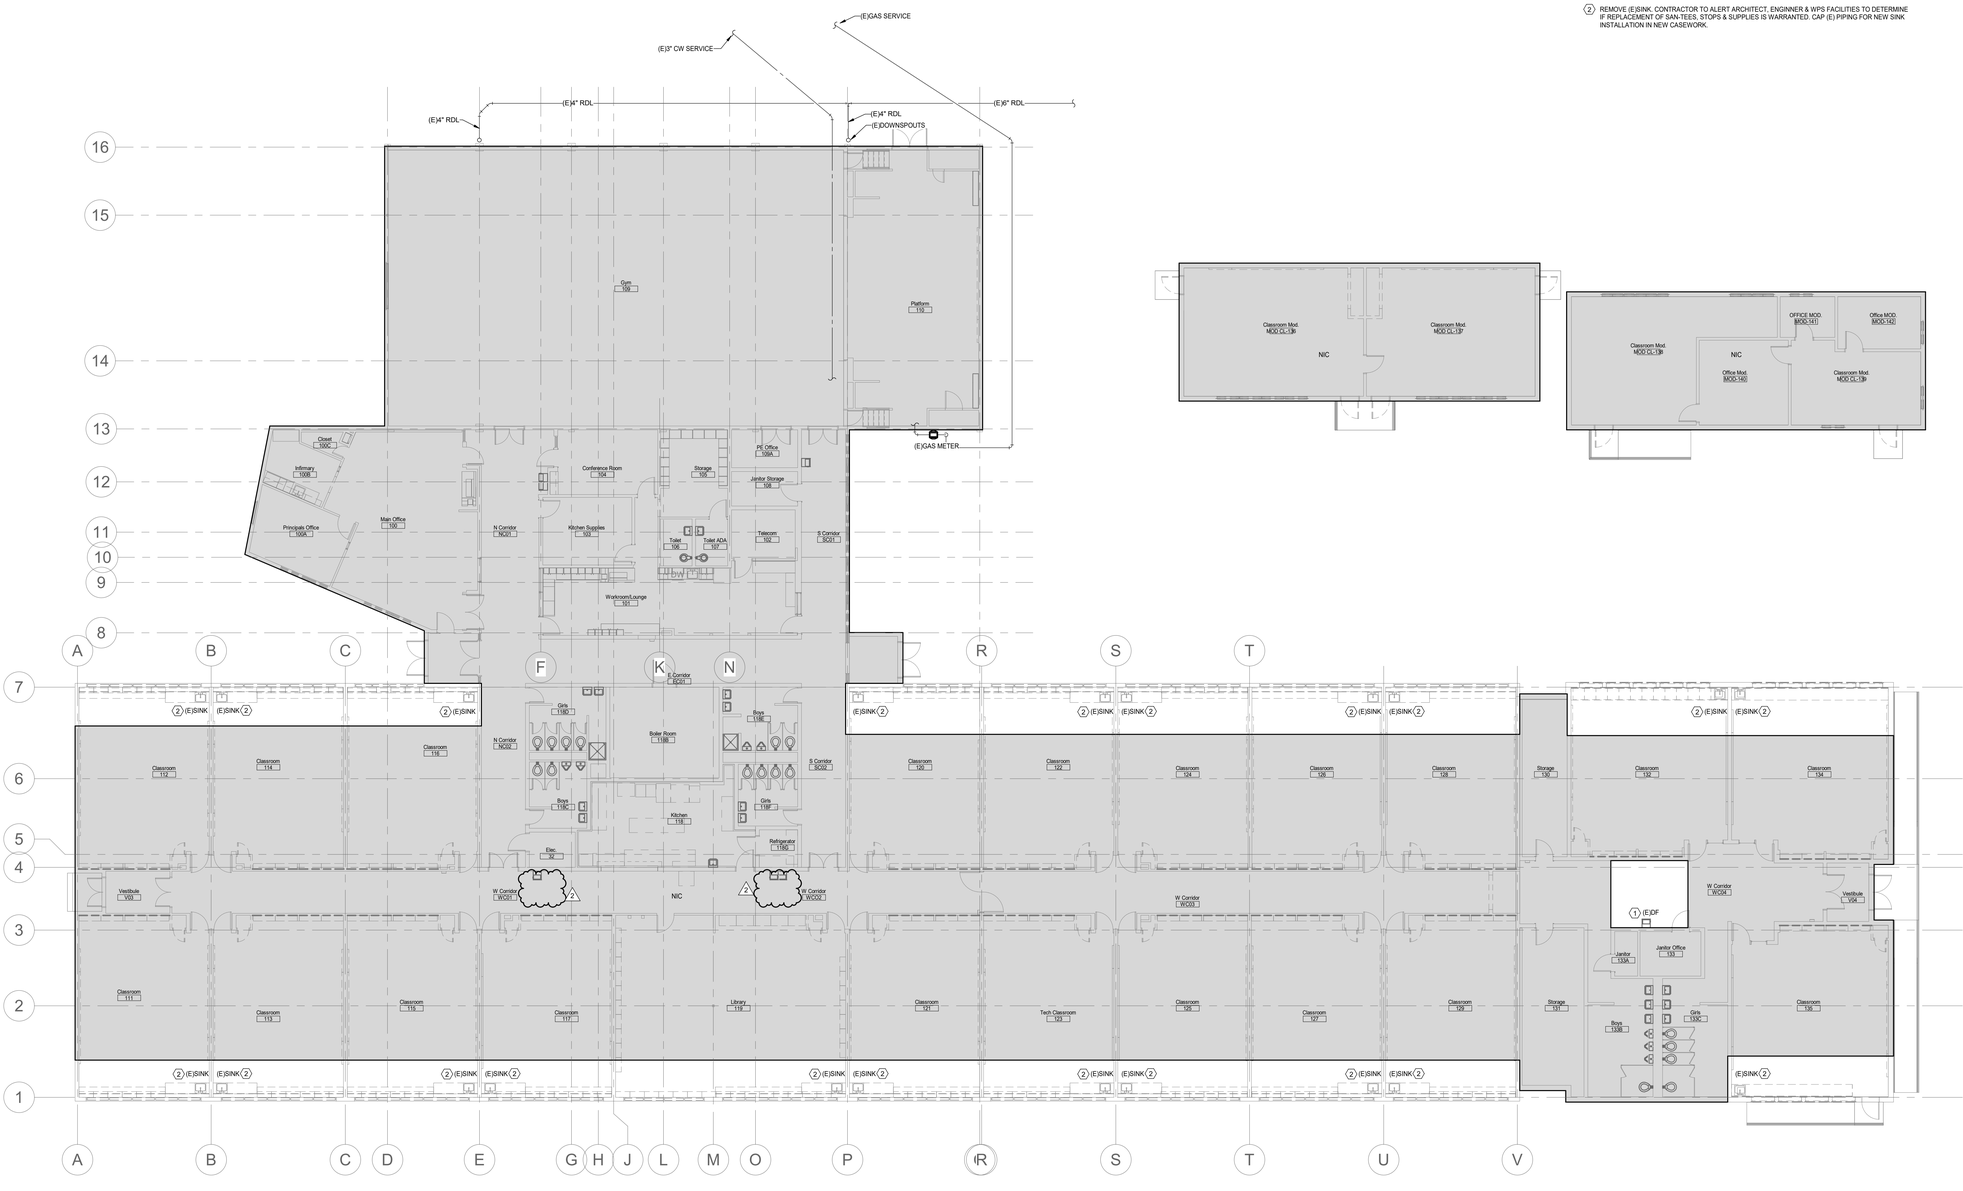

First Floor - Demolition Plumbing Plan

SCALE: 3/32" = 1'-0"

PLUMBING DEMOLITION KEYNOTES:

1. REMOVE (E) DRINKING FOUNTAIN. CAP PIPING FOR (N) FIXTURE.
2. REMOVE (E)SINK. CONTRACTOR TO ALERT ARCHITECT, ENGINNER & WPS FACILITIES TO DETERMINE IF REPLACEMENT OF SAN-TEES, STOPS & SUPPLIES IS WARRANTED. CAP (E) PIPING FOR NEW SINK INSTALLATION IN NEW CASEWORK.

DAO ARCHITECTURE

7230 Meade St.
Westminster, CO 80030

Phone: 720.273.0431
Email: dan@daoarch.com
Web: www.daoarch.com

The Ballard Group, Inc.
Mechanical Consulting Engineers
2525 S. Wadsworth Blvd, Suite 200
Lakewood, CO 80227
(303) 988-4514

Rev. #	Description	Rev. Date
2	Addendum 01	11/12/2026

Revision Schedule

Westminster Public Schools

Harris Park Elementary Kitchen Renovations

4300 W. 75th Avenue
Westminster, CO
80030

DAO No.:2022-022

September 25th, 2026


First Floor - Demolition Plumbing Plan

PD1.0

Autodesk Docs://WPS 2026 Bond Projects - Harris Park Renovations/25094-Harris Park 2026 Bond Projects-PLBG-R26.rvt
11/17/2026 9:44:42 AM

KEYNOTES

T2	REINSTALL EXISTING TECHNOLOGY DEVICES FOLLOWING COMPLETION OF ARCHITECTURAL WORK. RECONNECT TO EXISTING SYSTEMS.

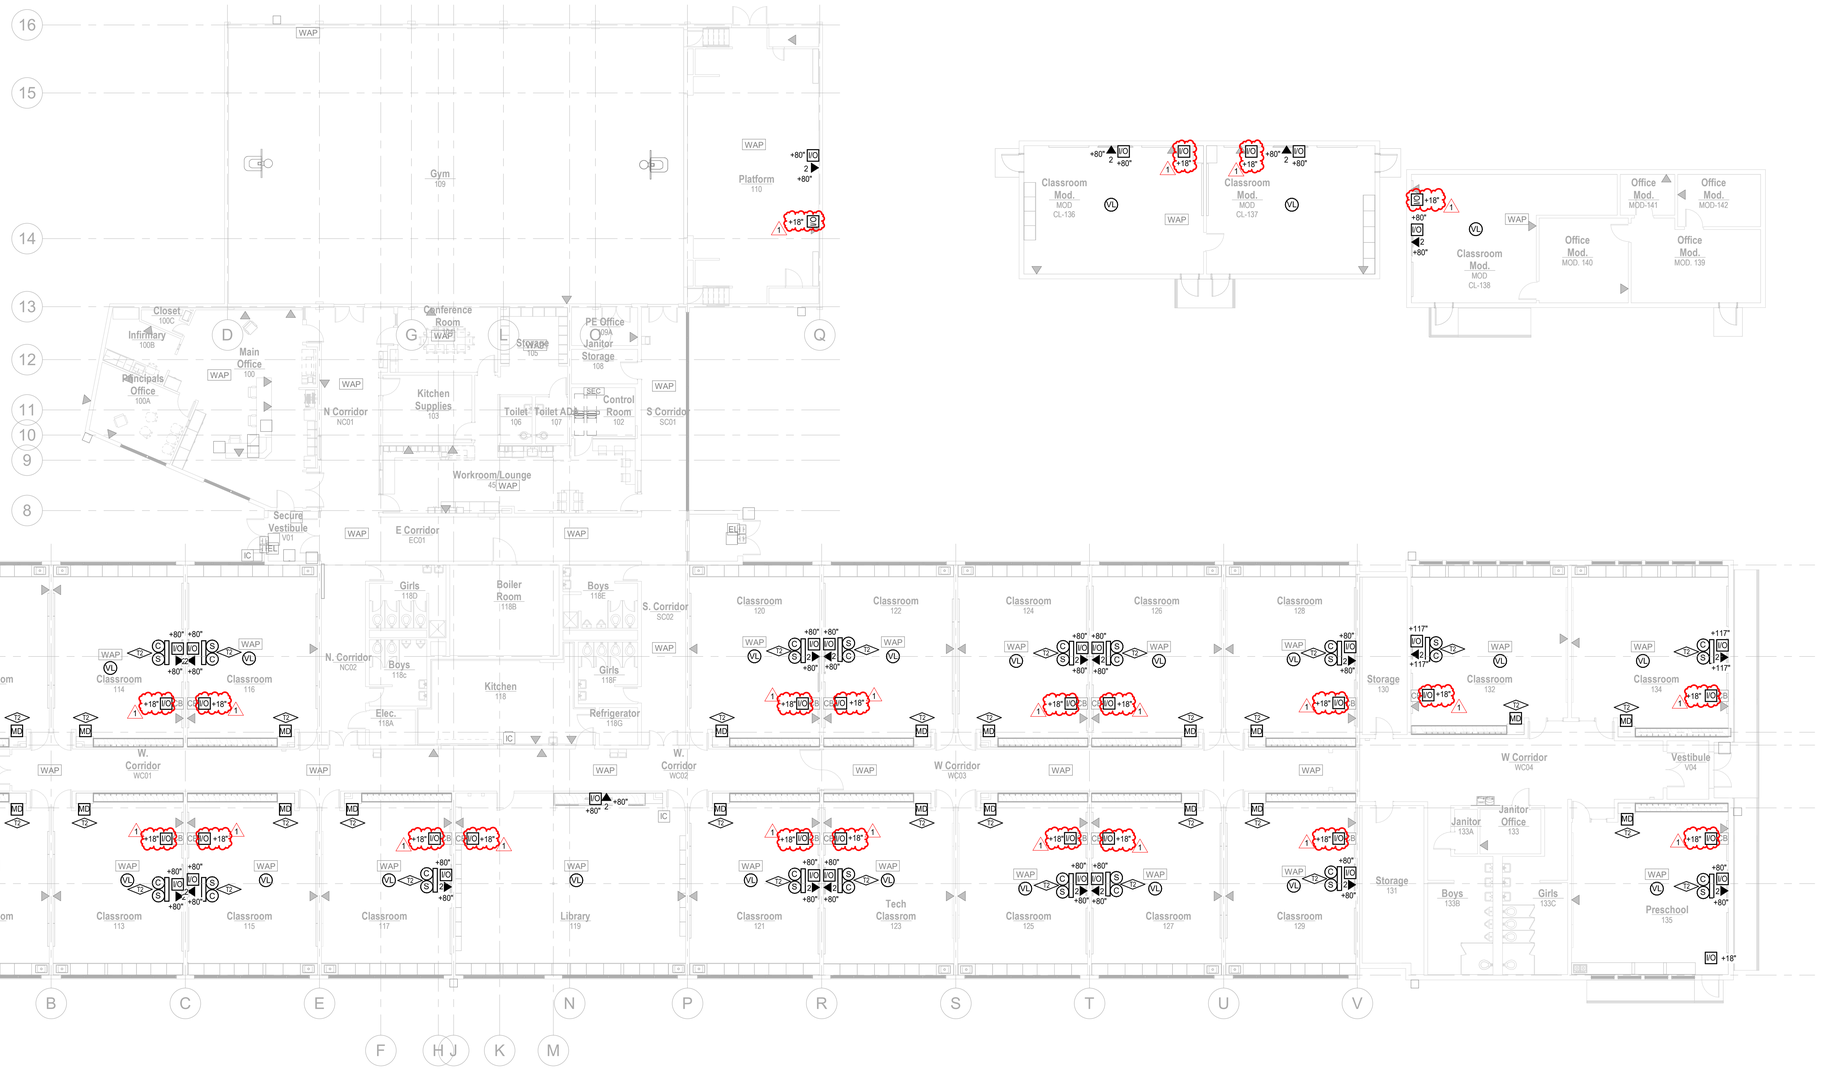


WORKING NORTH

TRUE NORTH

FIRST FLOOR TECHNOLOGY PLAN

SCALE: 3/32" = 1'-0"

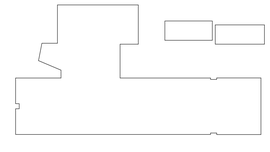

KEYPLAN

DAO ARCHITECTURE

7230 Meade St.
Westminster, CO 80030

Phone: 720.273.0431
Email: dan@daoarch.com
Web: www.daoarch.com

CATOR | RUMA & ASSOCIATES, CO.
896 Tabor Street, Lakewood, CO 80401
(303) 232-6200 ▪ www.catorruma.com

Rev. #	Description	Rev. Date
1	Addendum 01	11/12/2026

Revision Schedule

Westminster Public Schools

2026 Bond Projects
Harris Park Elementary

4300 W. 75th Avenue
Westminster, CO 80030

DAO No.: 2025-033

September 25th, 2026

FIRST FLOOR TECHNOLOGY PLAN

E1.12

P:\WPS\2025-187 Harris Park Elementary School Micro Panel Replacement
11/10/2026 9:28:47 AM