DAO ARCHITECTURE
7230 Meade Street
Westminster, CO 80030
Phone: 720-273-0431
Email: dan@daoarch.com

Date: 11/12/2026
Project: Westminster Public Schools – 2026 Bond Projects – TKP Renovations
DAO Project No.: 2025-033

Addendum 001

The following revisions are to be incorporated into the Construction Documents, dated September 25, 2026

I. SPECIFICATIONS

None at this time

II. DRAWINGS

Sheet G0.0 – Sheet revisions – AHJ comment clarifications

Sheet G0.1 – Sheet Revisions – AHJ comment clarifications

Sheet AD1.0 – Sheet revision – Additional demolition scope for basement and room 129.

Sheet AD2.0 – Sheet revisions – AHJ comment clarifications

Sheet A1.0 – Sheet revisions – Casework scope clarification, AHJ comment clarifications

Sheet A6.0 – Sheet revisions – Casework scope clarification, AHJ comment clarifications

Sheet A6.01 – Sheet revisions – Casework scope, existing conditions clarifications, AHJ comment clarifications

Sheet A6.02 – Sheet revisions – Casework scope, existing conditions clarifications, AHJ comment clarifications

Sheet PD1.0 – Sheet revisions – Demolition scope for installation of wall clean-outs where sinks are being removed

Sheet P1.0 – Sheet revisions – Clarification on wall clean-out scope

III. OTHER

None issued at this time.

MATERIALS SYMBOLS

EARTHWORKS

EARTH NON-COMPACTED

EARTH COMPACT/FILL

GRAVEL/POROUS FILL

CONCRETE

CONCRETE

PRECAST CONCRETE

SAND/MORTAR/PLASTER

METAL

ALUMINUM

BRASS/BRONZE

STEEL

MASONRY

CONCRETE BLOCK

COMMON/FACE BLOCK

FIRE BRICK

STONE

BLUESTONE/SLATE/ SOAPSTONE/FLAGGING

LIMESTONE

RUBBLE

WOOD

FINISH

ROUGH

SHIM

PLYWOOD

GLASS

GLASS

STRUCTURAL

GLASS BLOCK

INSULATION

BATT/LOOSE FILL

RIGID

SPRAY/FOAM

FINISHES

ACOUSTICAL TILE

CARPET AND PAD

CERAMIC TILE

GYPSUM WALLBOARD

TECTUM

PARTITION INDICATIONS

CAST-IN-PLACE CONCRETE

CONCRETE MASONRY

METAL STUD

WOOD STUD

ELEVATION INDICATIONS

BRICK

CERAMIC/ PORCELAIN TILE

CONCRETE/ PLASTER/GPDW


CONCRETE MASONRY UNIT

SHEET METAL


SHINGLES/SIDING

VICINITY MAP

N.T.S.

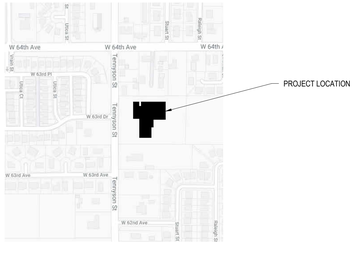

REFERENCE SYMBOLS

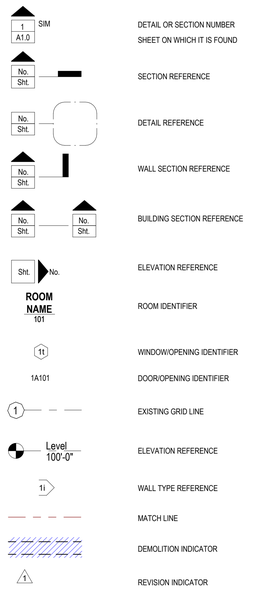

GENERAL NOTES

1. THE GENERAL CONTRACTOR SHALL VERIFY ALL EXISTING DIMENSIONS AND CONDITIONS SHOWN ON PLANS PRIOR TO COMMENCEMENT OF THE WORK. IT SHALL BE THE CONTRACTORS RESPONSIBILITY TO COORDINATE INSTALLATION OF NEW WORK WITHIN THESE EXISTING CONDITIONS. ANY DEVIATIONS IN EXISTING CONDITIONS OR DIMENSIONS INDICATED SHALL BE COORDINATED WITH THE ARCHITECT AND OWNER IN ORDER TO MODIFY PLANS ACCORDINGLY .
2. ALL DISCIPLINES SHALL BE RESPONSIBLE FOR THEIR SCOPE OF WORK . THIS WORK IS TO BE SCHEDULED AND COMPLETED WITH THE GENERAL CONTRACTOR'S FULL KNOWLEDGE.
3. ALL HOT WORK ACTIVITIES (I.E. USING HEAT GUNS, SOLDERING, BRAZING, WELDING, GRINDING, METAL CUTTING, ETC.) OR OTHER ACTIVITIES INVOLVING FLAMES OR SPARKS SHALL BE PRECEDED BY OBTAINING AN APPROVED HOT WORK PERMIT. AN ACFR HOT WORK OPERATIONAL PERMIT IS REQUIRED PRIOR TO ANY HOT WORK.
4. THE PROJECT STAGING AREA / CONSTRUCTION ACTIVITIES SHALL NOT CAUSE THE OBSTRUCTION OF PATHS OF EGRESS INSIDE THE BUILDING, BLOCK EXIT DISCHARGE FROM THE BUILDING, OR IMPEDE EMERGENCY VEHICLE ACCESS TO THE BUILDING. CORRIDORS MAY NOT BE USED AS STAGING AREAS OR AS AREAS FOR DEBRIS COLLECTION.
5. ALL NECESSARY MEASURES SHALL BE TAKEN TO PREVENT THE NUISANCE ACTUATION OF ANY NEARBY SMOKE OR DUCT DETECTORS BY CONSTRUCTION ACTIVITIES THAT CREATE DUST OR FUMES INSIDE THE BUILDING. THE OWNER SHALL ASSIGN AN IMPAIRMENT COORDINATOR, AND IMPAIRED EQUIPMENT SHALL BE TAGGED. SMOKE DETECTORS COVERED TO PREVENT NUISANCE ALARMS CONSTITUTE AN IMPAIRMENT. COVERS SHALL BE REMOVED AT THE END OF EACH WORK SHIFT, THE SYSTEM RESTORED TO NORMAL SERVICE, AND ACFR AND THE MONITORING COMPANY NOTIFIED ON RESTORATION. CODE REFERENCE: 2021 IFC SECTION 901.7 AND 901.7.1 THROUGH 901.7.6
6. THE CONTRACTOR SHALL NOT HANDLE OR DISABLE ANY FIRE SYSTEMS DEVICES. ONLY BUILDING FIRE SYSTEMS PERSONNEL MAY HANDLE OR DISABLE EXISTING FIRE SYSTEMS. ANY OUTAGES REQUIRED FOR THE EXISTING FIRE SYSTEMS SHALL BE PERFORMED ACCORDING TO THE BUILDING PROCEDURES. ACFR AND THE ALARM MONITORING COMPANY TO BE NOTIFIED BEFORE ANY FIRE ALARM SYSTEM IS PLACED OUT OF SERVICE. AN APPROVED FIRE WATCH SHALL BE PROVIDED WHEN THE FIRE ALARM SYSTEM IS OUT OF SERVICE FOR MORE THAN 4 HOURS IN A 24-HOUR PERIOD, OR WHEN REQUIRED BY THE FIRE CODE OFFICAL.
7. THE ARCHITECT ASSUMES NO RESPONSIBILITY FOR THE DETECTION OR REMOVAL OF ANY HAZARDOUS MATERIALS, INCLUDING, BUT NOT LIMITED TO, ASBESTOS IN ANY FORM. PARTIES RESPONSIBLE FOR DEMOLITION SHALL NOTIFY THE OWNER IMMEDIATELY OF ANY SUSPECTED MATERIALS.

PROJECT DESCRIPTION

THE SCOPE OF THIS PROJECT ENTAILS THE REPLACEMENT OF EXISTING CASEWORK THROUGHOUT CLASSROOMS WITHIN THE BUILDING. THE EXTERIOR MASONRY WILL BE REPAIRED AS REQUIRED THROUGHOUT THE BUILDING, AND WILL BE STAINED.

ELECTRICAL AND TECHNOLOGY SYSTEMS WILL BE MODIFIED AS REQUIRED FOR THE NEW CASEWORK INSTALLATION.

NO CIVIL, LANDSCAPE, STRUCTURAL, MECHANICAL, OR FIRE ALARM SCOPE ARE ANTICIPATED AS PART OF THIS PROJECT.

SPECIAL INSPECTIONS:
The following Special Inspections will be required:
1. Fire-Resistant Penetrations and Joints (1705.18)

Deferred Submittals:
The following items require deferred submittals

1. Firestop systems for each penetration type

STANDARD ABBREVIATIONS

A/E	ARCHITECT/ENGINEER
AB	ANCHOR BOLT
ABBR	ABBREVIATE
ABV	ABOVE
AC	AIR CONDITIONING
ACID RES	ACID RESISTANT
ACOUS	ACOUSTICAL
ACOUS INSUL	ACOUSTICAL INSULATION
ACOUS PNL	ACOUSTICAL PANEL
ACOUS PLAS	ACOUSTICAL PLASTER
ACOUS TILE	ACOUSTICAL TILE
ACT	ACTUAL
AD	AREA DRAIN
ADC	AUTOMATIC DOOR CLOSER
ADDL	ADDITIONAL
ADDM	ADDENDUM
ADJ	ADJUSTABLE
ADJC	ADJACENT
AF	ACCESS FLOOR
AFF	ABOVE FINISHED FLOOR
AFG	ABOVE FINISHED GRADE
AFS	ABOVE FINISHED SLAB
AGGR	AGGREGATE
AHR	ANCHOR
AHU	AIR HANDLING UNIT
ALD	ALUMINUM DOOR
ALM	ALARM
ALT	ALTERNATE
ALUM	ALUMINUM
AMB	AMBIENT
AMPL	AMPLIFIER
AMT	AMOUNT
ANN	ANNUNCIATOR
ANOD	ANODIZED
ANT	ANTENNA
AP	ACCESS PANEL
APPX	APPENDIX
ARCH	ARCHITECT(URAL)
ASB	ASBESTOS
ASC	ABOVE SUSPENDED CEILING
ASPH	ASPHALT
ASYM	ASYMMETRICAL
AV	AUDIO VISUAL
AVE	AVENUE
AWC	ACOUSTICAL WALL COVERING
AWP	ACOUSTICAL WALL PANEL
B&B	BALLED AND BURLAPPED
BAF	BAFFLE
BAL	BALANCE
BB	BULLETIN BOARD
BC	BOTTOM OF CURB
BD	BOARD
BEV	BEVEL
BF	BOTH FACES
BFF	BELOW FINISH FLOOR
BFP	BACKFLOW PREVENTER
BITUM	BITUMINOUS
BJT	BED JOINT
BL	BASE LINE
BLDG	BUILDING
BLK	BLOCK
BLKG	BLOCKING
BLKHD	BULKHEAD
BLST	BALLAST
BM	BEAM
BO	BOTTOM OF
BOC	BACK OF CURB
BOW	BOTTOM OF WALL
BP	BASE PLATE
BRCG	BRACING
BRDG JST	BRIDGING JOIST
BRG	BEARING
BRG PL	BEARING PLATE
BRK	BRICK
BRKT	BRACKET
BRS	BRASS
BRZ	BRONZE
BS	BOTH SIDES
BSMT	BASEMENT
BTM	BOTTOM
BUR	BUILT-UP ROOF
BW	BOTH WAYS
BOW	BOTTOM OF WALL
C/C	CENTER TO CENTER
C&G	CURB AND GUTTER
CAB	CABINET
CARP	CARPET
CAV	CAVITY
CB	CATCH BASIN
CCTV	CLOSED CIRCUIT TELEVISION
CEM	CEMENT
CEM PLAS	CEMENT PLASTER
CER	CERAMIC
CER TILE	CERAMIC TILE
C FLG	COUNTER FLASHING
CH BD	CHALKBOARD
CG	CORNER GUARD
CHAN	CHANNEL
CHFR	CHAMFER
CHK	CHECK
CI	CAST IRON
CIP	CAST IN PLACE
CIR	CIRCLE
CJ	CONTROL JOINT
CL	CENTER LINE
CLG	CEILING
CLG DIFF	CEILING DIFFUSER
CLG HT	CEILING HEIGHT
CLL	CONTRACT LIMIT LINE
CLOS	CLOSET
CLR	CLEAR
CLSR	CLOSURE
CMPST	COMPOSITE
CMU	CONCRETE MASONRY UNIT
CNR	CORNER
CNTR	COUNTER
CO	CLEANOUT
COL	COLUMN
COMM	COMMERCIAL
COMPL	COMPLETE
CONC	CONCRETE
CONC FL	CONCRETE FLOOR
CONF	CONFERENCE
CONN	CONNECTION
CONSTR	CONSTRUCTION
CONT	CONTINUOUS
CONTR	CONTRACTOR
COORD	COORDINATE
CORR	CORRIDOR
COV PL	COVER PLATE
CPRS	COMPRESSIBLE
CPT	CARPET
CRCMF	CIRCUMFERENCE
CRS	COLD ROLLED STEEL
CSG	CASING
CSK	COUNTERSUNK
CSMT	CASEMENT
CSWK	CASEWORK
CT	CERAMIC TILE
C TV	CABLE TELEVISION
CUB	CUBICLE
CUR	CURRENT
CW	COLD WATER
DBL GLZ	DOUBLE GLAZING
DEPT	DEPARTMENT
DET	DETAIL
DF	DRINKING FOUNTAIN
DF	DRAPERY FABRIC
DFR	DOOR FRAME
DH	DOUBLE HUNG
DIA	DIAMETER
DIM	DIMENSION
DIST	DISTANCE
DIV	DIVIDER
DIW	DEIONIZED WATER
DJ	DOUBLE JOIST
DL	DRAPERY LINER
DMPF	DAMPPROOFING
DN	DOWN
DO	DITTO
DR	DOOR
DR CLSR	DOOR CLOSURE
DS	DOWNSPOUT
DST	DOOR STOP
DT	DRAIN TILE
DUPL	DUPLICATE
DVTL	DOVETAIL
DW	DISHWASHER
DWG	DRAWING
DWL	DOWEL
DWR	DRAWER
DWTR	DUMBWAITER
E	EAST
EA	EACH
EF	EACH FACE
EJ	EXPANSION JOINT
EL	ELEVATION
ELEC	ELECTRICAL
ELEV	ELEVATOR
EMER	EMERGENCY
EMER SHR	EMERGENCY SHOWER
ENAM	ENAMEL
ENCL	ENCLOSURE
ENGR	ENGINEER
ENTR	ENTRANCE
EO	ELECTRICAL OUTLET
EP	ELECTRICAL PANEL
EPS	EXPANDED POLYSTYRENE
EPX	EPOXY FLOOR
EQL SP	EQUALLY SPACED
EQ	EQUAL
EQUIP	EQUIPMENT
EQUIV	EQUIVALENT
ERECT	ERECTION
ESCAL	ESCALATOR
ESMT	EASEMENT
EST	ESTIMATE
EW	EACH WAY
EXC	EXCAVATE
EXG	EXISTING
EXH HD	EXHAUST HOOD
EXH FN	EXHAUST FAN
EXP	EXPANSION
EXSP	EXPOSED
EXST	EXISTING
EXST GR	EXISTING GRADE
EXT	EXTERIOR
EXTN	EXTENSION
EIFS	EXTERIOR INSULATION & FINISH SYSTEM
F BRK	FIRE BRICK
F/F	FACE TO FACE
FBD	FIBERBOARD
FC	FIRE COATED
FD	FLOOR DRAIN
FDN	FOUNDATION
FEC	FIRE EXTINGUISHER CABINET
FF	FACTORY FINISH
FFE	FINISH FLOOR ELEVATION
FGL	FIBERGLASS
FIN GR	FINISH GRADE
FIN FL	FINISH FLOOR
FIN	FINISH
FL	FLOWLINE
FLDG	FOLDING
FLG	FLANGE
FLR	FLOOR
FLR SK	FLOOR SINK
FLR PL	FLOOR PLATE
FLR FIN	FLOOR FINISH
FLT GL	FLOAT GLASS
FLOUR	FLUORESCENT
FOC	FACE OF CONCRETE
FOM	FACE OF MASONRY
FOS	FACE OF STUD
FPL	FIREPLACE
FPRF	FIREPROOFING
FRM	FRAME
FRNT	FRONT
FS	FULL SIZE
FSP	FIRE STANDPIPE
FSTNR	FASTENER
FTG	FOOTING
FURR	FURRING
FUT	FUTURE
FXTR	FIXTURE
GA	GYPSUM ASSOCIATION
GALV	GALVANIZED
GB	GRAB BAR
GDRL	GUARD RAIL
GENL	GENERAL
GENL CONTR	GENERAL CONTRACTOR
GFI	GROUND FAULT INTERRUPTER
GL	GLASS
GL BLK	GLASS BLOCK
GLU LAM	GLUE LAMINATED
GLZ	GLAZING
GLZ CMU	GLAZED CONCRETE MASONRY UNIT
GND	GROUND
GPDW	GYPSUM DRY WALL
GR BM	GRADE BEAM
GR	GRADE
GRTG	GRATING
GUT	GUTTER
GYP	GYPSUM
GYP PLAS	GYPSUM PLASTER
H	HIGH
H&CW	HOT & COLD WATER
HB	HOSE BIBB
HC	HOLLOW CORE
HC	HANDICAP
HCMU	HOLLOW CONCRETE MASONRY UNIT
HD	HEAVY DUTY
HDJT	HEAD JOINT
HDBD	HARDBOARD
HDR	HEADER
HDWD	HARDWOOD
HGT	HEIGHT
HLB	HORIZONTAL LOUVER BLINDS
HM	HOLLOW METAL
HMD	HOLLOW METAL DOOR
HMF	HOLLOW METAL FRAME
HNDRL	HAND RAIL
HO	HOLD-OPEN
HORIZ	HORIZONTAL
HR	HOUR
HS	HIGH STRENGTH
HSB	HIGH STRENGTH BOLT
HTG	HEATING
HVAC	HEATING, VENTILATION, AIR CONDITIONING
HW	HOT WATER
HYD	HYDRANT
ID	INSIDE DIAMETER
IF	INSIDE FACE
INCAND	INCANDESCENT
INL	INLET
INSTL	INSTALLATION
INSUL	INSULATION
INTR	INTERIOR
INV	INVERT
INV EL	INVERT ELEVATION
JAN	JANITOR
JC	JANITOR'S CLOSET
JST	JOIST
JT	JOINT
KB	KNEE BRACE
KO	KNOCKOUT
KOP	KNOCKOUT PANEL
KPL	KICK PLATE
KWY	KEYWAY
L	LEFT
LAB	LABORATORY
LAT	LAY-IN ACOUSTICAL TILE
LAV	LAVATORY
LB	POUND
LBR	LUMBER
LCMU	LIGHTWEIGHT CONCRETE MASONRY UNIT
LD BRG	LOAD BEARING
LDG	LANDING
LF	LINEAR FOOT
LG	LENGTH
LH	LEFT HAND
LHR	LEFT HAND REVERSE
LIN	LINOLEUM
LIQ	LIQUID
LKR	LOCKER
LKR RM	LOCKER ROOM
LL	LIVE LOAD
LNTL	LINTEL
LOC	LOCATION
LONG	LONGITUDINAL
LRG	LARGE
LS	LUMP SUM
LT	LIGHT
LT WT	LIGHTWEIGHT
LTG	LIGHTING
LVL	LEVEL
LVR	LOUVER
LW PLAS	LIGHTWEIGHT PLASTER
LWC	LIGHTWEIGHT CONCRETE
M	METER
MAINT	MAINTENANCE
MARB	MARBLE
MAS	MASONRY
MATL	MATERIAL
MAX	MAXIMUM
MB	MARKERBOARD
MBR	MEMBER
MC	METAL CLAD
MDF	MEDIUM DENSITY FIBERBOARD
MDO	MEDIUM DENSITY OVERLOAD
ME	MATCH EXISTING
MEC	MISCELLANEOUS EQUIPMENT
MECH	MECHANICAL
MED	MEDIUM
MEMB	MEMBRANE
MEZZ	MEZZANINE
MFG	MANUFACTURING
MFR	MANUFACTURER
MH	MANHOLE
MIL	MILLIMETER
MIN	MINIMUM
MIR	MIRROR
MISC	MISCELLANEOUS
MK	MARK
MKRBD	MARKERBOARD
ML	MATCH LINE
MLC	METAL LABORATORY CASEWORK
MLDG	MOLDING
MLWK	MILLWORK
MO	MASONRY OPENING
MOD	MODULE
MTD	MOUNTED
MTG	MEETING
MTL	METAL
MTR	MORTAR
MULL	MULLION
MULT	MULTIPLE
MVBL	MOVABLE
N	NORTH
N/A	NOT APPLICABLE
NEG	NEGATIVE
NF	NEAR FACE
NIC	NOT IN CONTRACT
NO	NUMBER
NOM	NOMINAL
NS	NEAR SIDE
NTS	NOT TO SCALE
O/O	OUT TO OUT
OA	OVERALL
OC	ON CENTER
OD	OUTSIDE DIAMETER
OD	OVERFLOW DRAIN
OF	OUTSIDE FACE
OFCI	OWNER FURNISHED CONTRACTOR INSTALL
OFF	OFFICE
OFOI	OWNER FURNISHED OWNER INSTALLED
OH	OVERHEAD
OHD	OVERHEAD DOOR
OPER	OPERABLE
OPNG	OPENING
OPP	OPPOSITE
OPT	OPTIONAL
ORIG	ORIGINAL
OVHD	OVERHEAD
OXY	OXYGEN
OZ	OUNCE
P/C	PRECAST
PAR	PARALLEL
PARG	PARGING
PB	PANIC BAR
PBD	PARTICLE BOARD
PC	PORTLAND CEMENT
PCPLAS	PORTLAND CEMENT PLASTER
PED	PEDESTAL
PERF	PERFORATED
PERIM	PERIMETER
PERM	PERMANENT
PERP	PERPENDICULAR
PF	PANEL FABRIC
PFP	PRE-FINISHED PANELS
PGBD	PEGBOARD
PH	PHASE
PL	PLASTIC LAMINATE
PLAM	PLASTIC LAMINATE
PLAS	PLASTER
PLAT	PLATFORM
PLBG	PLUMBING
PLYWD	PLYWOOD
POL	POLISHED
POLY	POLYSTYRENE
POLYISO	POLYISOCYANURATE
POS	POSITIVE
PR	PAIR
PREFAB	PREFABRICATED
PRELIM	PRELIMINARY
PRKG	PARKING
PROJ	PROJECT
PS	PROJECTION SCREEN
PT	PAINT
PT	PORCELAIN TILE
PTN	PARTITION
PVC	POLYVINYL CHLORIDE
PVG	PAVING
PVMT	PAVEMENT
PWR	POWER
QT	QUARRY TILE
QTY	QUANTITY
QUAL	QUALITY
R	RISER
RAD	RADIUS
RB	RUBBER BASE
RBR	RUBBER
RC	REINFORCED CONCRETE
RCP	REINFORCED CONCRETE PIPE
RD	ROOF DRAIN
REC	RECESSED
RECD	RECEIVED
RECPT	RECEPTACLE
RECT	RECTANGULAR
REF	REFERENCE
REINF	REINFORCEMENT
REM	REMOVABLE
REQD	REQUIRED
RESIL	RESILIENT
RFM	RECESSED FLOOR MAT
RFG	ROOFING
RH	RIGHT HAND
RHR	RIGHT HAND REVERSE
RND	ROUND
RO	ROUGH OPENING
RST	RUBBER STAIR TREAD
RT	RUBBER TILE
RV	ROOF VENT
RVS	REVERSE
S	SOUTH
S	SEATING
SALV	SALVAGE
SB	SPLASH BLOCK
SC	SOLID CORE
SCH	SCHEDULE
SCMU	SOLID CONCRETE MASONRY UNIT
SCRN	SCREEN
SD	STORM DRAIN
SECT	SECTION
SF	SYSTEMS FURNITURE
SGL	SINGLE
SHR	SHOWER
SHTHG	SHEATHING
SHVL	SHELVES
SIM	SIMILAR
SJ	SLIP JOINT
SK	SINK
SLA	SLATE
SLP	SLOPE
SLS	SUB-FLOOR LEVELING SYSTEM
SLV	SLEEVE
SM	SHEET METAL
SMLS	SEAMLESS
SP	SPACING
SPCL	SPECIAL
SPEC	SPECIFICATION
SPKLR	SPRINKLER
SPKR	SPEAKER
SPRT	SUPPORT
SQFT	SQUARE FOOT
SQ	SQUARE
SQIN	SQUARE INCH
SQYD	SQUARE YARD
SSK	SERVICE SINK
SS	STAINLESS STEEL
SSM	SOLID SURFACING MATERIAL
ST	STAIN
ST	STREET
STAG	STAGGERED
STC	SOUND TRANSMISSION CLASS
STD	STANDARD
STIR	STIRRUP
STL JST	STEEL JOIST
STL PL	STEEL PLATE
STL	STEEL
STN	STONE
STOR	STORAGE
STRUCT	STRUCTURAL
STRUCT STL	STRUCTURAL STEEL
SUPPL	SUPPLEMENT
SURF	SURFACE
SUSP	SUSPENDED
SUSP CLG	SUSPENDED CEILING
SVB	SHEET VINYL BASE
SVF	SHEET VINYL FLOOR
SYM	SYMBOL
SYMM	SYMMETRICAL
SYST	SYSTEM
T&B	TOP & BOTTOM
T&G	TONGUE & GROOVE
T	TABLE
TB	TACKBOARD
TB-xx	TEST BORING-xx (E.G. TB-1)
TC	TOP OF CURB
TD	TRENCH DRAIN
TE	TRANSITION EDGE
TECH	TECHNICAL
TEMP	TEMPORARY
TER	TERRAZZO
THK	THICK
THRES	THRESHOLD
THRU	THROUGH
TKBD	TACKBOARD
TLT	TOILET
TMPD	TEMPERED
TMPD GL	TEMPERED GLASS
TNL	TUNNEL
TO	TOP OF
TOF	TOP OF FLANGE
TOFF	TOP OF FINISH FLOOR
TOJ	TOP OF JOIST
TOL	TOLERANCE
TOS	TOP OF STEEL
TOT	TOTAL
TOW	TOP OF WALL
TRNBKL	TURNBUCKLE
TS	TUBE STEEL
TV	TELEVISION
TYP	TYPICAL
UF	UPHOLSTERY FABRIC
UFD	UNDER FLOOR DUCT
UG	UNDERGROUND
UL	UNDERWRITERS LABORATORY
ULT	ULTIMATE
UNEX	UNEXCAVATED
UNFIN	UNFINISHED
UNO	UNLESS NOTED OTHERWISE
UPS	UNITERRUPTIBLE POWER SUPPLY
UR	URINAL
UTIL	UTILITY
V	VOLT
VAC	VACUUM
VAV	VARIABLE AIR VOLUME
VB	VAPOR BARRIER
VCT	VINYL COMPOSITION TILE
VDB	VISUAL DISPLAY BOARD
VERT	VERTICAL
VEST	VESTIBULE
VIB	VIBRATION
VNR	VENEER
VOL	VOLUME
VR	VAPOR RETARDER
VT	VINYL TILE
VWC	VINYL WALL COVERING
W	WITH
WW	WALL TO WALL
W/O	WITHOUT
W	WEST
WC	WATER CLOSET
WC	WALL COVERING
WCPT	WALL CARPET
WD	WOOD
WDD	WOOD DOOR
WDW	WINDOW
WF	WOOD FLOORING
WF	WIDE FLANGE
WGL	WIRE GLASS
WH	WALL HUNG
WHSE	WAREHOUSE
WL	WIND LOAD
WLD	WELDED
WR	WATER RESISTANT
WS	WEATHERSTRIPPING
WSCT	WAINSCOT
WT	WEIGHT
WTR	WATER
WTRPRF	WATERPROOFING
WWM	WELDED WIRE MESH
X SECT	CROSS SECTION

DAO ARCHITECTURE

7230 Meade St.
Westminster, CO 80030

Phone: 720.273.0431
Email: dan@daoarch.com
Web: www.daoarch.com

Rev. #	Description	Rev. Date
3	ACFR Round 2	10/28/2026

Revision Schedule

Westminster Public Schools

2026 Bond Projects
Tennyson Knolls Preparatory School Renovations

6330 Tennyson St,
Arvada, CO 80003

DAO No.: 2025-033

September 25, 2026

Standard Symbols, Abbreviations, General Notes & Building Code Data

G0.0

C:\Users\Anoor\AppData\Local\Autodesk\Revit\Autodesk Revit 2026\Collaboration\Cache\Y3PJ5STONLYKN5MR9cY483034-ba39-465b-87f9-5f0f80ca52ed-16c02ba1da-ba2f-c387-aaab-44d75d20fa3.rvt
11/12/2026 9:56:40 AM

APPLICABLE BUILDING CODES

All new work shall comply with the requirements of the codes and standards adopted by the State of Colorado.
The primary Applicable Codes and Standards are:

The 2021 International Code Series:
- The 2021 International Existing Building Code (IEBC)
- The 2021 International Building Code (IBC)
- The 2021 International Fire Code (IFC)
- The 2021 International Mechanical Code (IMC)
- The 2021 International Energy Conservation Code (IECC)

The 2021 Colorado Plumbing Code (CPC)
The 2021 Colorado Fuel Gas Code (CFGC)
The 2023 National Electrical Code
The 2017 ICC A117.1, Accessible and Usable Buildings and Facilities
The 2023 Colorado Model Electric Ready and Solar Ready Code

CODE REVIEW

This project entails replacing existing casework in classrooms, exterior masonry repair, staining of the entire building and electrical modifications as required for casework installation at the existing Tennyson Knolls Preparatory Academy located at 6330 Tennyson Street, Arvada, CO 80003 (unincorporated Adams County). This building is an existing E Occupancy building and will remain an E occupancy.

2021 IEBC

Chapter 3 – Provisions for All Compliance Methods
302 - General Provisions
- 302.4 New and replacement materials - Except as otherwise required or permitted by this code, materials permitted by the applicable code for new construction shall be used.

306 – Accessibility for Existing Buildings
- 306.1 Scope - The provisions of Sections 306.1 through 306.7.16 apply to maintenance and *repair, change of occupancy*, *additions* and *alterations* to *existing buildings*, including those identified as *historic buildings*.
- 306.7 *Alterations* - A *facility* that is altered shall comply with the applicable provisions in chapter 11 of the *International Building Code*, ICC A117.1 and the provisions of Sections 306.7.1 through 306.7.16, unless *technically infeasible*. Where compliance with this section is *technically infeasible*, the *alteration* shall provide access to the maximum extent technically feasible.
  - 306.7.1 Alterations affecting an Area of Primary Function - Where an *alteration* affects the accessibility to, or contains an area of *primary function*, the route to the *primary function* area shall be accessible. The accessible route to the *primary function* area shall include toilet *facilities* and drinking fountains serving the area of *primary function*.

Chapter 5 - Prescriptive Compliance Method
503 - Alterations
- 503.1 General - *Alterations* to any building or structure shall comply with the requirements of the *International Building Code* for new construction. *Alterations* shall be such that the *existing building* or structure is not less complying with the provisions of the *International Building Code* than the *existing building* or structure was prior to the *alteration*.

2021 IBC
Chapter 3 – Use and Occupancy Classification
305 - Educational: Group E - Educational Group E occupancy includes, among others, the use of a building or structure, or a portion thereof, by six or more persons at any one time for educational purposes through the 12th grade.

305.2 - Group E, day care facilities - This group includes buildings and structures or portions thereof occupied by more than five children older than 2 1/2 years of age who receive educational, supervision or personal care services for fewer than 24 hours per day. **Chapter 5 – General Building Heights and Areas**.
Building height and area are existing conditions that will not be altered by this project 's scope.

Chapter 6 - Types of Construction
602 - Construction Classification
- 602.3 - Type IIIB - The existing building is assumed to be type IIIB, as the exterior walls are of noncombustible materials, and the interior building elements are of any material permitted by the IBC.

Chapter 8 - Interior Finishes
803 - Wall and Ceiling Finishes
- 803.1 - Interior wall and ceiling finish materials shall be classified for fire performance and smoke development in accordance with Section 803.1.1 or 803.1.2
- 803.13 - Interior finish requirements based on group - Per Table 803.13
  E Occupancy (Non Sprinklered) - Exit enclosures and exit passageways - Class A;
  Corridors - Class B ;
  Rooms and Enclosed Spaces - Class C

Chapter 9 - Fire Protection Systems
903 - Automatic Fire Sprinklers
- 903.2 - Where Required - Automatic sprinklers will not be required as the building is an existing structure. [The existing building is un-sprinklered]

Chapter 10 – Means of Egress
Means of Egress are existing conditions that will not be altered by this project 's scope.

Chapter 11 – Accessibility
1110 – Other Features and Facilities
- 1110.3 Sinks - Where sinks are provided, at least 5 percent but not less than one provided in accessible spaces shall be accessible.
- 1110.19 Storage - Where fixed or built-in storage elements such as cabinets, coat hooks, shelves, medicine cabinets, lockers, closets and drawers are provided in required accessible spaces, at least 5 percent, but not less than one of each type shall be accessible.

Chapter 13 – Energy Efficiency
Energy efficiency features are existing and are not being altered by the scope of this project.

Chapter 29 – Plumbing Systems
See table 2902.1.

NOTE: PER IFC 807.5.2, COMBUSTIBLE ARTWORK AND TEACHING MATERIALS IN CLASSROOMS SHALL NOT EXCEED 50 PERCENT OF THE AGGREGATE WALL AREA, AND IN CORRIDORS SHALL NOT EXCEED 20 PERCENT. COMBUSTIBLE MATERIALS SHALL NOT BE STORED IN CORRIDORS.


Table 2902.1

Classification	Occupancy	Description	Water Closets Male	Water Closets Female	Lavatories Male	Lavatories Female	Bathtubs/ Showers	Drinking Fountains	Other
Educational	E	Educational facilities	1/50 474/50 =9.5	1/50 474/50 =9.5	1/50 474/50 =9.5	1/50 474/50 =9.5	N/A	1/100 948/100 =9.5	# Service Sink 1 Service Sink
		Total Required	**Existing**	**Existing**	**Existing**	**Existing**	N/A	**Existing**	**Existing**
		Total Provided	**Existing**	**Existing**	**Existing**	**Existing**	N/A	**Existing**	**Existing**

Occupant Load Table

Number	Name	Area	Area Function	SF Per Occupant	Occupant Load	Required Exiting Width
000	Vestibule	110 SF	(none)		0.00	0
004	Vestibule	64 SF	(none)		0.00	0
008	Vestibule	63 SF	(none)		0.00	0
009	Vestibule	63 SF	(none)		0.00	0
010	Mechanical	537 SF	IBC_Accessory storage areas, mechanical equipment room	300 SF	1.79	0.4
011	Group Room	892 SF	IBC_Educational: Classroom area	20 SF	44.61	8.9
100	Office	445 SF	IBC_Business areas	100 SF	4.45	0.9
100a	Principal	153 SF	IBC_Business areas	100 SF	1.53	0.3
100b	Nurse	131 SF	IBC_Business areas	100 SF	1.31	0.3
100c	Work Room	187 SF	IBC_Assembly: without fixed seats - Unconcentrated (tables and chairs)	15 SF	12.44	2.5
100d	Hall	65 SF	(none)		0.00	0
100e	RR	21 SF	(none)		0.00	0
100f	RR	21 SF	(none)		0.00	0
101	Kindergarten	749 SF	IBC_Educational: Classroom area	20 SF	37.44	7.5
101a	Storage	108 SF	IBC_Accessory storage areas, mechanical equipment room	300 SF	0.36	0.1
101b	Vestibule	38 SF	(none)		0.00	0
101c	RR	20 SF	(none)		0.00	0
101d	RR	20 SF	(none)		0.00	0
102	Kindergarten	769 SF	IBC_Educational: Classroom area	20 SF	38.43	7.7
103	Speech Therapy	295 SF	IBC_Business areas	100 SF	2.95	0.6
104	Speech Therapy	266 SF	IBC_Business areas	100 SF	2.66	0.5
105	Elec.	25 SF	IBC_Accessory storage areas, mechanical equipment room	300 SF	0.08	0
106	Storage	88 SF	IBC_Accessory storage areas, mechanical equipment room	300 SF	0.29	0.1
107	Lounge	606 SF	IBC_Educational: Classroom area	20 SF	30.31	6.1
107a	Office	233 SF	IBC_Business areas	100 SF	2.33	0.5
107b	Lift	24 SF	(none)		0.00	0
108	Janitor	55 SF	IBC_Accessory storage areas, mechanical equipment room	300 SF	0.18	0
109	Classroom	656 SF	IBC_Educational: Classroom area	20 SF	32.81	6.6
110	Music Room	840 SF	IBC_Educational: Classroom area	20 SF	41.98	8.4
110a	Lift	22 SF	(none)		0.00	0
111	Classroom	656 SF	IBC_Educational: Classroom area	20 SF	32.81	6.6
112	Classroom	656 SF	IBC_Educational: Classroom area	20 SF	32.81	6.6
113	Classroom	656 SF	IBC_Educational: Classroom area	20 SF	32.81	6.6
114	Classroom	656 SF	IBC_Educational: Classroom area	20 SF	32.81	6.6
115	Classroom	656 SF	IBC_Educational: Classroom area	20 SF	32.78	6.6
116	Classroom	656 SF	IBC_Educational: Classroom area	20 SF	32.81	6.6
117a	PE Office & Storage	232 SF	IBC_Business areas	100 SF	2.32	0.5
118	Classroom	656 SF	IBC_Educational: Classroom area	20 SF	32.78	6.6
119	Classroom	656 SF	IBC_Educational: Classroom area	20 SF	32.81	6.6
120	Preschool	654 SF	IBC_Educational: Classroom area	20 SF	32.72	6.5
121	Janitor	48 SF	IBC_Accessory storage areas, mechanical equipment room	300 SF	0.16	0
122	Media	1366 SF	IBC_Assembly: without fixed seats - Unconcentrated (tables and chairs)	15 SF	91.04	18.2
123	Classroom	749 SF	IBC_Educational: Classroom area	20 SF	37.45	7.5
124	Classroom	813 SF	IBC_Educational: Classroom area	20 SF	40.63	8.1
125	Janitor	59 SF	IBC_Accessory storage areas, mechanical equipment room	300 SF	0.20	0
126	Office	187 SF	IBC_Business areas	100 SF	1.87	0.4
127	Classroom	630 SF	IBC_Educational: Classroom area	20 SF	31.52	6.3
128	Classroom	604 SF	IBC_Educational: Classroom area	20 SF	30.22	6
129	Classroom	810 SF	IBC_Educational: Classroom area	20 SF	40.50	8.1
130	Classroom	843 SF	IBC_Educational: Classroom area	20 SF	42.16	8.4
131	Storage	323 SF	IBC_Accessory storage areas, mechanical equipment room	300 SF	1.08	0.2
132	Boys RR	153 SF	(none)		0.00	0
133	Girls RR	197 SF	(none)		0.00	0
134	Kitchen	319 SF	IBC_Kitchens, commercial	200 SF	1.59	0.3
134a	Kitchen Storage	117 SF	IBC_Accessory storage areas, mechanical equipment room	300 SF	0.39	0.1
134b	Refrigerator	53 SF	IBC_Accessory storage areas, mechanical equipment room	300 SF	0.18	0
135	Mens RR	118 SF	(none)		0.00	0
136	Girls RR	139 SF	(none)		0.00	0
137	Girls RR	152 SF	(none)		0.00	0
138	Boys RR	151 SF	(none)		0.00	0
: 60		21529 SF			872.41	174.5
Gymnasium						
117	Gymnasium	3806 SF	IBC_Assembly: without fixed seats - Concentrated (chairs only - not fixed)	7 SF	543.71	108.7
Gymnasium: 1		3806 SF			543.71	108.7
Grand total: 61		25335 SF			1416.12	283.2

NOTE:
THE GYMNASIUM IS SHOWN SPLIT OUT FROM THE REST OF THE SCHOOL, FOR COMPARISON OF THE OCCUPANT LOAD OF THE AFTER HOURS ASSEMBLY SPACES AND THE EDUCATIONAL SPACES. THE OCCUPANT LOAD FOR THE BUILDING IS BASED ON THE COMBINED TOTAL.

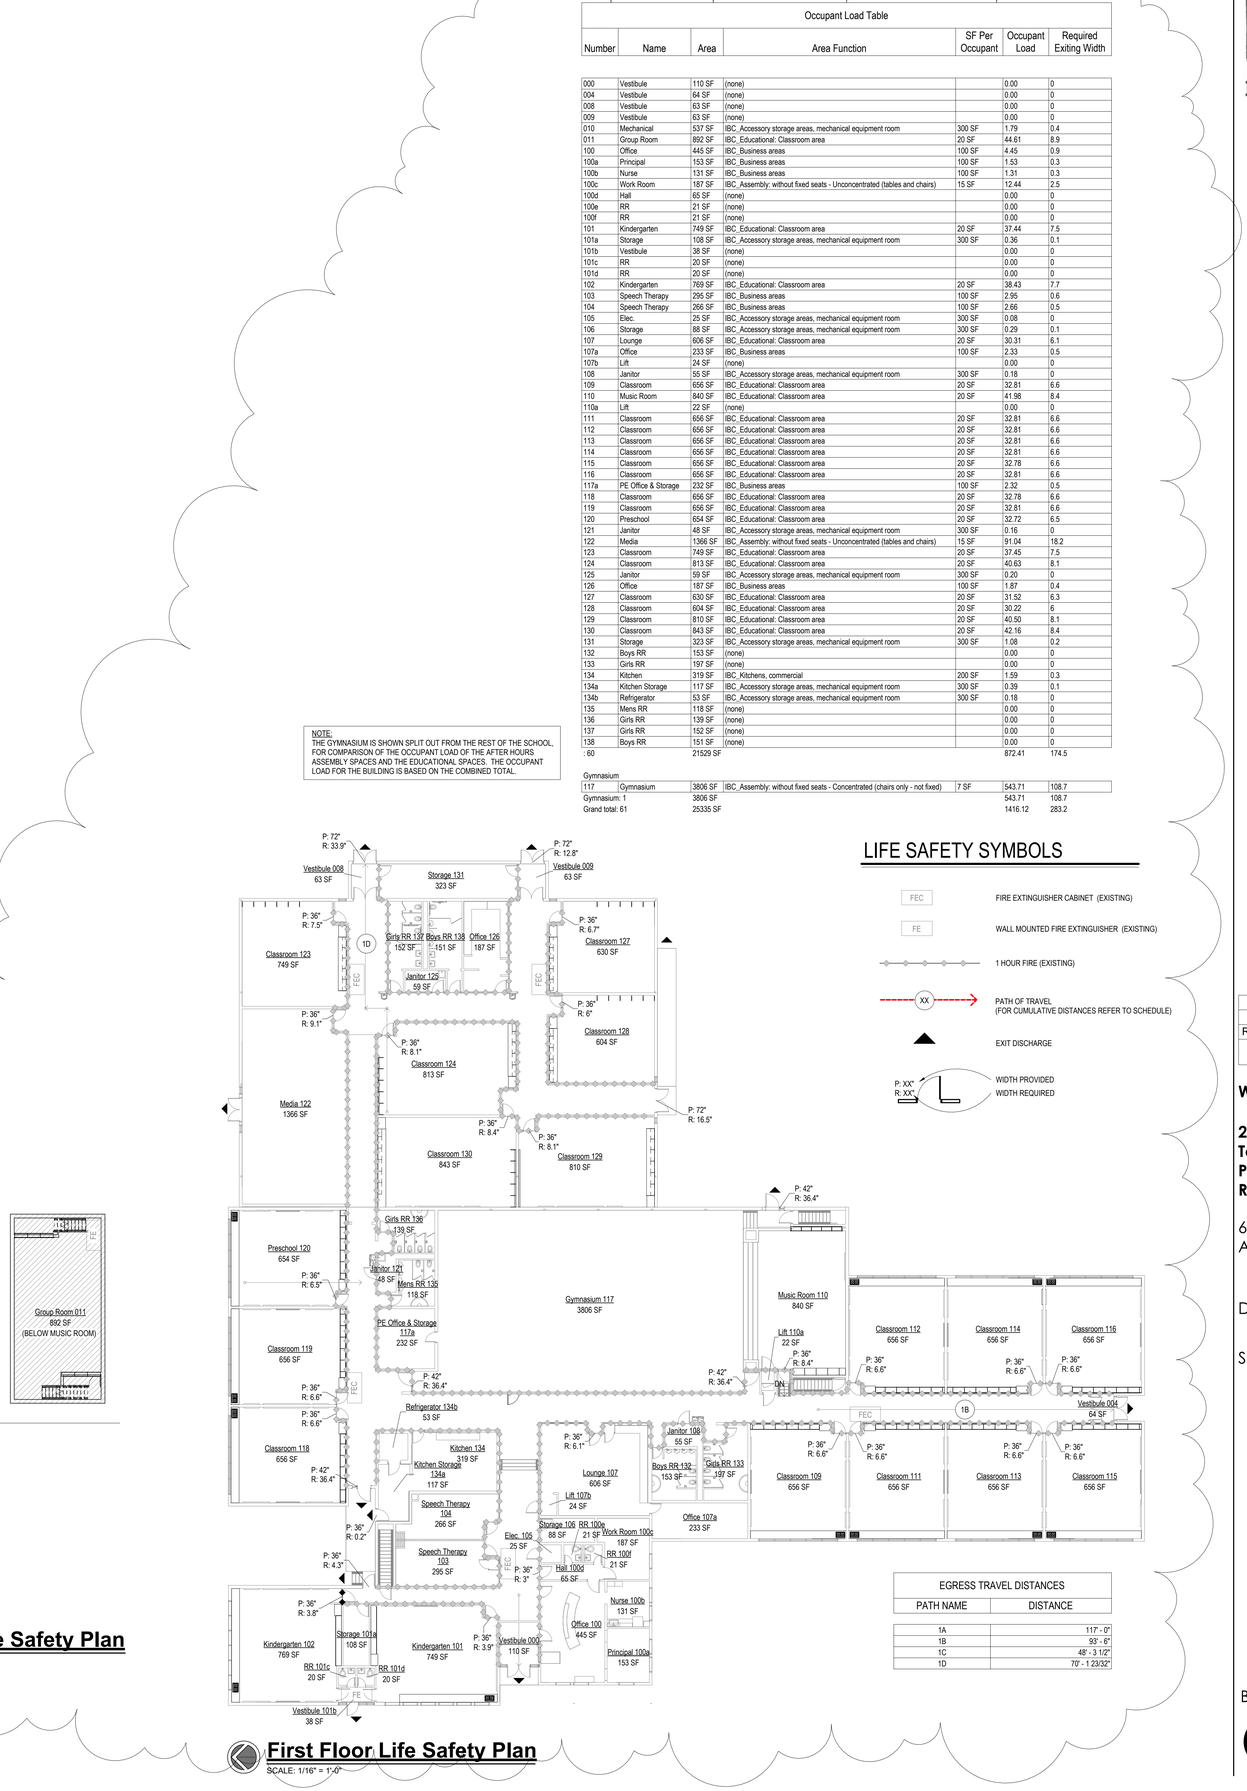

Basement Life Safety Plan
SCALE: 1/16" = 1'-0"

First Floor Life Safety Plan
SCALE: 1/16" = 1'-0"

LIFE SAFETY SYMBOLS

- FEC — FIRE EXTINGUISHER CABINET (EXISTING)
- FE — WALL MOUNTED FIRE EXTINGUISHER (EXISTING)
- 1 HOUR FIRE (EXISTING)
- XX — PATH OF TRAVEL (FOR CUMULATIVE DISTANCES REFER TO SCHEDULE)
- EXIT DISCHARGE
- P: XX" / R: XX" — WIDTH PROVIDED / WIDTH REQUIRED

EGRESS TRAVEL DISTANCES

PATH NAME	DISTANCE
1A	117' - 0"
1B	93' - 6"
1C	48' - 3 1/2"
1D	70' - 1 23/32"

DAO ARCHITECTURE
7230 Meade St.
Westminster, CO 80030
Phone: 720.273.0431
Email: dan@daoarch.com
Web: www.daoarch.com

Rev. #	Description	Rev. Date
3	ACFR Round 2	10/28/2026
1	ACFR Comments	10/26/2026

Revision Schedule

Westminster Public Schools

2026 Bond Projects
Tennyson Knolls Preparatory School Renovations

6330 Tennyson St,
Arvada, CO 80003


DAO No.: 2025-033

September 25, 2026

Building Code Data

G0.1

C:\Users\Arvon\AppData\Local\Autodesk\Revit\Autodesk Revit 2026\Collaboration\Cache\YSPJ6ST5\NLYKNSMR\b7453034-ba39-45da-87f5-9080a4524e15\025-ba1fc-ba0f-4387-aea8-f4dd75c820a3.rvt
11/12/2025 9:56:43 AM

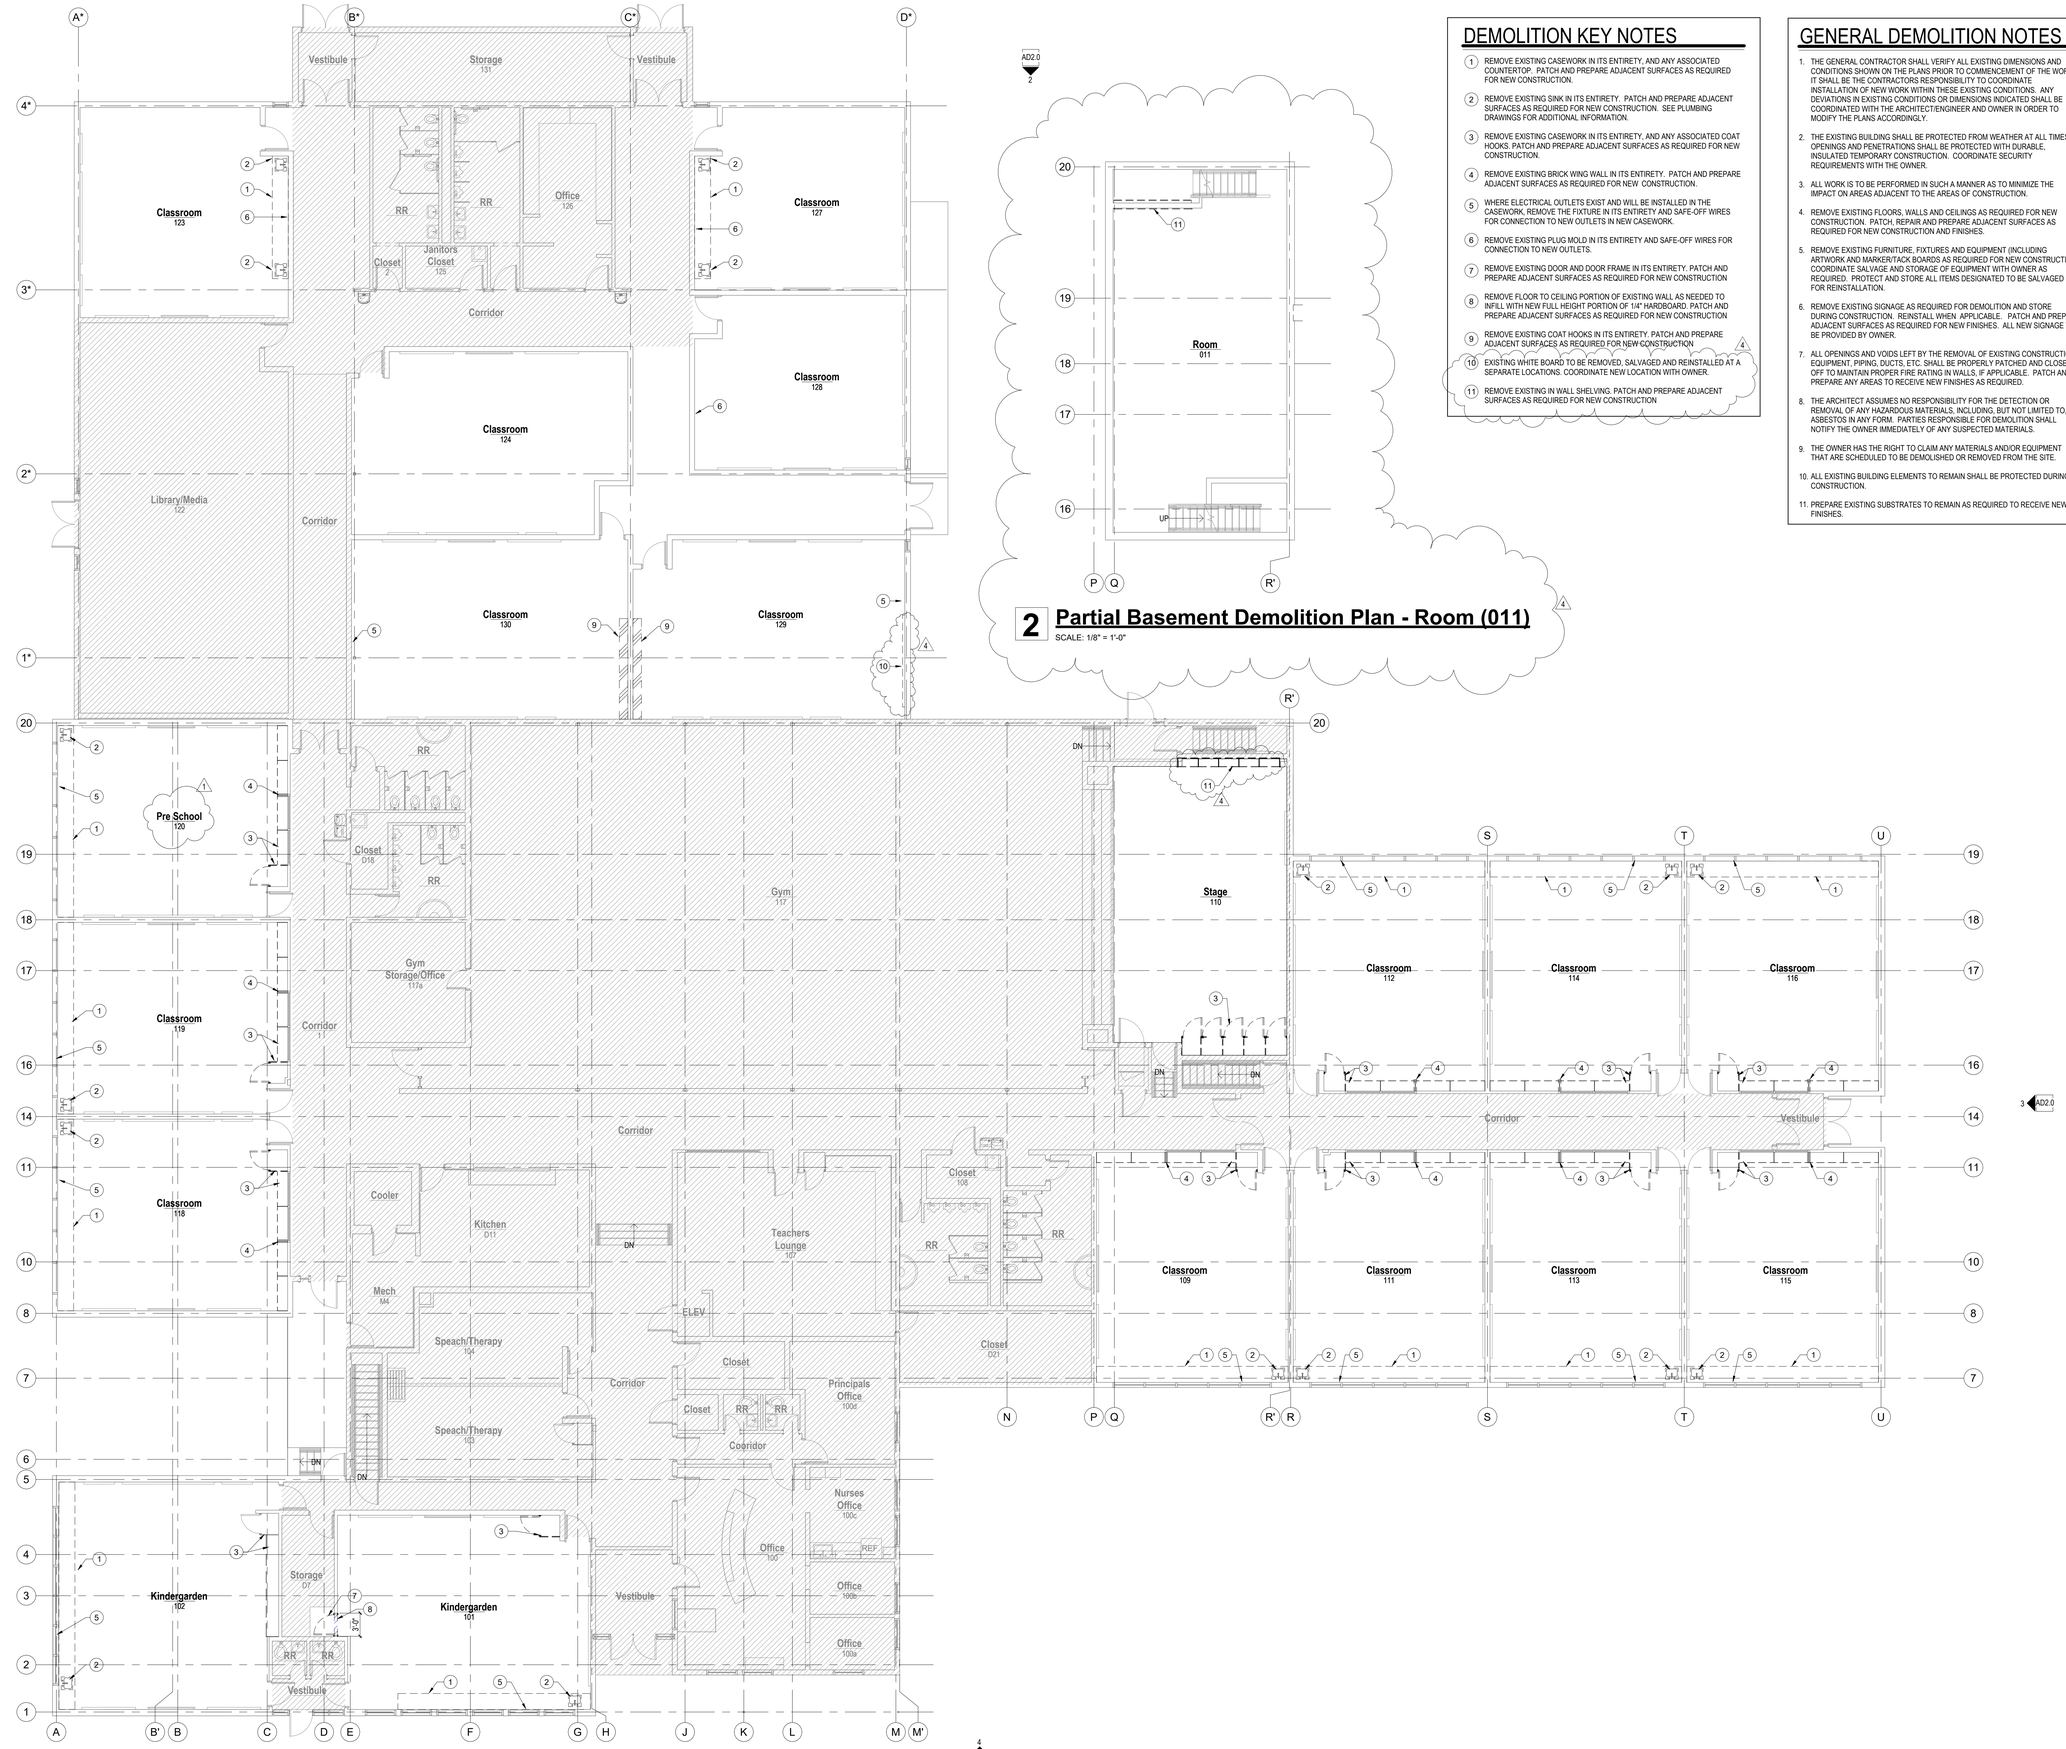

2 Partial Basement Demolition Plan - Room (011)

SCALE: 1/8" = 1'-0"

1 First Floor Demolition Plan

SCALE: 1/8" = 1'-0"

DEMOLITION KEY NOTES

1. REMOVE EXISTING CASEWORK IN ITS ENTIRETY, AND ANY ASSOCIATED COUNTERTOP. PATCH AND PREPARE ADJACENT SURFACES AS REQUIRED FOR NEW CONSTRUCTION.
2. REMOVE EXISTING SINK IN ITS ENTIRETY. PATCH AND PREPARE ADJACENT SURFACES AS REQUIRED FOR NEW CONSTRUCTION. SEE PLUMBING DRAWINGS FOR ADDITIONAL INFORMATION.
3. REMOVE EXISTING CASEWORK IN ITS ENTIRETY, AND ANY ASSOCIATED COAT HOOKS. PATCH AND PREPARE ADJACENT SURFACES AS REQUIRED FOR NEW CONSTRUCTION.
4. REMOVE EXISTING BRICK WING WALL IN ITS ENTIRETY. PATCH AND PREPARE ADJACENT SURFACES AS REQUIRED FOR NEW CONSTRUCTION.
5. WHERE ELECTRICAL OUTLETS EXIST AND WILL BE INSTALLED IN THE CASEWORK, REMOVE THE FIXTURE IN ITS ENTIRETY AND SAFE-OFF WIRES FOR CONNECTION TO NEW OUTLETS IN NEW CASEWORK.
6. REMOVE EXISTING PLUG MOLD IN ITS ENTIRETY AND SAFE-OFF WIRES FOR CONNECTION TO NEW OUTLETS.
7. REMOVE EXISTING DOOR AND DOOR FRAME IN ITS ENTIRETY. PATCH AND PREPARE ADJACENT SURFACES AS REQUIRED FOR NEW CONSTRUCTION
8. REMOVE FLOOR TO CEILING PORTION OF EXISTING WALL AS NEEDED TO INFILL WITH NEW FULL HEIGHT PORTION OF 1/4" HARDBOARD. PATCH AND PREPARE ADJACENT SURFACES AS REQUIRED FOR NEW CONSTRUCTION
9. REMOVE EXISTING COAT HOOKS IN ITS ENTIRETY. PATCH AND PREPARE ADJACENT SURFACES AS REQUIRED FOR NEW CONSTRUCTION
10. EXISTING WHITE BOARD TO BE REMOVED, SALVAGED AND REINSTALLED AT A SEPARATE LOCATIONS. COORDINATE NEW LOCATION WITH OWNER.
11. REMOVE EXISTING IN WALL SHELVING. PATCH AND PREPARE ADJACENT SURFACES AS REQUIRED FOR NEW CONSTRUCTION

GENERAL DEMOLITION NOTES

1. THE GENERAL CONTRACTOR SHALL VERIFY ALL EXISTING DIMENSIONS AND CONDITIONS SHOWN ON THE PLANS PRIOR TO COMMENCEMENT OF THE WORK. IT SHALL BE THE CONTRACTORS RESPONSIBILITY TO COORDINATE INSTALLATION OF NEW WORK WITHIN THESE EXISTING CONDITIONS. ANY DEVIATIONS IN EXISTING CONDITIONS OR DIMENSIONS INDICATED SHALL BE COORDINATED WITH THE ARCHITECT/ENGINEER AND OWNER IN ORDER TO MODIFY THE PLANS ACCORDINGLY.
2. THE EXISTING BUILDING SHALL BE PROTECTED FROM WEATHER AT ALL TIMES. OPENINGS AND PENETRATIONS SHALL BE PROTECTED WITH DURABLE, INSULATED TEMPORARY CONSTRUCTION. COORDINATE SECURITY REQUIREMENTS WITH THE OWNER.
3. ALL WORK IS TO BE PERFORMED IN SUCH A MANNER AS TO MINIMIZE THE IMPACT ON AREAS ADJACENT TO THE AREAS OF CONSTRUCTION.
4. REMOVE EXISTING FLOORS, WALLS AND CEILINGS AS REQUIRED FOR NEW CONSTRUCTION. PATCH, REPAIR AND PREPARE ADJACENT SURFACES AS REQUIRED FOR NEW CONSTRUCTION AND FINISHES.
5. REMOVE EXISTING FURNITURE, FIXTURES AND EQUIPMENT (INCLUDING ARTWORK AND MARKER/TACK BOARDS) AS REQUIRED FOR NEW CONSTRUCTION. COORDINATE SALVAGE AND STORAGE OF EQUIPMENT WITH OWNER AS REQUIRED. PROTECT AND STORE ALL ITEMS DESIGNATED TO BE SALVAGED FOR REINSTALLATION.
6. REMOVE EXISTING SIGNAGE AS REQUIRED FOR DEMOLITION AND STORE DURING CONSTRUCTION. REINSTALL WHEN APPLICABLE. PATCH AND PREPARE ADJACENT SURFACES AS REQUIRED FOR NEW FINISHES. ALL NEW SIGNAGE TO BE PROVIDED BY OWNER.
7. ALL OPENINGS AND VOIDS LEFT BY THE REMOVAL OF EXISTING CONSTRUCTION, EQUIPMENT, PIPING, DUCTS, ETC. SHALL BE PROPERLY PATCHED AND CLOSED OFF TO MAINTAIN PROPER FIRE RATING IN WALLS, IF APPLICABLE. PATCH AND PREPARE ANY AREAS TO RECEIVE NEW FINISHES AS REQUIRED.
8. THE ARCHITECT ASSUMES NO RESPONSIBILITY FOR THE DETECTION OR REMOVAL OF ANY HAZARDOUS MATERIALS, INCLUDING, BUT NOT LIMITED TO, ASBESTOS IN ANY FORM. PARTIES RESPONSIBLE FOR DEMOLITION SHALL NOTIFY THE OWNER IMMEDIATELY OF ANY SUSPECTED MATERIALS.
9. THE OWNER HAS THE RIGHT TO CLAIM ANY MATERIALS AND/OR EQUIPMENT THAT ARE SCHEDULED TO BE DEMOLISHED OR REMOVED FROM THE SITE.
10. ALL EXISTING BUILDING ELEMENTS TO REMAIN SHALL BE PROTECTED DURING CONSTRUCTION.
11. PREPARE EXISTING SUBSTRATES TO REMAIN AS REQUIRED TO RECEIVE NEW FINISHES.

DAO ARCHITECTURE

7230 Meade St.
Westminster, CO 80030

Phone: 720.273.0431
Email: dan@daoarch.com
Web: www.daoarch.com

Rev. #	Description	Rev. Date
4	Addendum 1	11/12/2026
1	ACFR Comments	10/26/2026

Revision Schedule

Westminster Public Schools

2026 Bond Projects
Tennyson Knolls Preparatory School Renovations

6330 Tennyson St,
Arvada, CO 80003


DAO No.: 2025-033

September 25, 2026

First Floor Demolition Plan


AD1.0

C:\Users\Arvon\AppData\Local\Autodesk\Revit\Autodesk Revit 2026\Collaboration\Cache\YSPJ6STGNLYKNSMRb7453034-ba39-45da-87f6-90800a525a4f-01025a1f-ba0f-4387-aea8-f4d75c820a3.rvt
11/12/2026 9:56:45 AM

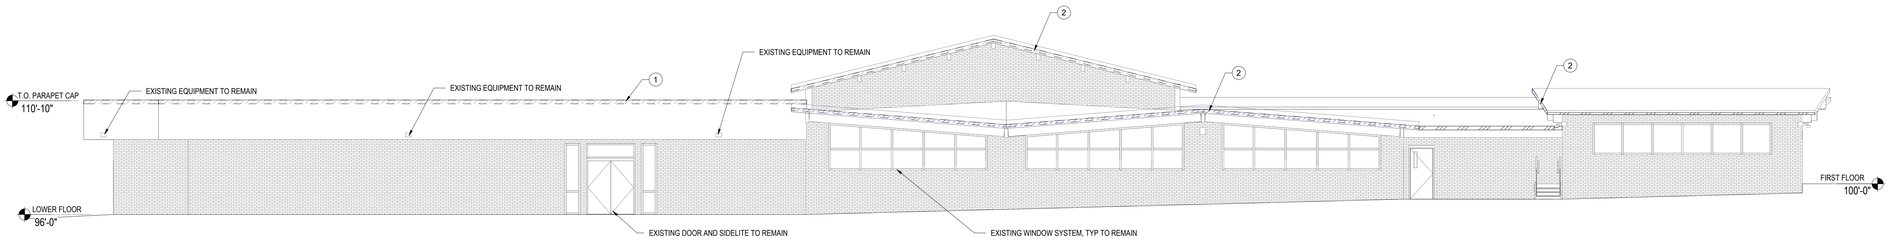


1 Exterior Demolition Elevation - North

SCALE: 1/8" = 1'-0"

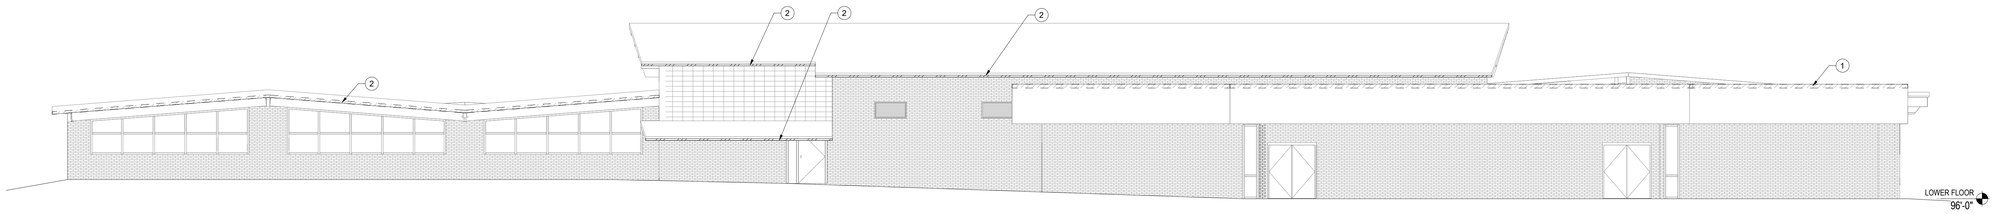


2 Exterior Demolition Elevation - East

SCALE: 1/8" = 1'-0"

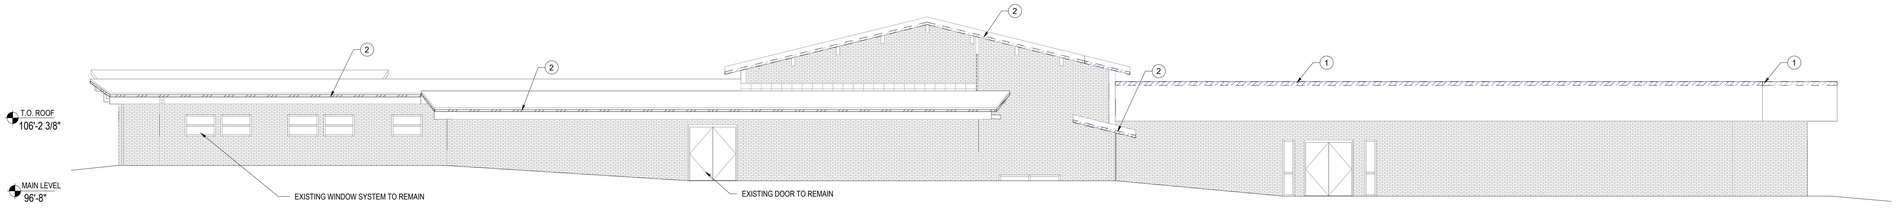

3 Exterior Demolition Elevation - South

SCALE: 1/8" = 1'-0"

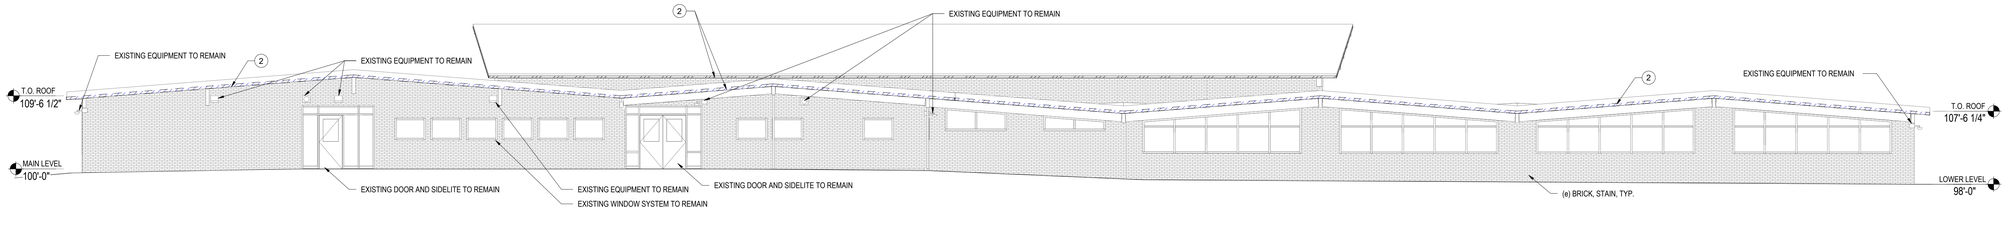

4 Exterior Demolition Elevation - West

SCALE: 1/8" = 1'-0"

GENERAL NOTES

1. THE GENERAL CONTRACTOR SHALL VERIFY ALL EXISTING DIMENSIONS AND CONDITIONS SHOWN ON PLANS PRIOR TO COMMENCEMENT OF THE WORK. IT SHALL BE THE CONTRACTORS RESPONSIBILITY TO COORDINATE INSTALLATION OF NEW WORK WITHIN THESE EXISTING CONDITIONS. ANY DEVIATIONS IN EXISTING CONDITIONS OR DIMENSIONS INDICATED SHALL BE COORDINATED WITH THE ARCHITECT AND OWNER IN ORDER TO MODIFY PLANS ACCORDINGLY.
2. ALL DISCIPLINES SHALL BE RESPONSIBLE FOR THEIR SCOPE OF WORK. THIS WORK IS TO BE SCHEDULED AND COMPLETED WITH THE GENERAL CONTRACTOR'S FULL KNOWLEDGE.
3. ALL HOT WORK ACTIVITIES (I.E. USING HEAT GUNS, SOLDERING, BRAZING, WELDING, GRINDING, METAL CUTTING, ETC.) OR OTHER ACTIVITIES INVOLVING FLAMES OR SPARKS SHALL BE PRECEDED BY OBTAINING AN APPROVED HOT WORK PERMIT. AN ACFR HOT WORK OPERATIONAL PERMIT IS REQUIRED PRIOR TO ANY HOT WORK.
4. THE PROJECT STAGING AREA / CONSTRUCTION ACTIVITIES SHALL NOT CAUSE THE OBSTRUCTION OF PATHS OF EGRESS INSIDE THE BUILDING, BLOCK EXIT DISCHARGE FROM THE BUILDING, OR IMPEDE EMERGENCY VEHICLE ACCESS TO THE BUILDING. CORRIDORS MAY NOT BE USED AS STAGING AREAS OR AS AREAS FOR DEBRIS COLLECTION.
5. ALL NECESSARY MEASURES SHALL BE TAKEN TO PREVENT THE NUISANCE ACTUATION OF ANY NEARBY SMOKE OR DUCT DETECTORS BY CONSTRUCTION ACTIVITIES THAT CREATE DUST OR FUMES INSIDE THE BUILDING.
6. THE CONTRACTOR SHALL NOT HANDLE OR DISABLE ANY FIRE SYSTEMS DEVICES. ONLY BUILDING FIRE SYSTEMS PERSONNEL MAY HANDLE OR DISABLE EXISTING FIRE SYSTEMS. ANY OUTAGES REQUIRED FOR THE EXISTING FIRE SYSTEMS SHALL BE PERFORMED ACCORDING TO THE BUILDING PROCEDURES. ACFR AND THE ALARM MONITORING COMPANY TO BE NOTIFIED BEFORE ANY FIRE ALARM SYSTEM IS PLACED OUT OF SERVICE.
7. THE ARCHITECT ASSUMES NO RESPONSIBILITY FOR THE DETECTION OR REMOVAL OF ANY HAZARDOUS MATERIALS, INCLUDING, BUT NOT LIMITED TO, ASBESTOS IN ANY FORM. PARTIES RESPONSIBLE FOR DEMOLITION SHALL NOTIFY THE OWNER IMMEDIATELY OF ANY SUSPECTED MATERIALS.

Note

1. ALL SIGNAGE AND EQUIPMENT TO BE REMOVED AS NEEDED FOR STAINING OF BRICK. RE-INSTALL AS REQUIRED

EXTERIOR DEMOLITION KEY NOTES

1. REMOVE EXISTING PARAPET CAP, ALL OTHER ELEMENTS TO REMAIN. SEE S/AD2.0 FOR ADDITIONAL INFORMATION. PATCH AND PREPARE ADJACENT SURFACES AS REQUIRED FOR NEW CONSTRUCTION.
2. REMOVE EXISTING CAP FLASHING. PATCH AND PREPARE ADJACENT SURFACES AS REQUIRED FOR NEW CONSTRUCTION.

DAO ARCHITECTURE

7230 Meade St.
Westminster, CO 80030

Phone: 720.273.0431
Email: dan@daoarch.com
Web: www.daoarch.com

Rev. #	Description	Rev. Date
1	ACFR Comments	10/26/2026

Revision Schedule

Westminster Public Schools

2026 Bond Projects
Tennyson Knolls Preparatory School Renovations

6330 Tennyson St,
Arvada, CO 80003

DAO No.: 2025-033

September 25, 2026

Exterior Demolition Elevations

AD2.0

C:\Users\Arxoo\AppData\Local\Autodesk\Revit\Autodesk Revit 2026\Collaboration\Cache\YSPJSST3NLYKNSMR\b7483934-ba39-465b-87f9-5980ccb23e4-15f2f0ca1fa-ba2f-4387-aaab-f4467b5f20b3.rvt
11/12/2026 9:56:48 AM



2 Partial Basement Plan - Room (011)

SCALE: 1/8" = 1'-0"

1 First Floor Plan

SCALE: 1/8" = 1'-0"

NOTE

CONTRACTOR SHALL FIELD-VERIFY THE LOCATION OF ALL EXISTING FIRE ALARM INITIATING DEVICES, NOTIFICATION APPLIANCES AND MANUAL FIRE ALARM BOXES BEFORE CASEWORK FABRICATION. CASEWORK SHALL NOT OBSTRUCT, COVER OR REDUCE THE VISIBILITY OR AUDIBILITY OF ANY DEVICE. WALL-MOUNTED VISIBLE APPLIANCES SHALL REMAIN UNOBSTRUCTED, 80 TO 96 INCHES ABOVE FINISHED FLOOR. ANY REMOVAL, RELOCATION OR ADDITION OF FIRE ALARM DEVICES OR WIRING REQUIRES A SEPARATE ACFR FIRE ALARM CONSTRUCTION PERMIT, WITH SHOP DRAWINGS APPROVED BEFORE THE WORK"

GENERAL PLAN NOTES

1. DRAWINGS & SPECIFICATIONS ARE COMPLIMENTARY COMPONENTS OF THE CONTRACT DOCUMENTS, REVIEW ALL DRAWINGS AND SPECIFICATIONS FOR THE COMPLETE SCOPE OF WORK. NOTIFY ARCHITECT IMMEDIATELY FOR CLARIFICATION IF INCONSISTENCIES, CONTRADICTIONS OR OMISSIONS ARE DISCOVERED.
2. DO NOT SCALE DRAWINGS. IF DIMENSIONAL INFORMATION IS REQUIRED & NOT FOUND, NOTIFY ARCHITECT IMMEDIATELY FOR CLARIFICATION.
3. ALL DIMENSIONS ARE TO COLUMN CENTERLINES OR FACE OF FINISHED WALLS OR SURFACES UNLESS NOTED OTHERWISE.
4. REFER TO DEMOLITION DRAWINGS FOR WORK REQUIRED IN ADVANCE OF CONSTRUCTION AND COORDINATE ACCORDINGLY.
5. REFER TO PLUMBING DRAWINGS FOR ADDITIONAL INFORMATION.
6. ALL THROUGH-PENETRATIONS AND MEMBRANE PENETRATIONS (PIPING, ELECTRICAL BOXES, CONDUIT AND LOW-VOLTAGE CABLING) OF EXISTING 1-HOUR CORRIDOR WALLS SHALL BE PROTECTED BY LISTED FIRESTOP SYSTEMS THAT MAINTAIN THE RATING OF THE WALL.
7. PAINT AS REQUIRED AT ANY LOCATIONS WHERE WHITEBOARDS, PLUG MOLD AND TACK BOARDS ARE REMOVED

KEY NOTES

1. MAPLE-VENEERED PLYWOOD BASE CABINETS WITH SOLID SURFACE COUNTERTOP
2. SINGLE BASIN ADA SINK WITH BUBBLER. RE: PLUMBING
3. FULL-HEIGHT WOOD-VENEERED CABINET WITH DOOR LOCK
4. MAPLE-VENEERED PLYWOOD SHELF WITH COAT HOOKS BELOW
5. MAPLE-VENEERED PLYWOOD UPPER CABINETS
6. INSTALL NEW DUAL OUTLET IN CABINET FILLER PANEL. EXTEND EXISTING CIRCUITING AS REQUIRED
7. INSTALL NEW DUAL OUTLET IN EXISTING IN-WALL J-BOX. EXTEND CIRCUITING AS REQUIRED.
8. INFILL EXISTING WALL OPENING WITH MATCHING WALL ASSEMBLY. SEE 10/A6.0 FOR ADDITIONAL INFORMATION
9. FULL-HEIGHT WOOD-VENEERED STORAGE CABINET WITH DOOR LOCK
10. NEW WOOD-VENEERED IN WALL SHELVING

LEGEND

EXTENTS OF AREA WITH LIMITED TO NO ARCHITECTURAL SCOPE

DAO ARCHITECTURE

7230 Meade St.
Westminster, CO 80030

Phone: 720.273.0431
Email: dan@daoarch.com
Web: www.daoarch.com

Rev. #	Description	Rev. Date
4	Addendum 1	11/12/2026
3	ACFR Round 2	10/28/2026
1	ACFR Comments	10/26/2026

Revision Schedule

Westminster Public Schools

2026 Bond Projects
Tennyson Knolls Preparatory School Renovations

6330 Tennyson St,
Arvada, CO 80003


DAO No.: 2025-033

September 25, 2026


First Floor Plan

A1.0


C:\Users\Arvon\AppData\Local\Autodesk\Revit\Autodesk Revit 2026\Collaboration\Cache\YSP-b5TGNLYKNSMRb7453034-ba39-45da-82f6-90800a525a4-15025-ba8f-4387-aea8-f4dd75c820a3.rvt
11/12/2026 9:55:51 AM

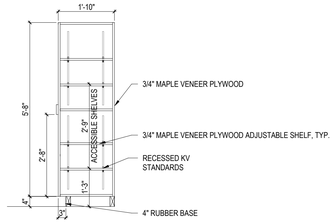


1 Teacher's Cabinet - Left
SCALE: 1/2" = 1'-0"

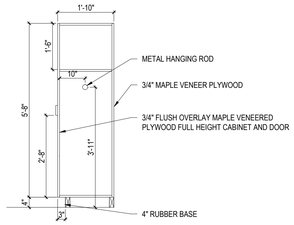


2 Teacher's Cabinet - Right
SCALE: 1/2" = 1'-0"

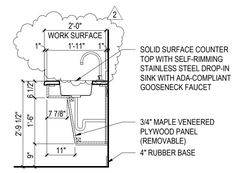


3 Sink Base Cabinet Only
SCALE: 1/2" = 1'-0"

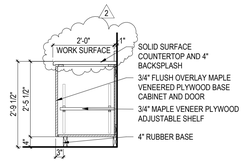


4 Base Cabinet Only
SCALE: 1/2" = 1'-0"

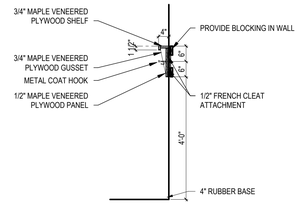


5 Backpack Storage Section
SCALE: 1/2" = 1'-0"

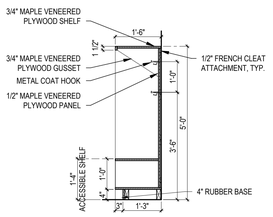


6 Classroom Shelf
SCALE: 1/2" = 1'-0"

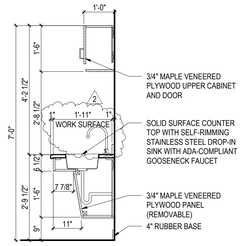

8 Sink with Upper
SCALE: 1/2" = 1'-0"

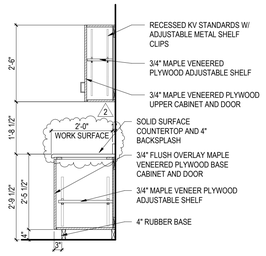

9 Base with Uppers
SCALE: 1/2" = 1'-0"

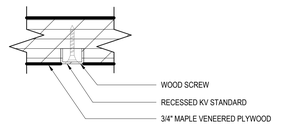

7 Typ. Recessed KV Standard
SCALE: 12" = 1'-0"

CASEWORK GENERAL NOTES


1. ALL CASEWORK SHALL BE CONSTRUCTED TO MEET THE FOLLOWING AWI CONSTRUCTION GRADES:
   WOOD VENEERED PLYWOOD CASEWORK
   -GRADE = CUSTOM
   -SOLID SURFACE COUNTERTOPS AND BACKSPLASH

2. TYPICAL MATERIALS:
   -HEAVY DUTY DRAWER SLIDES
   -FIVE KNUCKLE HINGES
   -WIRE PULLS
   -METAL SHELF CLIPS ON RECESSED K.V. STANDARDS


3. FINISHES AS BELOW:
   -CASEWORK: PLAIN SLICED WHITE MAPLE WITH CLEAR FINISH
   -COUNTERTOPS: SOLID SURFACE FORMICA CLASSICS RIVER ROCK MOSAIC 656 MATTE FINISH
   -RUBBER BASE: ROPPE - BLACK, REQUIRED AT CASEWORK TOEKICK AND ANYWHERE INDICATED ON THE CONSTRUCTION DOCUMENTS. (4)

4. RECESS ALL KV STANDARDS PER DETAIL 7 ON SHEET A6.0


5. BOTH SIDES OF TEACHERS CABINET SHALL BE LOCKABLE. LOCKS SHOULD BE COMPATIBLE WITH DISTRICT STANDARD (BEST 1CP7WC1626 CORES)

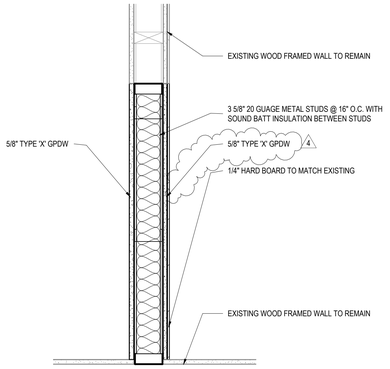

10 Door Infill
SCALE: 1 1/2" = 1'-0"

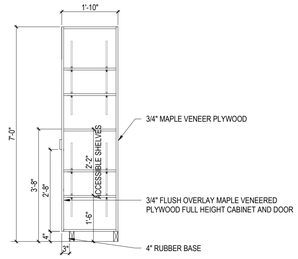

11 Storage Cabinet
SCALE: 1/2" = 1'-0"

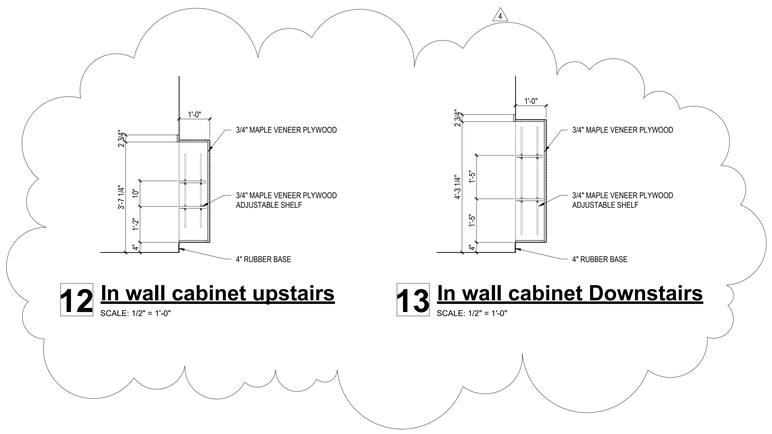

12 In wall cabinet upstairs
SCALE: 1/2" = 1'-0"

13 In wall cabinet Downstairs
SCALE: 1/2" = 1'-0"

FINISH REQUIREMENTS NOTE

1. ANY NEW WALL APPLIED FINISH MATERIALS SHALL MEET THE INTERIOR WALL FINISH CLASSIFICATION FOR A NON-SPRINKLERED GROUP E OCCUPANCY. CLASS A IN EXIT ENCLOSURES AND CORRIDORS, AND NOT LESS THAN CLASS C IN ROOMS OR ENCLOSED SPACES. CONTRACTOR TO PROVIDE ASTM E84/UL 723 FLAME SPREAD AND SMOKE-DEVELOPED INDEX DATA FOR FINISH PRODUCTS. (1)

DAO ARCHITECTURE
7230 Meade St.
Westminster, CO 80030
Phone: 720.273.0431
Email: dan@daoarch.com
Web: www.daoarch.com

Rev. #	Description	Rev. Date
4	Addendum 1	11/12/2026
2	DFPC Comments	10/26/2026
1	ACFR Comments	10/26/2026

Revision Schedule

Westminster Public Schools

2026 Bond Projects
Tennyson Knolls Preparatory School Renovations

6330 Tennyson St,
Arvada, CO 80003


DAO No.: 2025-033

September 25, 2026

Casework Sections/Details


A6.0

C:\Users\Arvon\AppData\Local\Autodesk\Revit\Autodesk Revit 2026\Collaboration\Cache\YSPJ6ST1GNLYKNSMRb7453034-ba39-45da-87f9-9980ca525a41\5025ca1fa-ba0f-4387-aeab-f4dd75c820ba3.rvt
11/12/2026 9:56:52 AM

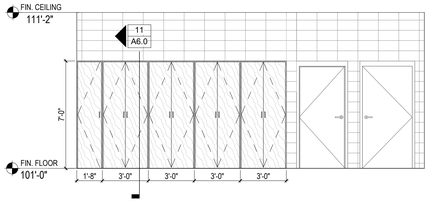


1 Stage (110) - West

1 A1.0 SCALE: 1/4" = 1'-0"

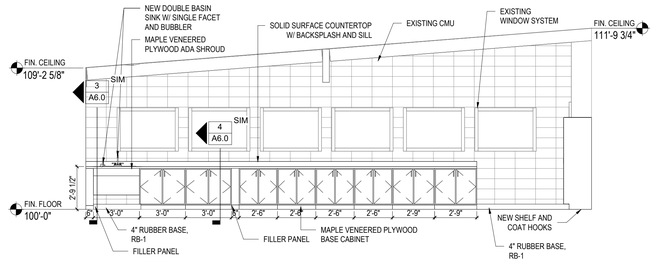


2 Kindergarden (101) - West

1 A1.0 SCALE: 1/4" = 1'-0"

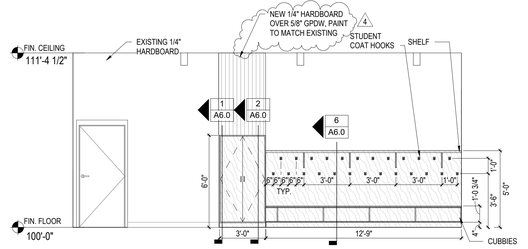


3 Kindergarden (101) - North

1 A1.0 SCALE: 1/4" = 1'-0"

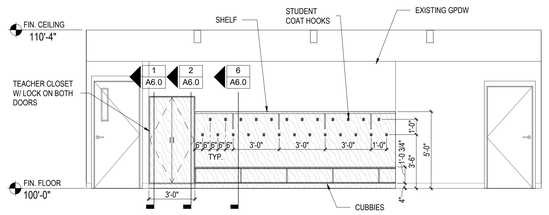


4 Kindergarden (102) - East

1 A1.0 SCALE: 1/4" = 1'-0"

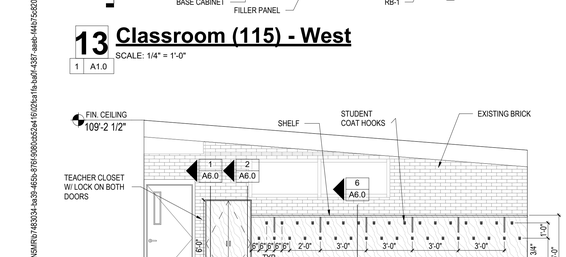


5 Kindergarden (102) - West

1 A1.0 SCALE: 1/4" = 1'-0"

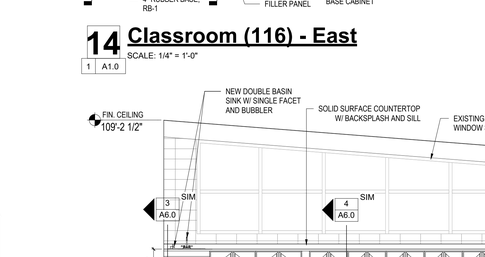


6 Classroom (109) -East

1 A1.0 SCALE: 1/4" = 1'-0"

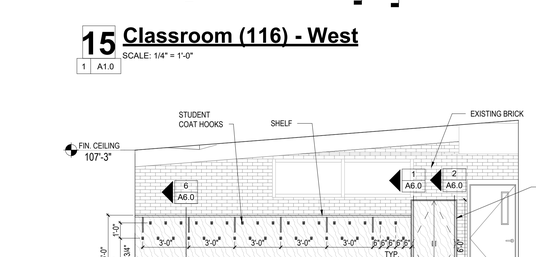


7 Classroom (109) - West

1 A1.0 SCALE: 1/4" = 1'-0"

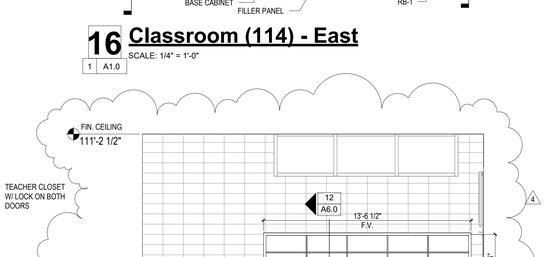


8 Classroom (111) - East

1 A1.0 SCALE: 1/4" = 1'-0"

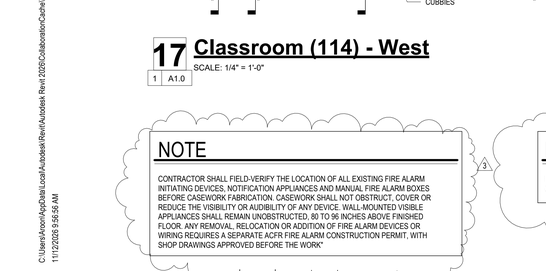


9 Classroom (111) - West

1 A1.0 SCALE: 1/4" = 1'-0"

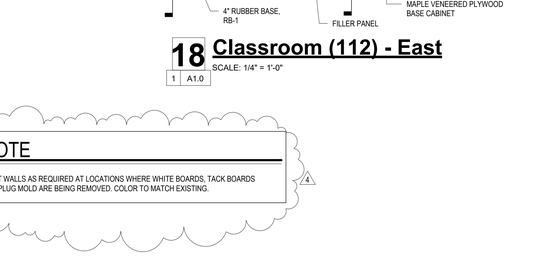


10 Classroom (113) - East

1 A1.0 SCALE: 1/4" = 1'-0"

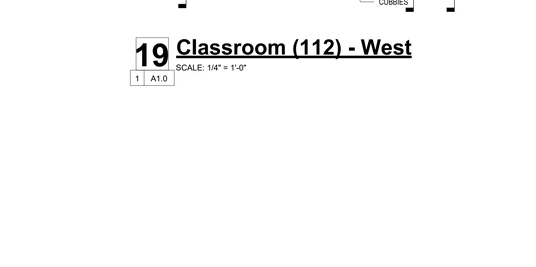

11 Classroom (113) - West

1 A1.0 SCALE: 1/4" = 1'-0"

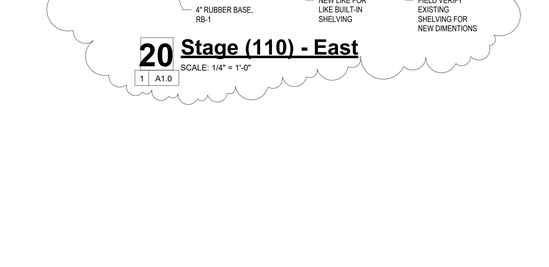

12 Classroom (115) - East

1 A1.0 SCALE: 1/4" = 1'-0"

13 Classroom (115) - West

1 A1.0 SCALE: 1/4" = 1'-0"

14 Classroom (116) - East

1 A1.0 SCALE: 1/4" = 1'-0"

15 Classroom (116) - West

1 A1.0 SCALE: 1/4" = 1'-0"

16 Classroom (114) - East

1 A1.0 SCALE: 1/4" = 1'-0"

17 Classroom (114) - West

1 A1.0 SCALE: 1/4" = 1'-0"

18 Classroom (112) - East

1 A1.0 SCALE: 1/4" = 1'-0"

19 Classroom (112) - West

1 A1.0 SCALE: 1/4" = 1'-0"

20 Stage (110) - East

1 A1.0 SCALE: 1/4" = 1'-0"

NOTE

CONTRACTOR SHALL FIELD-VERIFY THE LOCATION OF ALL EXISTING FIRE ALARM INITIATING DEVICES, NOTIFICATION APPLIANCES AND MANUAL FIRE ALARM BOXES BEFORE CASEWORK FABRICATION. CASEWORK SHALL NOT OBSTRUCT, COVER OR REDUCE THE VISIBILITY OR AUDIBILITY OF ANY DEVICE. WALL-MOUNTED VISIBLE APPLIANCES SHALL REMAIN UNOBSTRUCTED, 80 TO 96 INCHES ABOVE FINISHED FLOOR. ANY REMOVAL, RELOCATION OR ADDITION OF FIRE ALARM DEVICES OR WIRING REQUIRES A SEPARATE ACFR FIRE ALARM CONSTRUCTION PERMIT, WITH SHOP DRAWINGS APPROVED BEFORE THE WORK"

3

NOTE

PAINT WALLS AS REQUIRED AT LOCATIONS WHERE WHITE BOARDS, TACK BOARDS AND PLUG MOLD ARE BEING REMOVED. COLOR TO MATCH EXISTING.

4

C:\Users\Anoor\AppData\Local\Autodesk\Revit\Autodesk Revit 2026\Collaboration\Cache\YSPJDSTONLYKNSMRK(745934-ba39-465b-87f9-f0980ca52ae1-0028a41e-ba2f-1387-aaab-f44b75d20a3.rvt
11/12/2026 9:56:56 AM

DAO ARCHITECTURE

7230 Meade St.
Westminster, CO 80030

Phone: 720.273.0431
Email: dan@daoarch.com
Web: www.daoarch.com

Rev. #	Description	Rev. Date
4	Addendum 1	11/12/2026
3	ACFR Round 2	10/28/2026

Revision Schedule

Westminster Public Schools

2026 Bond Projects
Tennyson Knolls Preparatory School Renovations


6330 Tennyson St,
Arvada, CO 80003

DAO No.: 2025-033

September 25, 2026

Interior Elevations


A6.01

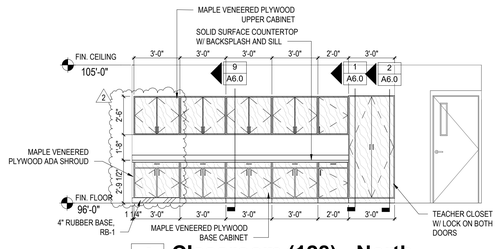

1 Classroom (128) - North

SCALE: 1/4" = 1'-0"


1 | A1.0

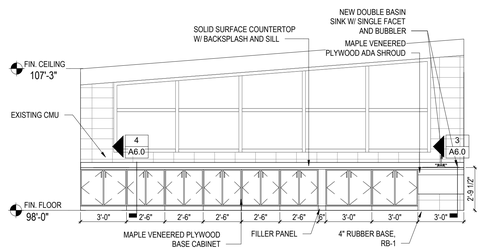

2 Classroom (118) - North

SCALE: 1/4" = 1'-0"


1 | A1.0

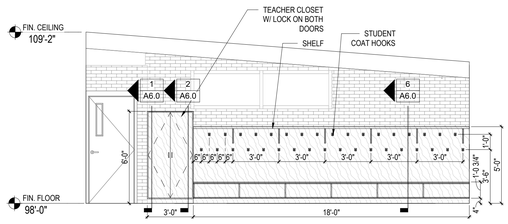

3 Classroom (118) - South

SCALE: 1/4" = 1'-0"


1 | A1.0

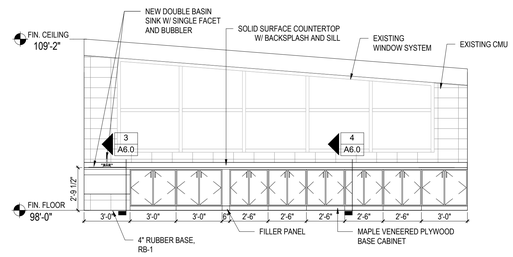

4 Classroom (119) - North

SCALE: 1/4" = 1'-0"


1 | A1.0

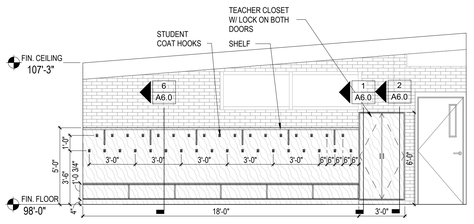

5 Classroom (119) - South

SCALE: 1/4" = 1'-0"


1 | A1.0

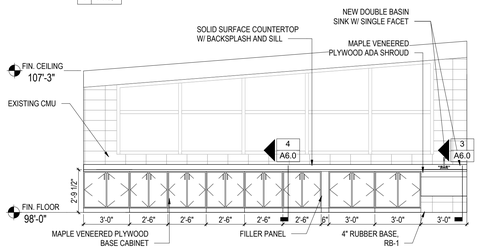

6 Classroom (120) - North

SCALE: 1/4" = 1'-0"


1 | A1.0

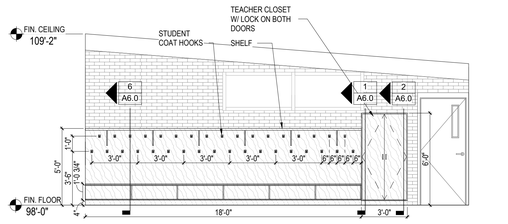

7 Classroom (120) - South

SCALE: 1/4" = 1'-0"


1 | A1.0

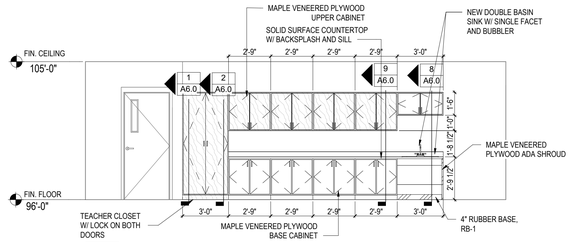

8 Classroom (123) - South

SCALE: 1/4" = 1'-0"


1 | A1.0

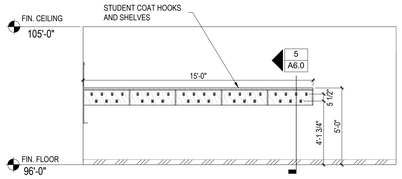

9 Classroom (124) - North

SCALE: 1/4" = 1'-0"


1 | A1.0

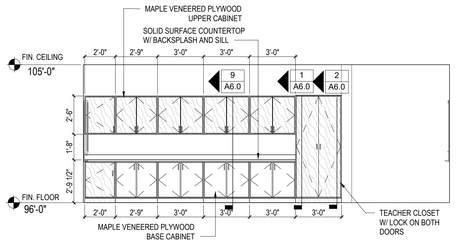

10 Classroom (124) - South

SCALE: 1/4" = 1'-0"


1 | A1.0

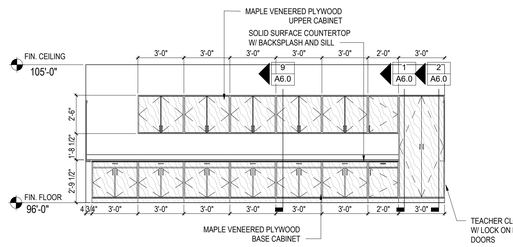

11 Classroom (130) - North

SCALE: 1/4" = 1'-0"


1 | A1.0

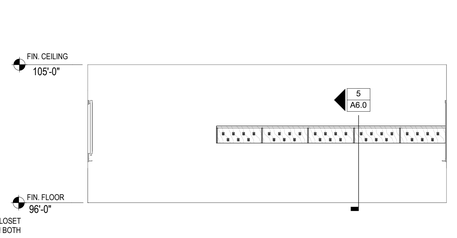

12 Classroom (130) - South

SCALE: 1/4" = 1'-0"


1 | A1.0

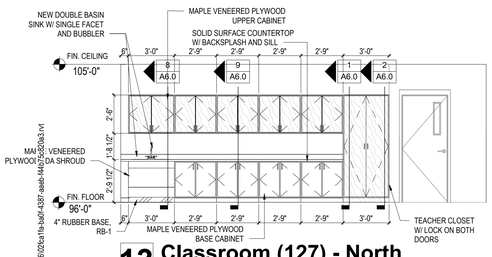

13 Classroom (127) - North

SCALE: 1/4" = 1'-0"


1 | A1.0

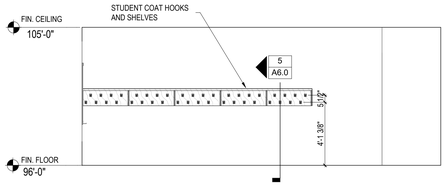

14 Classroom (129) - North

SCALE: 1/4" = 1'-0"


1 | A1.0

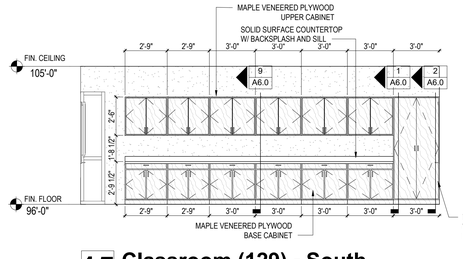

15 Classroom (129) - South

SCALE: 1/4" = 1'-0"

1 | A1.0

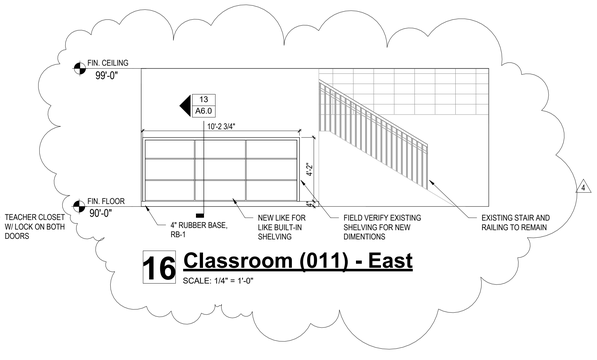

16 Classroom (011) - East

SCALE: 1/4" = 1'-0"

NOTE

CONTRACTOR SHALL FIELD-VERIFY THE LOCATION OF ALL EXISTING FIRE ALARM INITIATING DEVICES, NOTIFICATION APPLIANCES AND MANUAL FIRE ALARM BOXES BEFORE CASEWORK FABRICATION. CASEWORK SHALL NOT OBSTRUCT, COVER OR REDUCE THE VISIBILITY OR AUDIBILITY OF ANY DEVICE. WALL-MOUNTED VISIBLE APPLIANCES SHALL REMAIN UNOBSTRUCTED, 80 TO 96 INCHES ABOVE FINISHED FLOOR. ANY REMOVAL, RELOCATION OR ADDITION OF FIRE ALARM DEVICES OR WIRING REQUIRES A SEPARATE ACFR FIRE ALARM CONSTRUCTION PERMIT, WITH SHOP DRAWINGS APPROVED BEFORE THE WORK"

NOTE

PAINT WALLS AS REQUIRED AT LOCATIONS WHERE WHITE BOARDS, TACK BOARDS AND PLUG MOLD ARE BEING REMOVED. COLOR TO MATCH EXISTING.

C:\Users\Anon\AppData\Local\Autodesk\Revit\Autodesk Revit 2025\Collaboration\Cache\YSPJ6ST1GNLYKNSMRb7458334-aa39-4b5b-87f9-90f80ca52ad15\02fa1fa-ba0f-4357-aaa8-f4d7a2c50b3-rvt
11/12/2026 9:56:58 AM

DAO ARCHITECTURE
7230 Meade St.
Westminster, CO 80030
Phone: 720.273.0431
Email: dan@daoarch.com
Web: www.daoarch.com

Rev. #	Description	Rev. Date
4	Addendum 1	11/12/2026
3	ACFR Round 2	10/28/2026
2	DFPC Comments	10/26/2026

Revision Schedule

Westminster Public Schools

2026 Bond Projects
Tennyson Knolls Preparatory School Renovations


6330 Tennyson St,
Arvada, CO 80033

DAO No.: 2025-033

September 25, 2026

Interior Elevations

A6.02

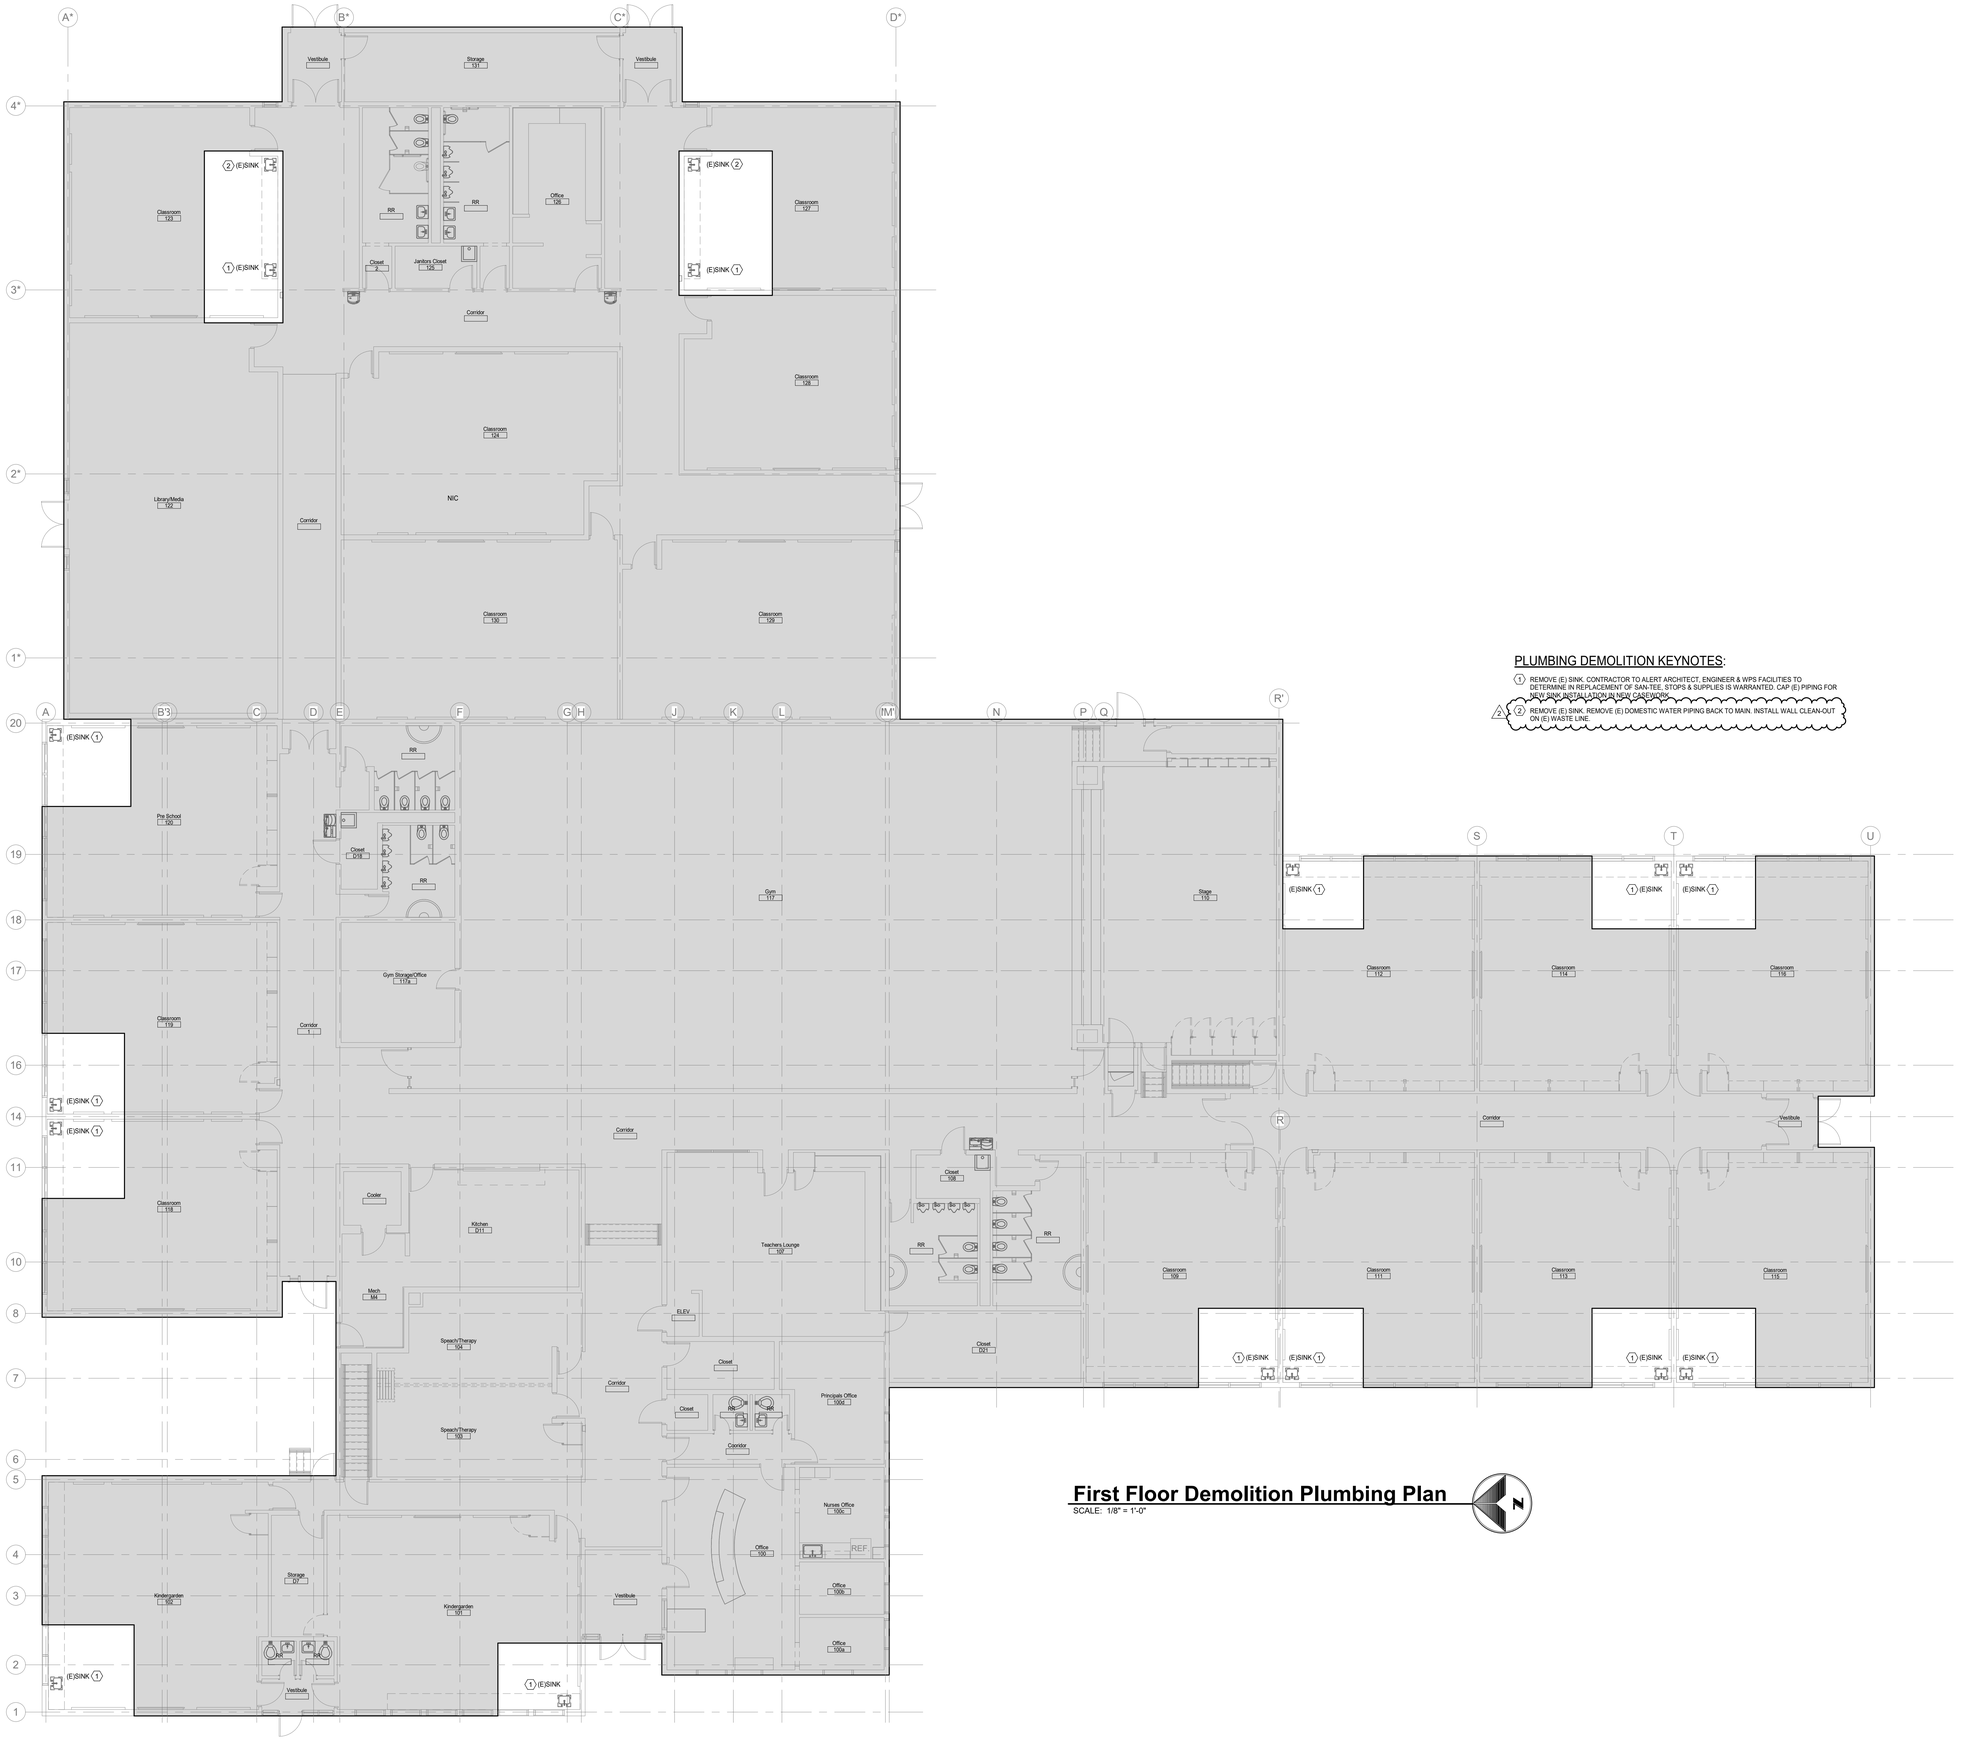

First Floor Demolition Plumbing Plan

SCALE: 1/8" = 1'-0"

PLUMBING DEMOLITION KEYNOTES:

1. REMOVE (E) SINK. CONTRACTOR TO ALERT ARCHITECT, ENGINEER & WPS FACILITIES TO DETERMINE IN REPLACEMENT OF SAN-TEE, STOPS & SUPPLIES IS WARRANTED. CAP (E) PIPING FOR NEW SINK INSTALLATION IN NEW CASEWORK.
2. REMOVE (E) SINK. REMOVE (E) DOMESTIC WATER PIPING BACK TO MAIN. INSTALL WALL CLEAN-OUT ON (E) WASTE LINE.

DAO ARCHITECTURE

7230 Meade St.
Westminster, CO 80030

Phone: 720.273.0431
Email: dan@daoarch.com
Web: www.daoarch.com

The Ballard Group, Inc.
Mechanical Consulting Engineers
2525 S. Wadsworth Blvd, Suite 200
Lakewood, CO 80227
(303) 988-4514

Rev. #	Description	Rev. Date
2	Addendum 01	11/12/2026

Revision Schedule

Westminster Public Schools

2026 Bond Projects
Tennyson Knolls Preparatory School Renovations

6330 Tennyson St,
Arvada, CO 80003

DAO No.:2025-025

September 25, 2026

First Floor Demolition Plumbing Plan

PD1.0

Autodesk Docs://WPS 2026 Bond Projects - Tennyson Knolls Renovations/25094 Tennyson Knolls Bond Projects-PLBG-R26.rvt
11/12/2026 9:49:37 AM

PLUMBING KEYNOTES:

1. CONNECT 2" WASTE, 1/2" CW & 1/2" HW TO (E) PLBG FOR NEW SINK. CONTRACTOR TO ALERT ARCHITECT, ENGINEER & WPS FACILITIES TO DETERMINE IF REPLACEMENT OF SAN-TEE, STOPS & SUPPLIES IS WARRANTED.
2. INSTALL WALL CLEAN-OUT AT SANITARY BRANCH AT WALL.

First Floor Plumbing Plan

SCALE: 1/8" = 1'-0"

DAO ARCHITECTURE

7230 Meade St.
Westminster, CO 80030

Phone: 720.273.0431
Email: dan@daoarch.com
Web: www.daoarch.com

The Ballard Group, Inc.
Mechanical Consulting Engineers
2525 S. Wadsworth Blvd, Suite 200
Lakewood, CO 80227
(303) 988-4514

Rev. #	Description	Rev. Date
2	Addendum 01	11/12/2026

Revision Schedule

Westminster Public Schools

2026 Bond Projects
Tennyson Knolls Preparatory School Renovations

6330 Tennyson St,
Arvada, CO 80003

DAO No.:2025-025

September 25, 2026

First Floor Plumbing Plan

P1.0

Autodesk Docs://WPS 2026 Bond Projects - Tennyson Knolls Renovations/25094 Tennyson Knolls Bond Projects-PLBG-R26.rvt
11/12/2026 9:49:40 AM