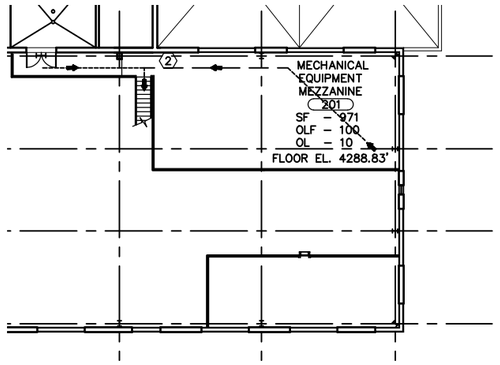


MEZZANINE FLOOR EL. 4288.83'

SCALE 1/16"=1'-0"

LEGEND:

1. — ⟶ – INDICATES DIRECTION OF EGRESS PATH
2. SF – SQUARE FEET
3. OLF – OCCUPANT LOAD FACTOR
4. OL – OCCUPANT LOAD
5. NA – NOT APPLICABLE, UNOCCUPIED ACCESSORY AREA
6. [E] – INDICATES EXIT LOCATION
7. ⟨#⟩ – INDICATES FIRE RESISTANCE RATING IN HOURS
8. F-1, B, H-3 – INDICATES OCCUPANCY CLASSIFICATION

THE FOLLOWING BUILDING CODE INFORMATION IS BASED ON THE 2003 INTERNATIONAL BUILDING CODE, 1997 NEW MEXICO BUILDING CODE AND THE 1997 UNIFORM BUILDING CODE, USING THE MOST STRINGENT REQUIREMENTS OF EACH CODE.

A. HEIGHT AND FLOOR AREA OF BUILDING:
1. FLOOR AREA: 15,200 SQUARE FEET.
2. HEIGHT: 23 FEET, VARIES, 1 STORY

B. *OCCUPANCY CLASSIFICATION:
1. F-1 INDUSTRIAL MODERATE-HAZARD (SECTION 306.1)

C. *CONSTRUCTION CLASSIFICATION:
1. TYPE 11 N (TABLE 5-B, BASIC ALLOWABLE BUILDING HEIGHTS AND BASIC ALLOWABLE FLOOR AREA FOR BUILDINGS ONE STORY IN HEIGHT).
   a. MAXIMUM HEIGHT – 55 FEET, TWO STORIES
   b. MAXIMUM AREA – 12,000 SQUARE FEET.
   c. MAXIMUM AREA WITH AREA INCREASE – 36,000 SQUARE FEET.

D. *ALLOWABLE AREA INCREASE:
1. AUTOMATIC SPRINKLER SYSTEM INCREASE; IF THE BUILDING IS PROVIDED WITH AN APPROVED AUTOMATIC SPRINKLER SYSTEM THROUGHOUT, SECTION 505.3. THE AREA LIMITATIONS IN (TABLE 5-B) MAY BE TRIPLED IN ONE-STORY BUILDINGS. AUTOMATIC SPRINKLER SYSTEM REQUIRED, WITH THE EXCEPTION OF THE ELECTRICAL ROOM

E. **REQUIRED SEPARATION OF OCCUPANCIES (TABLE 302.3.2)

F. **INTERIOR WINDOWS IN A 2 HOUR FIRE RATED BARRIER WALL
1. INTERIOR FIRE WINDOW ASSEMBLIES. FIRE-PROTECTION-RATED GLAZING USED IN FIRE WINDOW ASSEMBLIES LOCATED IN FIRE PARTITIONS AND FIRE BARRIERS SHALL BE LIMITED TO USE IN ASSEMBLIES WITH A MINIMUM FIRE-RESISTANCE RATING OF 1 HOUR IN ACCORDANCE WITH THIS SECTION. (SECTION 715.4.7). TABLE 715.4 FIRE WINDOW ASSEMBLY FIRE PROTECTION RATINGS.
   a. NOT PERMITTED EXCEPT AS SPECIFIED IN FIRE-RESISTANCE-RATING GLAZING. LABELED FIRE-RESISTANCE-RATED GLAZING TESTED AS PART OF A FIRE-RESISTANCE-RATED WALL ASSEMBLY IN ACCORDANCE WITH ASTME 119 SHALL NOT BE REQUIRED TO COMPLY WITH THIS SECTION (SECTION 715.2)
2. SIZE LIMITATIONS: THE TOTAL AREA OF WINDOWS SHALL NOT EXCEED 25 PERCENT OF THE AREA OF A COMMON WALL WITH ANY ROOM (SECTION 715.4.7.2).

G. *MEANS OF EGRESS:
1. MECHANICAL EQUIPMENT MEZZANINE, ONE EXIT REQUIRED. (TABLE 10A, NUMBER 21).
2. HALLWAYS SHALL BE CONSIDERED AS INTERVENING ROOM, (SECTION 1004.2.2). ROOMS WITH A CUMULATIVE OCCUPANT LOAD OF LESS THAN 10 MAY ACCESS EXITS THROUGH MORE THAN ONE INTERVENING ROOM. (SECTION 1004.2.2, EXCEPTIONS 3).
3. DEAD ENDS IN HALLWAYS AND CORRIDORS SHALL NOT BE MORE THAN 20 FEET IN LENGTH, (SECTION 1004.2.6)

H. *EXIT ACCESS TRAVEL DISTANCE: (SECTION 1004.2.5.2).

I. ***ACCESSIBILITY:
1. REQUIRED (SECTION 1103.1).

LEGEND:
* 1997 UNIFORM BUILDING CODE
** 2003 INTERNATIONAL BUILDING CODE
*** 1997 NEW MEXICO BUILDING CODE

Office areas, water lab, restrooms, locker rooms

approx. location of concrete suface & ramp that needs to be swept

approx. location of mats that need to be vacuumed in test bay area

Approx. location of concrete that needs to be swept

RECORD DRAWINGS
THIS DRAWING REFLECTS CHANGES FROM THE ORIGINAL CONTRACT DRAWING THAT WERE MADE DURING CONSTRUCTION AND HAVE BEEN PREPARED FROM INFORMATION PROVIDED TO THE ENGINEER BY THE CONSTRUCTION CONTRACTOR(S). THE ENGINEER DOES NOT WARRANT THIS DRAWING TO BE COMPLETE AND ACCURATE IN ALL RESPECTS.
MALCOLM PIRNIE, INC.
DATE _____ BY _____

8 0 8 16
SCALE: 1/16" = 1'-0"
4 0 4 8
SCALE: 1/8" = 1'-0"

PRIME CONTRACTOR
LAGUNA CONSTRUCTION COMPANY, INC.

ENGINEER/ARCHITECT
MALCOLM PIRNIE

JEFFREY K. KRACHT NEW MEXICO 7054 LICENSED PROFESSIONAL ENGINEER

NO.	BY	DATE	REMARKS
#4	MH	10-17-05	ITEMS IDENTIFIED AS COST SAVINGS
	RM	06-08	RECORD DRAWING CHANGES

BUREAU OF RECLAMATION

	As-Built No Changes	JOHN L. WALP	TECHNICAL SERVICE CENTER, DENVER CO
X	As-Built With Changes		

DES DFC
DWN MAV
CKD

U.S. DEPARTMENT OF THE INTERIOR BUREAU OF RECLAMATION

TULAROSA BASIN NATIONAL DESALINATION RESEARCH FACILITY

MAIN BUILDING
CODE COMPLIANCE PLAN AT EL. 4278.00
1/8"=1'-0"

COPYRIGHT © 2005 MALCOLM PIRNIE, INC.

DATE DECEMBER, 2006

A2 SHEET # OF #

CAD REF. NO. 3216A251

User:Marinelli Spec:PIRNIE_STANDARD? File:Z:\ACAD\PROJ\3216009\DESIGN\RECORD DRAWINGS-BLDG PKG\ACAD\ARCH\3216A251.DWG Scale:1:1 Date:06/18/2008 Time:13:50 Layout:CODE PLAN